

INDEX TO DRAWINGS	
SHEET NO.	DESCRIPTION
1	TITLE SHEET
2	GENERAL NOTES & LEGEND
3 - 4	WATER POLLUTION & EROSION CONTROL NOTES
5	ROADWAY PLAN
6-8	DRAINAGE DETAILS
9	WORK ZONE SIGN DETAILS

STATE OF HAWAII

DEPARTMENT OF TRANSPORTATION

HIGHWAYS DIVISION

HONOLULU, HAWAII

"AS-BUILT"

PLANS FOR


KUHIO HIGHWAY DRAINAGE IMPROVEMENTS

VICINITY OF M.P. 18.3

PROJECT NO. 56AC-01-04

DISTRICTS OF KAWAIHAU AND HANAIEI


ISLAND OF KAUAI

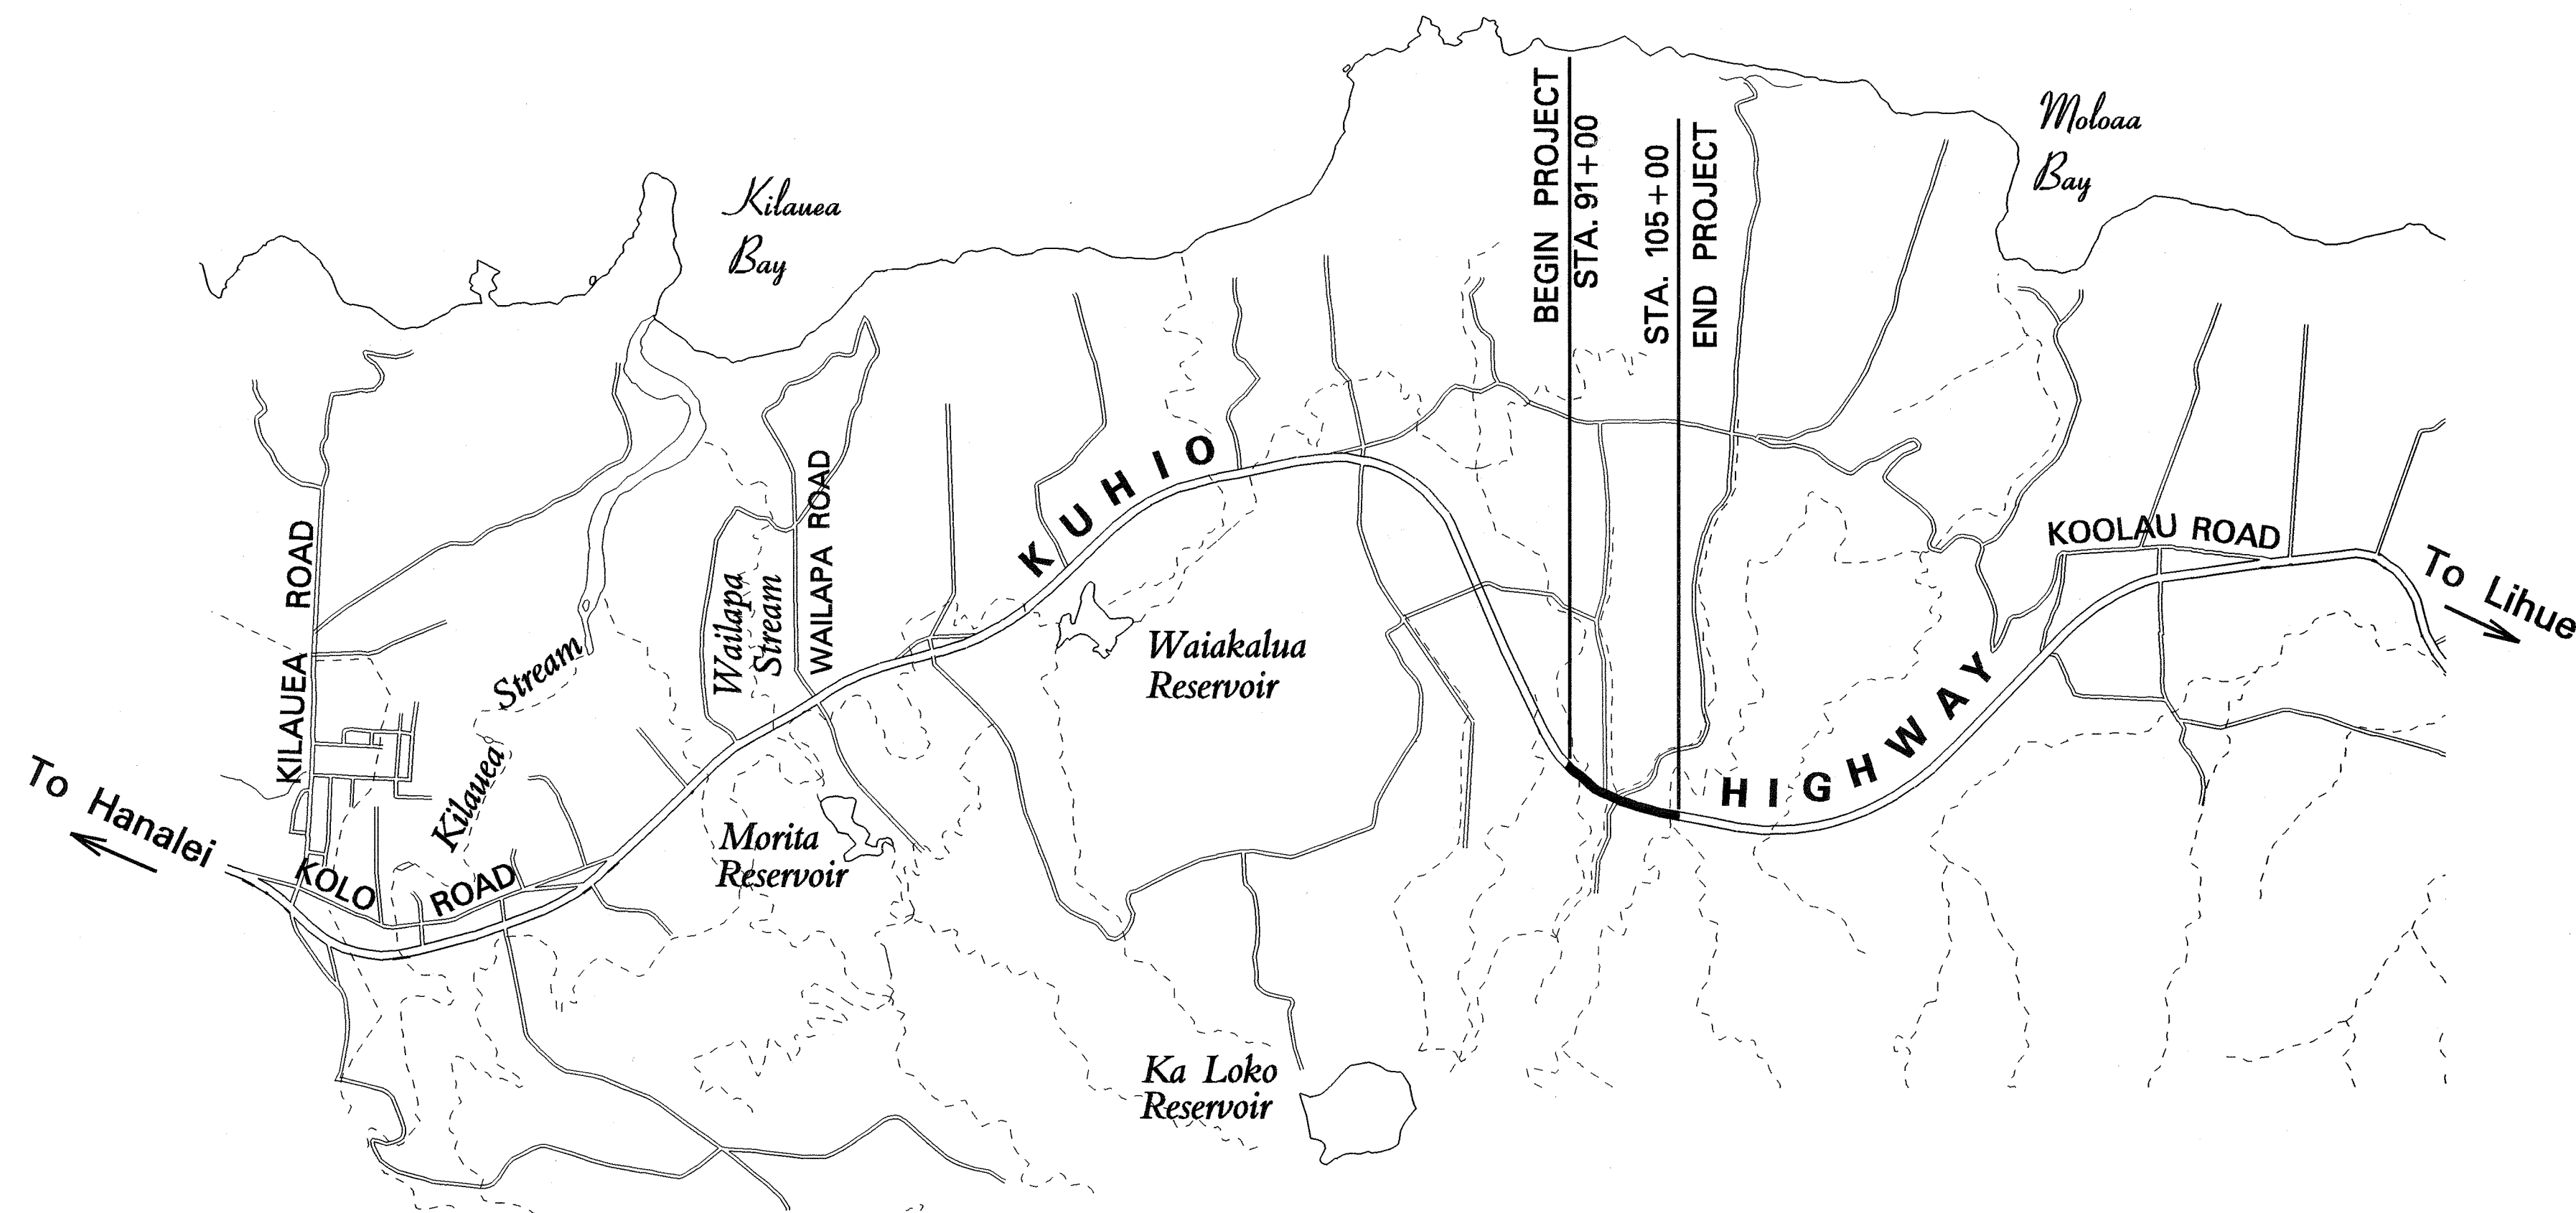



LAYOUT PLAN

GROSS LENGTH OF PROJECT.....0.27 MILES

NET LENGTH OF PROJECT.....0.27 MILES

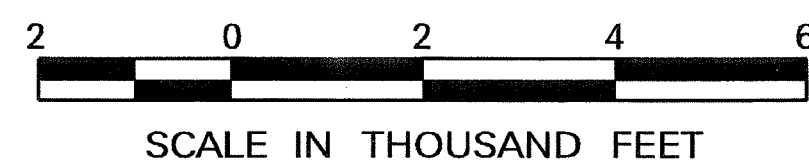

FED. ROAD DIST. NO.	STATE	PROJ. NO.	FISCAL YEAR	SHEET NO.	TOTAL SHEETS
HAWAII	HAW.	56AC-01-04	2008	1	9

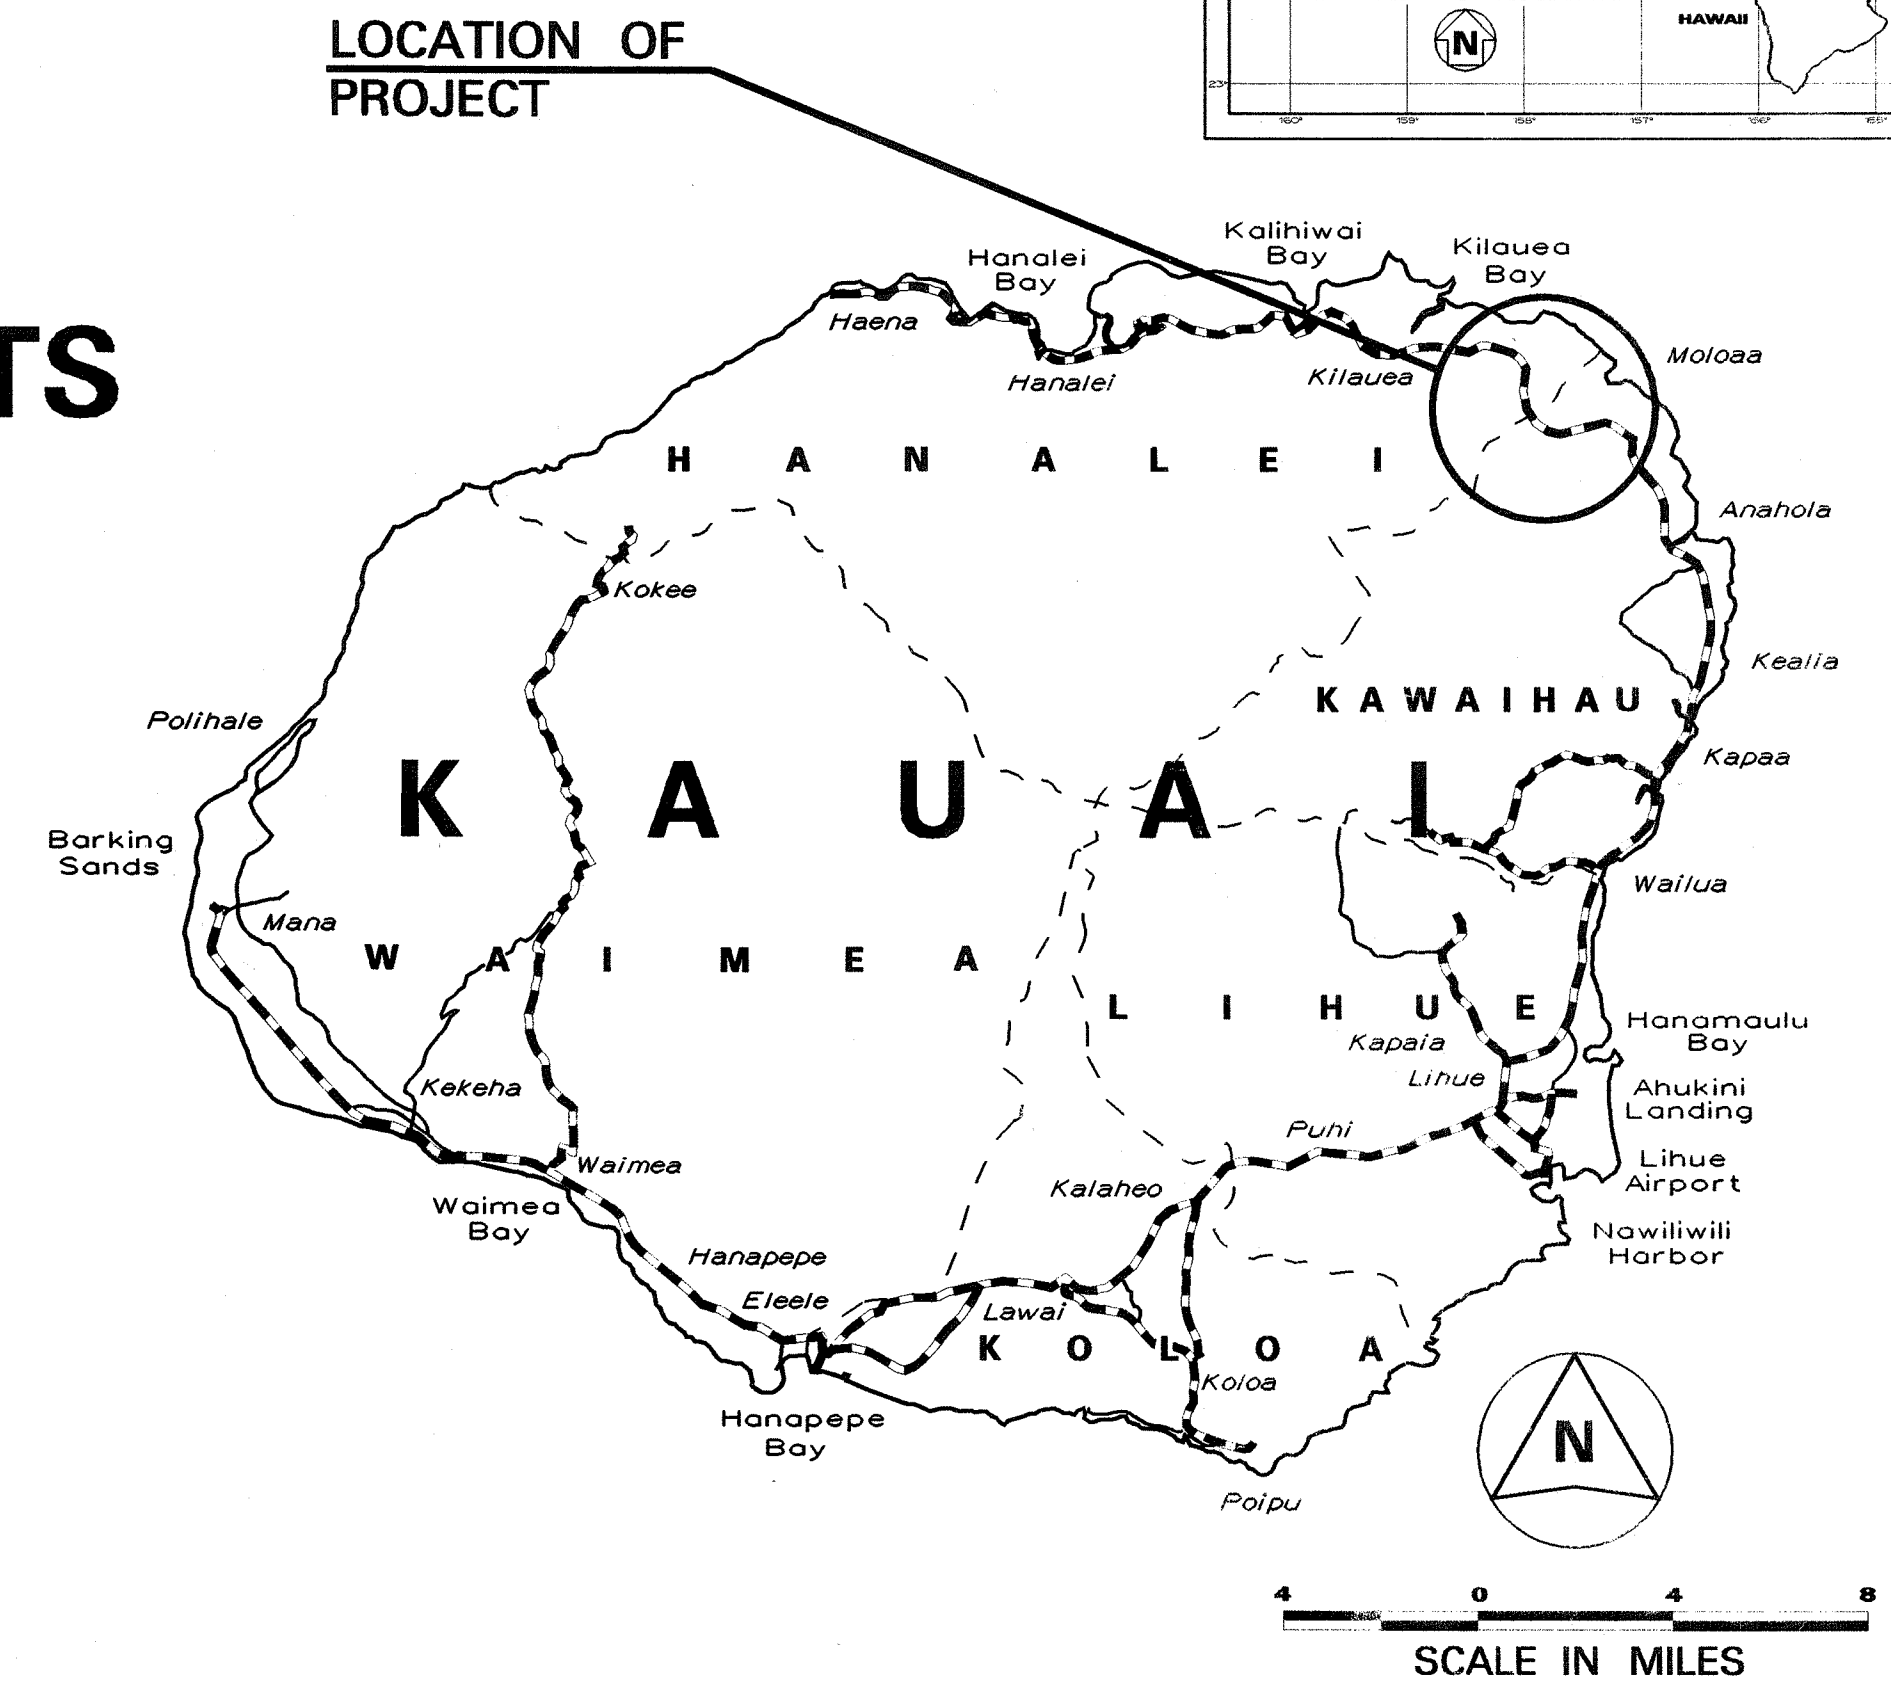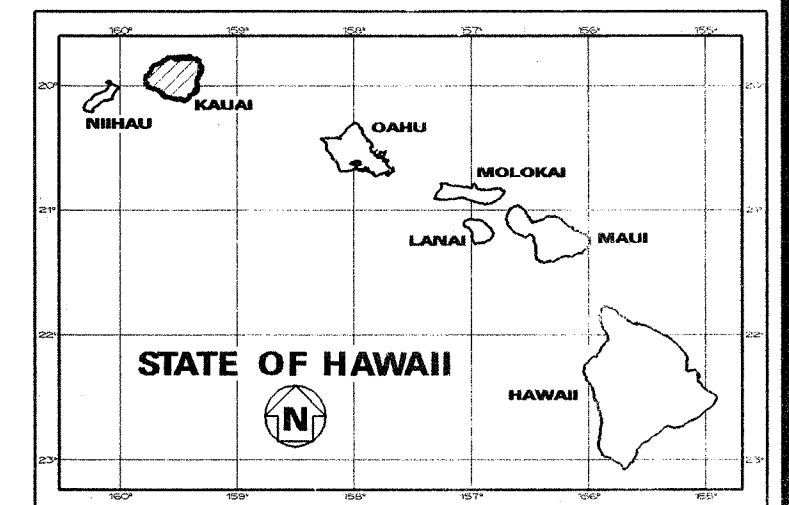

----- FEDERAL AID PROJECTS PREVIOUSLY CONSTRUCTED OR UNDER CONSTRUCTION

MILE POST 18.12 TO MILE POST 18.39

CHANGES MADE DURING CONSTRUCTION HAVE BEEN INCORPORATED ON THESE PLANS EXCEPT CHANGES IN THE ORIGINAL THEORETICAL QUANTITIES. FOR ACTUAL QUANTITIES, REFER TO PROJECT LEDGER AND/OR COMPUTATION BOOK.

[Signature] 9/14/11
RESIDENT ENGINEER DATE

DEPARTMENT OF TRANSPORTATION STATE OF HAWAII	
APPROVED:	
<i>[Signature]</i> DIR. OF TRANSPORTATION	11-9-07 DATE

HWY-DH DESIGNED BY

HWY-DH MANAGED BY

692-7563 PHONE

JUNE 2007 DATE