



FED. ROAD DIST. NO.	STATE	PROJ. NO.	FISCAL YEAR	SHEET NO.	TOTAL SHEETS
HAWAII	HAW.	56A-01-05M	2005	12	25

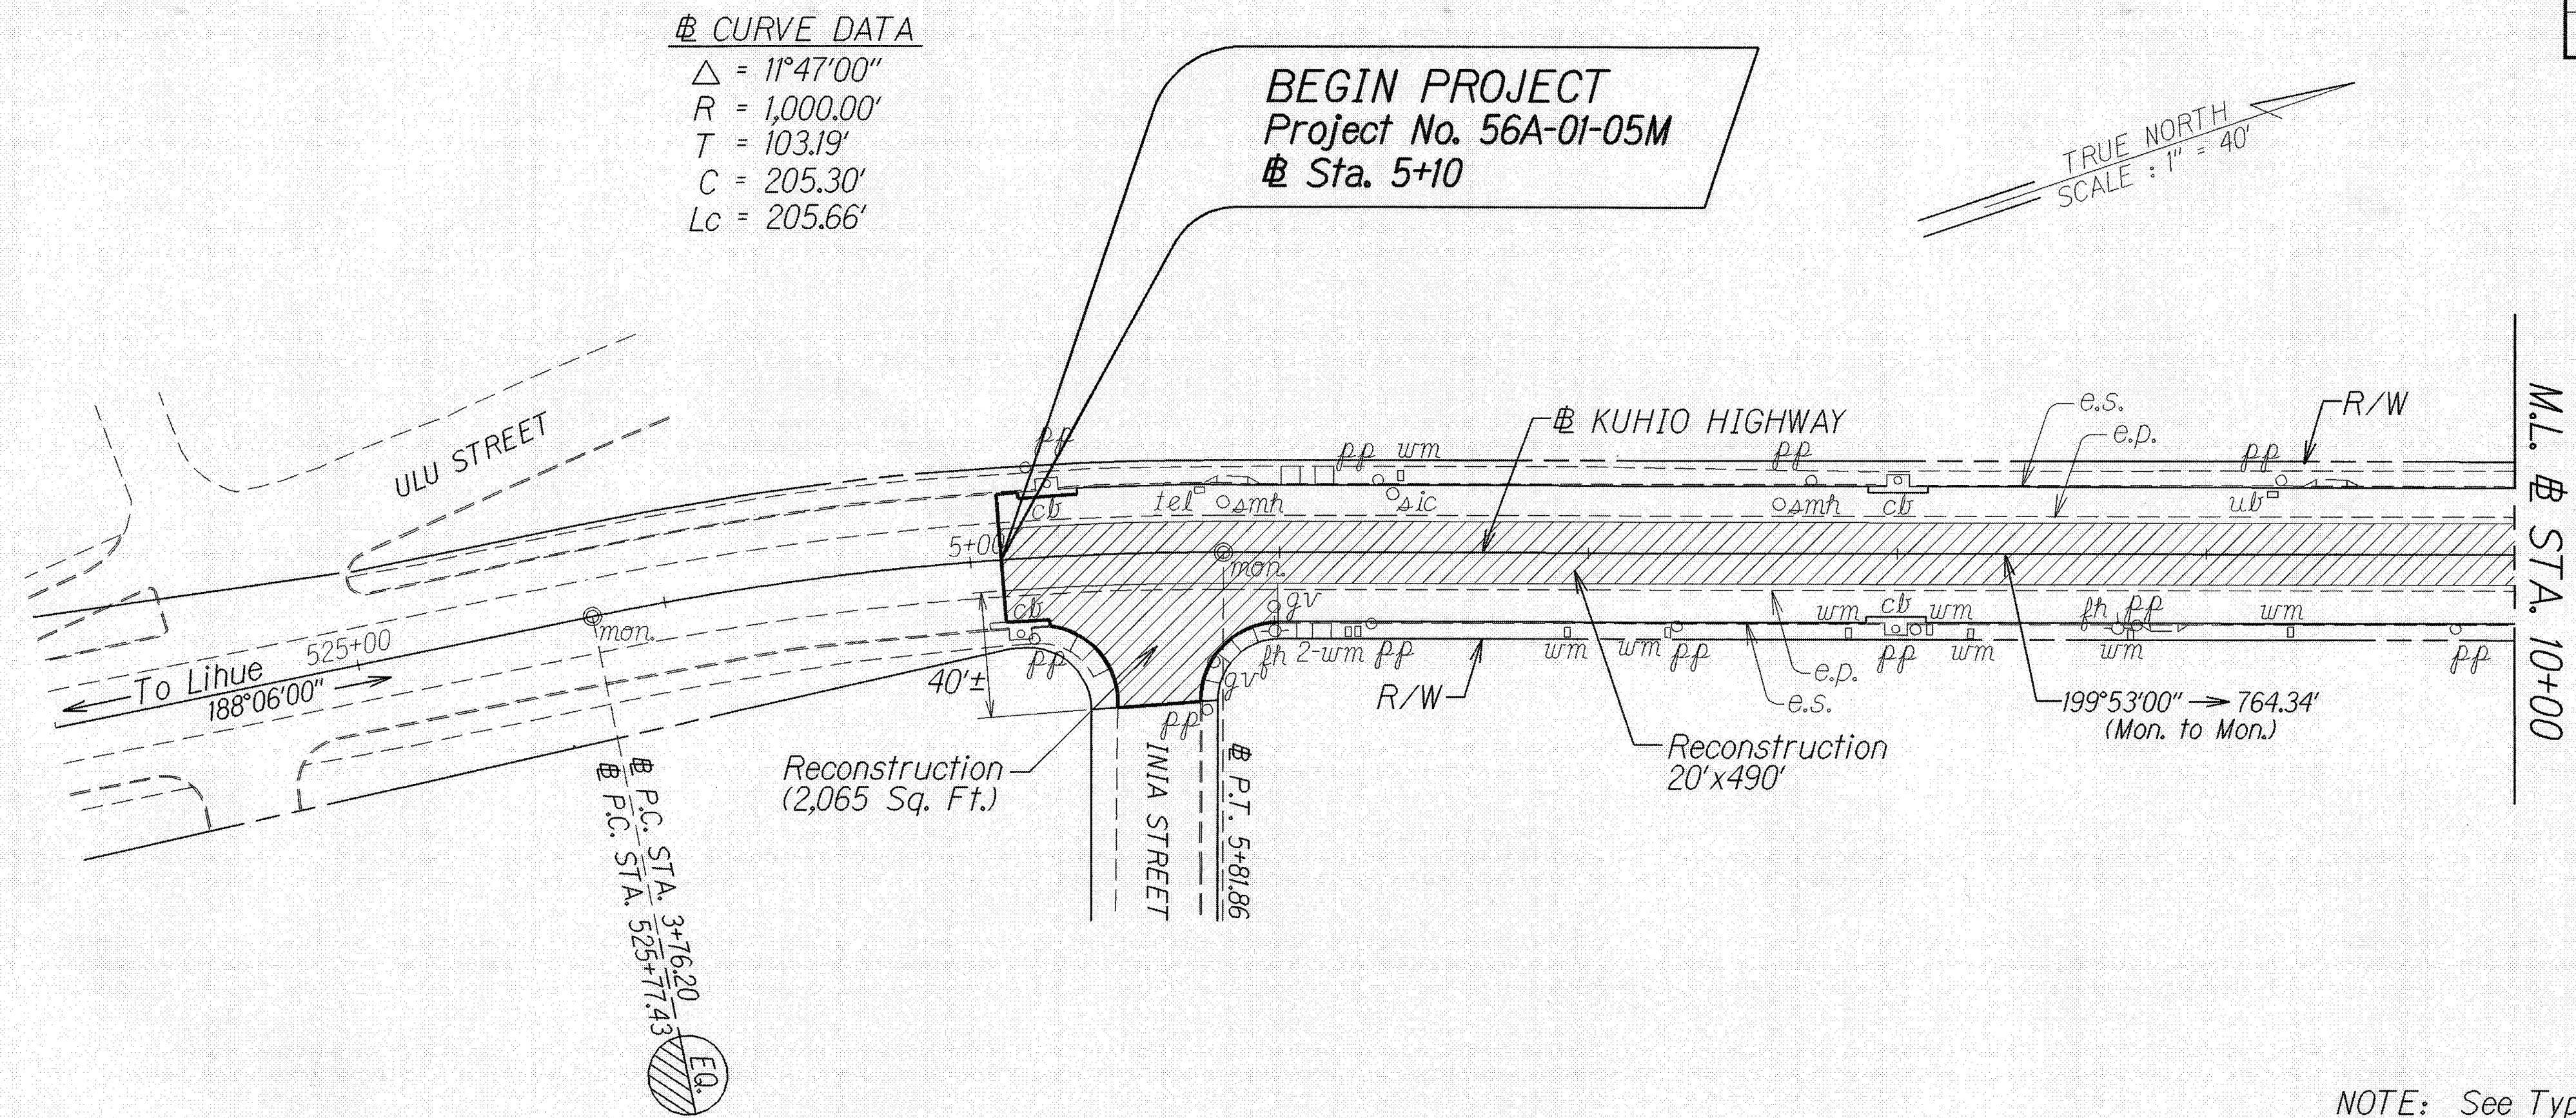

NOTE: See Typical Section on Plan Sht. #6 & #7 for limits of cold-planing.

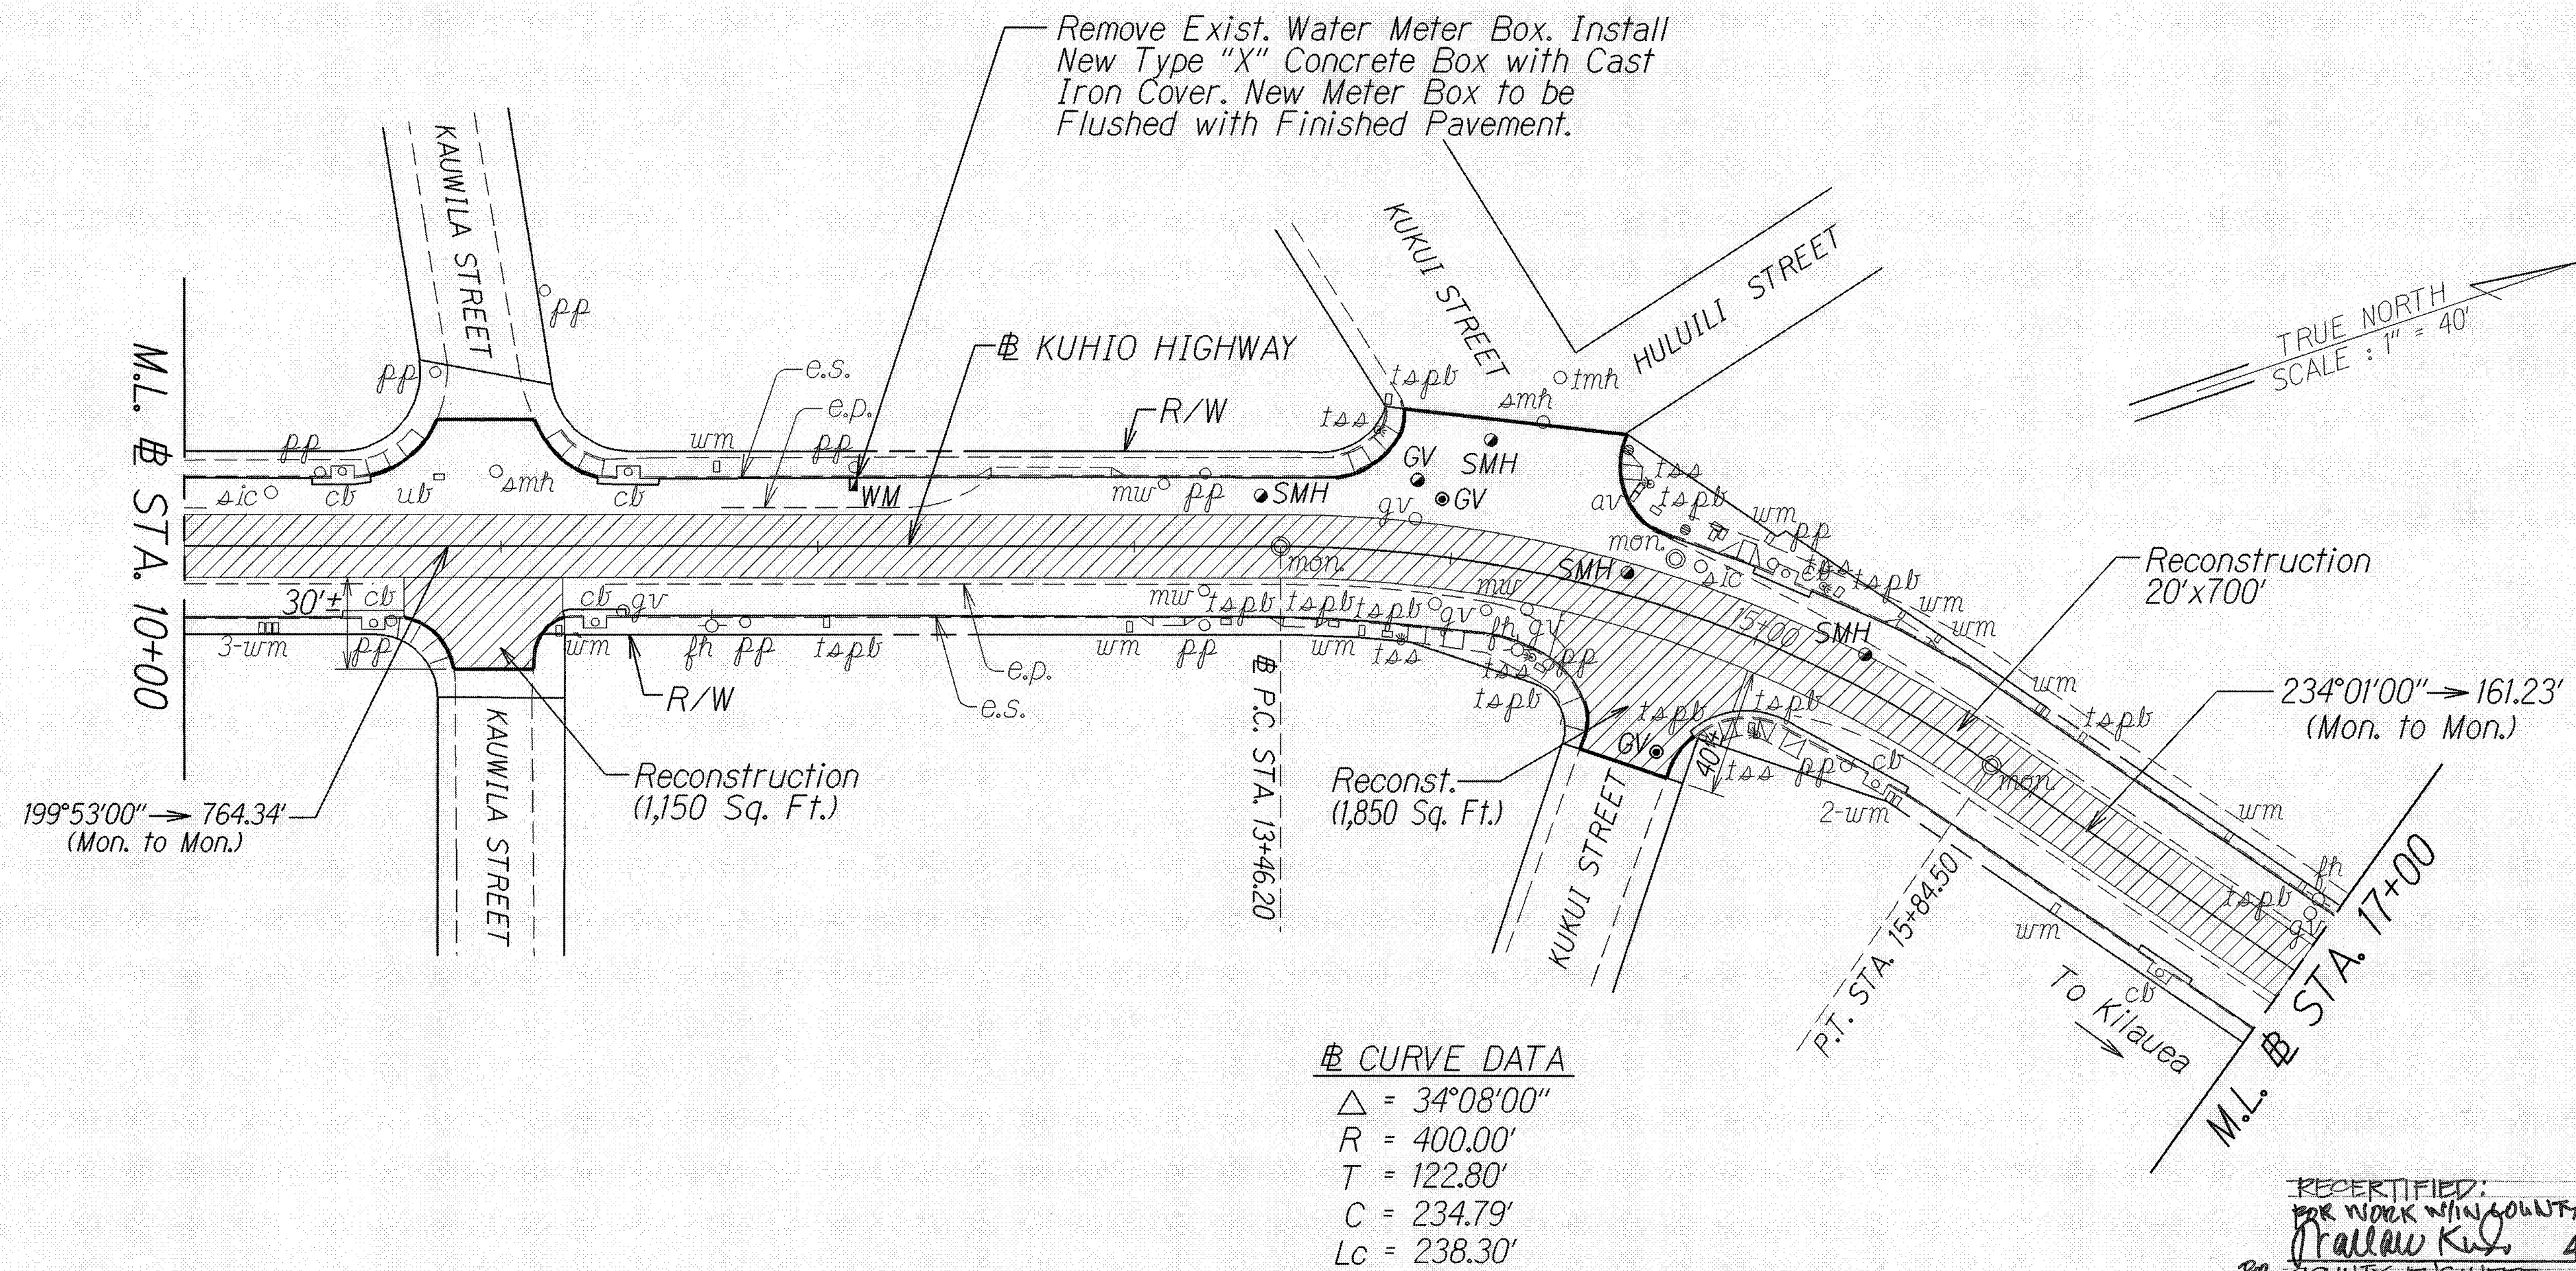

RECERTIFIED:
 Bruce Moya 3/11/08
 FOR MANAGER & CHIEF ENGINEER
 DEPT. OF WATER, COUNTY OF KAUAI DATE

APPROVED:
 U. Moya 4/22/05
 Manager & Chief Engineer
 Department of Water Date

APPROVED: (For Work Within County Right-of-Way Only)
 David A. Moya 4-28-05
 County Engineer Date

STATE OF HAWAII
 DEPARTMENT OF TRANSPORTATION
 HIGHWAYS DIVISION

ROADWAY PLAN


KUHIO HIGHWAY RESURFACING
 Inia Street to Kawaiila Road
 Project No. 56A-01-05M

Scale: 1" = 40' Date: April 2005

SHEET No. 1 OF 3 SHEETS

DATE	_____
SURVEY PLOTTED BY	_____
DRAWN BY	_____
NOTE BOOK	_____
QUANTITIES BY	_____
CHECKED BY	_____
ORIGINAL PLAN	_____
NOTE BOOK	_____
QUANTITIES BY	_____
CHECKED BY	_____

FED. ROAD DIST. NO.	STATE	PROJ. NO.	FISCAL YEAR	SHEET NO.	TOTAL SHEETS
HAWAII	HAW.	56A-01-05M	2005	13	25

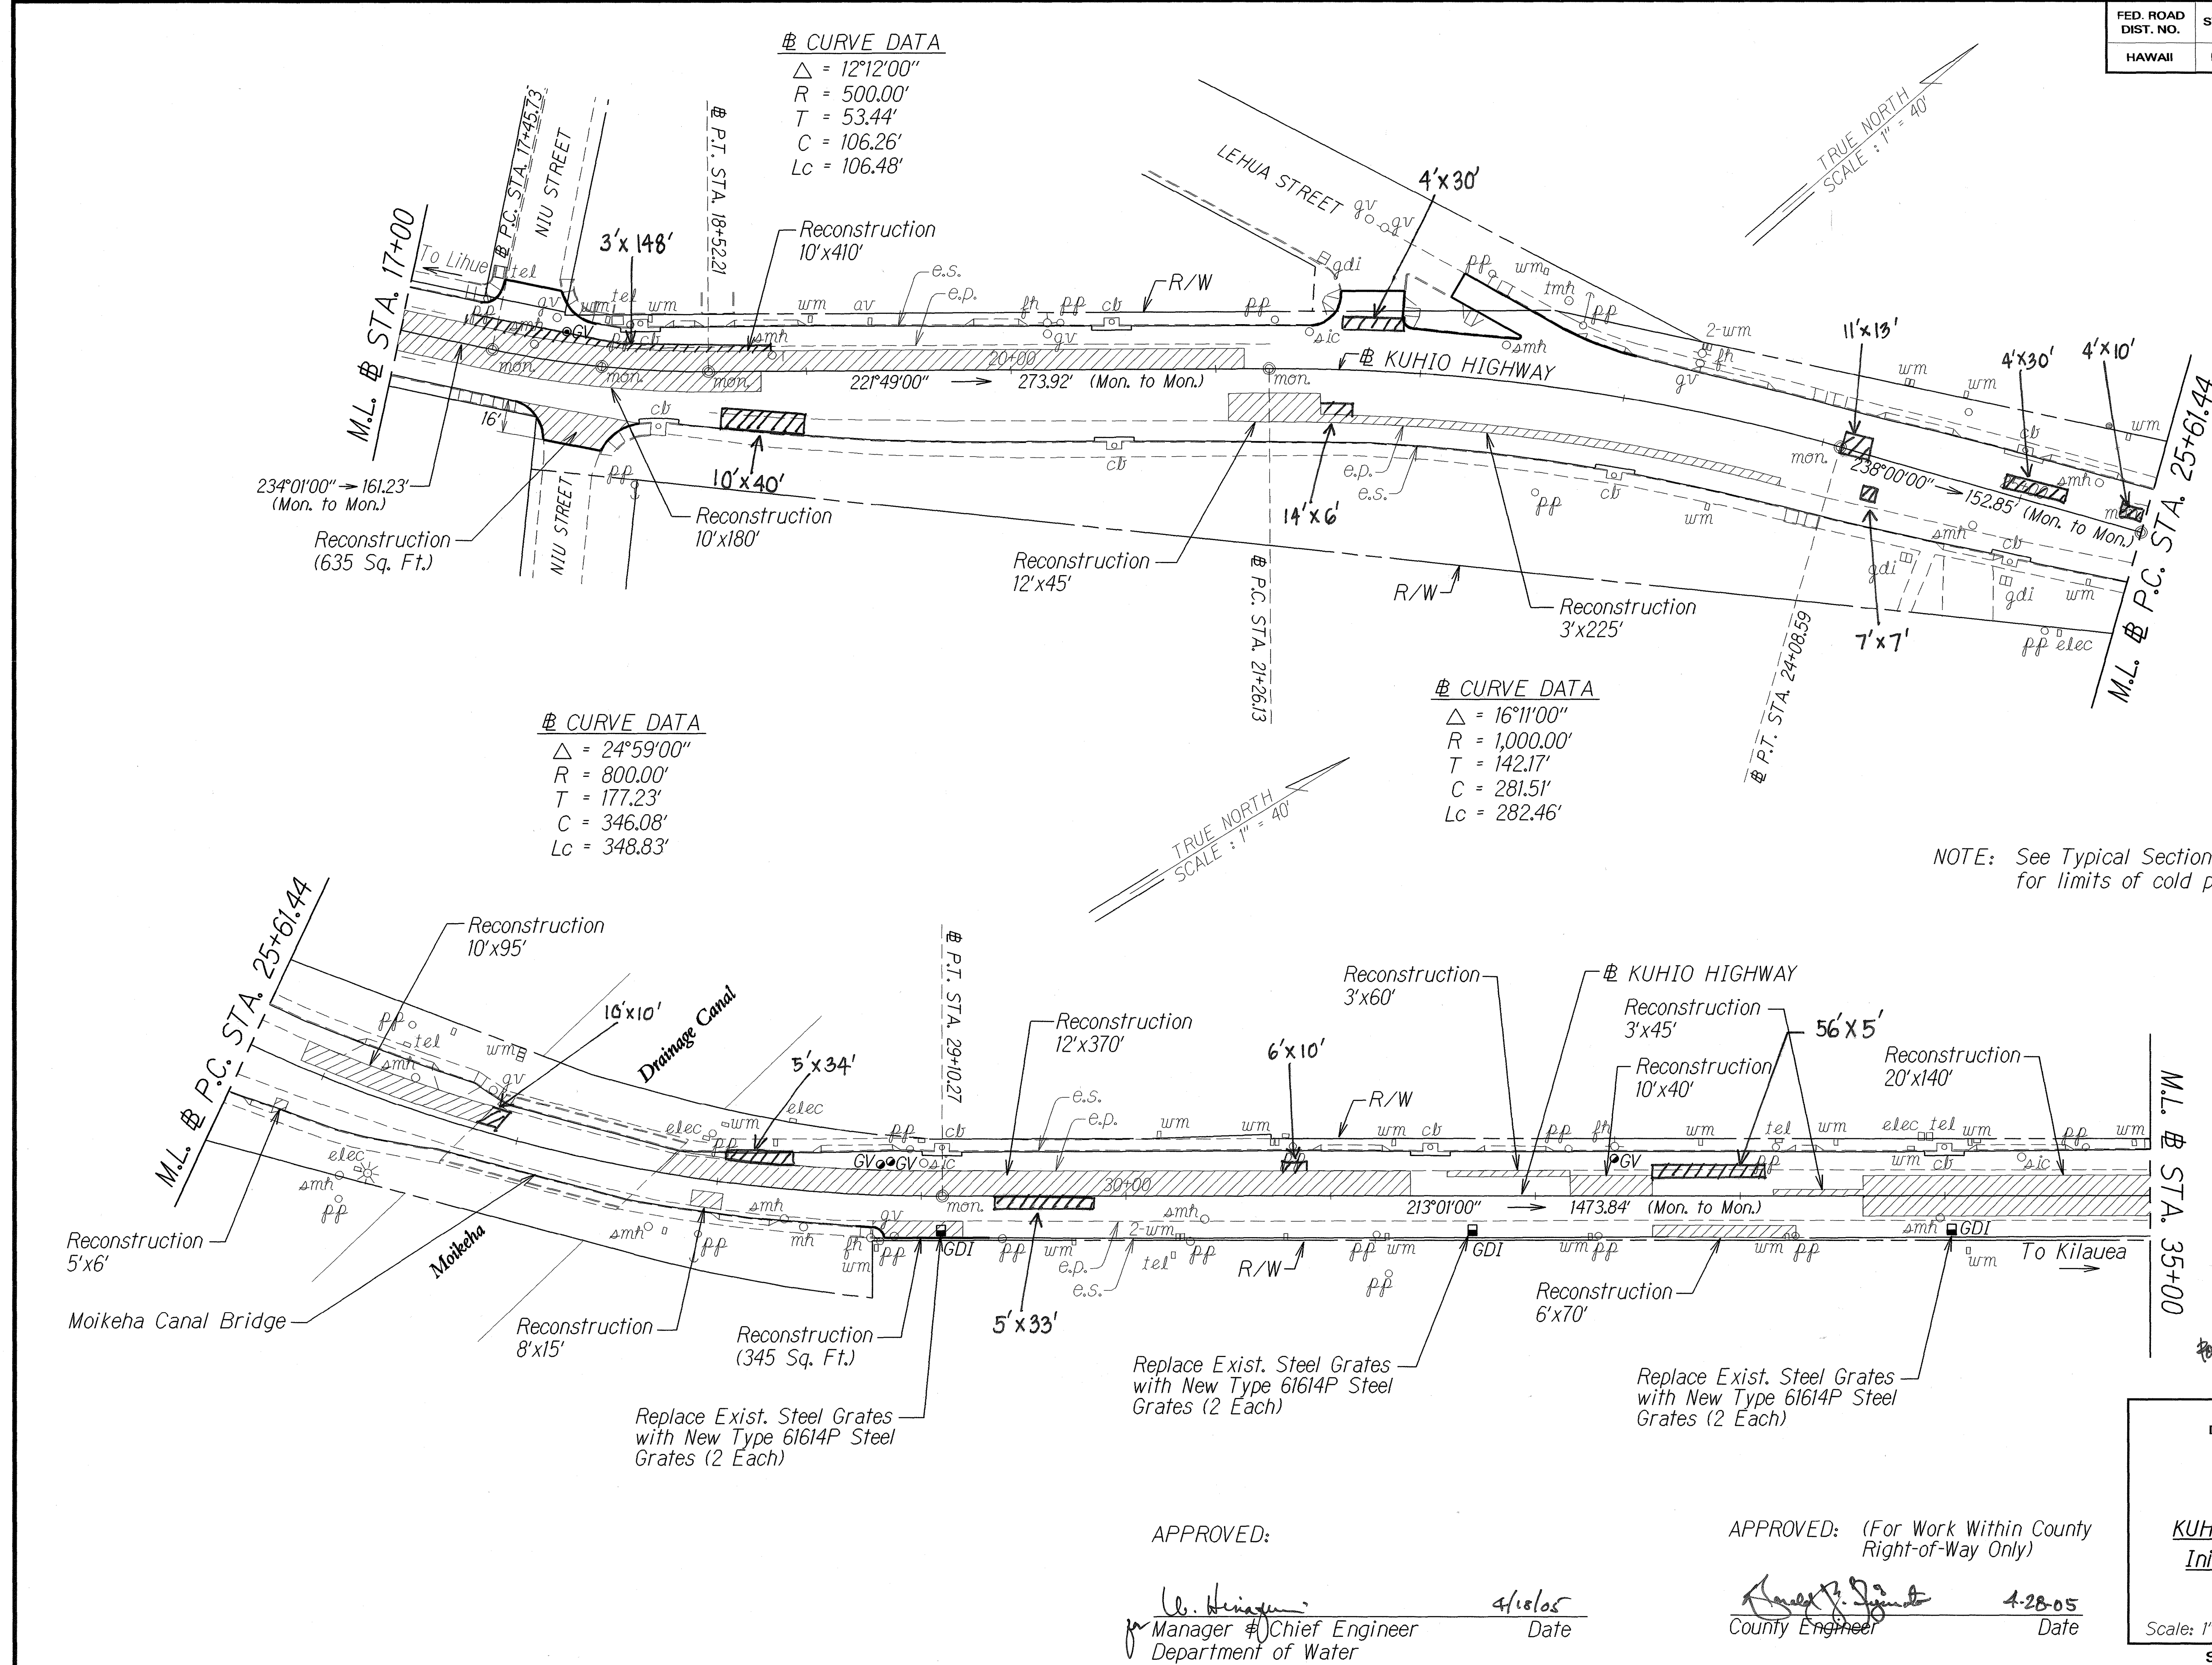

NOTE: See Typical Section on Plan Sht. #6 & #7 for limits of cold planing.

DATE	_____
SURVEY PLOTTED BY	_____
DRAWN BY	_____
TRACED BY	_____
NOTED BY	_____
CHECKED BY	_____

RECEIVED:
 Bruce Inoué 3/11/08
 FOR MANAGER & CHIEF ENGINEER
 DEPT. OF WATER, COUNTY OF KAUAI
 Date
 For Dr. Alan K. Kuo 4/1/08
 COUNTY ENGINEER
 FOR WORK WITHIN COUNTY R/W
 Date

APPROVED: _____ 4/18/05 Date
 Manager & Chief Engineer
 Department of Water

APPROVED: (For Work Within County Right-of-Way Only)
 _____ 4-28-05 Date
 County Engineer

STATE OF HAWAII
DEPARTMENT OF TRANSPORTATION
HIGHWAYS DIVISION
ROAD PLAN
KUHIO HIGHWAY RESURFACING
Inia Street to Kawaihau Road
Project No. 56A-01-05M

Scale: 1" = 40'
Date: April 2005
SHEET No. 2 OF 3 SHEETS

"AS-BUILT"

