


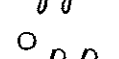
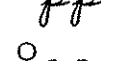
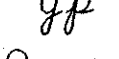

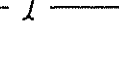
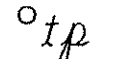



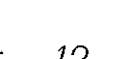
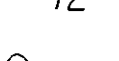
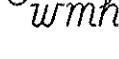
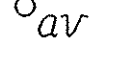
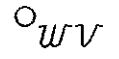

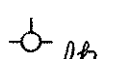
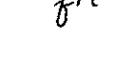

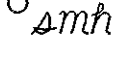

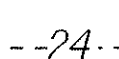
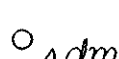
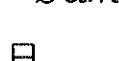




GENERAL NOTES

FED. ROAD DIST. NO.	STATE	PROJ. NO.	FISCAL YEAR	SHEET NO.	TOTAL SHEETS
HAWAII	HAW.	56B-01-06M	2006	3	14

LEGEND

	Existing Guardrail
	New Guardrail
	Existing Joint Pole
	Existing Power Pole
	Existing Guy Pole
	Existing Electric Manhole
	Existing Telephone Line
	Existing Telephone Pole
	Existing Telephone Manhole
	Existing TV Cable
	Existing Fiber Optic Duct Line
	Existing 12" Water Line
	Existing Water Manhole
	Existing Water Air Valve
	Existing Water Valve Box
	Existing Water Meter
	Existing Fire Hydrant
	Existing Sewer Line
	Existing Sewer Manhole
	Existing Monument
	Existing 24" Drain Line
	Existing Storm Drain Manhole
	Existing Grated Drop Inlet
	Existing Traffic Sign
	existing edge of pavement
	existing edge of shoulder
	New edge of pavement
	New edge of shoulder

1. The scope of work for this project consists of erecting work access and debris platform, repairing cracks, spalls, and reinforcing steel on concrete bridges, and installing galvanic anodes.

2. The Contractor is reminded of the requirements of Subsection 108.01 - Subletting of Contract, which requires him to perform work amounting to not less than 30 percent of the total contract cost less deductible items. Non-compliance with this Subsection may be grounds for rejection of bid.

3. The Contractor's attention is directed to the following Sections of the Special Provisions: Subsection 107.13 - Public Convenience and Safety, Subsection 107.21 - Contractor's Responsibility for Utility Property and Services, and Section 645 - Traffic Control.

4. All lanes shall be open to traffic during morning peak hours from 6:30 A.M. to 8:30 A.M., during afternoon peak hours from 3:30 P.M. to 6:00 P.M. and during off work hours. Only one lane of highway shall be closed at any other time. Failure of the Contractor to open all lanes of traffic during the times specified above shall result in assessment of liquidated damages as specified in Section 108.08 of the Special Provisions.

5. The Contractor shall make every endeavor, using certified flaggers to ensure that the speed on the bridge is reduced to 25 miles per hour or less during concrete mortar placement and until initial set (approximately 4 hours.) The Contractor shall submit traffic plan to the Engineer two weeks prior to start of work.

6. At the end of each day's work, the Contractor shall remove all equipment and other obstructions to permit free and safe passage of public traffic.

7. The existence and location of underground utilities, manholes, monuments and structures as shown on the plans are from the latest available data but the accuracy is not guaranteed. The encountering of other obstacles during the course of the work is possible. The Contractor shall tone for the exact locations and depths of all underground facilities, either shown on or omitted from the plans, in areas where work, such as the placement of guardrail posts, sign posts, etc. may affect these properties. Toning shall be considered incidental to the various contract items and will not be paid for separately. The Contractor shall be held liable for any damages incurred to the existing facilities and/or improvements as a result of his operations.

8. The Contractor shall notify the Engineer in writing, two (2) weeks prior to starting paving operations.

9. Existing drainage systems shall remain functional at all times during construction. The Contractor is to furnish materials, equipment, labor, tools and incidentals necessary to maintain flow. This work shall be considered incidental to the various contract items.

10. The Contractor shall provide for access to and from all existing side streets cross streets and driveways at all times. Providing and maintaining this access shall be considered incidental to the various contract items.

11. The deck mounted Thrie Beam and Bikeway Metal Railing shown on the plans is in place. Removal and reinstallation of these rails to accommodate bridge repair shall be considered incidental to the repair work. Any section of bridge where removed rail is not replaced at the end of the days work shall be shielded by portable barriers. Any railing damaged by the contractor shall be replaced with new railing at the contractor's expense.

12. No section of incomplete guardrail shall be left unshielded at the end of each day. Open sections shall be shielded by portable physical barriers. Furnishing, placing and maintaining physical barriers shall be considered incidental to other contract items.

13. During working hours, open sections shall be delineated by placing Type II Barricades with flashers @ 40' O. C. and traffic cones @ 10' O. C. between barricades. Furnishing, placing and maintaining barricades and cones shall be considered incidental to other contract items.

14. Unless noted to be removed and/or replaced, all existing signs shall remain. The Contractor shall replace any signs damaged during the course of construction at no cost to the State. The Contractor may elect to remove signs for the convenience of work. Removed signs shall be reinstalled at the end of each day's work and such removal and replacement shall be at no cost to the State.

15. The Contractor shall be solely responsible for the protection of adjacent properties, utilities and existing structures from damages due to construction. Repairing any damage shall be at the Contractor's own expense, to the satisfaction of the Engineer.

16. The Contractor shall provide and maintain for access to and from all existing driveways, sidewalks and ADA access routes, and side streets and cross streets at all times. This work shall be considered incidental to the various contract items and will not be paid for separately.

17. Removal and disposal of all debris from construction activities shall be considered incidental to their respective bid items.

18. No material and/or equipment shall be stockpiled or otherwise stored within the highway right-of-way except at locations designated in writing and approved by the Engineer. If use of location is approved by the Engineer, the Contractor shall obtain a permit for Occupancy and Use of State Right-of-Way from the Highways Division, Kauai District Office (Tel. No. 241-3000).

19. It shall be the Contractor's responsibility to keep noise generated by construction activities below the maximum permissible allowed for any particular time and location. If maximums will be exceeded, the Contractor shall apply for a Community Noise Variance from the State Department of Health.

20. The Contractor shall carefully review the plans, specifications and proposal and notify the State within ten (10) working days before bid opening of any discrepancies between the plans and bid proposal. All work specified in the contract but not listed separately in the proposal schedule shall be considered incidental to other various contract items and shall not be paid for separately.

ORIGINAL PLAN	SURVEY PLOTTED BY	DATE
NOTE BOOK	DRAWN BY	6/24
REVISION	DESIGNED BY	
QUANTITIES BY	CHECKED BY	
NOTED BY		

STATE OF HAWAII
DEPARTMENT OF TRANSPORTATION
HIGHWAYS DIVISION
GENERAL NOTES AND LEGEND

KUHIO HIGHWAY
Spall Repairs at Kapaa Stream Bridge
Project No. 56B-01-06M

Date: May 2006