


FED. ROAD DIST. NO.	STATE	PROJ. NO.	FISCAL YEAR	SHEET NO.	TOTAL SHEETS
HAWAII	HAW.	56B-01-06M	2006	14	14

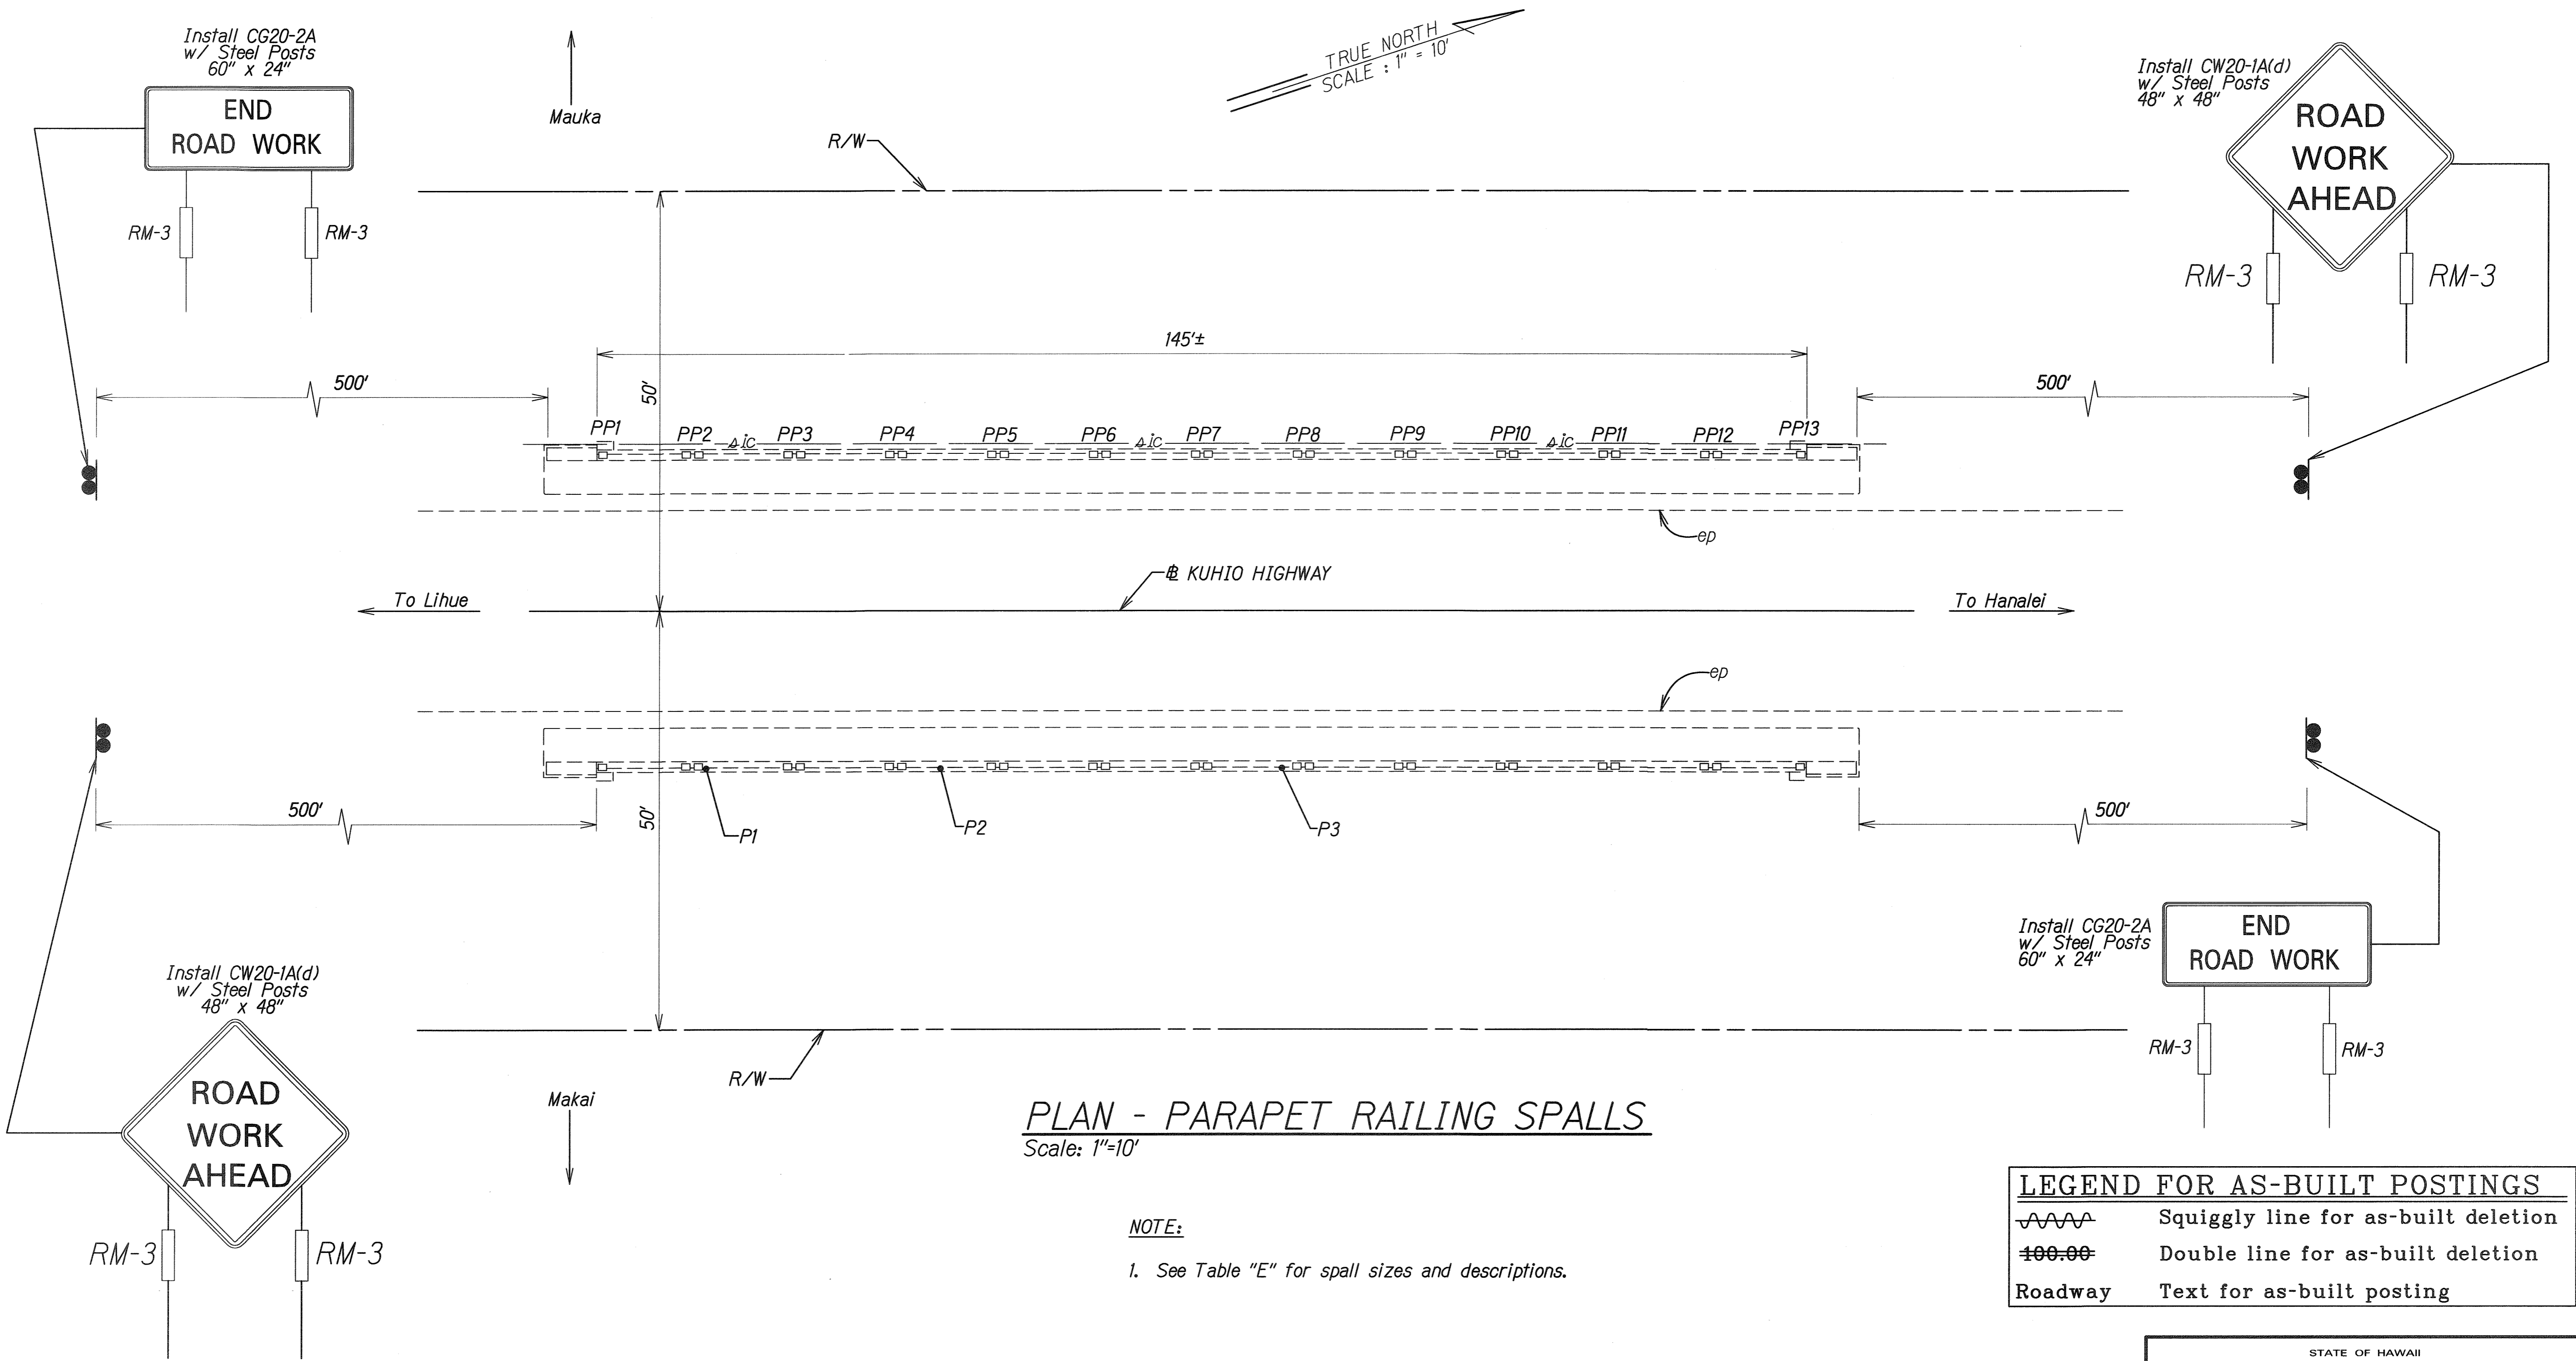

DATE	10/1/06
DESIGNED BY	10/1/06
TRACED BY	10/1/06
NOTED BY	10/1/06
QUANTITIES BY	10/1/06
CHECKED BY	10/1/06

PLAN - PARAPET RAILING SPALLS
Scale: 1"=10'

- NOTE:**
- See Table "E" for spall sizes and descriptions.

Spall No.	Spall Size (ft x ft)	Area (sf)	Span	Location / Remarks
P1	1.0 1.0	1.0	1	between PP2 and PP3
P2	7.0 1.0	7.0	1	between PP4 and PP5, bottom corner
P3	3.0 1.0	3.0	2	between PP7 and PP8

STATE OF HAWAII
DEPARTMENT OF TRANSPORTATION
HIGHWAYS DIVISION

PARAPET RAILING SPALLS
CONSTRUCTION SIGN PLAN
KUHIO HIGHWAY
Spall Repairs at Kapaa Stream Bridge
Project No. 56B-01-06M
Scale: 1" = 10' Date: May 2006

SHEET No. 1 OF 1 SHEETS