

INDEX TO DRAWINGS	
SHEET NO.	DESCRIPTION
1	TITLE SHEET
2	STANDARD PLANS SUMMARY
3	GENERAL NOTES AND LEGEND
4 - 5	WATER POLLUTION AND EROSION CONTROL NOTES
6	CONCRETE REPAIR DETAILS AND NOTES
7	TYPICAL BRIDGE DECK SECTION
8 - 13	SPALL REPAIR PLANS
14	SPALL REPAIR PLAN - PARAPET RAILING
10S-1-10S-2	SPALL REPAIR PLANS NOTE: ADDED DURING TIME OF AS-BUILT

STATE OF HAWAII

DEPARTMENT OF TRANSPORTATION

HIGHWAYS DIVISION

HONOLULU, HAWAII

"AS-BUILT"

PLANS FOR

KUHIO HIGHWAY


SPALL REPAIRS AT KAPAA STREAM BRIDGE

VICINITY OF KEALIA

PROJECT NO. 56B-01-06M



DISTRICT OF KAWAIIHAU

ISLAND OF KAUAI



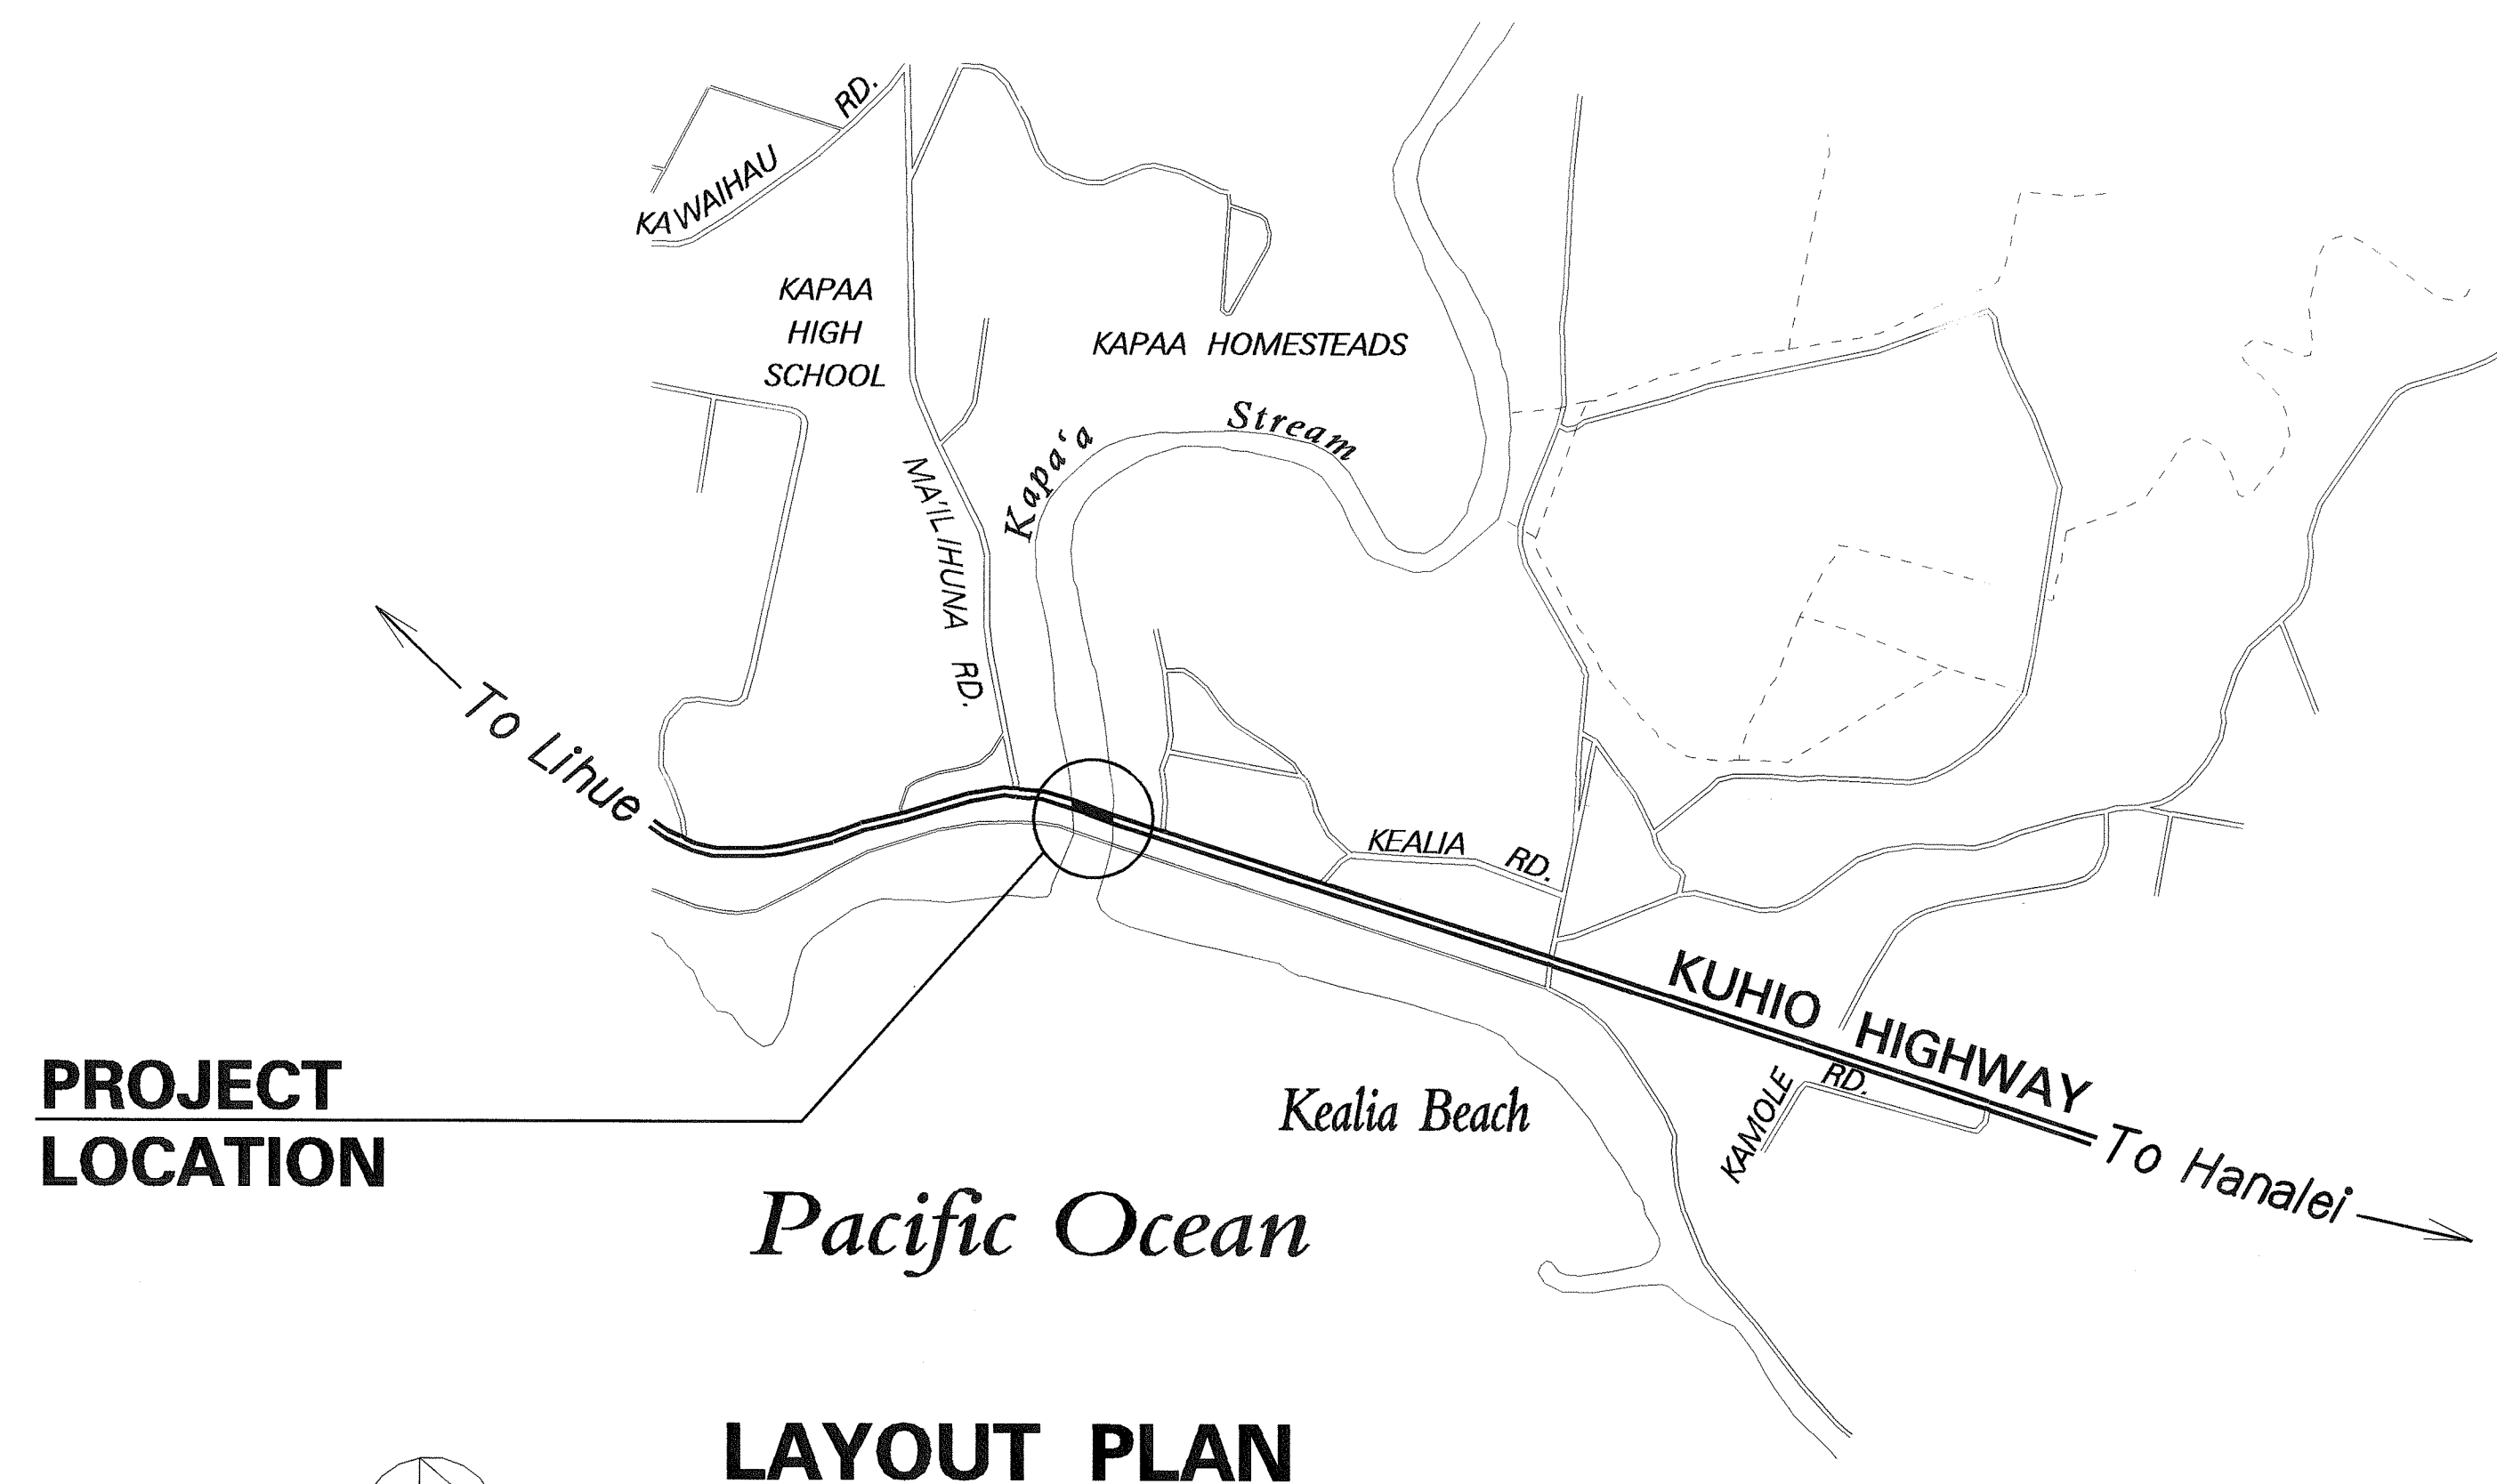


PROJECT
LOCATION

LAYOUT PLAN

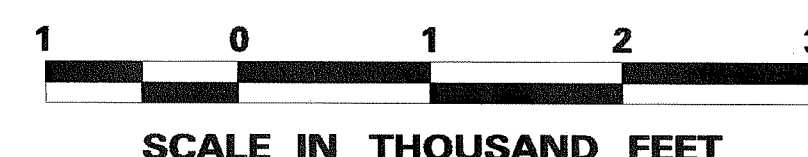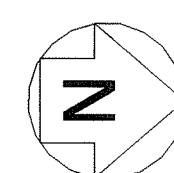

FED. ROAD DIST. NO.	STATE	PROJ. NO.	FISCAL YEAR	SHEET NO.	TOTAL SHEETS
HAWAII	HAW.	56B-01-06M	2006	1	14

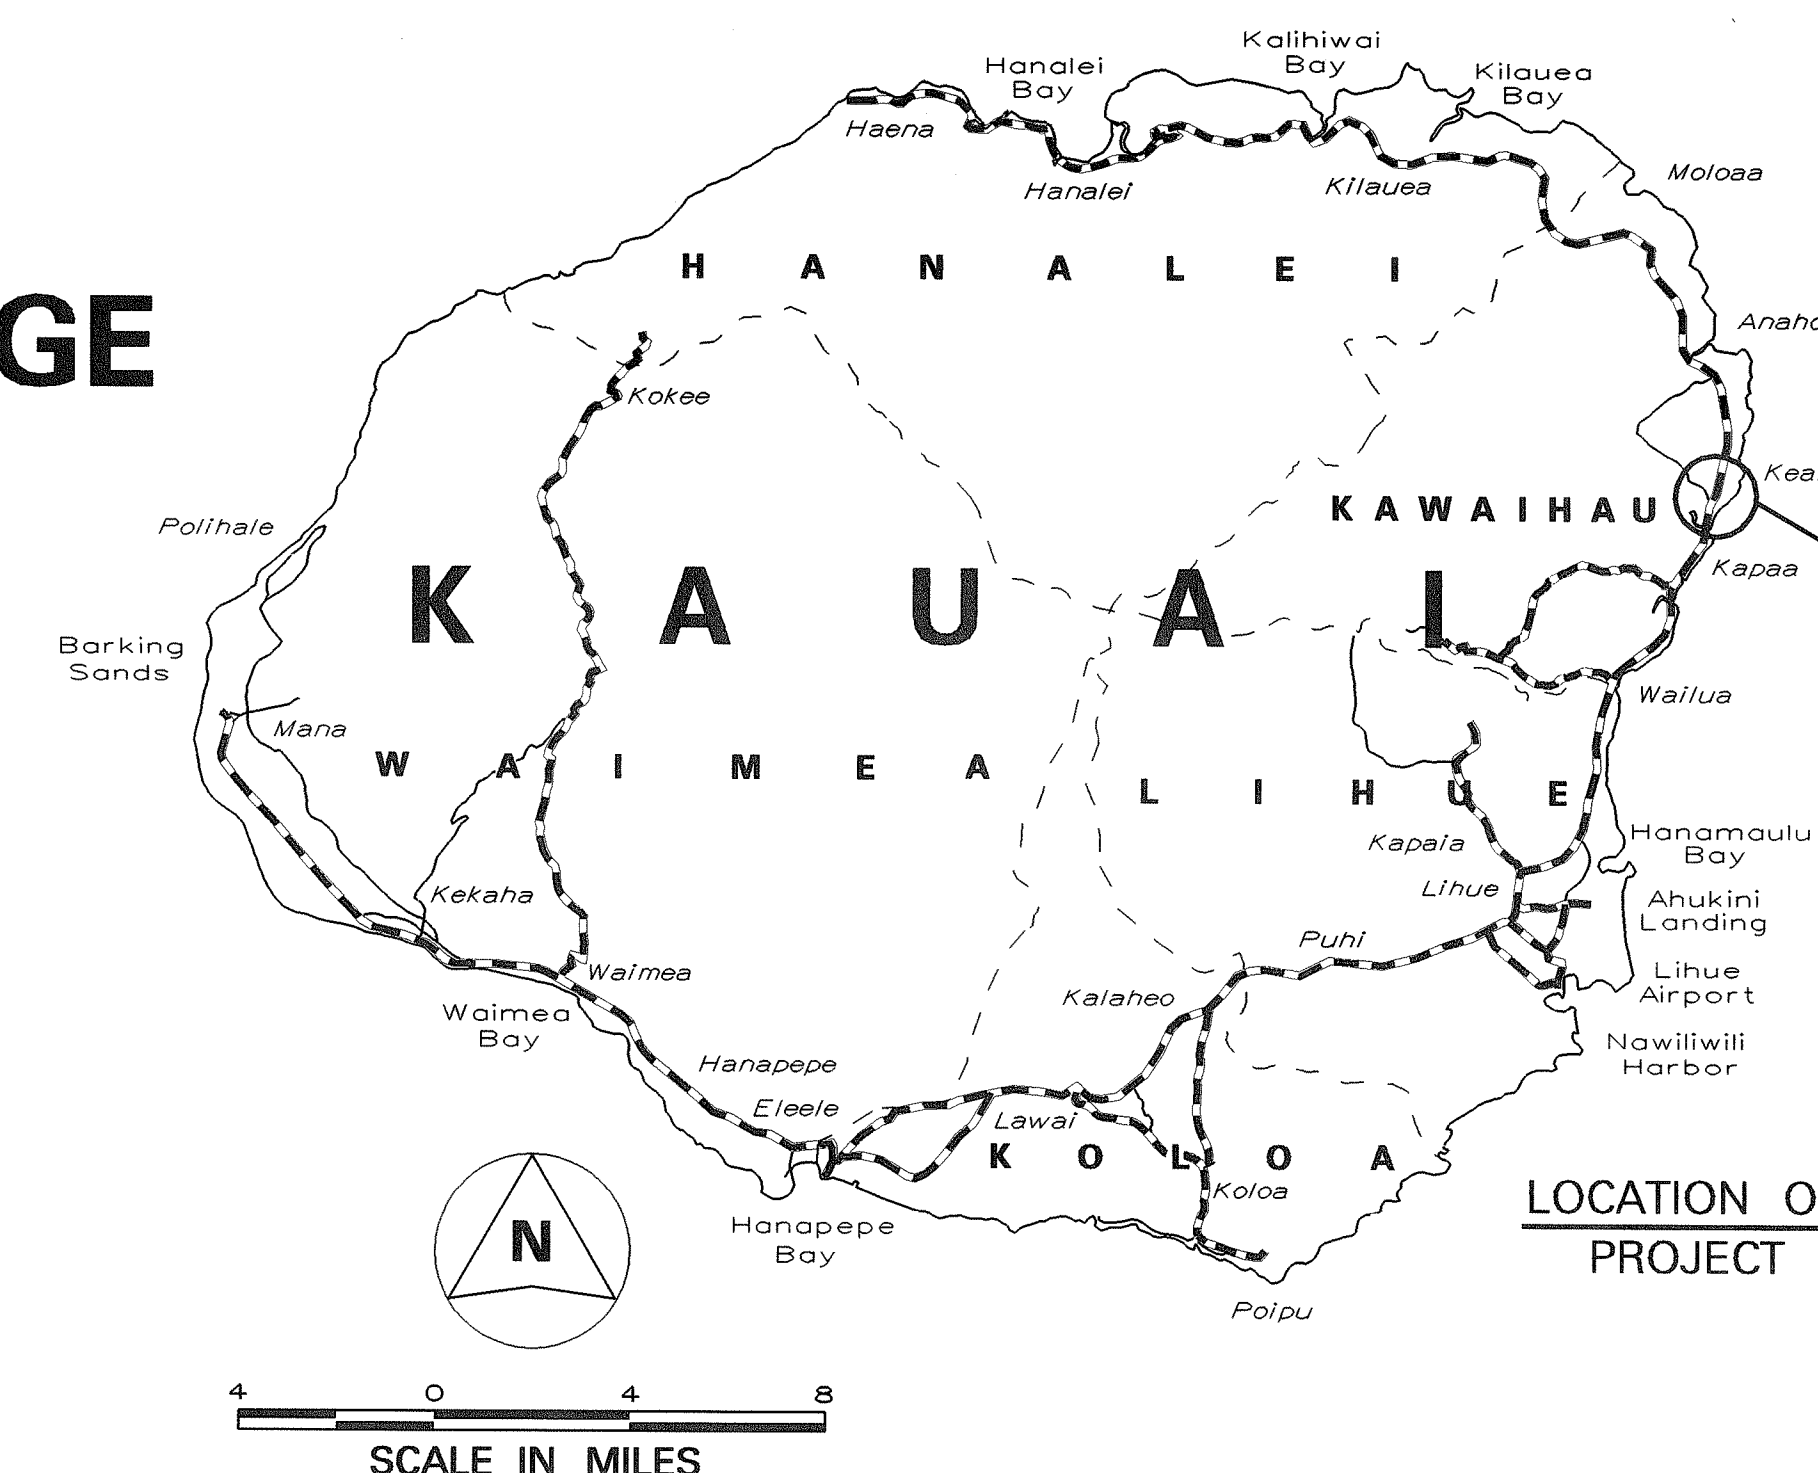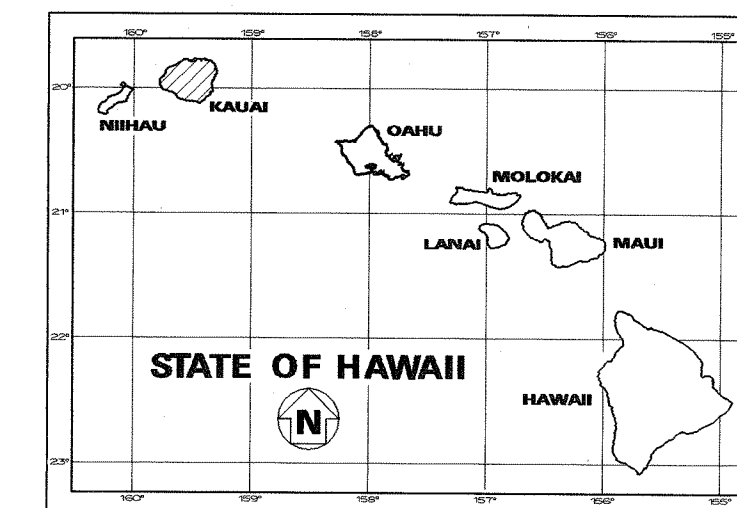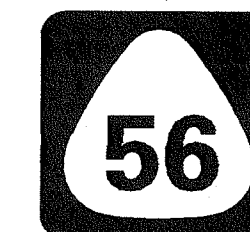

----- FEDERAL AID PROJECTS PREVIOUSLY CONSTRUCTED OR UNDER CONSTRUCTION

MILE POST 9.88 TO MILE POST 9.91

CHANGES MADE DURING CONSTRUCTION HAVE BEEN INCORPORATED ON THESE PLANS EXCEPT CHANGES IN THE ORIGINAL THEORETICAL QUANTITIES. FOR ACTUAL QUANTITIES, REFER TO PROJECT LEDGER AND/OR COMPUTATION BOOK.

[Signature] 6/24/10
RESIDENT ENGINEER DATE

DEPARTMENT OF TRANSPORTATION
STATE OF HAWAII

APPROVED: *[Signature]* 5-1-06
DIR. OF TRANSPORTATION DATE

DESIGNED BY
MANAGED BY
HWY-KE
241-3000
PHONE
MAY 2006
DATE