


FED. ROAD DIST. NO.	STATE	FED-AID PROJ. NO.	FISCAL YEAR	SHEET NO.	TOTAL SHEETS
HAWAII	HAW.	ER-14(3)	2008	ADD. 8	18

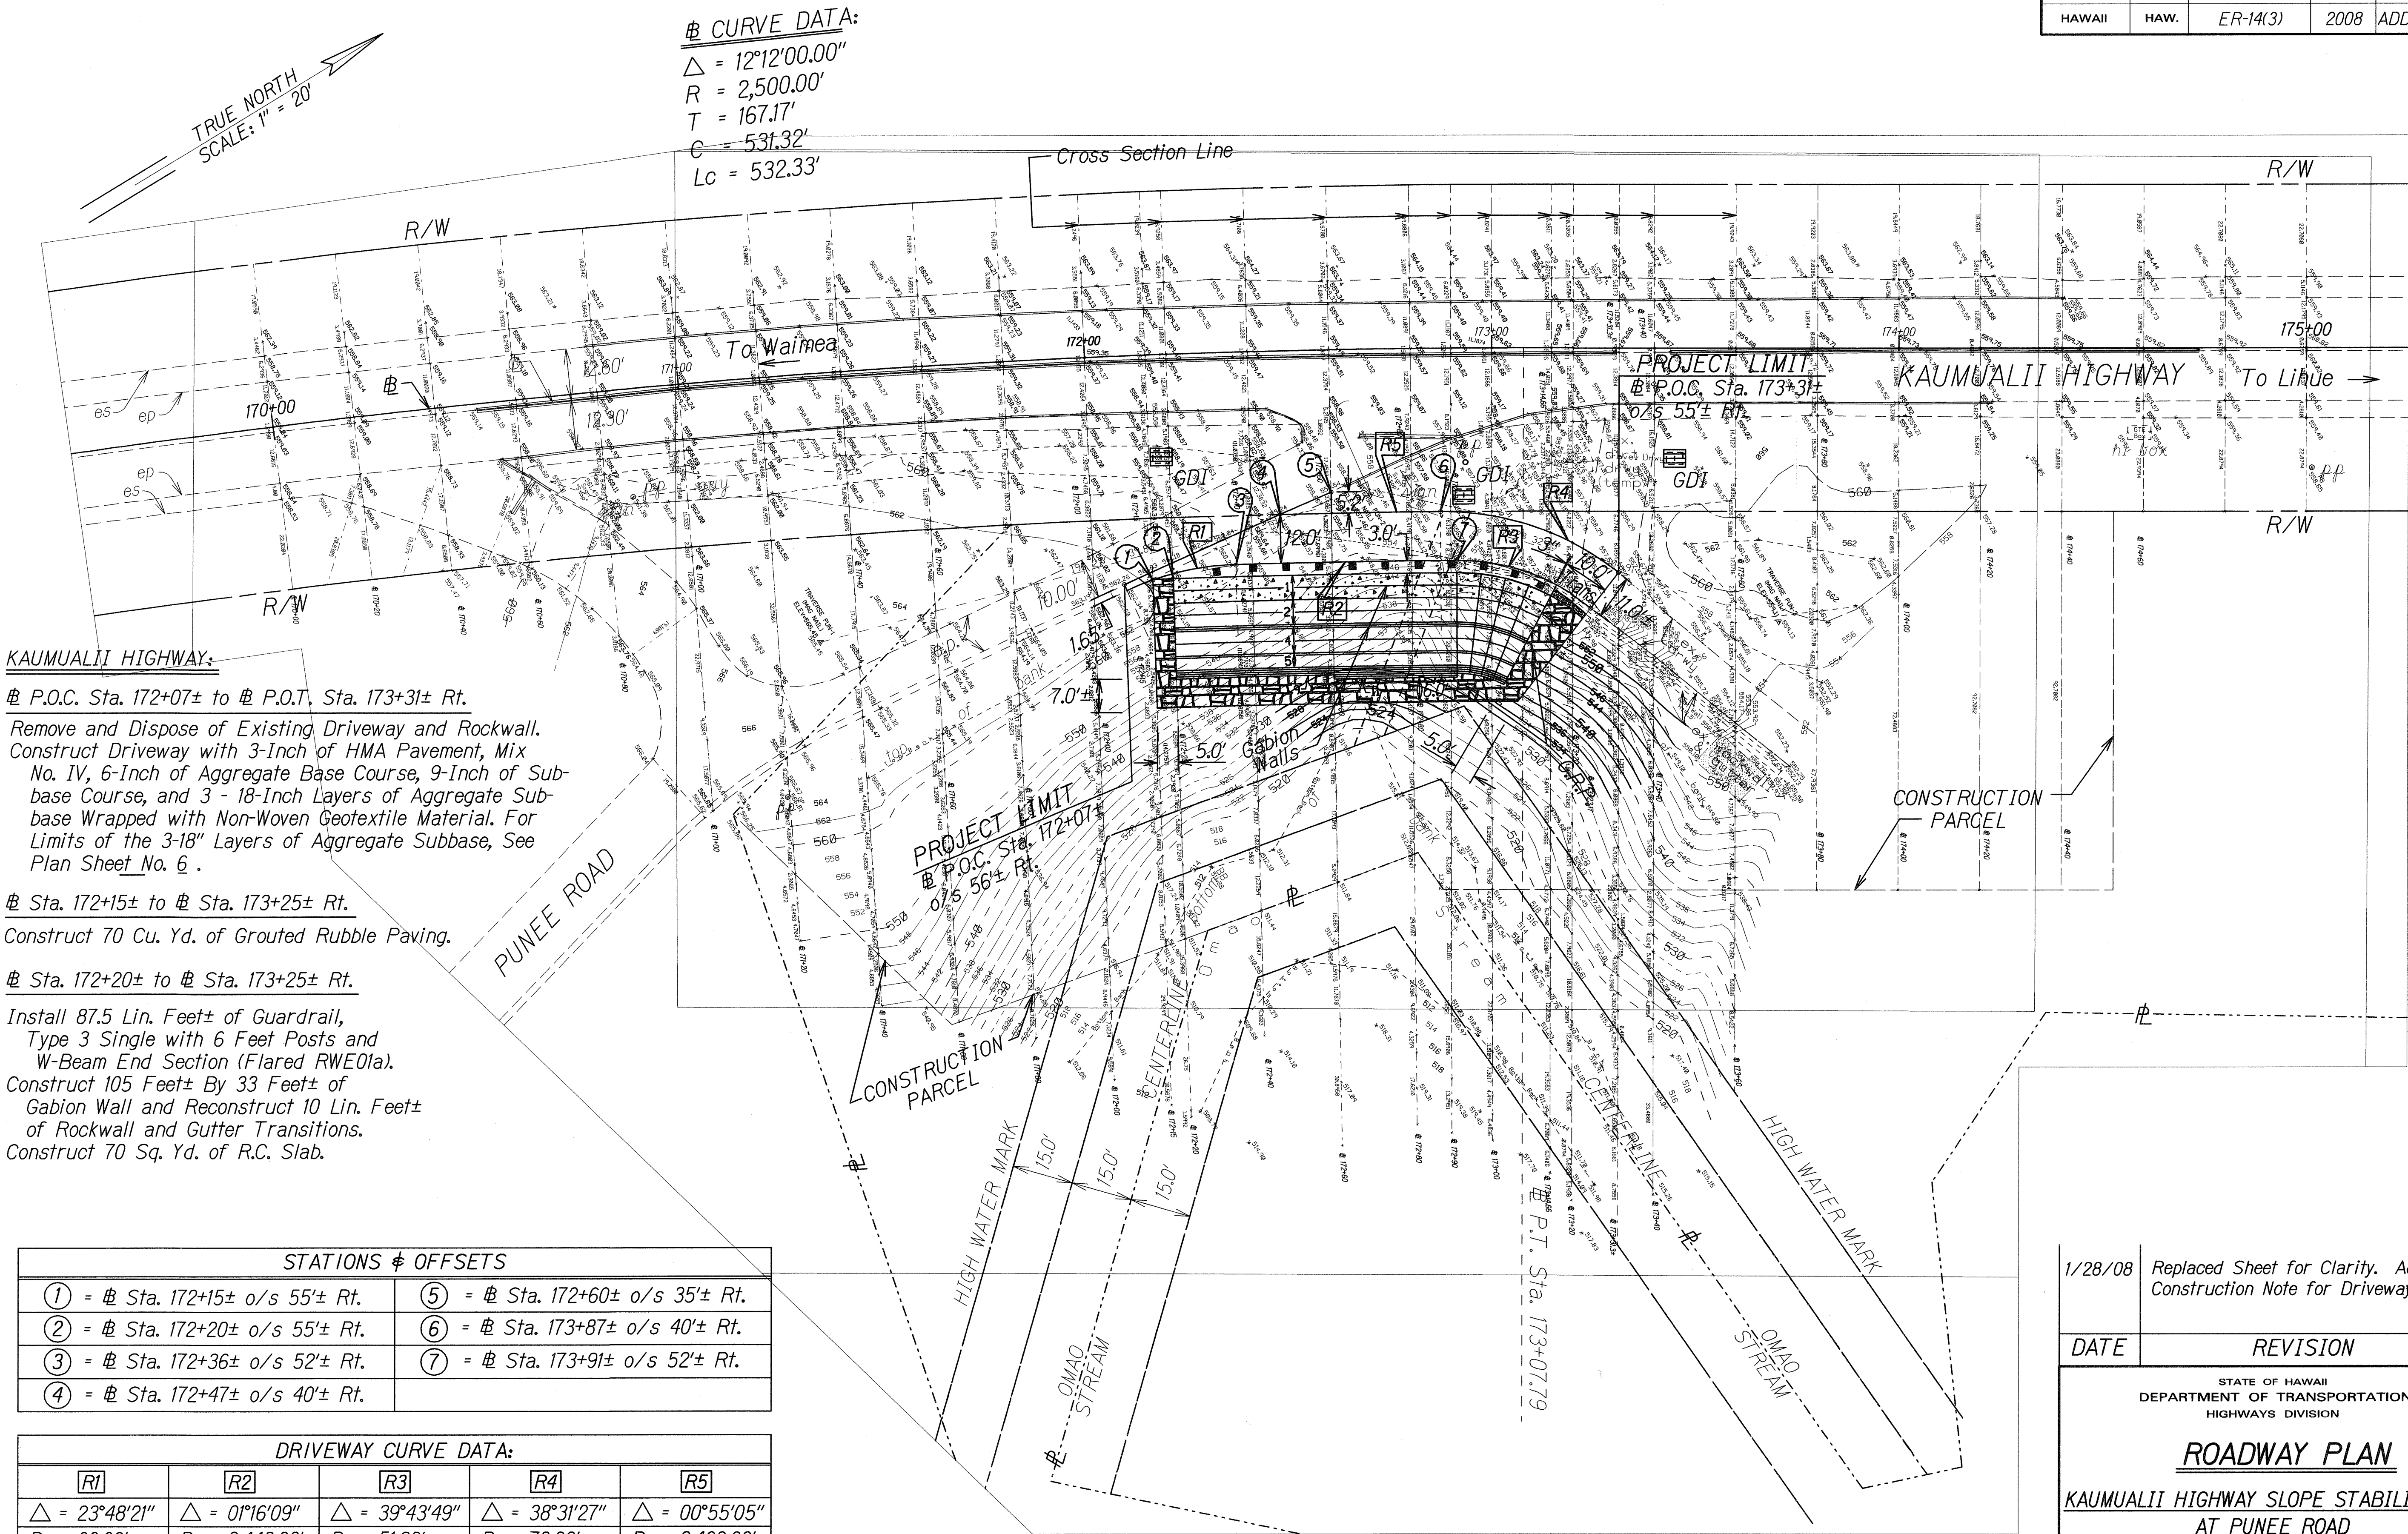

1/28/08 Replaced Sheet for Clarity. Added Construction Note for Driveway Limits.

DATE REVISION

STATE OF HAWAII
DEPARTMENT OF TRANSPORTATION
HIGHWAYS DIVISION

ROADWAY PLAN
KAUMUALII HIGHWAY SLOPE STABILIZATION
AT PUNEE ROAD

FEDERAL-AID PROJECT NO.: ER-14(3)

Scale: 1" = 20' Date: Sept, 2007

SHEET No. 1 OF 1 SHEETS

ADD. 8