


| FED. ROAD DIST. NO. | STATE | PROJ. NO. | FISCAL YEAR | SHEET NO. | TOTAL SHEETS |
|------------------------|-------|------------|----------------|--------------|-----------------|
| HAWAII | HAW. | 56D-01-92M | 1992 | 1 | 7 |

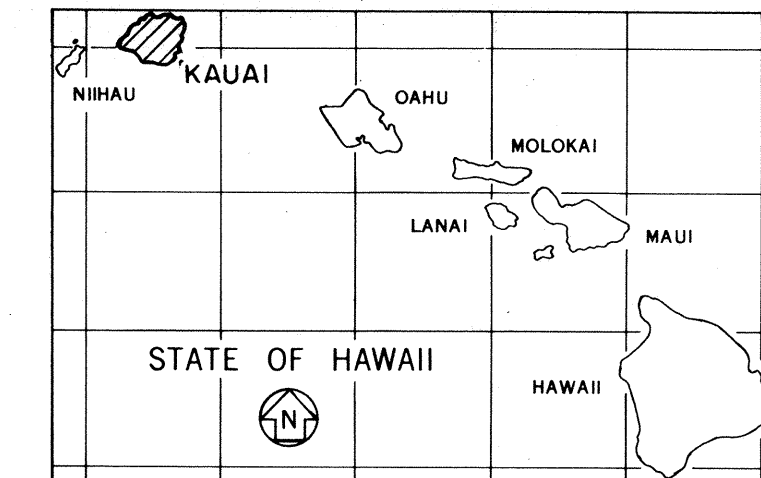


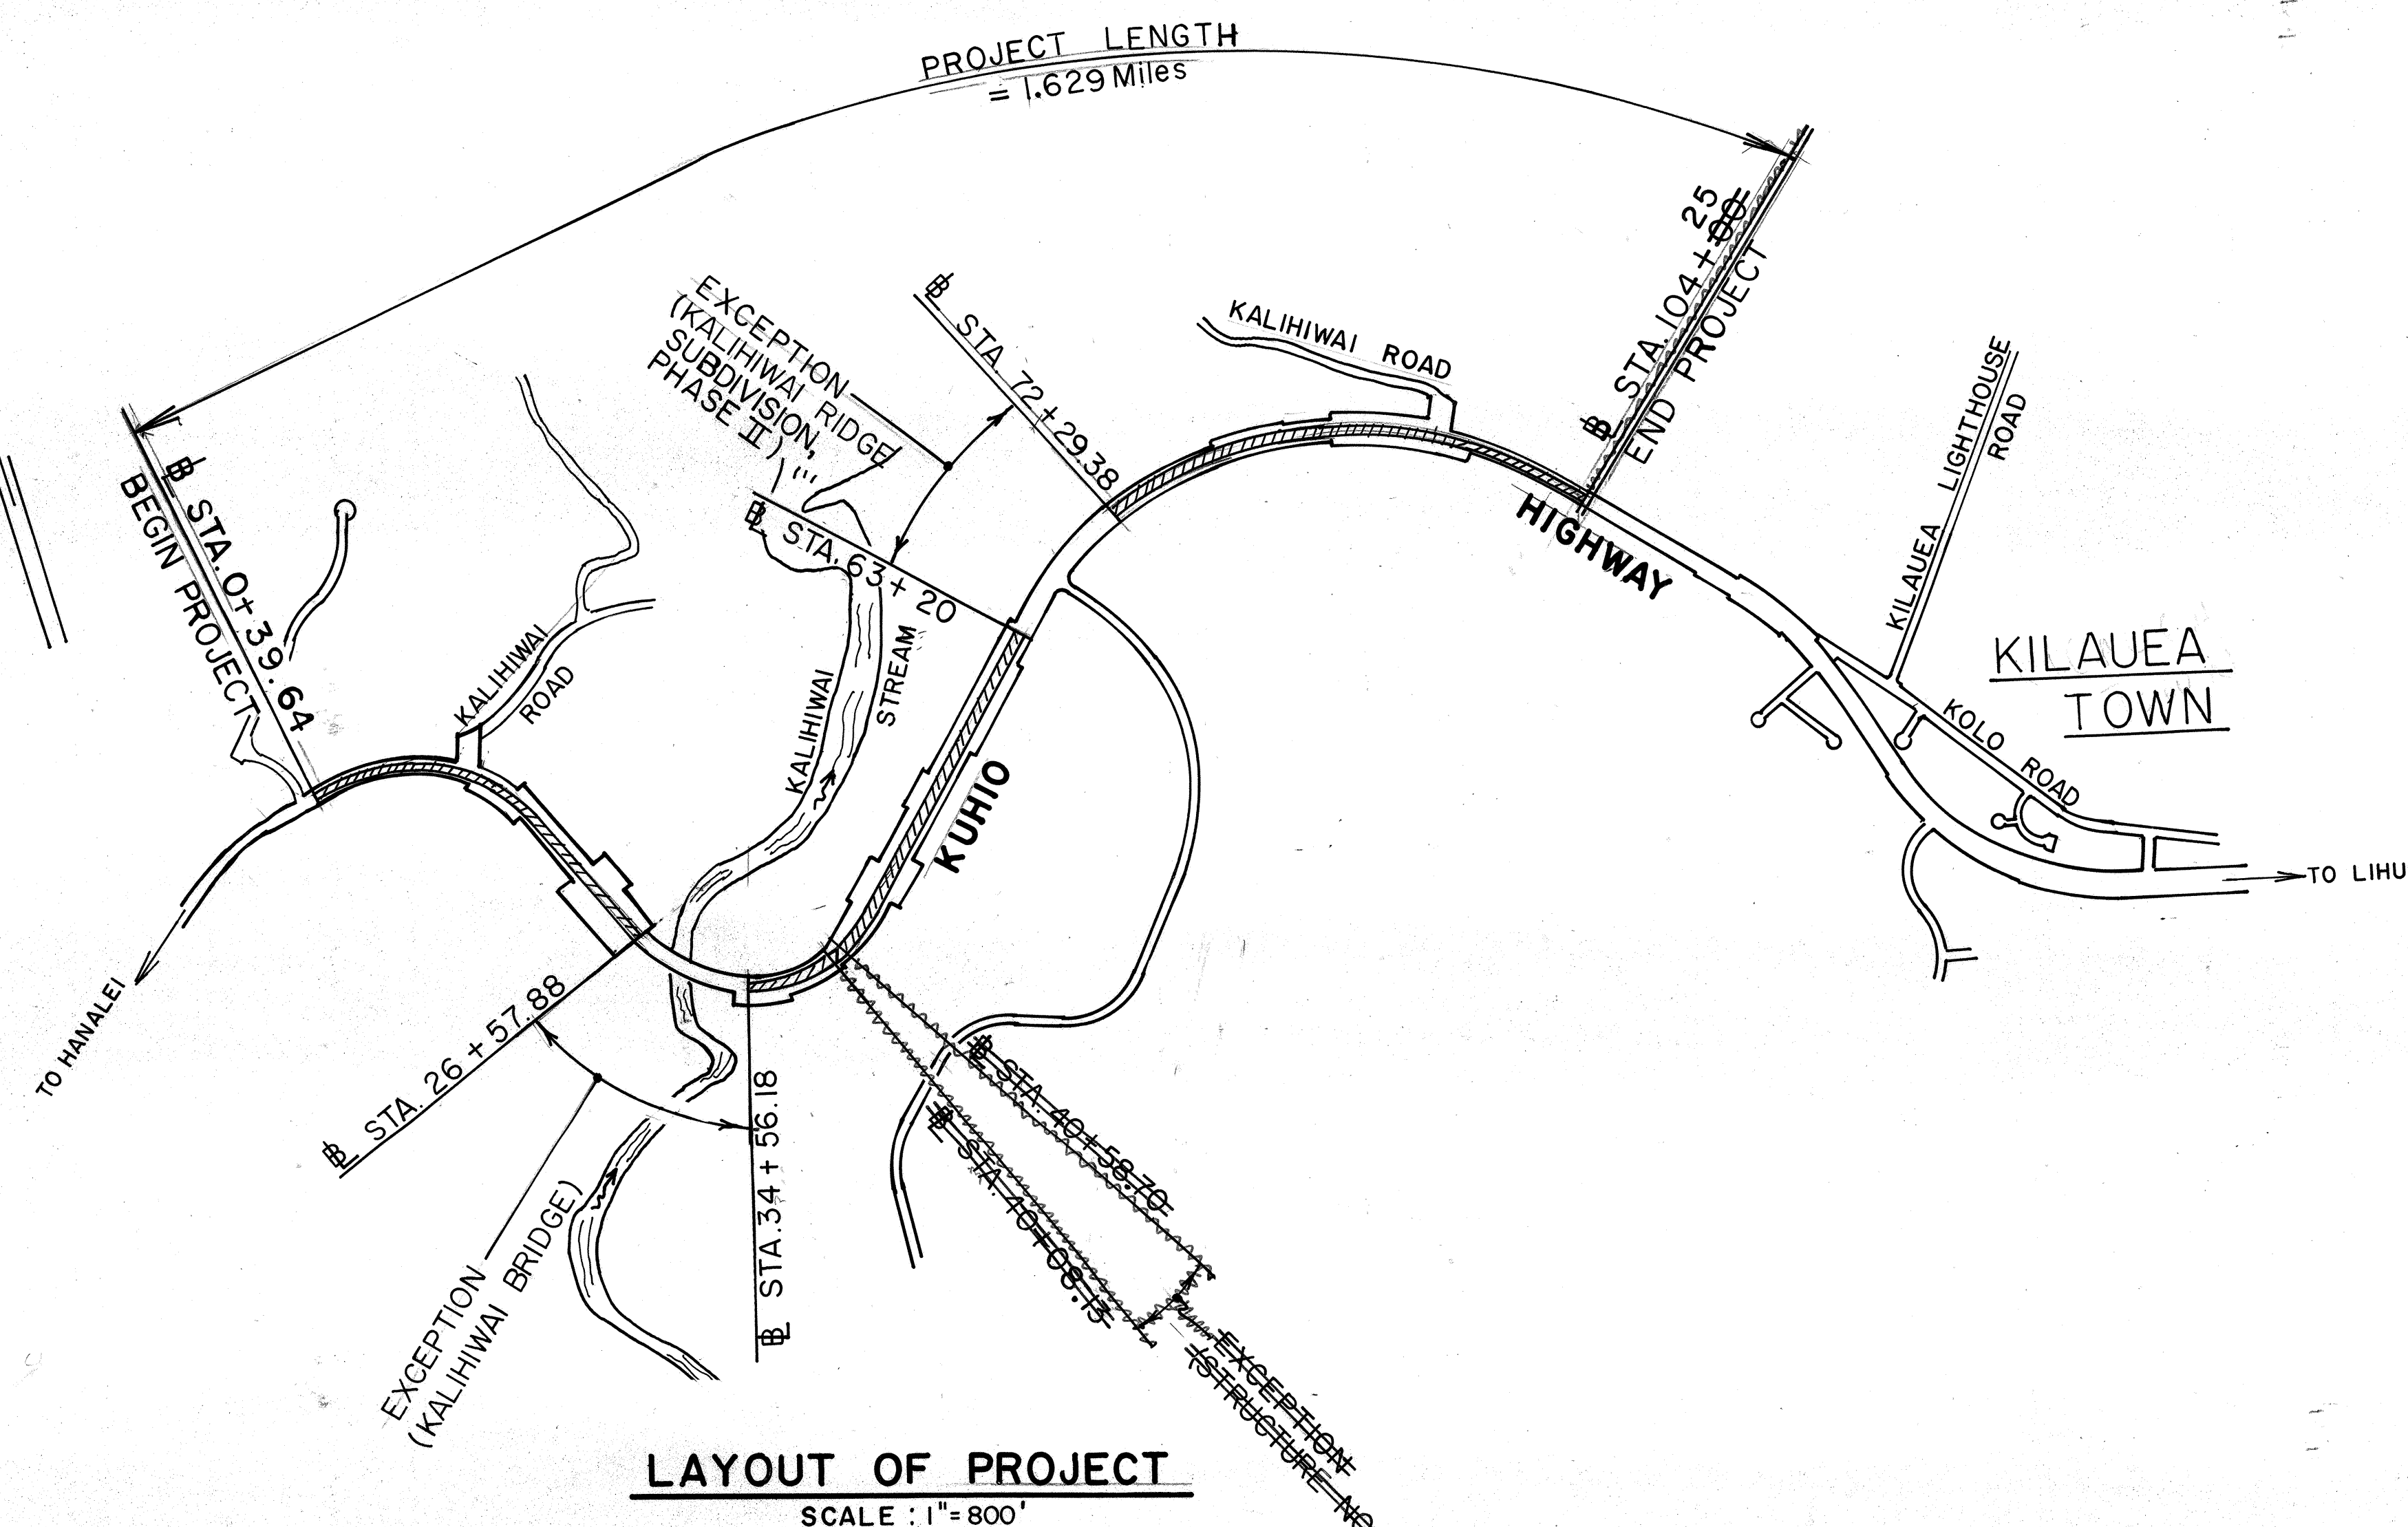
STATE OF HAWAII
DEPARTMENT OF TRANSPORTATION
HIGHWAYS DIVISION
HONOLULU, HAWAII
"AS-BUILT" PLAN
KUHIO HIGHWAY RESURFACING
KILAUEA TO KALIHIWAI
PROJECT NO. 56D-01-92M
DISTRICT OF HANAIEI
ISLAND OF KAUAI

 FEDERAL AID PROJECTS PREVIOUSLY CONSTRUCTED
 OR UNDER CONSTRUCTION

CHANGES MADE DURING CONSTRUCTION HAVE BEEN INCORPORATED ON THESE PLANS EXCEPT CHANGES IN THE ORIGINAL THEORETICAL QUANTITIES. FOR ACTUAL QUANTITIES, REFER TO PROJECT LEDGER AND/OR COMPUTATION BOOK.

Darryl H Maeda
RESIDENT ENGINEER

| | |
|---|---------|
| DEPARTMENT OF TRANSPORTATION STATE OF HAWAII | |
| APPROVED: | |
|  | 4/20/92 |
| DIRECTOR, DEPARTMENT OF TRANSPORTATION | DATE |

[illegible]

KAUAI DISTRICT
DESIGNED BY
R. TAKAESU
P. S. & E. BY
587-2249
PHONE
APRIL, 1992
DATE