



FED. ROAD DIST. NO.	STATE	PROJ. NO.	FISCAL YEAR	SHEET NO.	TOTAL SHEETS
HAWAII	HAW.	56D-01-92M	1992	4	7

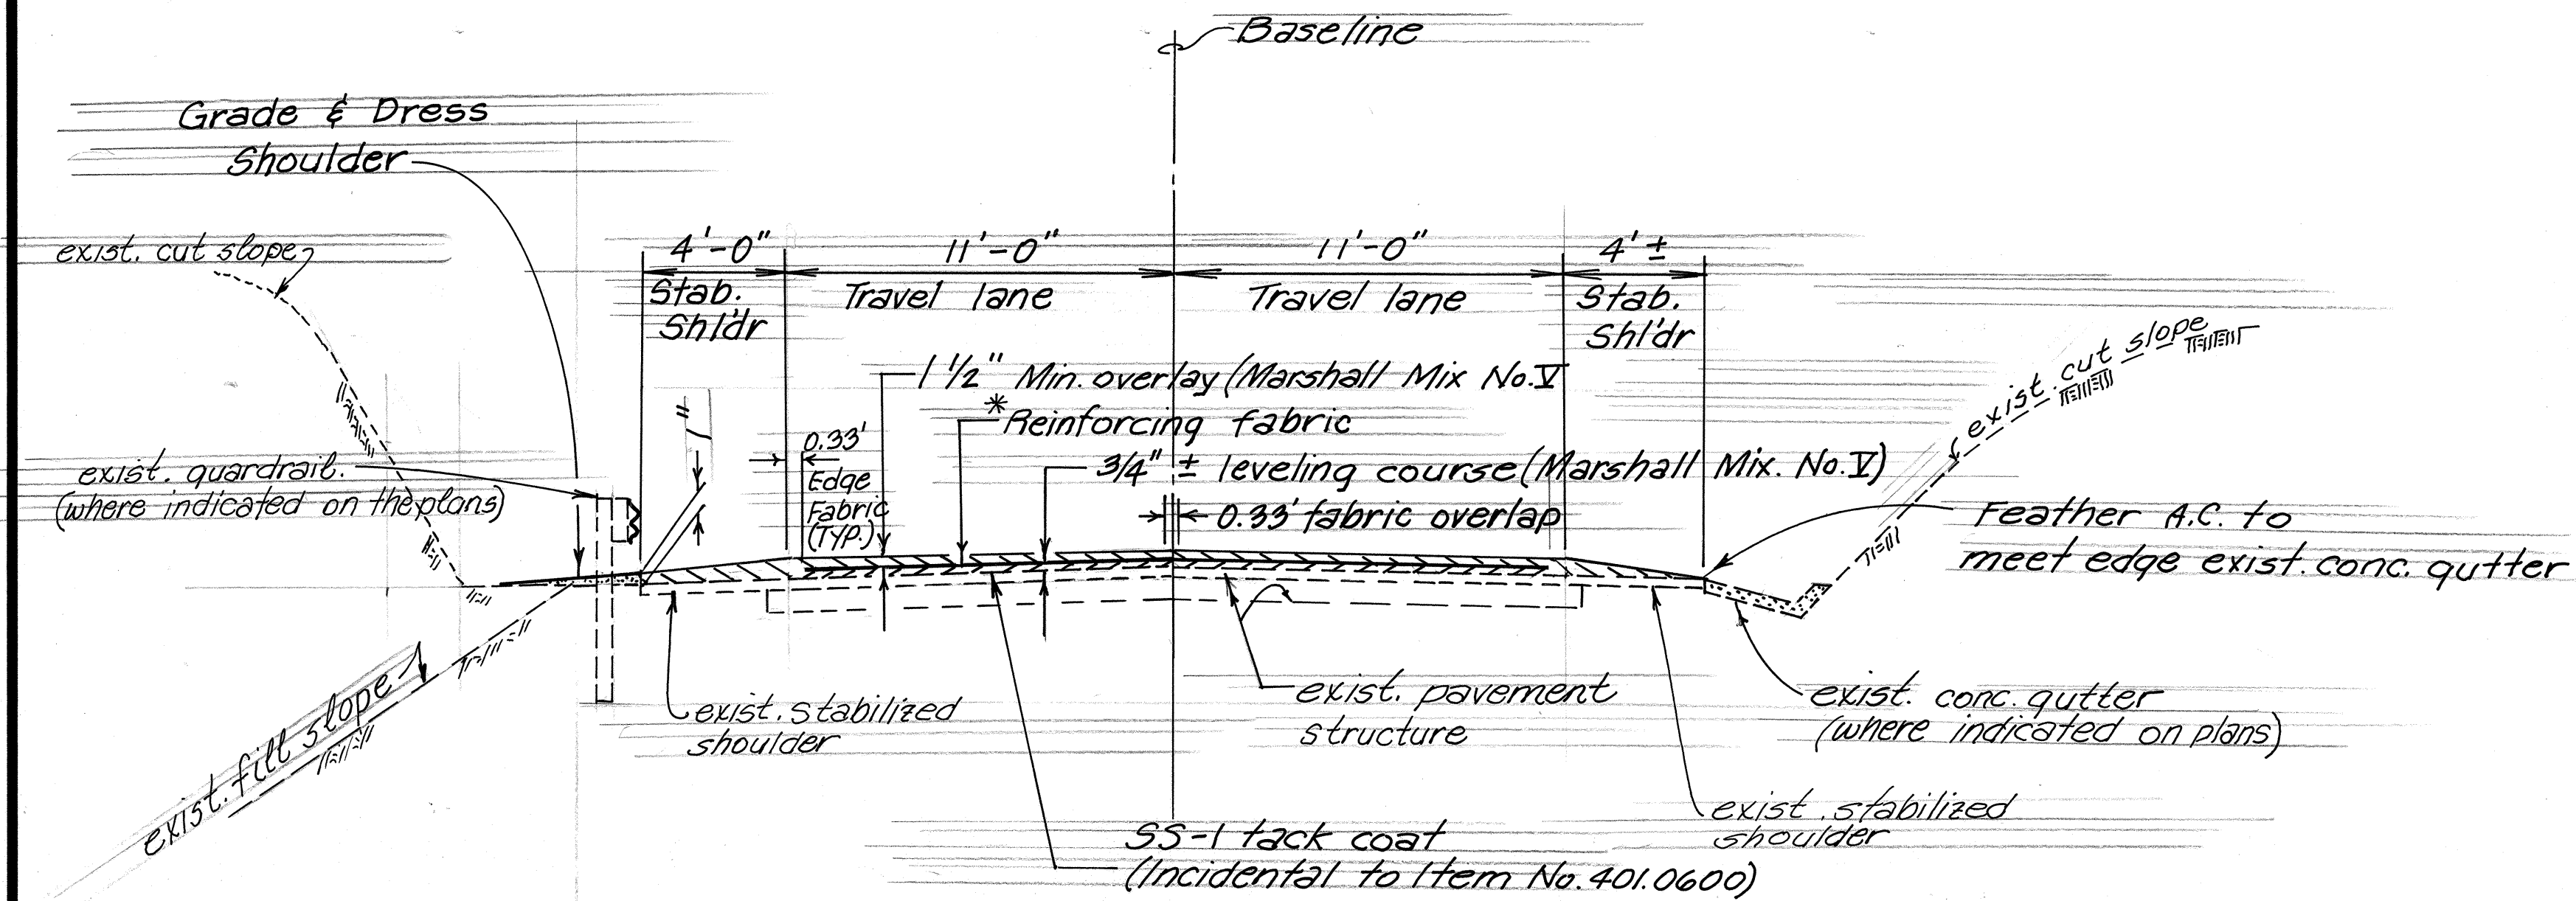


* See notes No. 6 & 17 on Sht. 3.

TYPICAL SECTION
Scale: 1/4" = 1'-0"

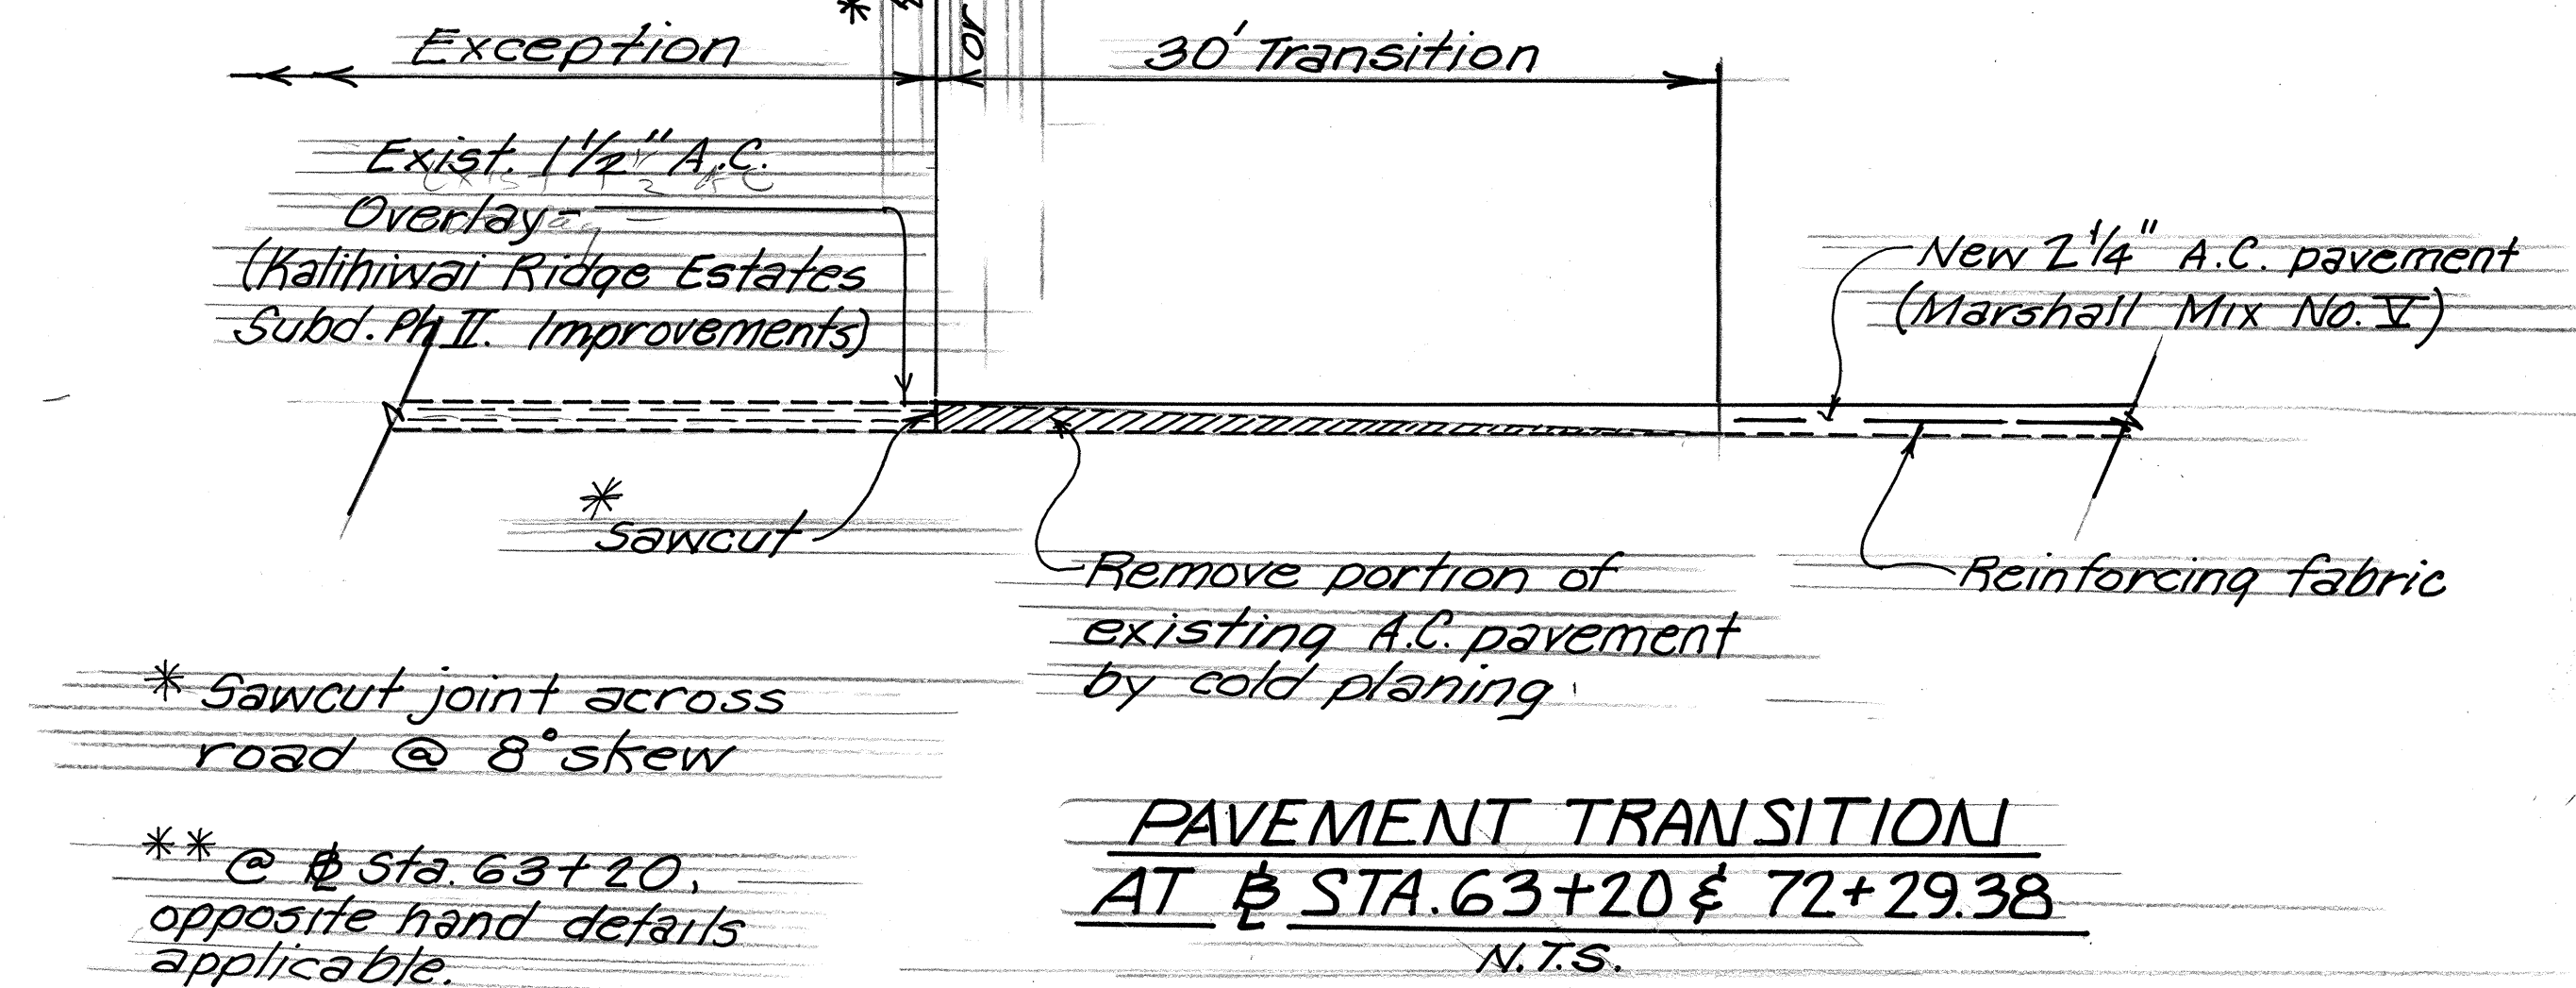

PAVEMENT TRANSITION AT STA. 63+20 & 72+29.38
N.T.S.

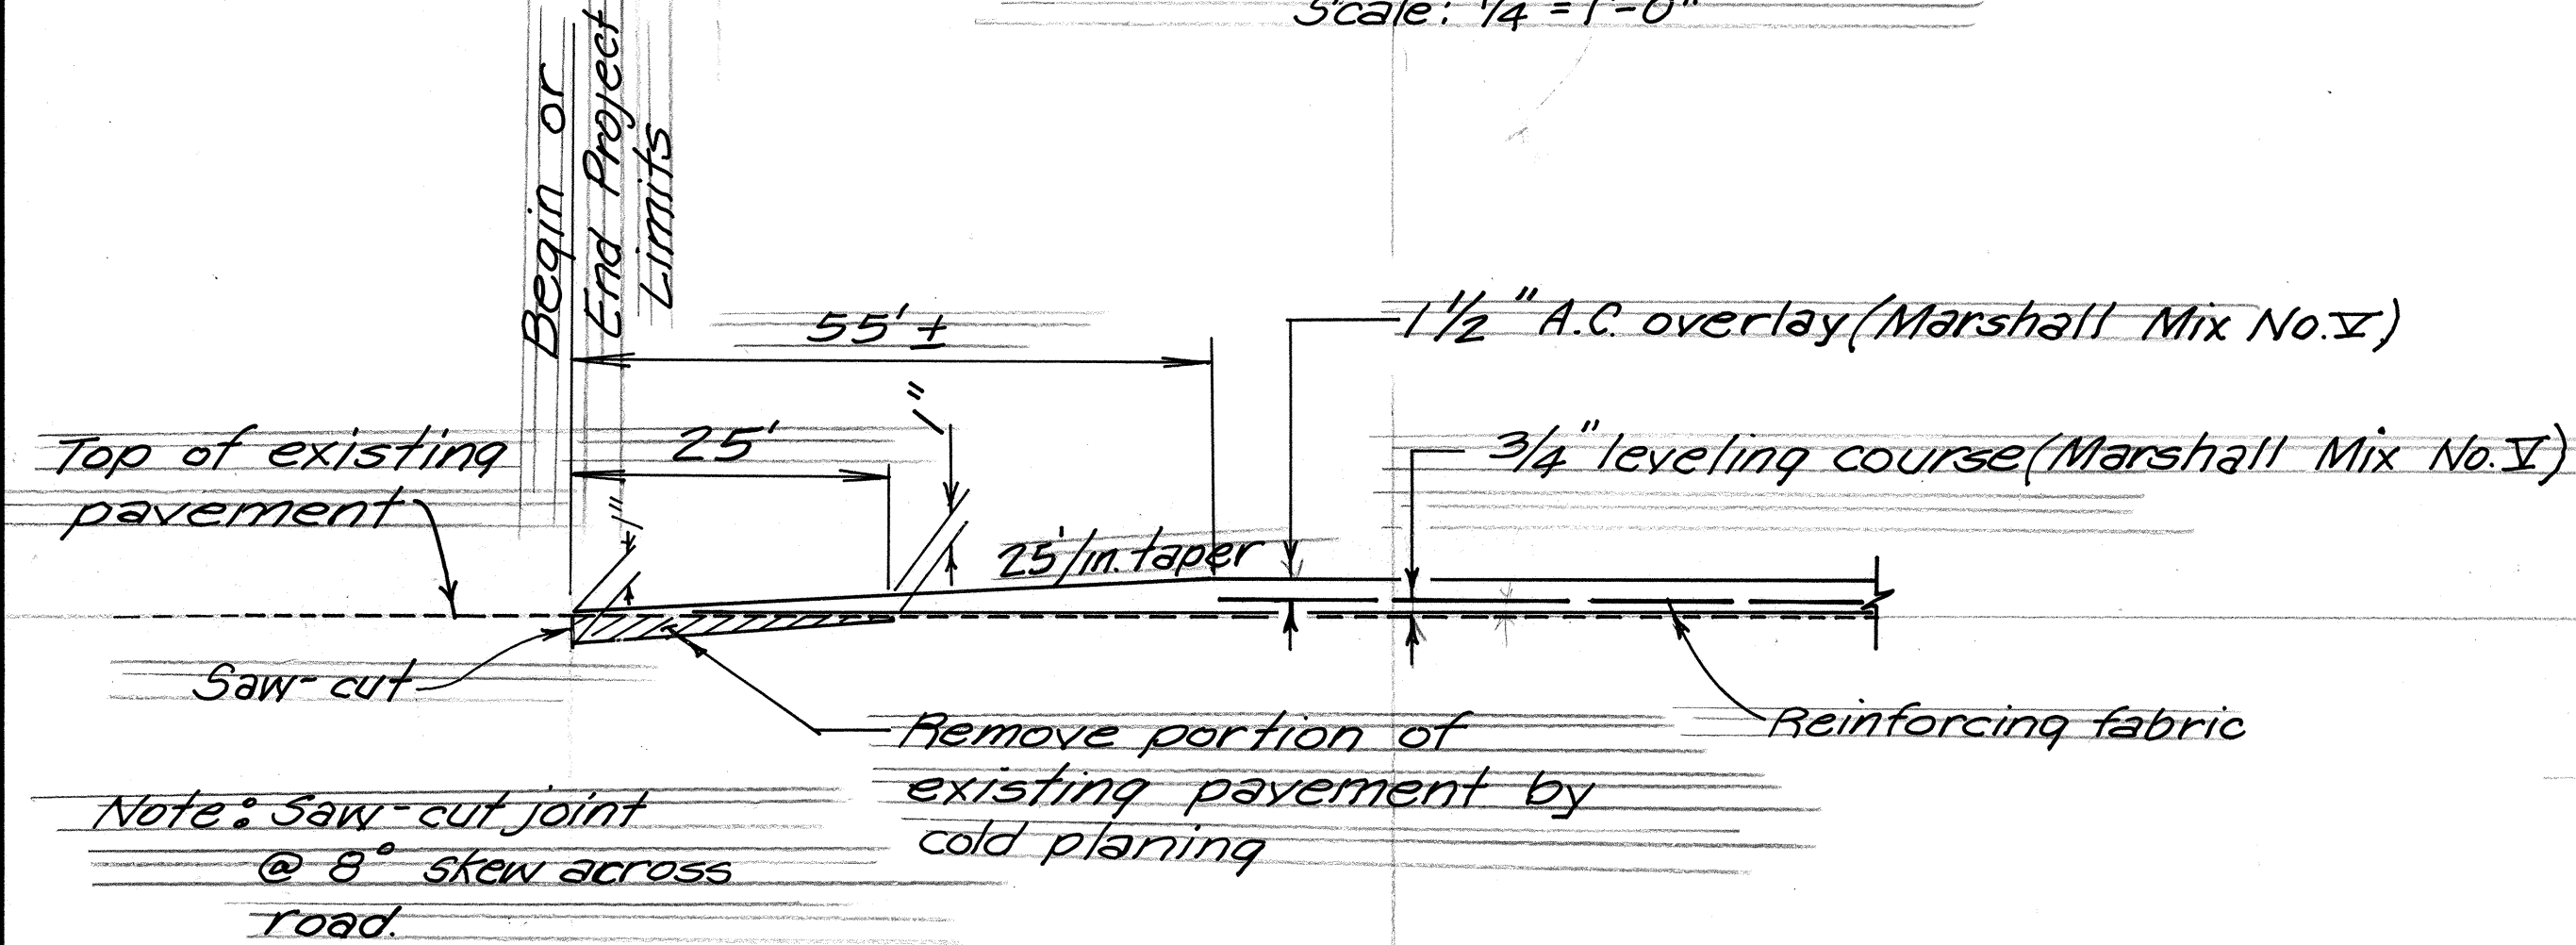

PAVEMENT TRANSITION AT BEGINNING & END OF PROJECT
N.T.S.


Summary of Centerline Striping and Raised Pavement Markers

Station Limits	Pavement Striping (Lin. Ft.)		Pavement Markers (Each)				Zone Req'mts
	C.L.	E.P.	Type OL	Type DL	Type HL	Type S	
0+39.60	1060	*2100	56	54			No Pass
11+00							No Pass
11+40	40	*80	2	2			No Pass
11+40							40' Gap Kalihiwai Rd.
14+75	335	*670	20	18			No Pass
14+75							No Pass
24+30	955	*1170	50		25	100	No Pass/Pass
24+30							No Pass
43+30	1900	*460	98	96			No Pass
43+30							No Pass
49+10	580	*1160	32		16	64	No Pass/Pass
49+10							No Pass
60+20	—	*2220	58	29		116	Pass
60+20	300	*1160	18		9	36	Pass/No Pass
63+20	300	*600	18		9	36	Pass/No Pass
72+29	2161	*4322	110	109			No Pass
93+90	40	*80	2	2			No Pass
93+90							40' Gap Kalihiwai Rd.
94+30	390	*780	22	21			No Pass
98+20	580	*1160	32		16	64	No Pass/Pass
104+00							No Pass
Totals		*14,802	500	331	66	380	

Notes for White edge line
Sta. 14+75 to Sta. 20+60 = 4"
Sta. 20+60 to Sta. 24+30 = 8"
Sta. 24+30 to Sta. 41+00 = 8"
Sta. 41+00 to Sta. 43+30 = 4"

Exception - Sta. 63+20 to Sta. 72+29

15'-12" White Stop Bar at Kalihiwai Rd.

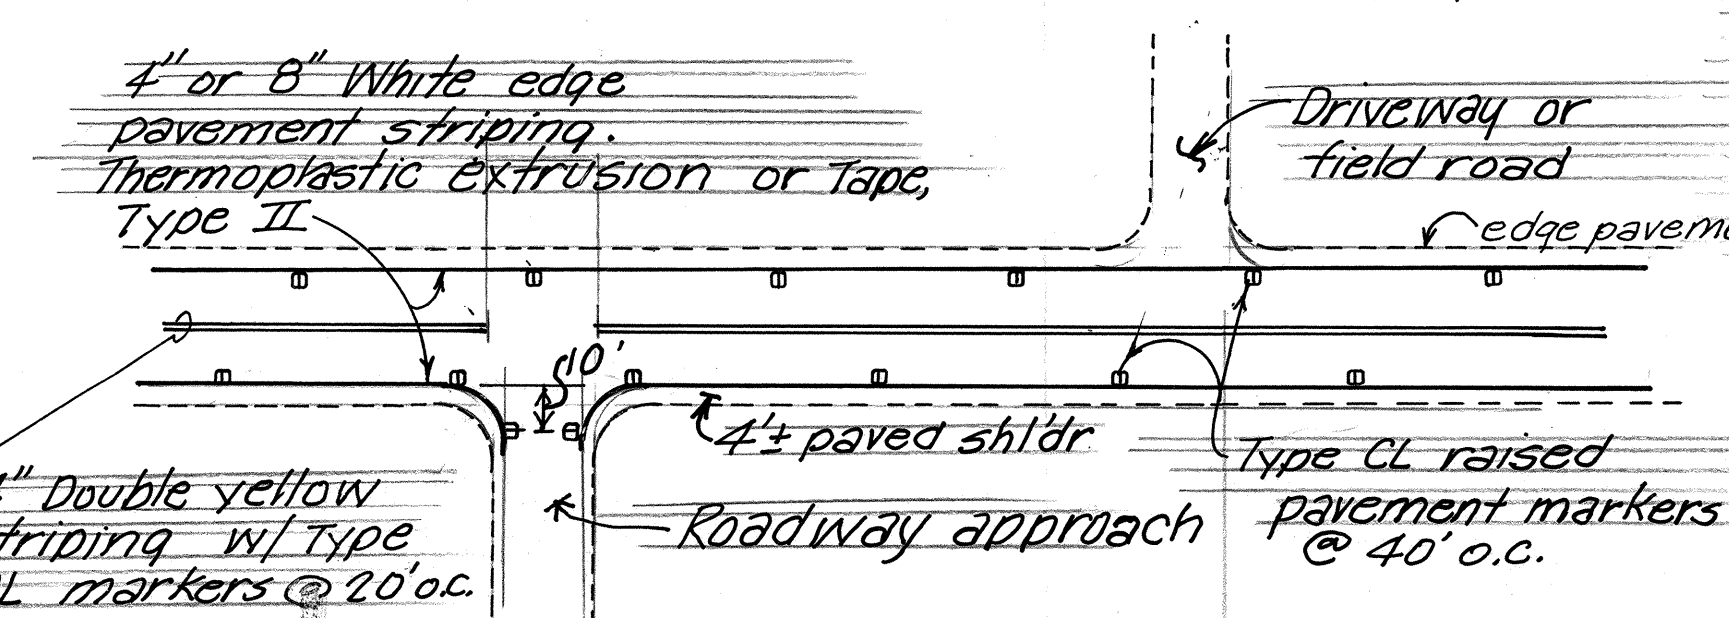

PLAN TYPICAL EDGE LINE WITH RAISED PAVEMENT MARKERS
N.T.S.

Note:
* 4" White edge line
** 8" White edge line

STATE OF HAWAII

DEPARTMENT OF TRANSPORTATION

HIGHWAYS DIVISION

TYPICAL SECTIONS

KUHIO HIGHWAY RESURFACING

KILAUEA TO KALIHUAI

PROJECT NO. 56D-01-92M

SCALE: AS SHOWN

DATE: MAR. 1992

SHEET NO. 4 OF 7 SHEETS

ORIGINAL PLAN	DATE
DRAWN BY	
DESIGNED BY	
CHECKED BY	
NO.	