

INDEX TO DRAWINGS	
SHEET NO.	DESCRIPTION
1	TITLE SHEET
2	STANDARD PLANS SUMMARY
3	GENERAL NOTES AND LEGEND
4 - 5	WATER POLLUTION AND EROSION CONTROL NOTES
6 - 9	TYPICAL SECTIONS
10 - 13	ROADWAY PLAN
14	PAVEMENT MARKING LEGEND, DETAILS AND NOTES
15 - 18	PAVEMENT MARKING AND TRAFFIC SIGNING PLAN
19	DRAINAGE DETAILS
20	SIGN DETAILS
21	HIGH SPEED UNDIVIDED HIGHWAY WORK ZONE SIGNING PLAN, NOTES AND DETAILS
22	LOW SPEED UNDIVIDED HIGHWAY WORK ZONE SIGNING PLAN, NOTES AND DETAILS

Sheet No. 19S-1 is a Supplementary Sheet to this Project. Total Sheet Count After "AS-BUILT" Posting 23 Sheets.

Hwy-K
DESIGNED BY

Hwy-KE
P. S. & E. BY

241-3000
PHONE

JAN. 2007
DATE

STATE OF HAWAII

DEPARTMENT OF TRANSPORTATION

HIGHWAYS DIVISION

HONOLULU, HAWAII

"AS-BUILT"

PLANS FOR



KUHIO HIGHWAY RESURFACING

KALIHIWAI ROAD TO KAHILIHOLE ROAD

PROJECT NO. 56D-01-07M

DISTRICT OF HANAIEI

ISLAND OF KAUAI

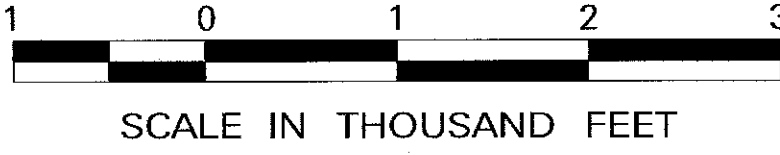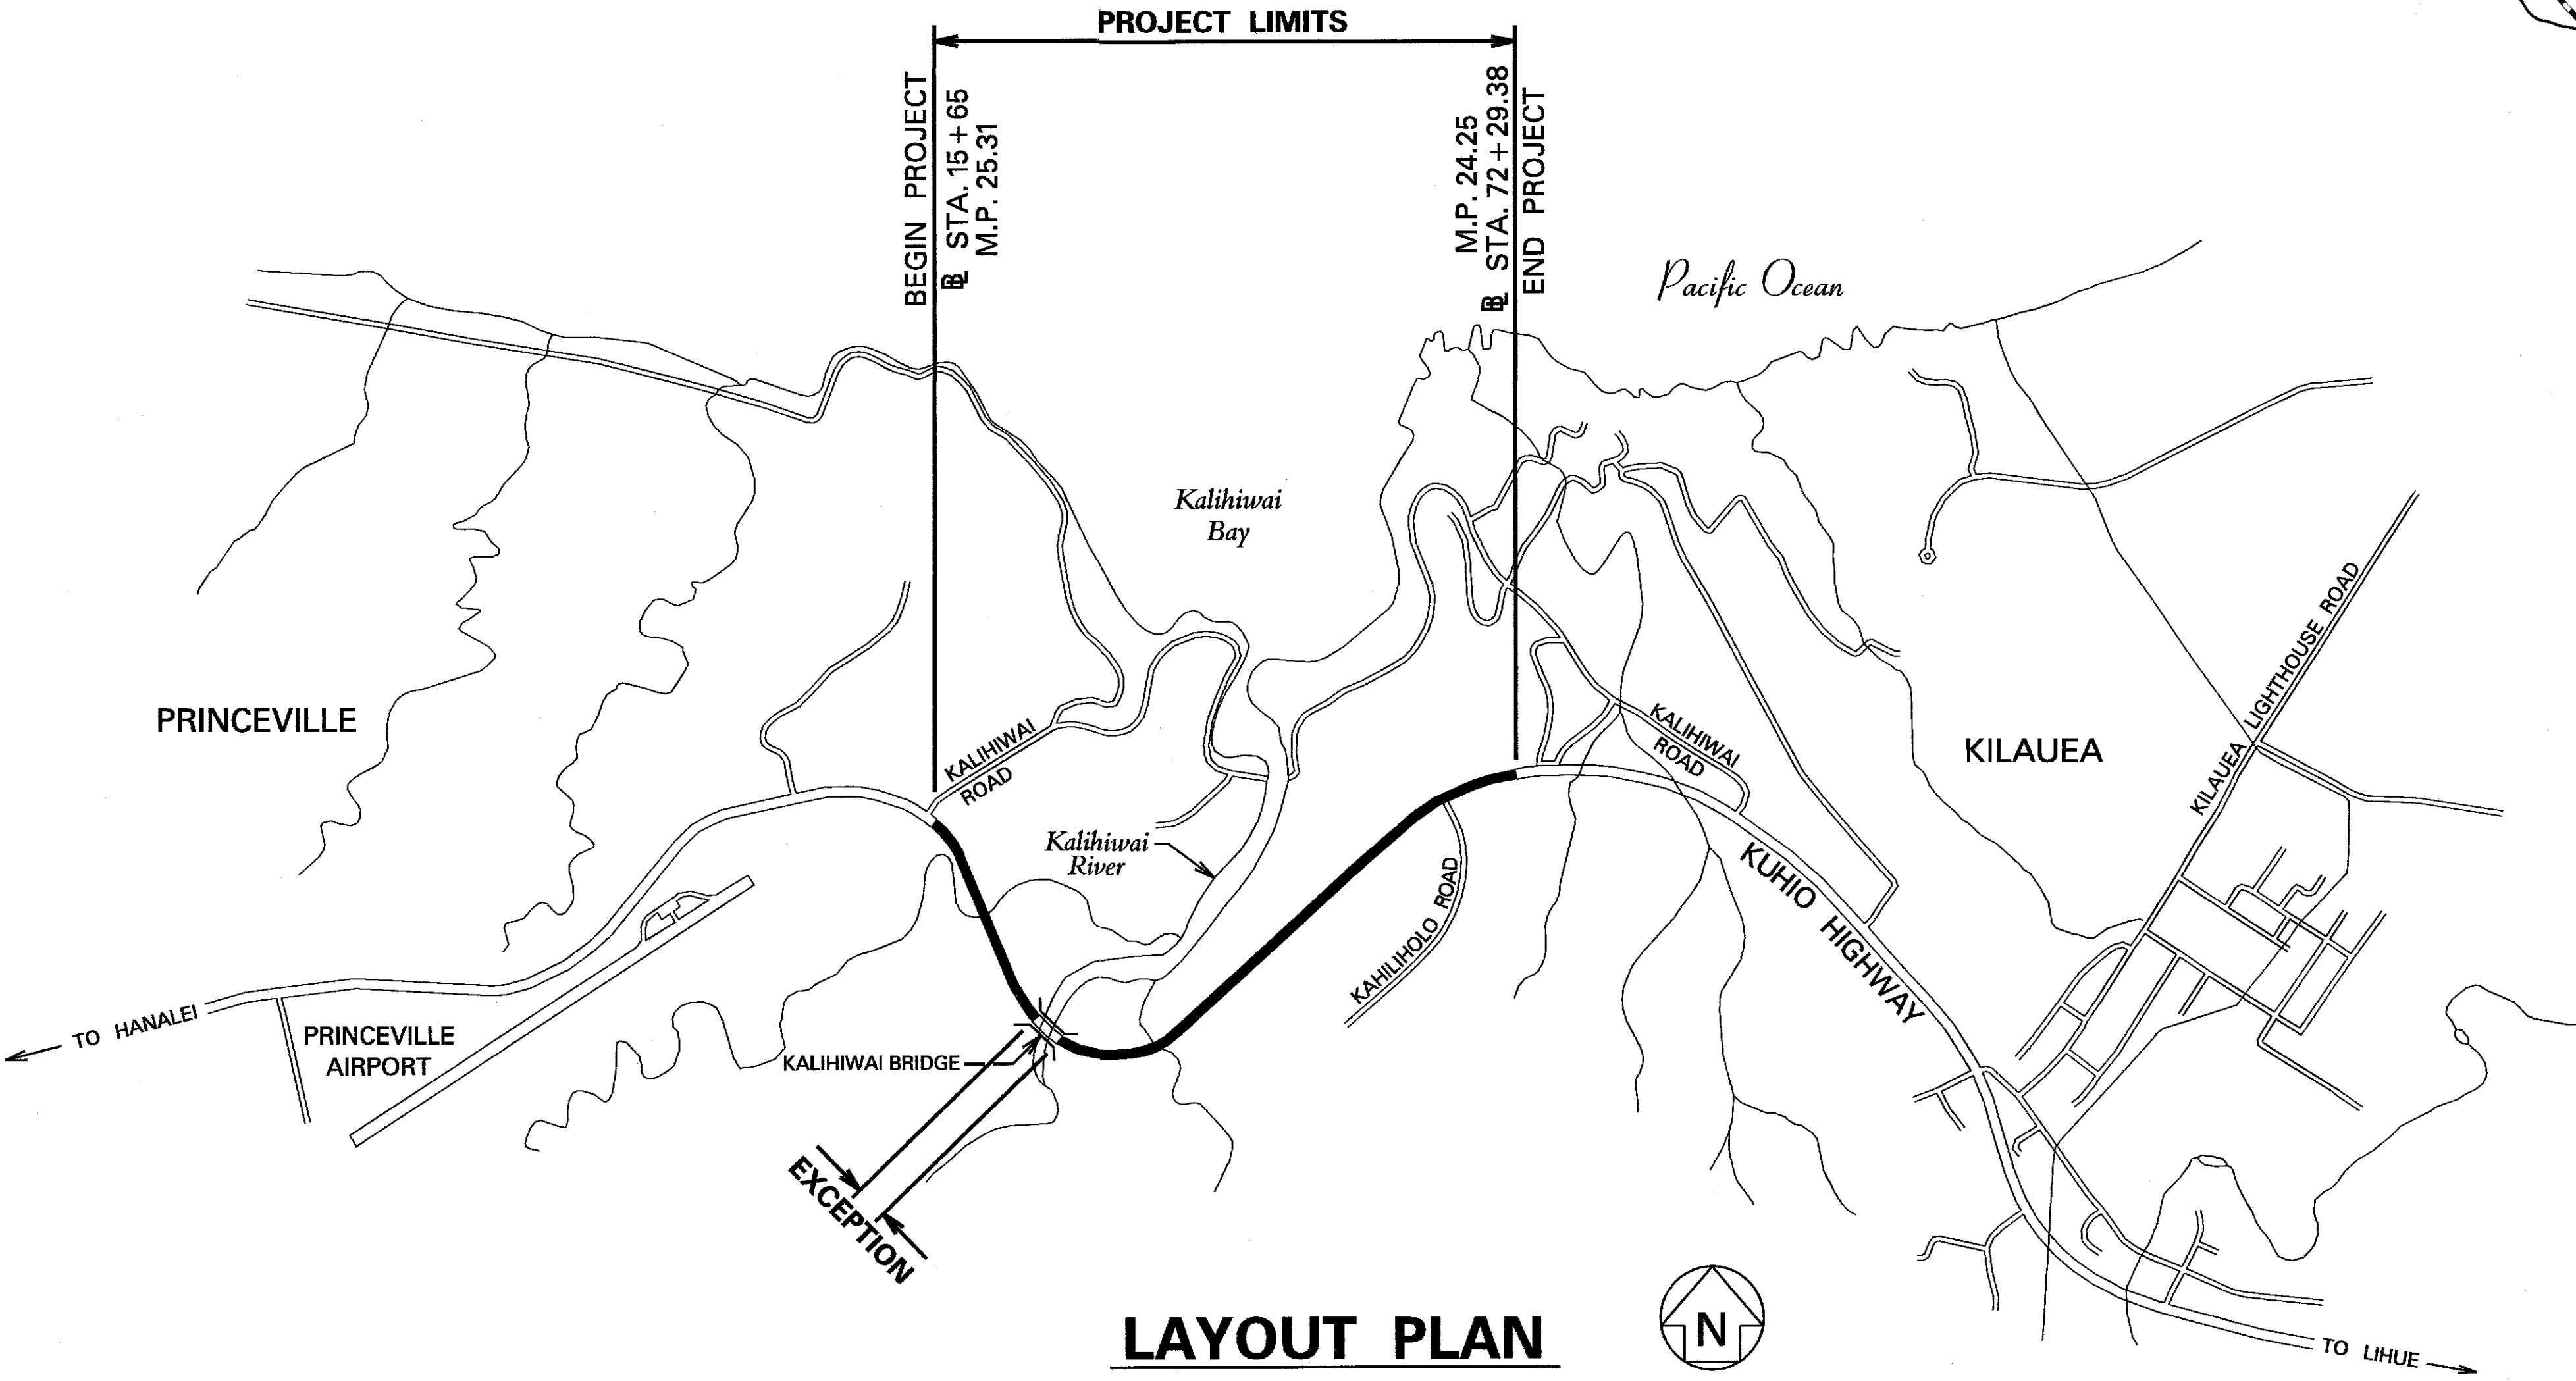


LAYOUT PLAN


GROSS LENGTH OF PROJECT.....1.06 MILES

NET LENGTH OF PROJECT.....0.91 MILES

FED. ROAD DIST. NO.	STATE	PROJ. NO.	FISCAL YEAR	SHEET NO.	TOTAL SHEETS
HAWAII	HAW.	56D-01-07M	2007	1	22

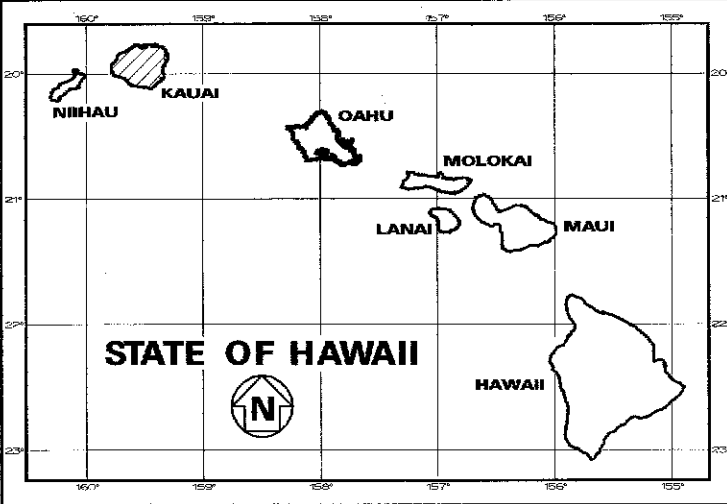

PROJECT LOCATION

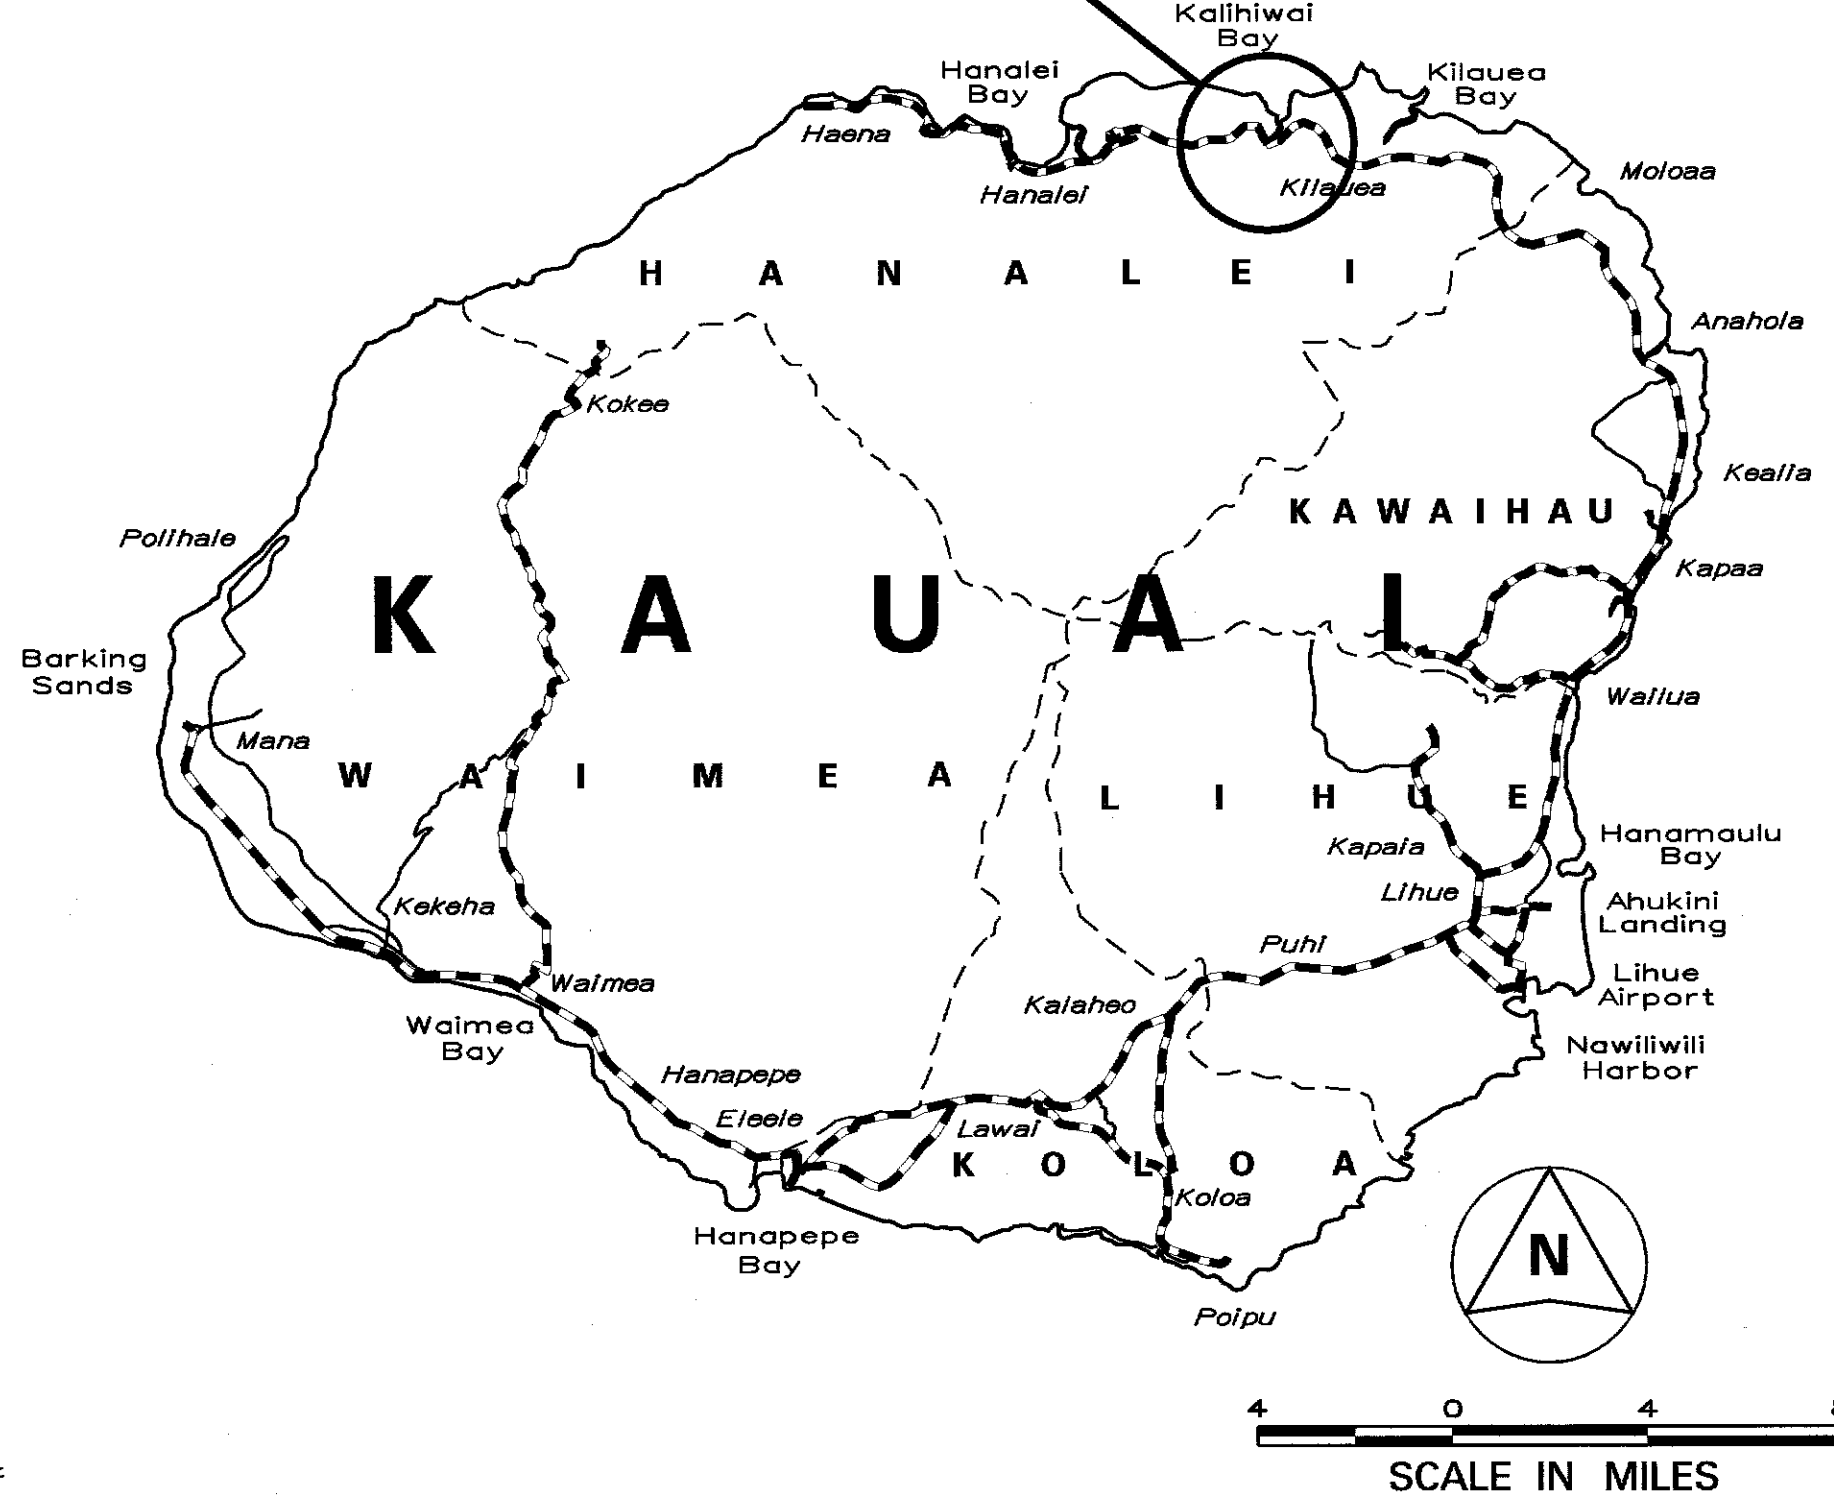

----- FEDERAL AID PROJECTS PREVIOUSLY CONSTRUCTED OR UNDER CONSTRUCTION

MILE POST 24.25 TO MILE POST 25.31

CHANGES MADE DURING CONSTRUCTION HAVE BEEN INCORPORATED ON THESE PLANS EXCEPT CHANGES IN THE ORIGINAL THEORETICAL QUANTITIES FOR ACTUAL QUANTITIES. REFER TO PROJECT LOGS FOR MORE INFORMATION.

[Signature] 9/12/19

DEPARTMENT OF TRANSPORTATION
STATE OF HAWAII

APPROVED:

[Signature] 1-23-07
DIR. OF TRANSPORTATION DATE