



| FED. ROAD DIST. NO. | STATE | FED. AID PROJ. NO. | FISCAL YEAR | SHEET NO. | TOTAL SHEETS |
|---------------------|-------|--------------------|-------------|------------|--------------|
| KAUAI | HAW. | NH-056-1(50) | 2019 | C.O.ADD.13 | 244 |

True North
Scale: 1"=100'

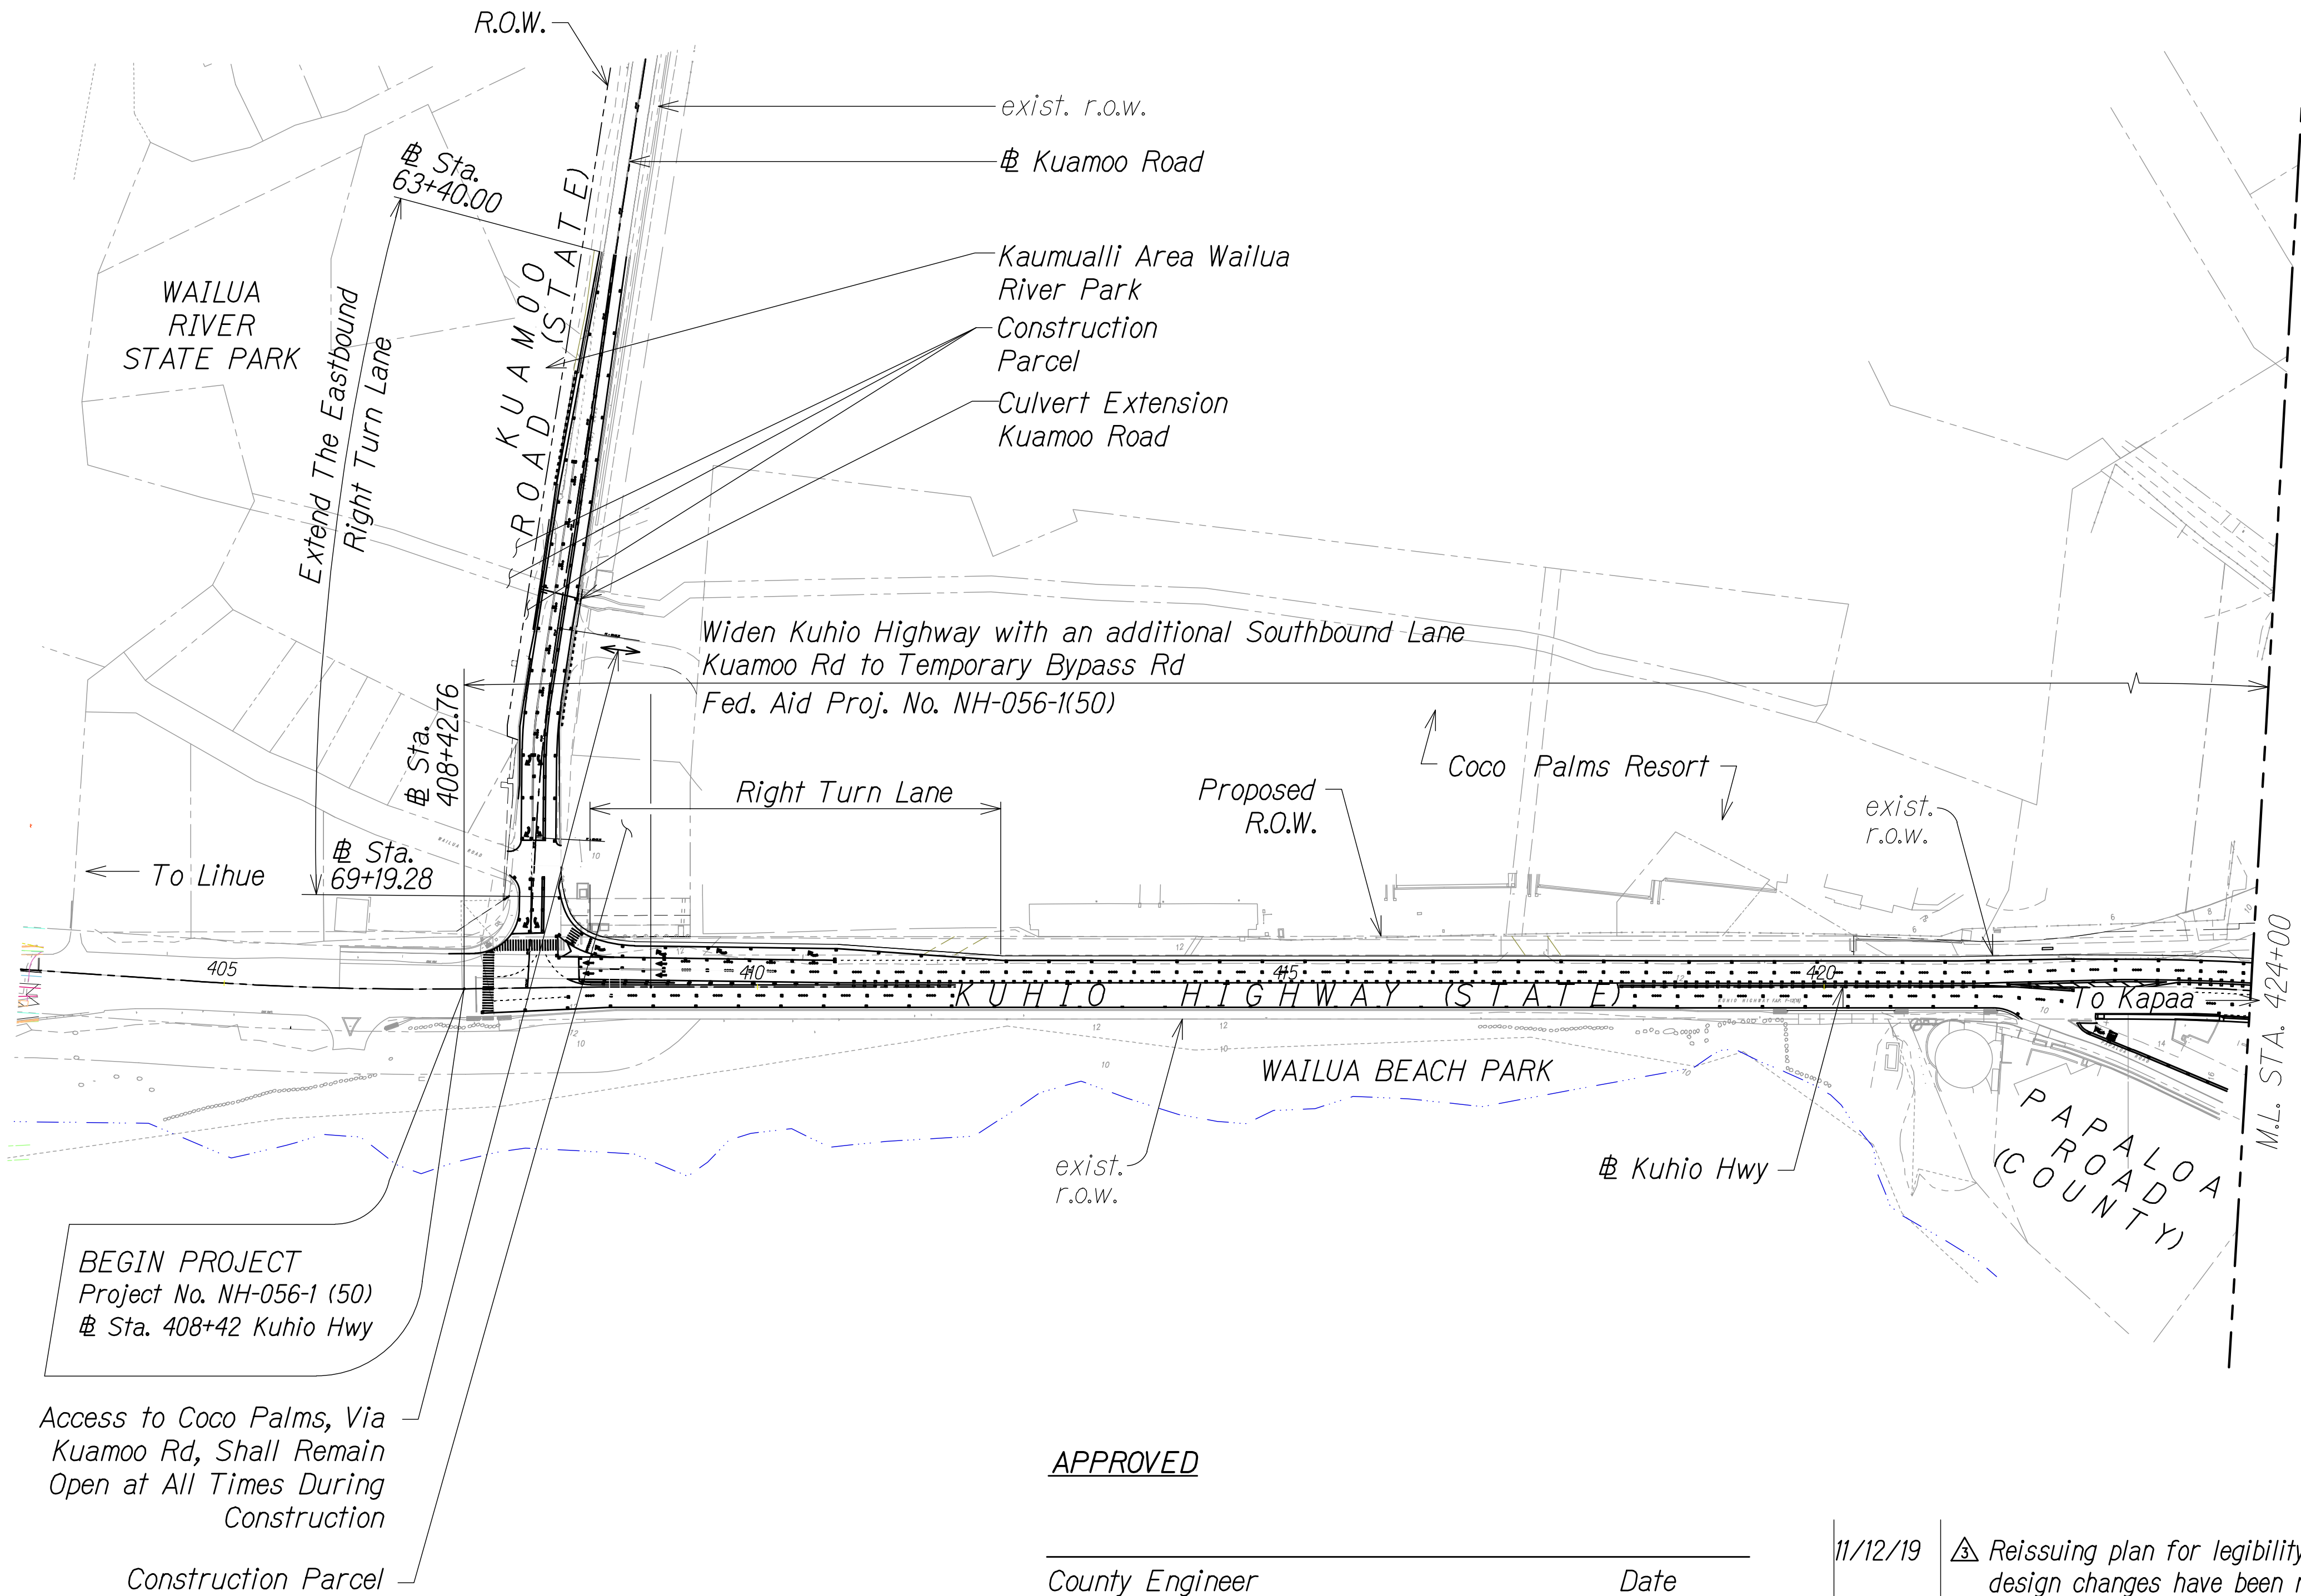

THESE PLANS HAVE BEEN PREPARED UTILIZING INFORMATION PROVIDED BY THE PROJECT CONTRACTOR. THE UPDATED CONSTRUCTION INFORMATION DEPICTED HEREIN HAS NOT BEEN VERIFIED FOR ACCURACY AND COMPLETENESS. NO REPRESENTATION IS BEING MADE TO ITS VALIDITY.

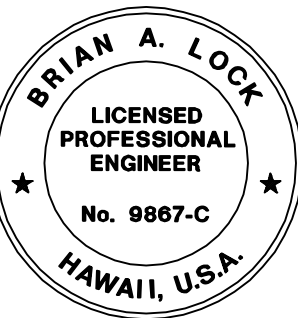

THIS WORK WAS PREPARED BY ME OR UNDER MY SUPERVISION.
WILSON OKAMOTO CORPORATION
APRIL 30, 2020
LIC. EXP. DATE

STATE OF HAWAII
DEPARTMENT OF TRANSPORTATION
HIGHWAYS DIVISION

GENERAL PLAN

KUHIO HIGHWAY SHORT-TERM
IMPROVEMENTS KUAMOO ROAD
TO TEMPORARY KAPAA BYPASS ROAD
Fed. Aid Proj. No. NH-056-1(50)
Scale: 1" = 100' Date: July 2019

SHEET No. C1 OF 2 SHEETS


APPROVED

County Engineer
County of Kauai
(For Work Within the County Right-of-Way)

Date

| | |
|----------|---|
| 11/12/19 | △ Reissuing plan for legibility only. No design changes have been made. |
| 9/20/19 | △ Reissuing plan for legibility only. No design changes have been made. |

| DATE | REVISION |
|------|----------|
|------|----------|

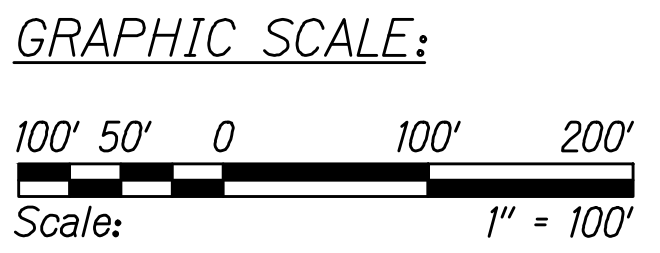


| | | |
|---------------|-------------------|------|
| ORIGINAL PLAN | SURVEY PLOTTED BY | DATE |
| NOTE BOOK | DRAWN BY | |
| | DESIGNED BY | |
| | CHECKED BY | |


"AS-BUILT"

C.O.ADD.13

| FED. ROAD DIST. NO. | STATE | FED. AID PROJ. NO. | FISCAL YEAR | SHEET NO. | TOTAL SHEETS |
|---------------------|-------|--------------------|-------------|------------|--------------|
| KAUAI | HAW. | NH-056-1(50) | 2019 | C.O.ADD.14 | 244 |

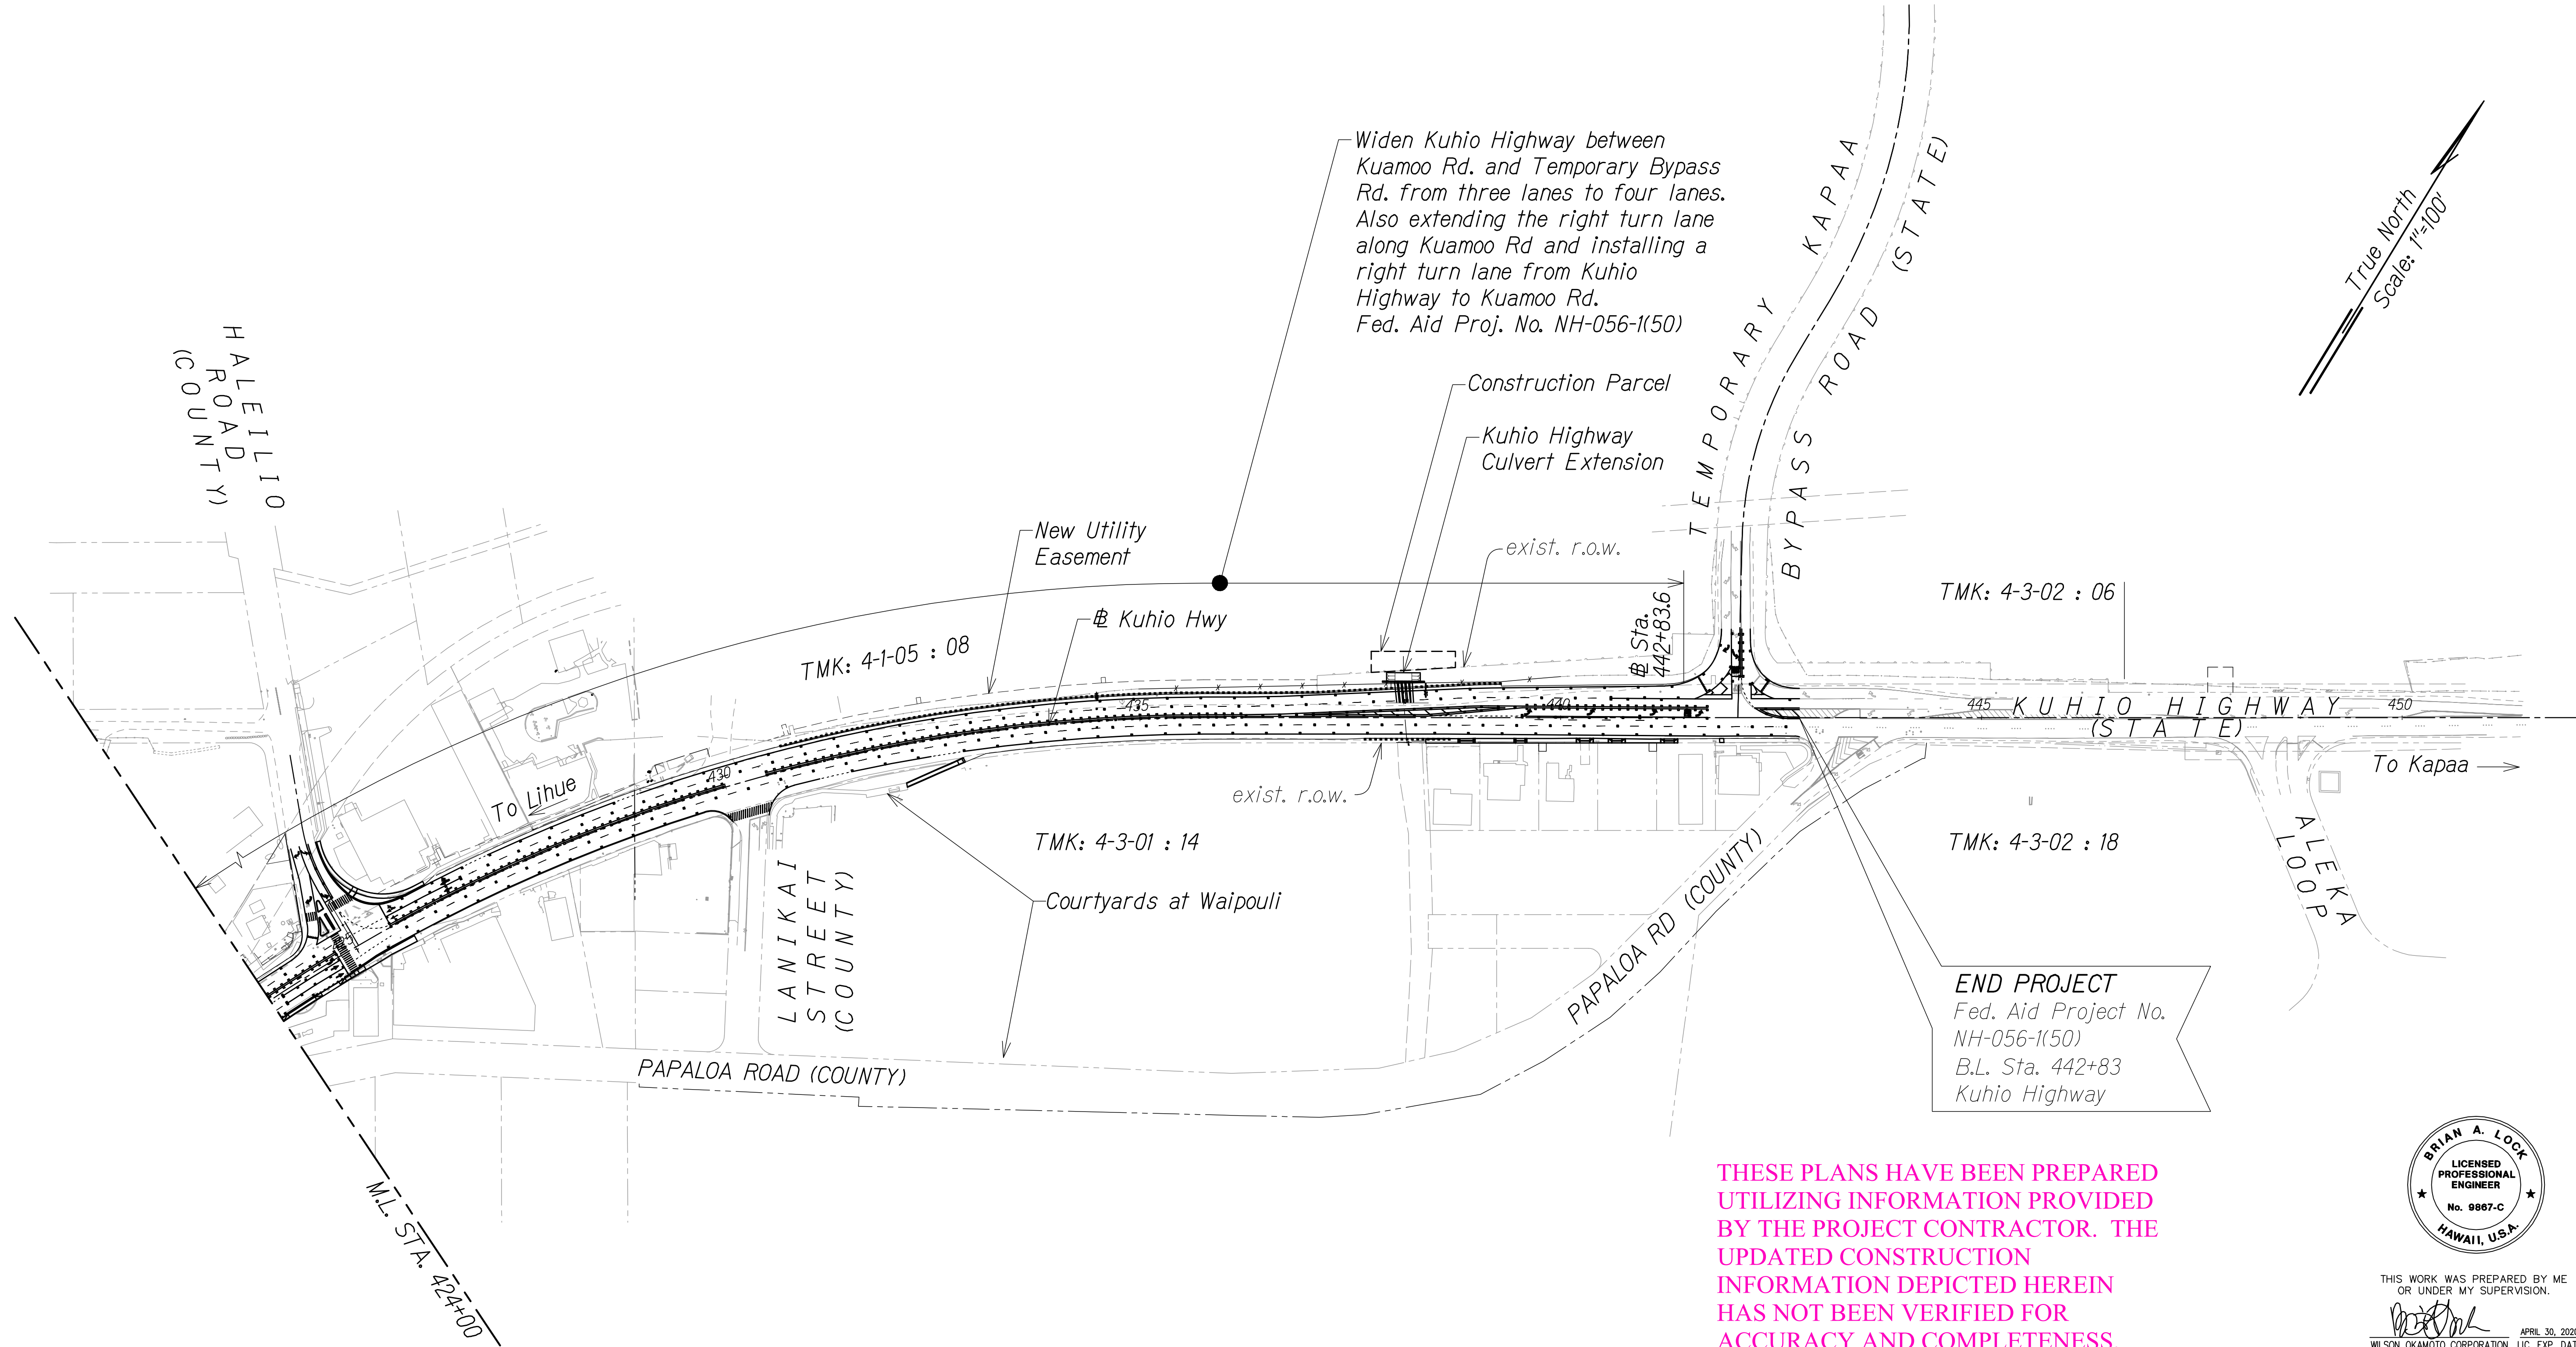

| | |
|-------------------|------|
| SURVEY PLOTTED BY | DATE |
| DRAWN BY | |
| TRACED BY | |
| CHECKED BY | |
| REVIEWED BY | |
| APPROVED BY | |
| DATE | |

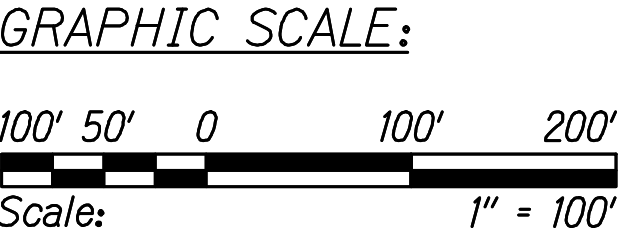

APPROVED


County Engineer
County of Kaua'i
(For Work Within the County Right-of-Way)

Date

| | |
|----------|---|
| 11/12/19 | △ Reissuing plan for legibility only. No design changes have been made. |
| 9/20/19 | △ Reissuing plan for legibility only. No design changes have been made. |

| DATE | REVISION |
|------|----------|
|------|----------|

"AS-BUILT"

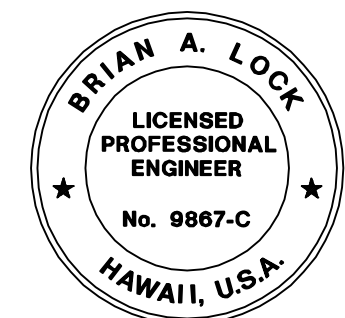

THIS WORK WAS PREPARED BY ME
OR UNDER MY SUPERVISION.
[Signature]
WILSON OKAMOTO CORPORATION LIC. EXP. DATE

STATE OF HAWAII
DEPARTMENT OF TRANSPORTATION
HIGHWAYS DIVISION

GENERAL PLAN

**KUHIO HIGHWAY SHORT-TERM
IMPROVEMENTS KUAMOO ROAD
TO TEMPORARY KAPAA BYPASS ROAD**
Fed. Aid Proj. No. NH-056-1(50)
Scale: 1" = 100' Date: July 2019

SHEET No. C2 OF 2 SHEETS

C.O.ADD.14