

INDEX TO DRAWINGS	
SHT. NO.	DESCRIPTION
1	TITLE SHEET
2-3	STANDARD PLANS SUMMARY
4-10	NOTES
11-12	WATER POLLUTION AND EROSION CONTROL NOTES
13-14	GENERAL PLANS
15-23	TYPICAL ROADWAY SECTIONS
24-25	DEMOLITION PLANS
26-33	ROADWAY PLANS
34-41	PAVEMENT PLANS
42-51	GRADING PLANS
52-54	CULVERT DETAILS
55-65	UTILITY PLANS AND DETAILS (1) (2)
66-74	PAVEMENT MARKING AND SIGNING PLANS
75-87	KUAMO'O ROAD PLANS
88-92	EROSION CONTROL PLANS
93-98	GUARDRAIL DETAILS
99-100	MILLED RUMBLE STRIP DETAILS
101-111	TRAFFIC DETAILS
112-174	TRAFFIC CONTROL PLANS
175-178	TRAFFIC SIGNAL SERIES
179-186	ROADWAY CROSS SECTIONS
187-207	STRUCTURAL PLANS
208-244	ELECTRICAL PLANS

SHEET NOS. (1) C.O. ADD 62 S-1 AND (2) C.O. ADD 65 S-1
ARE SUPPLEMENTARY SHEETS TO THIS PROJECT. TOTAL
SHEET COUNT AFTER "AS-BUILT" POSTING 246 SHEETS.



WILSON OKAMOTO CORPORATION
DESIGNED BY
HWY-DD
MANAGED BY
692-7570
PHONE
JULY 2019
DATE

CHANGES MADE DURING CONSTRUCTION HAVE
BEEN INCORPORATED ON THESE PLANS EXCEPT
CHANGES IN THE ORIGINAL THEORETICAL
QUANTITIES. FOR ACTUAL QUANTITIES, REFER TO
PROJECT LEDGER AND/OR COMPUTATION BOOK.

RESIDENT ENGINEER
DATE
Oct 9, 2024

GROSS LENGTH OF PROJECT 0.65 MILE
NET LENGTH OF PROJECT 0.65 MILE

LAYOUT PLAN
NOT TO SCALE

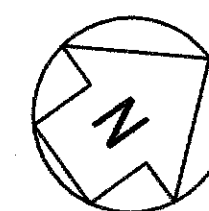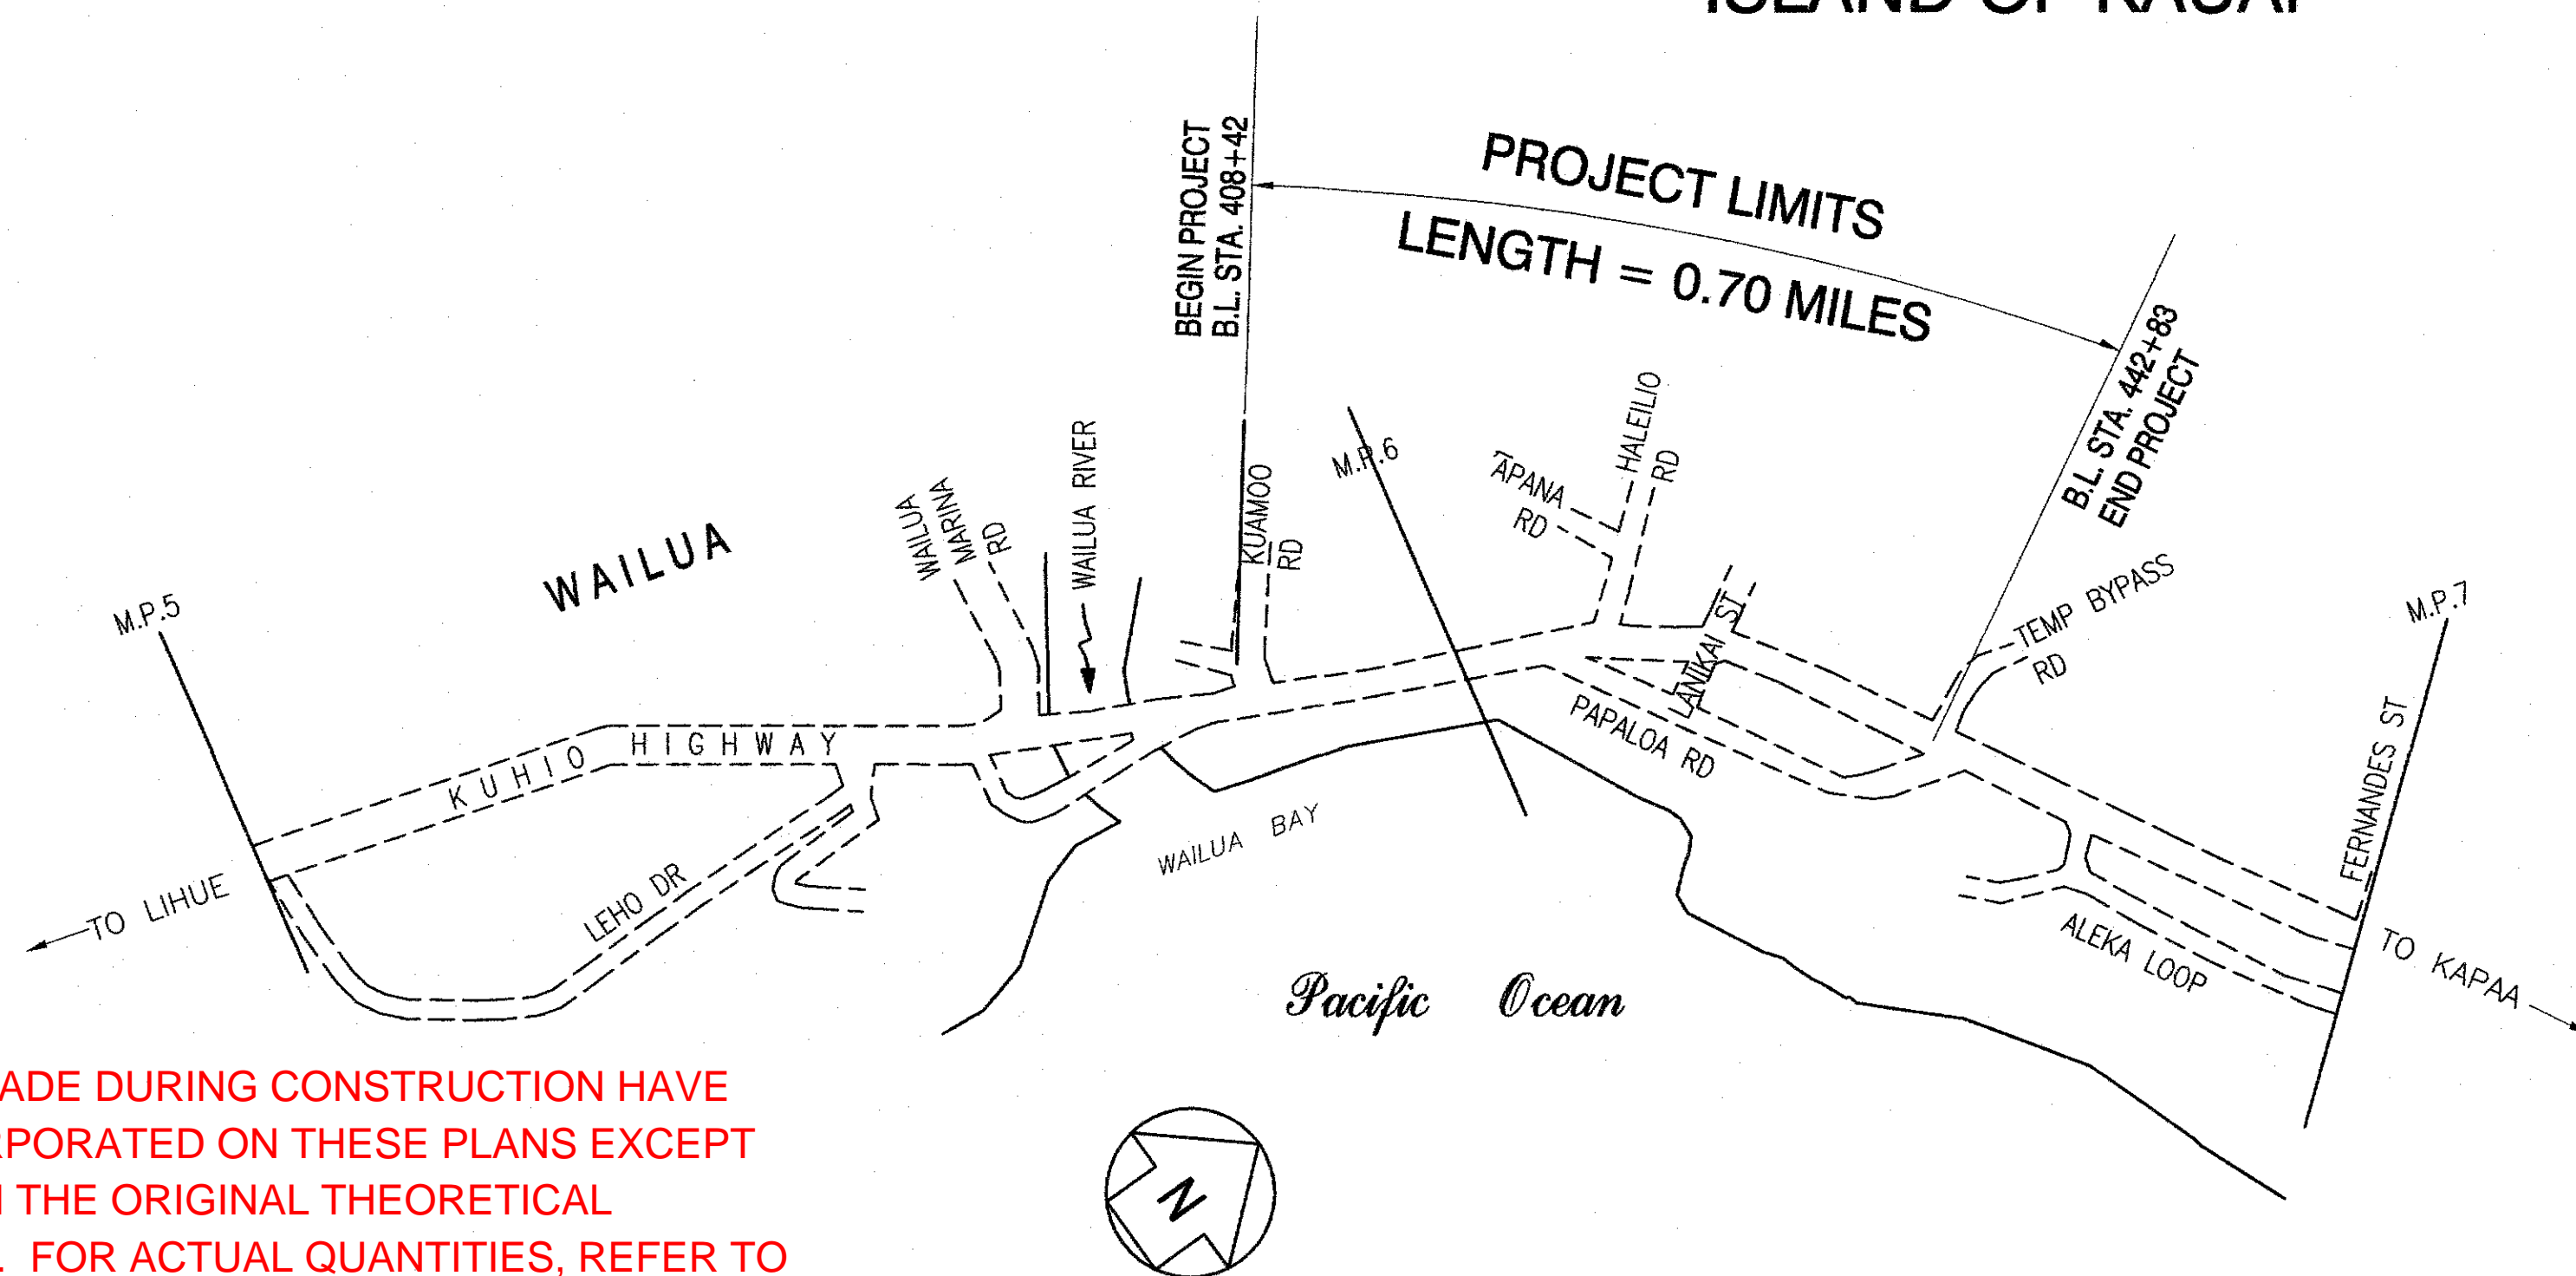

Pacific Ocean

WAILUA RIVER

WAILUA

M.P. 5

PROJECT LIMITS
LENGTH = 0.70 MILES

BEGIN PROJECT
B.L. STA. 408+42

B.L. STA. 442+83
END PROJECT

M.P. 6

HALELIU RD

PAPALOA RD

LANIKAI RD

TEMP BYPASS RD

HALELIU RD

PAPALOA RD

LANIKAI RD

TEMP BYPASS RD

