
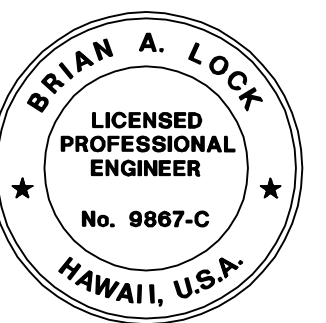
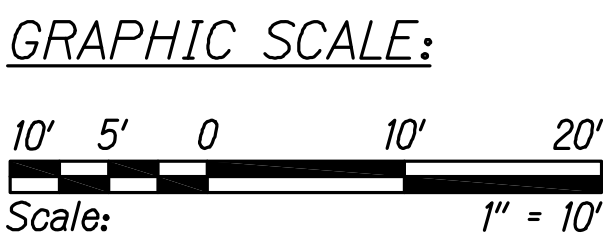
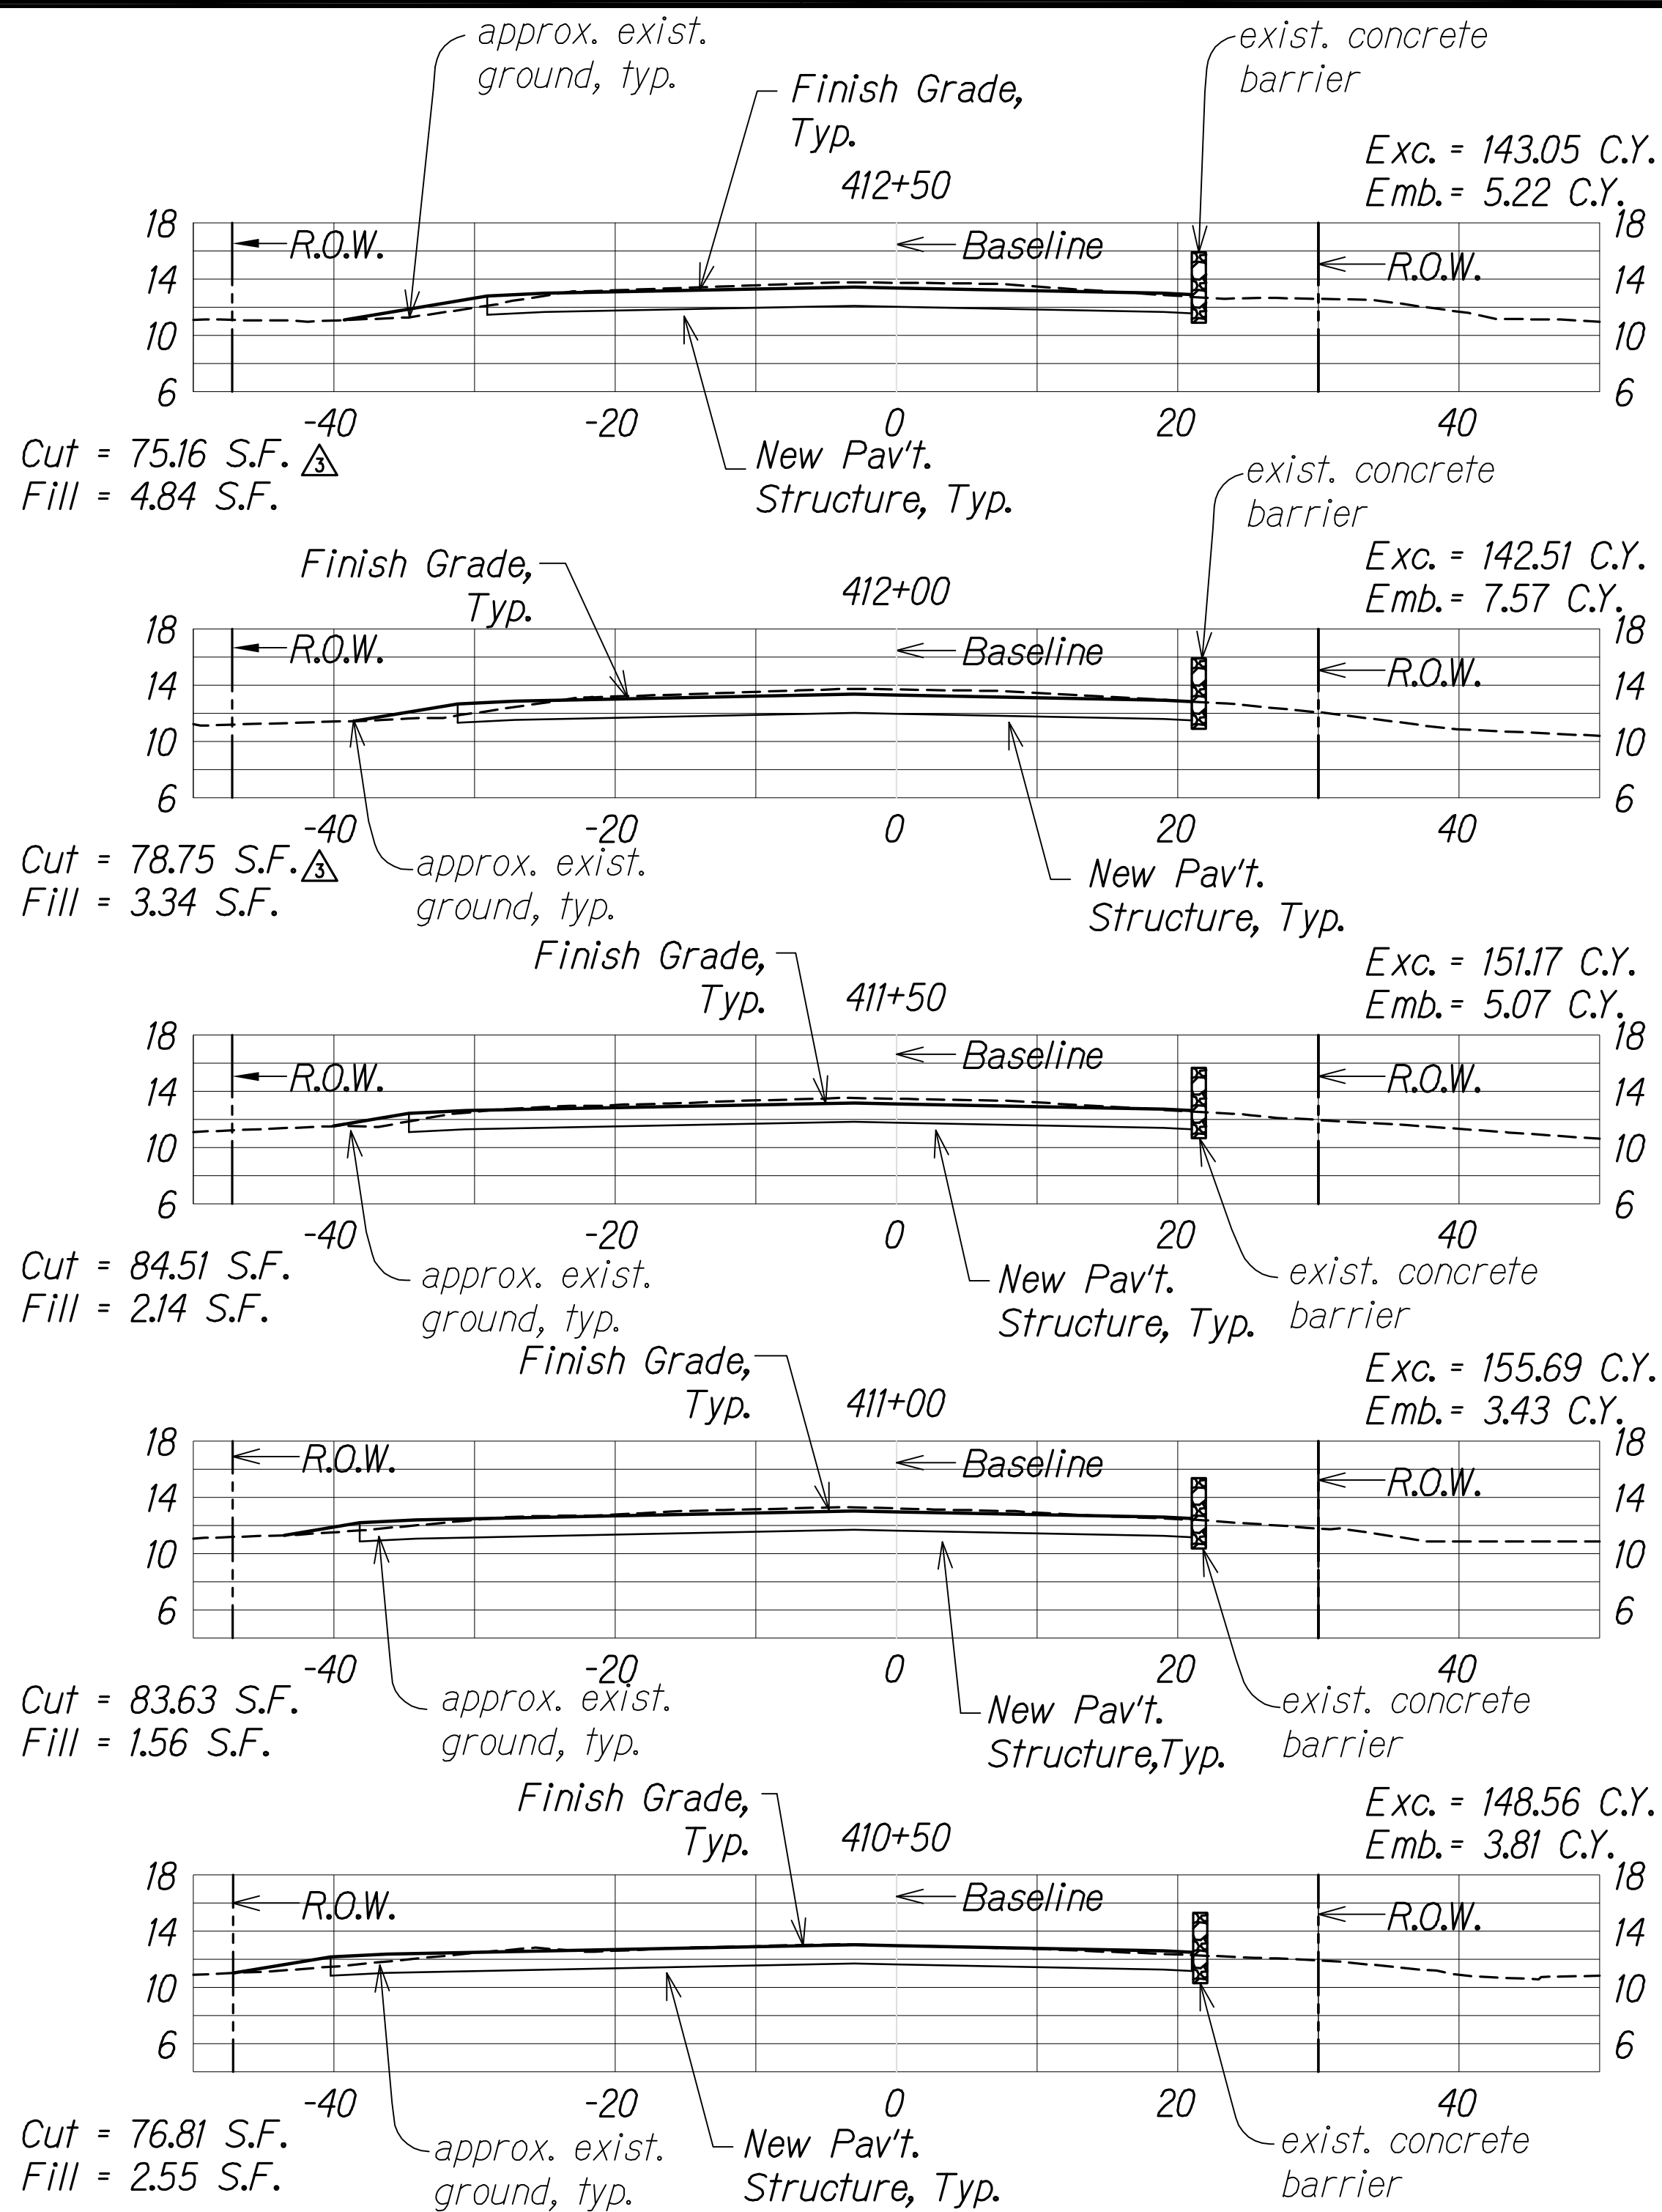


FED. ROAD DIST. NO.	STATE	FED. AID PROJ. NO.	FISCAL YEAR	SHEET NO.	TOTAL SHEETS
KAUAI	HAW.	NH-056-1(50)	2019	ADD.179	244

Sheet Total  
Exc. = 1362.28 C.Y.  
Emb. = 36.74 C.Y.

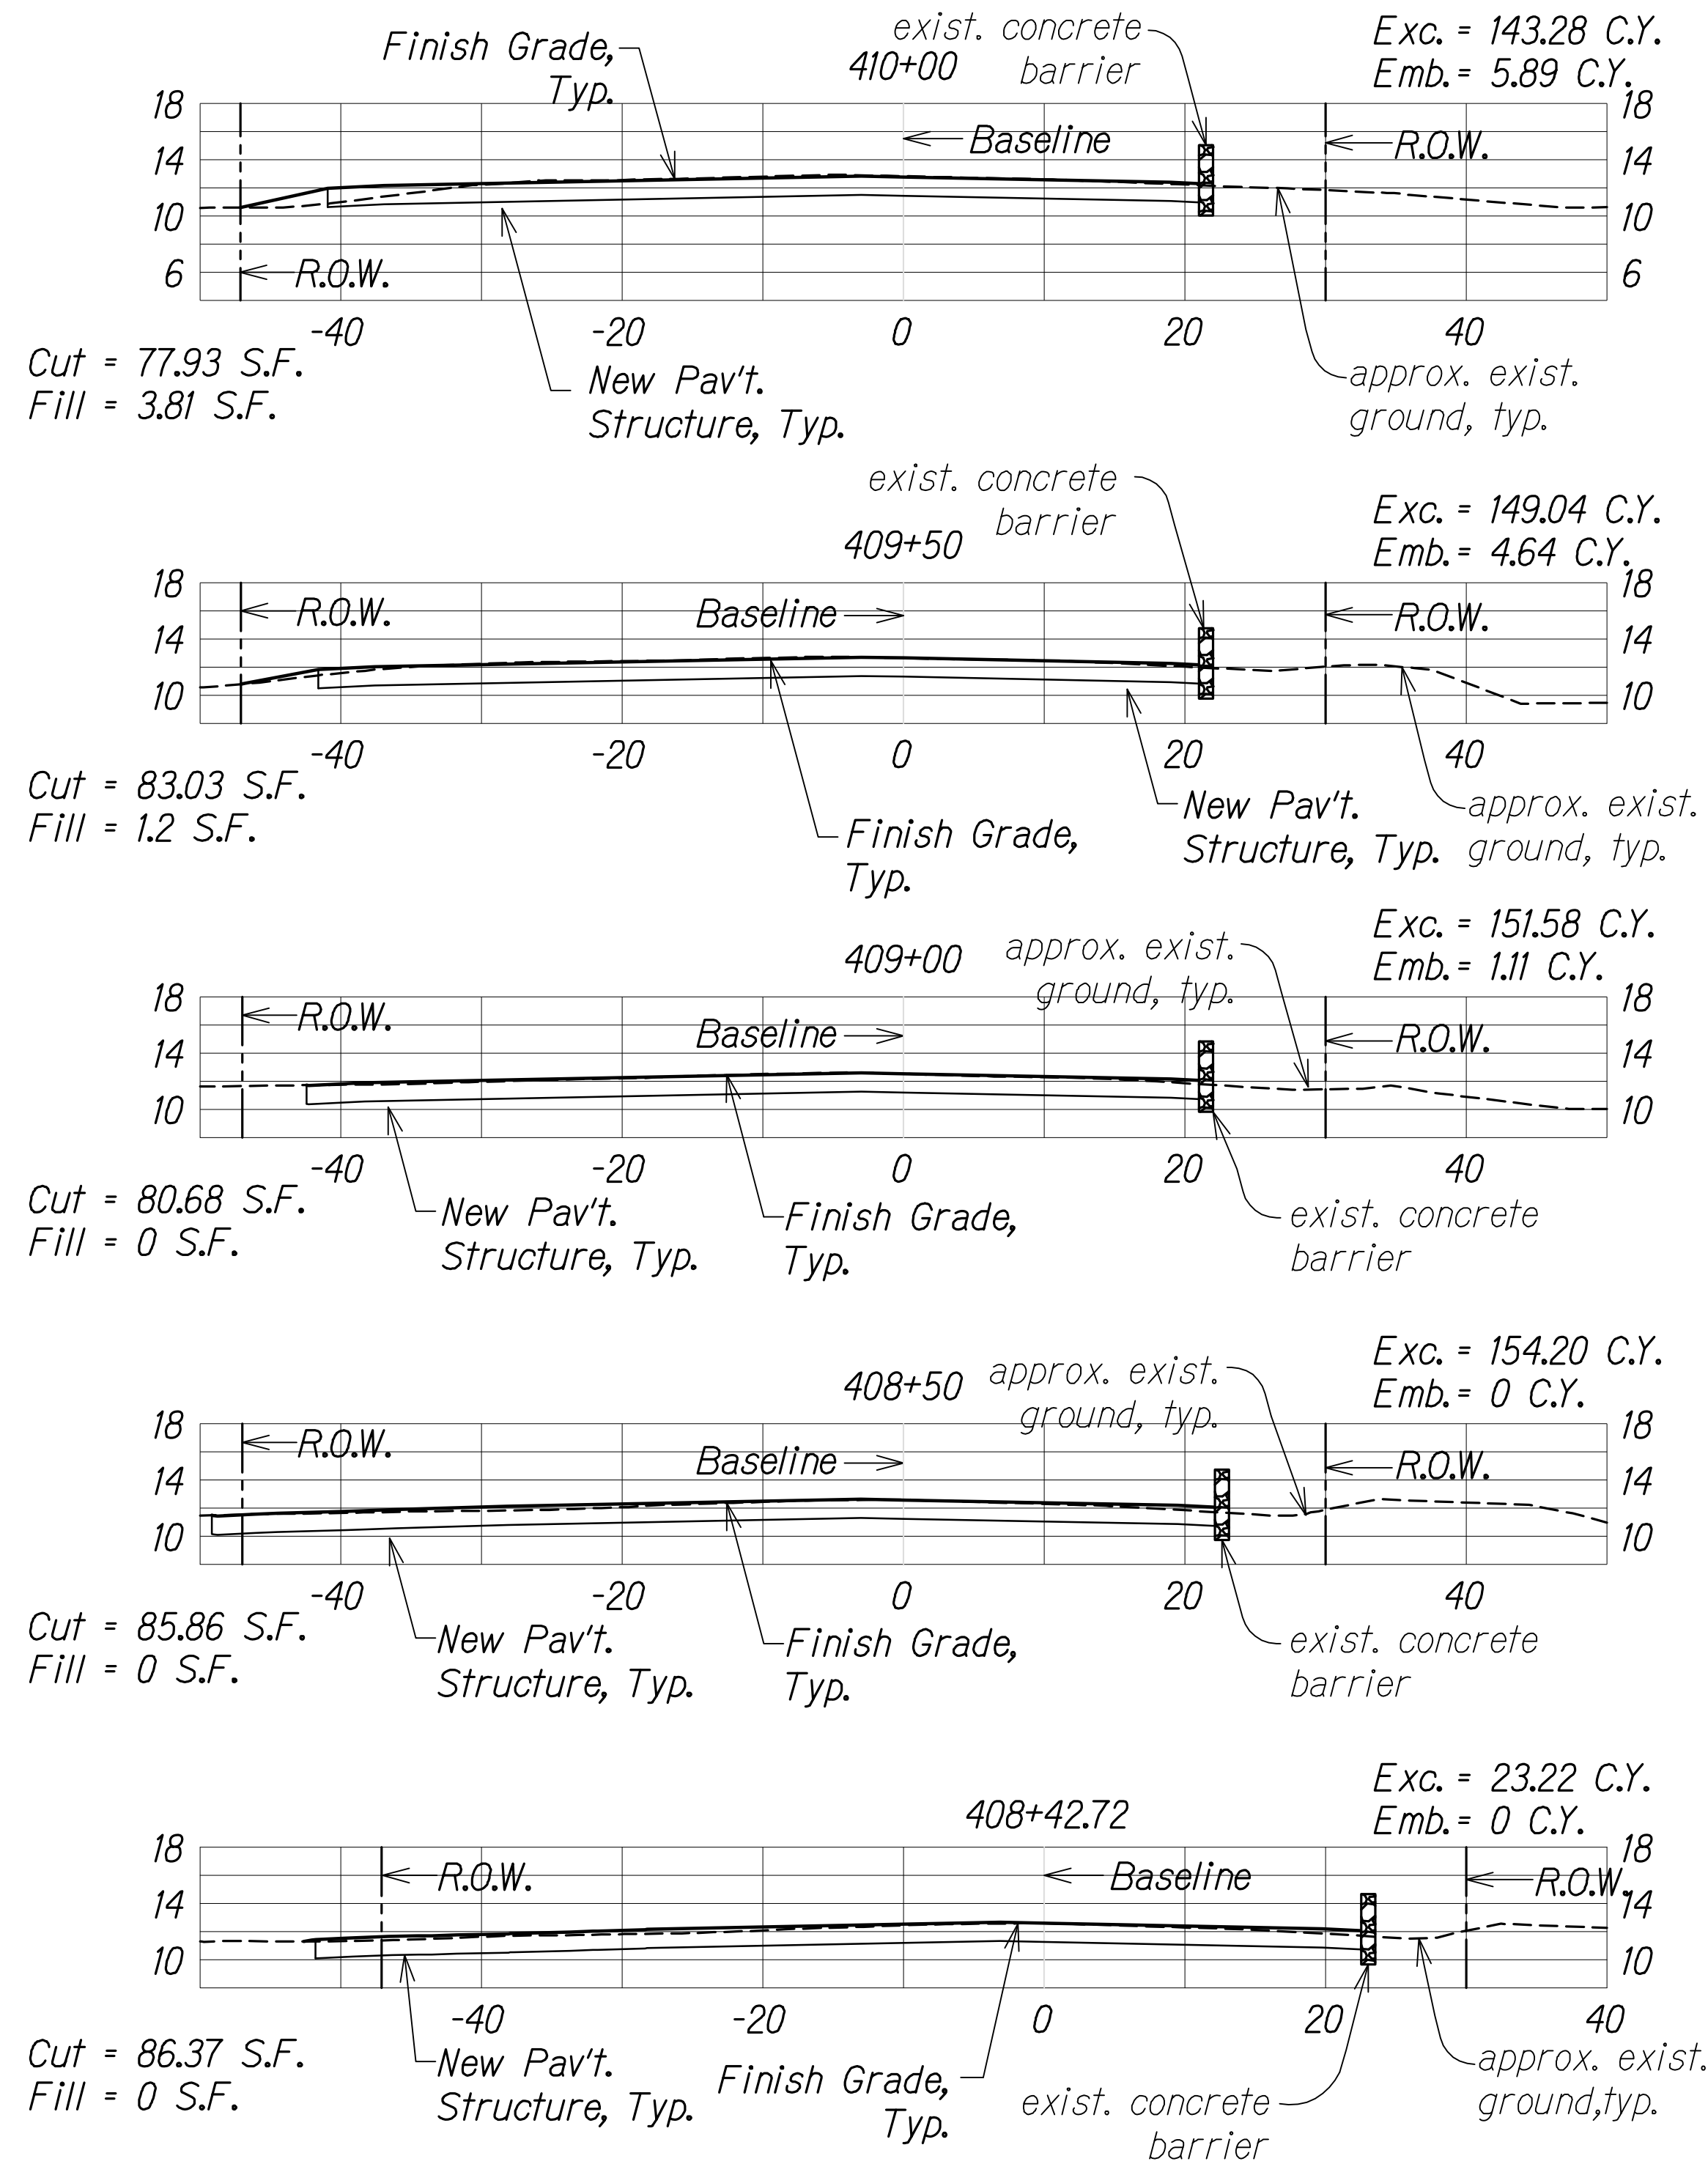

THIS WORK WAS PREPARED BY ME  
OR UNDER MY SUPERVISION.  
WILSON OKAMOTO CORPORATION  
APRIL 30, 2020  
LIC. EXP. DATE

STATE OF HAWAII  
DEPARTMENT OF TRANSPORTATION  
HIGHWAYS DIVISION

ROADWAY CROSS SECTIONS

KUHIO HIGHWAY SHORT-TERM  
IMPROVEMENTS KUAMOO ROAD  
TO TEMPORARY KAPAA BYPASS ROAD  
Fed. Aid Proj. No. NH-056-1(50)  
Scale: 1" = 10' Date: July 2019

SHEET No. XS1 OF 8 SHEETS

ADD.179
















Kuhio Highway Improvements  
ROADWAY CROSS SECTIONS  
Scale: 1" = 10'

11/12/19	Reissuing plan for legibility; revised cross section
9/20/19	Reissuing plan for legibility only. No design changes have been made.
DATE	REVISION

SURVEY PLOTTED BY	DATE
DRAWN BY	
TRACED BY	
CHECKED BY	
ORIGINAL PLAN	
NOTE BOOK	
No.	

FED. ROAD DIST. NO.	STATE	FED. AID PROJ. NO.	FISCAL YEAR	SHEET NO.	TOTAL SHEETS
KAUAI	HAW.	NH-056-1(50)	2019	ADD.180	244

Sheet Total  
Exc. = 1803.53 C.Y.  
Emb. = 3.80 C.Y.

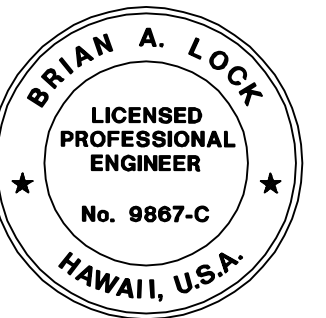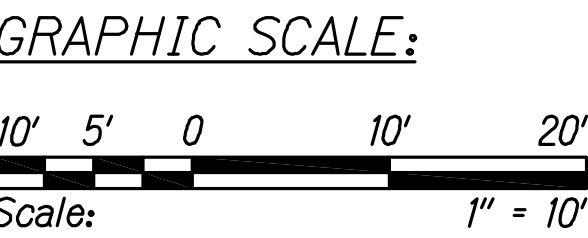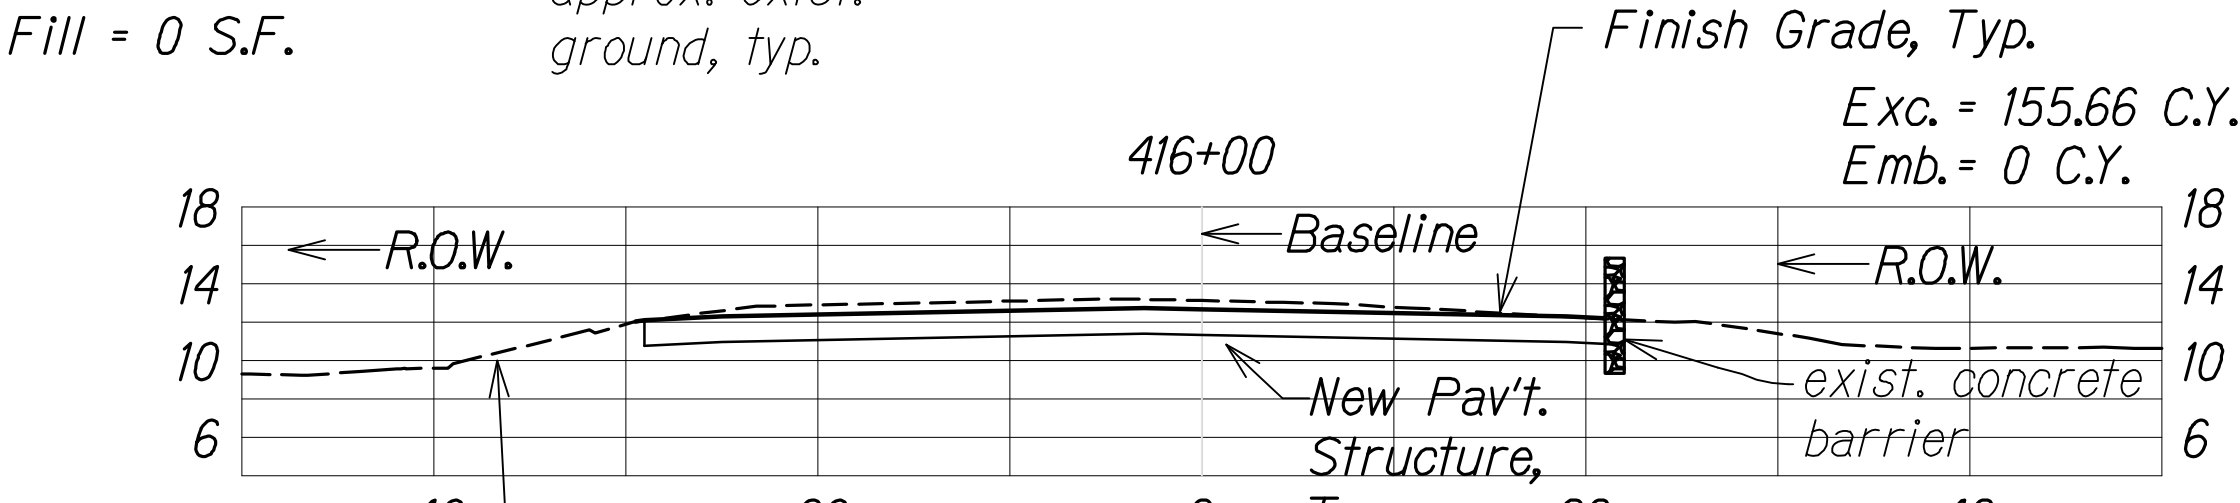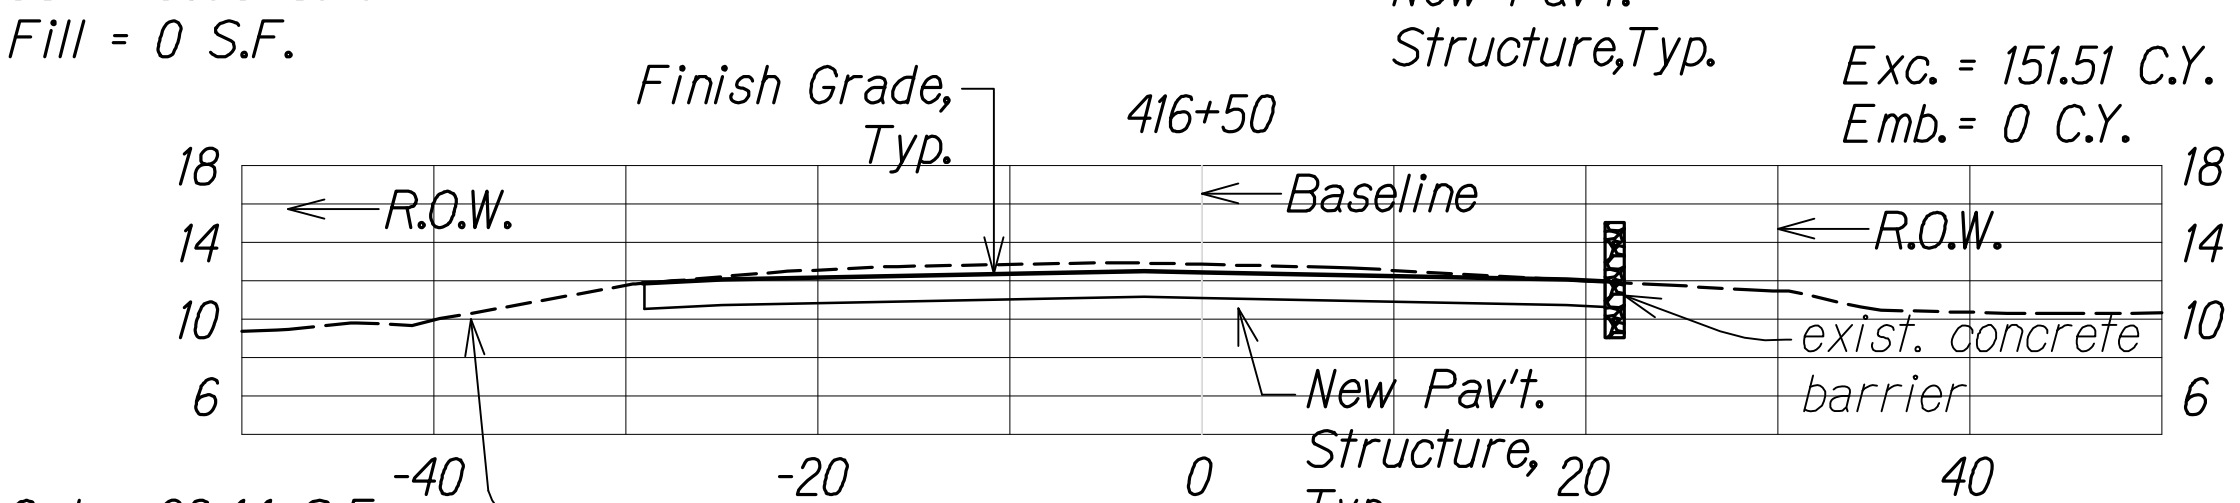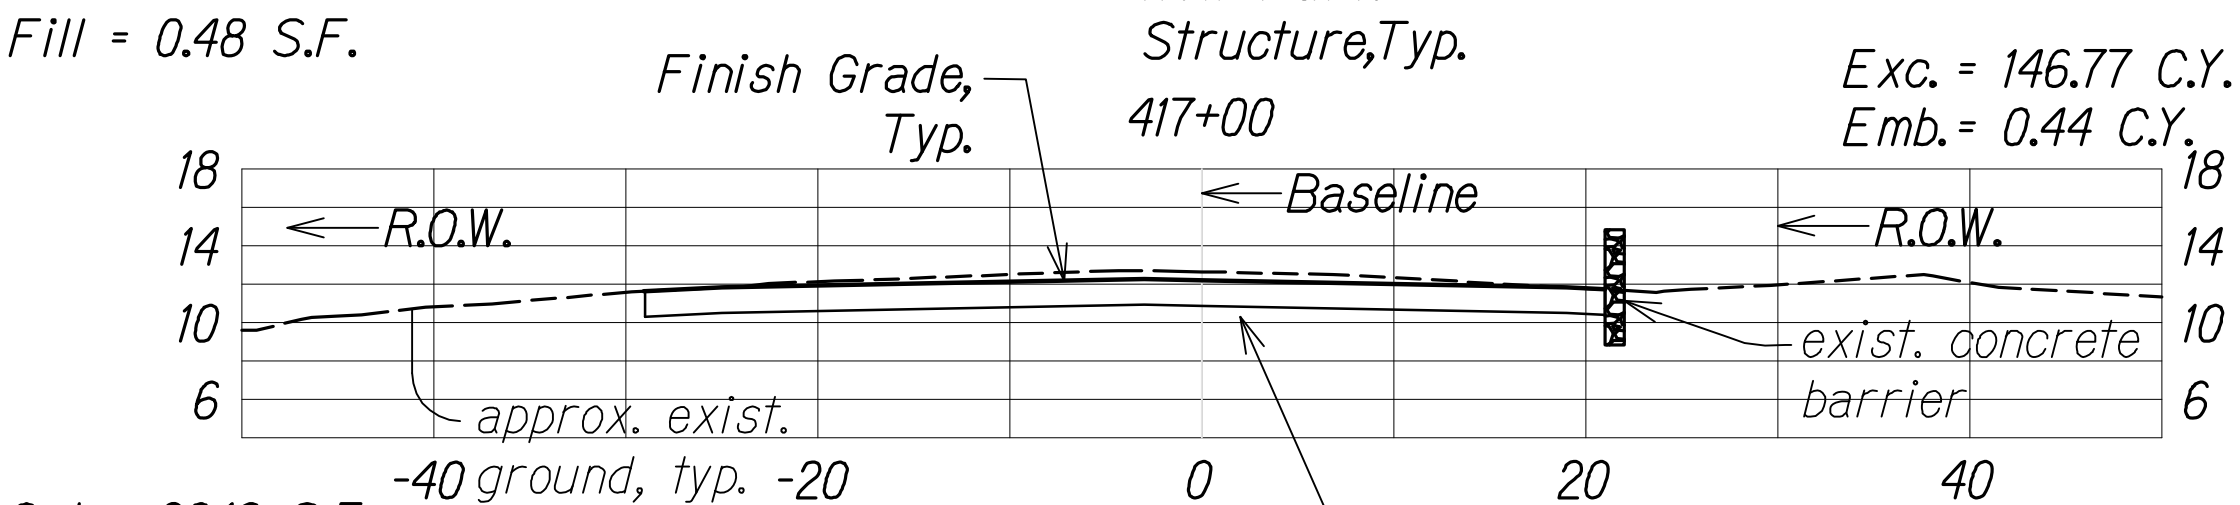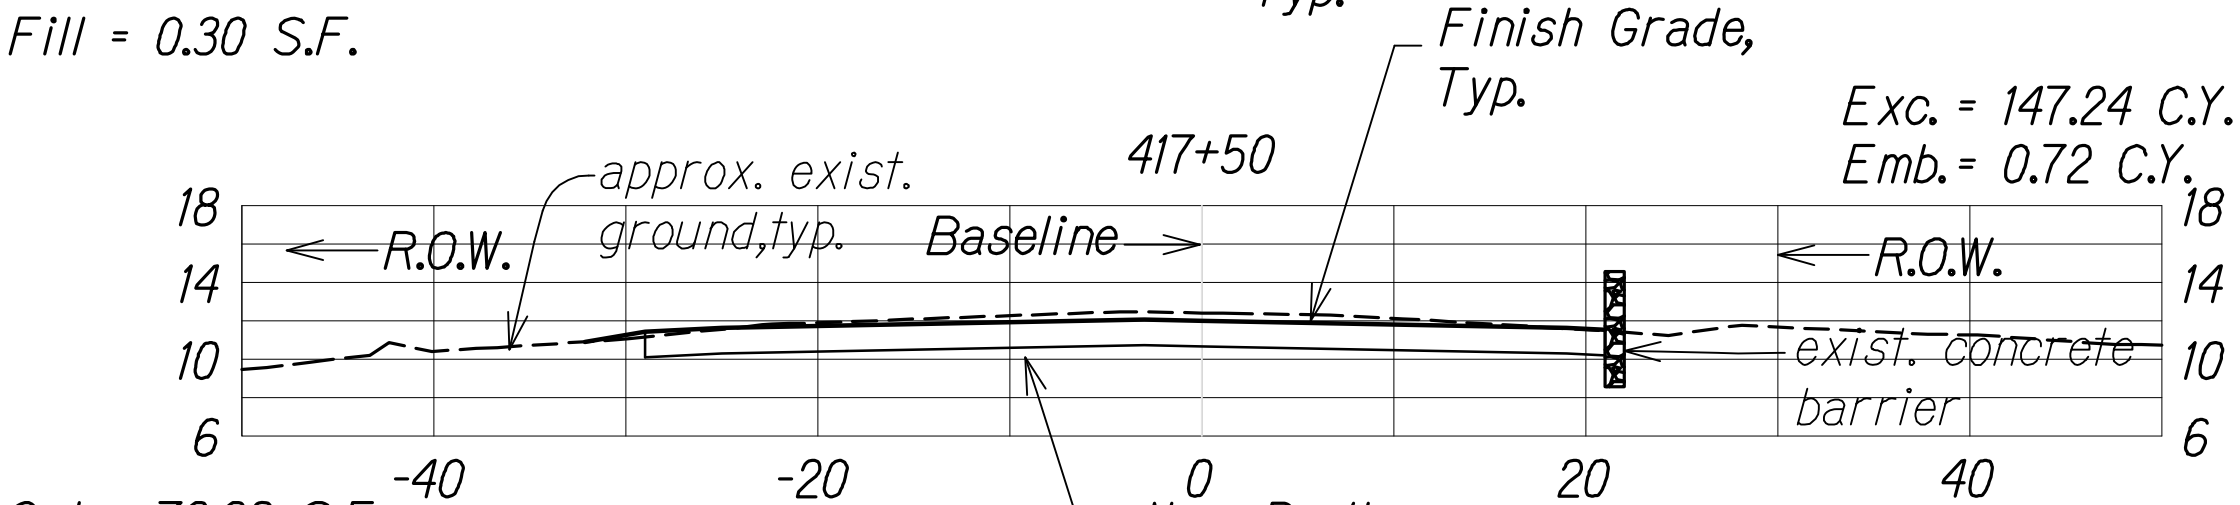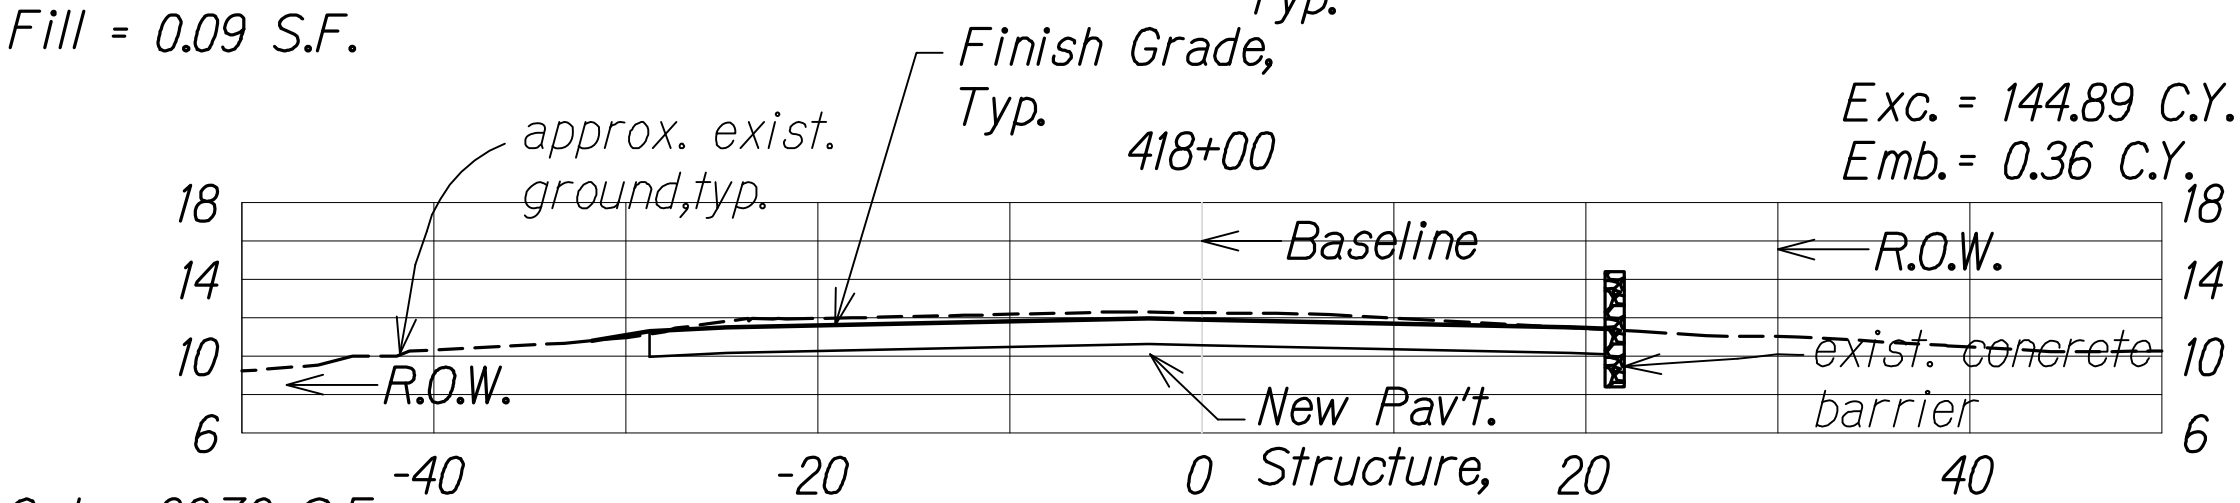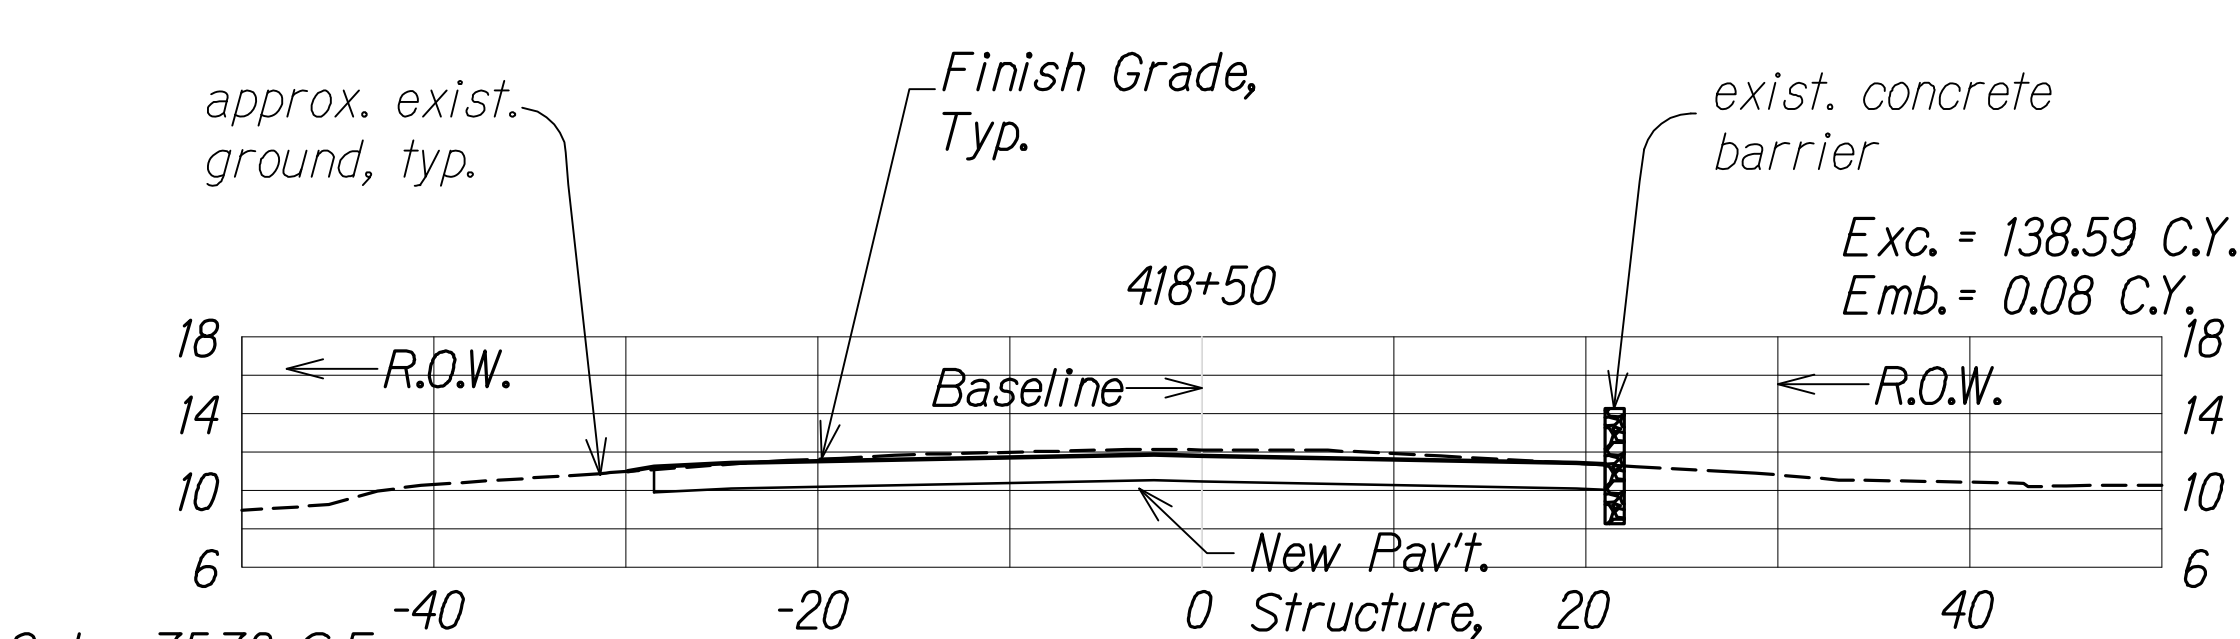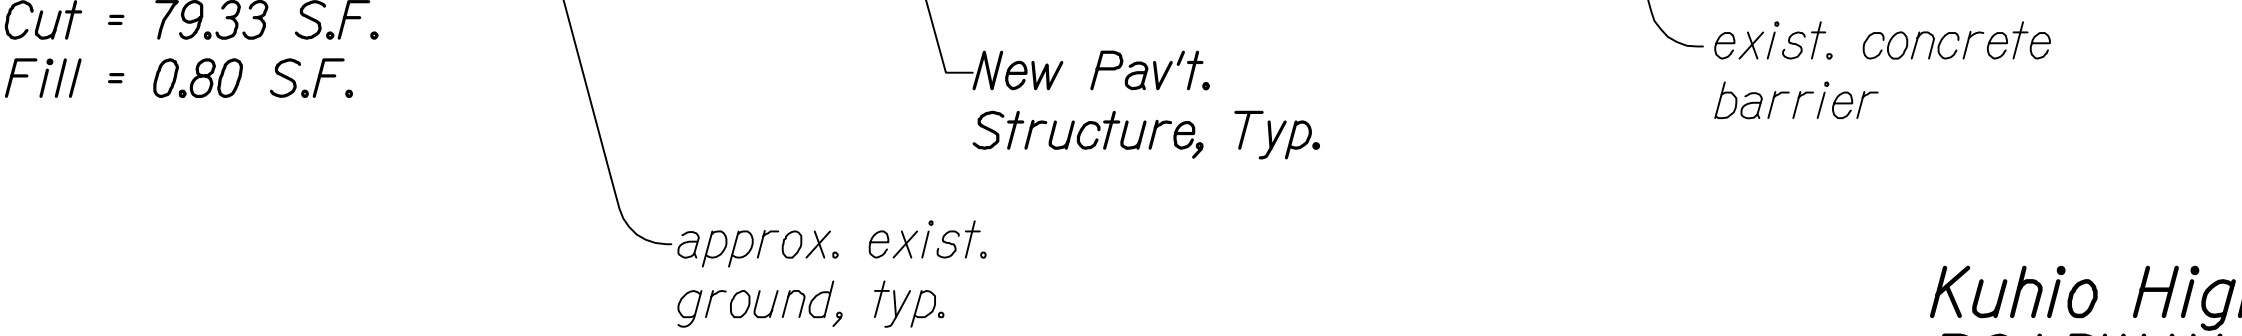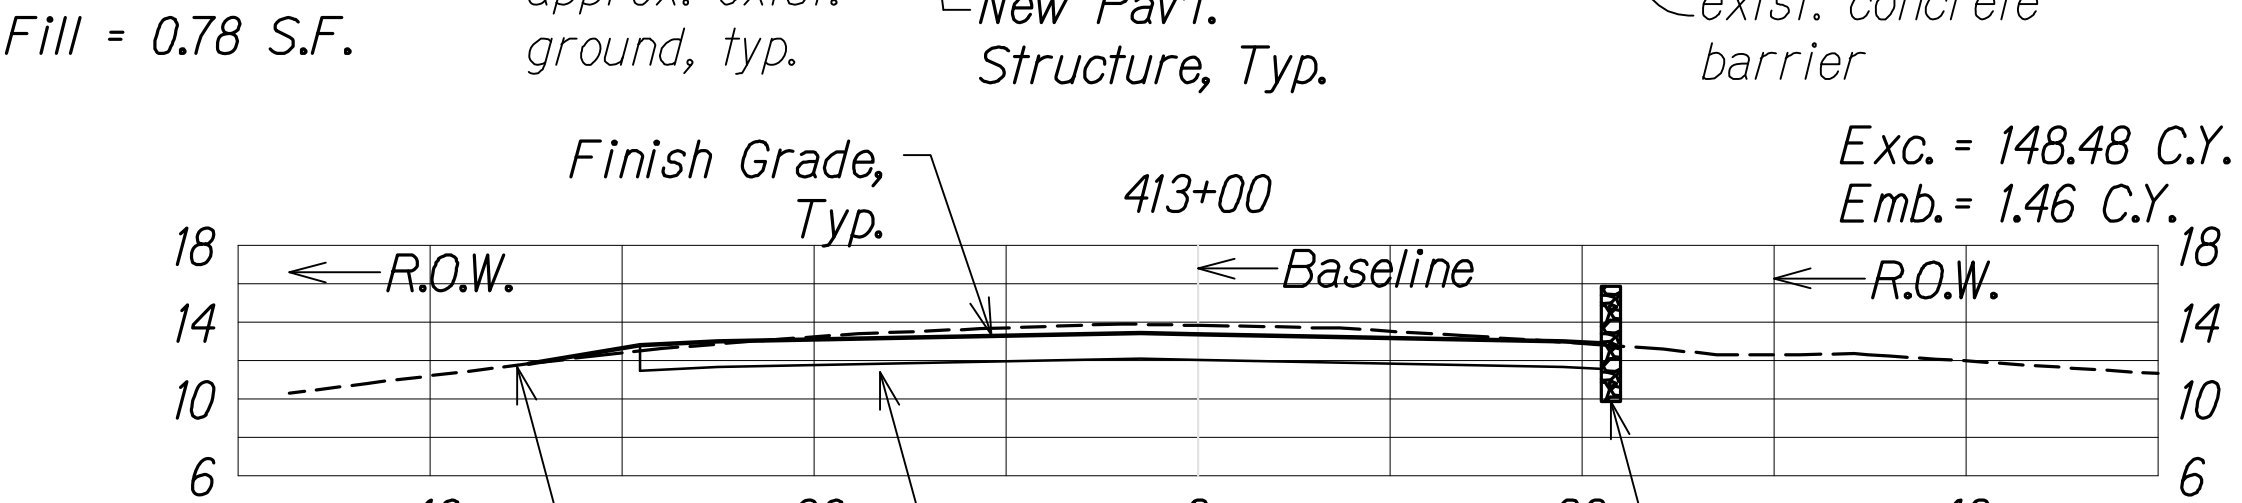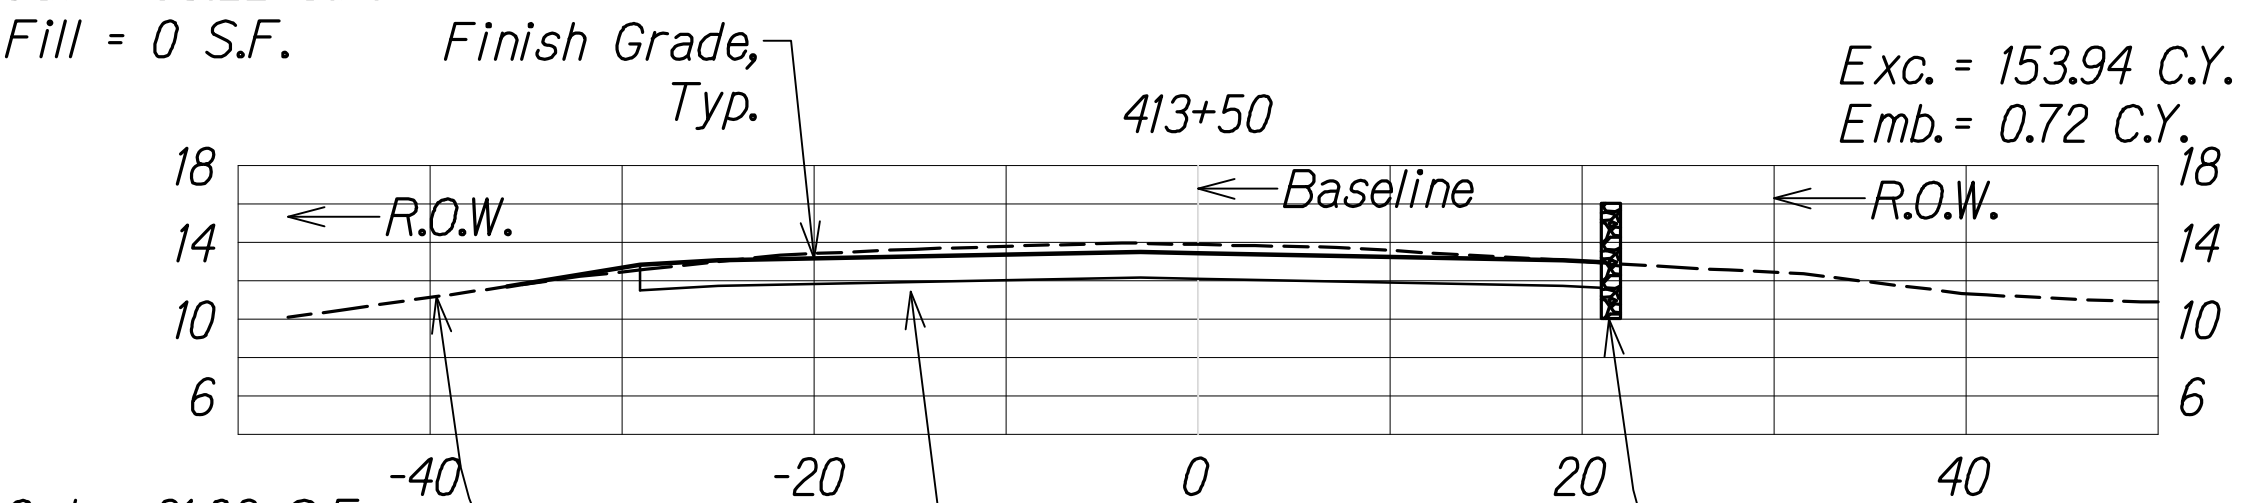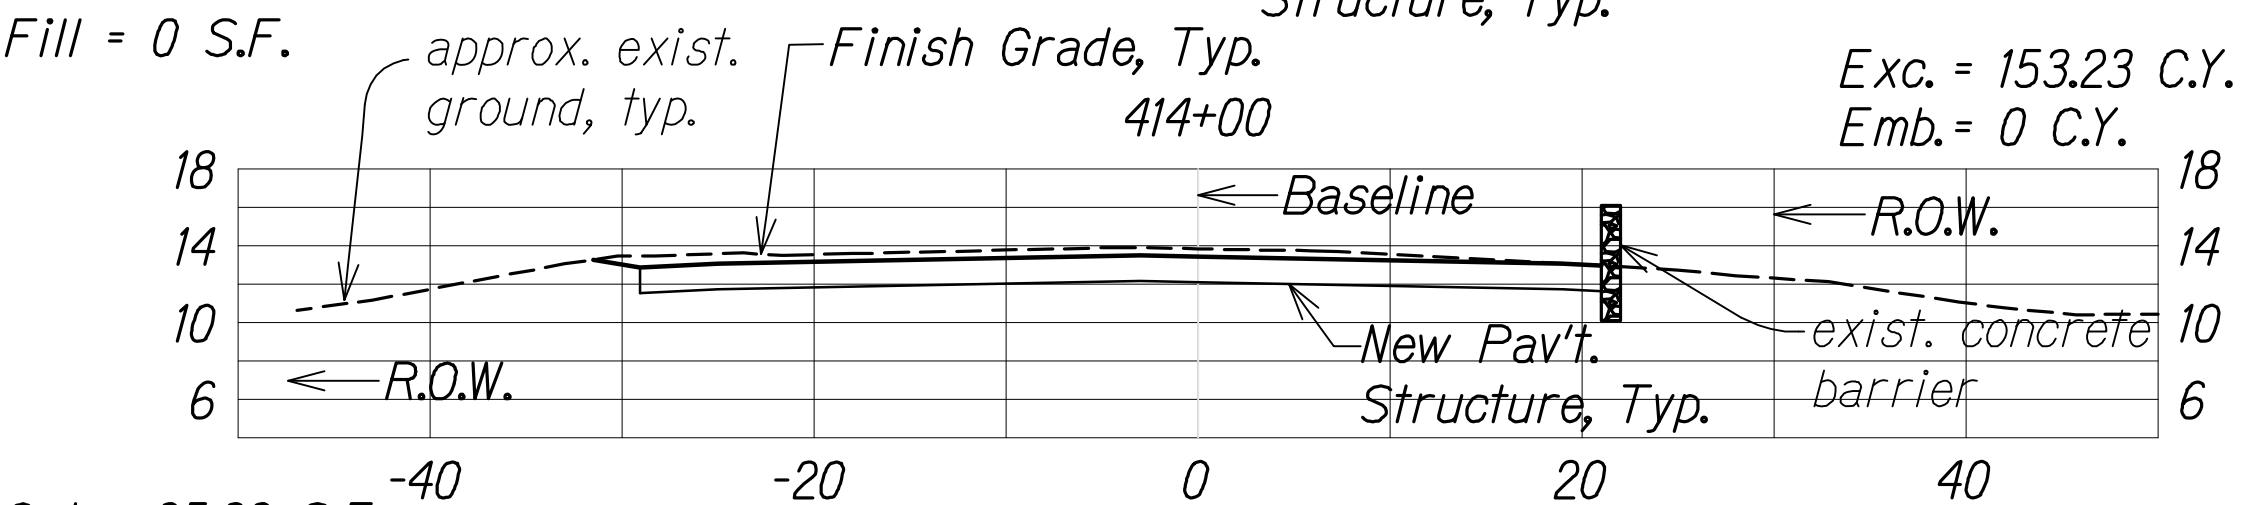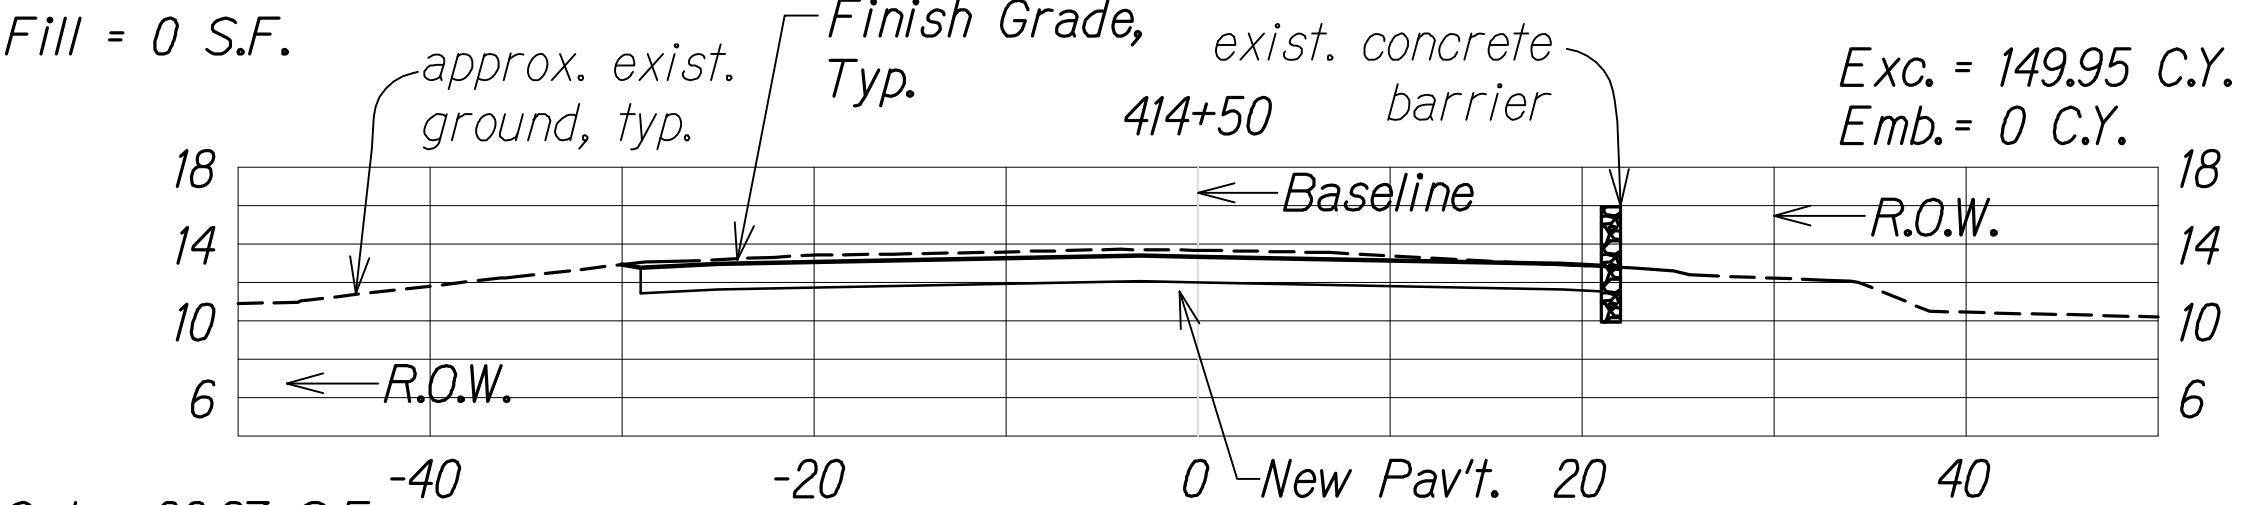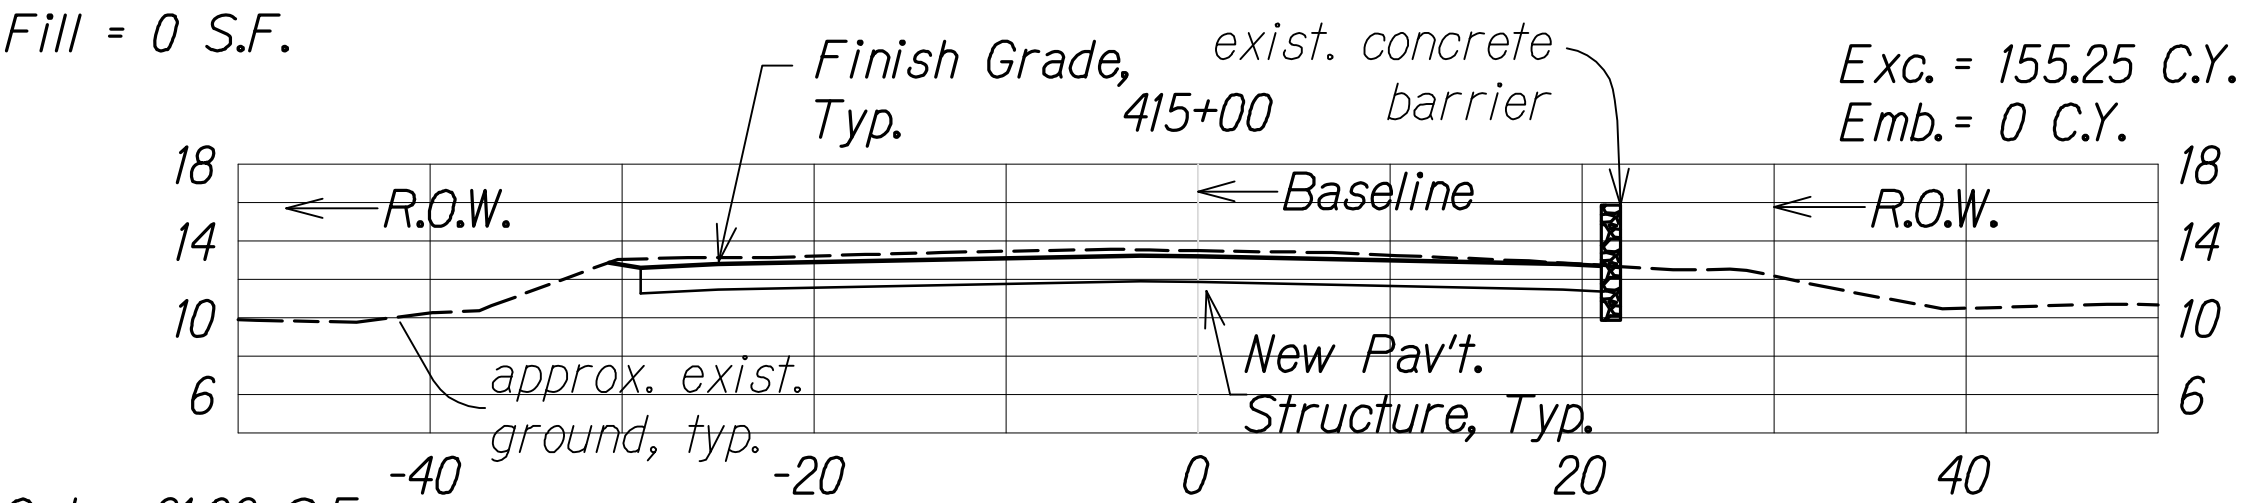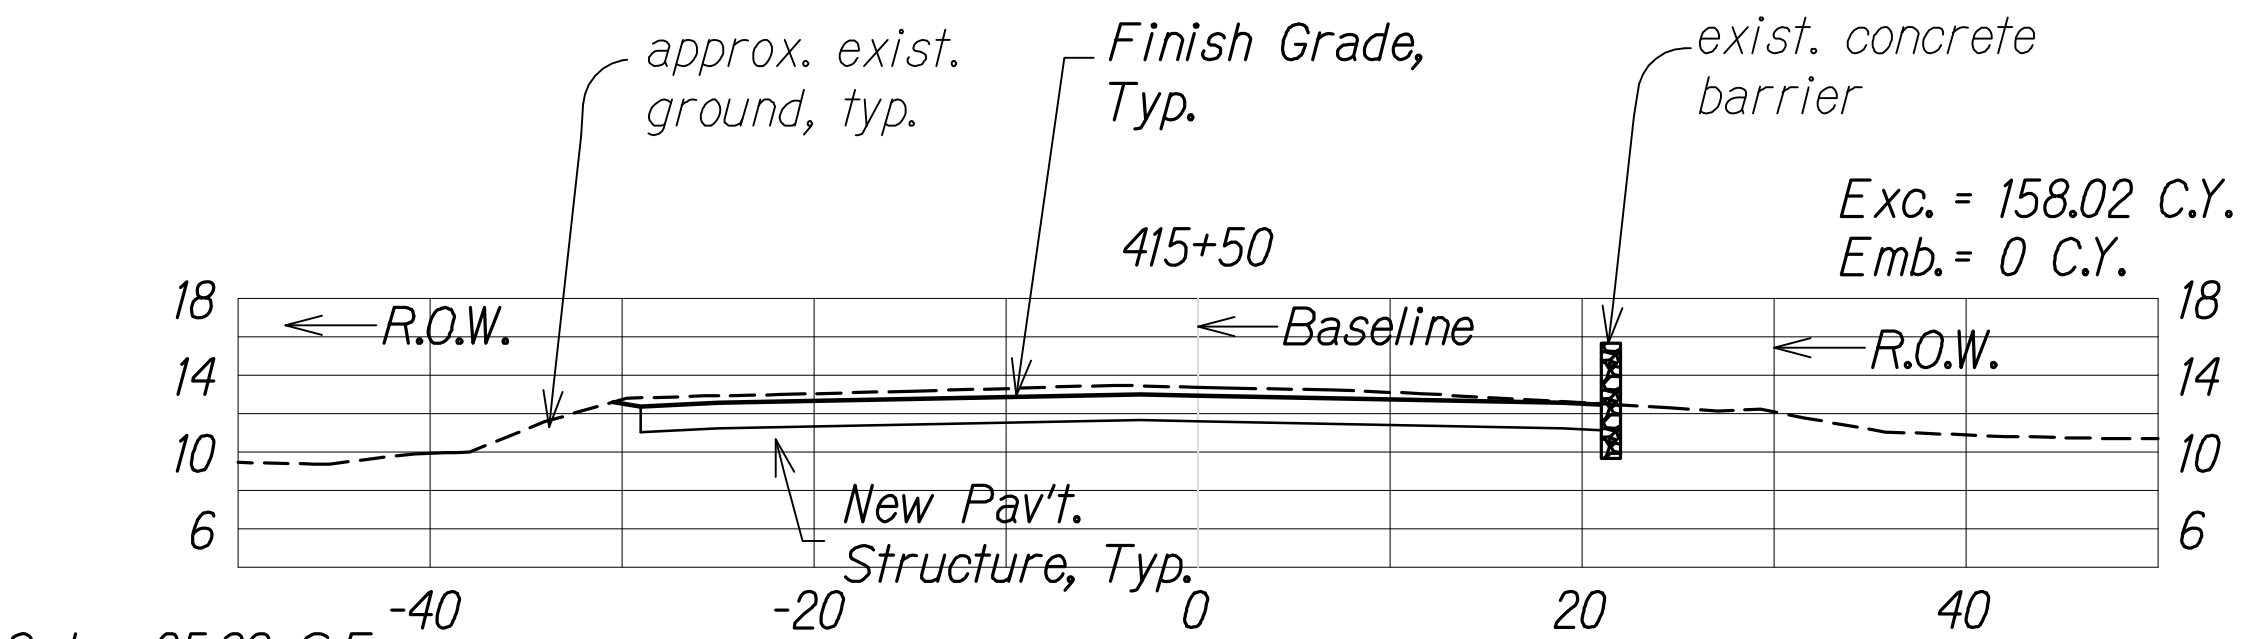

THIS WORK WAS PREPARED BY ME  
OR UNDER MY SUPERVISION.  
WILSON OKAMOTO CORPORATION  
APRIL 30, 2020  
LIC. EXP. DATE

STATE OF HAWAII  
DEPARTMENT OF TRANSPORTATION  
HIGHWAYS DIVISION

ROADWAY CROSS SECTIONS

KUHIO HIGHWAY SHORT-TERM  
IMPROVEMENTS KUAMOO ROAD  
TO TEMPORARY KAPAA BYPASS ROAD  
Fed. Aid Proj. No. NH-056-1(50)  
Scale: 1" = 10' Date: July 2019

SHEET No. XS2 OF 8 SHEETS

SURVEY PLATTED BY	DATE
DRAWN BY	
TRACED BY	
CHECKED BY	
ORIGINAL PLAN	
NOTE BOOK	
No.	













Kuhio Highway Improvements  
ROADWAY CROSS SECTIONS  
Scale: 1" = 10'

11/12/19	△ Reissuing plan for legibility only. No design changes have been made.
9/20/19	△ Reissuing plan for legibility only. No design changes have been made.
DATE	REVISION







FED. ROAD DIST. NO.	STATE	FED. AID PROJ. NO.	FISCAL YEAR	SHEET NO.	TOTAL SHEETS
KAUAI	HAW.	NH-056-1(50)	2019	ADD.182	244

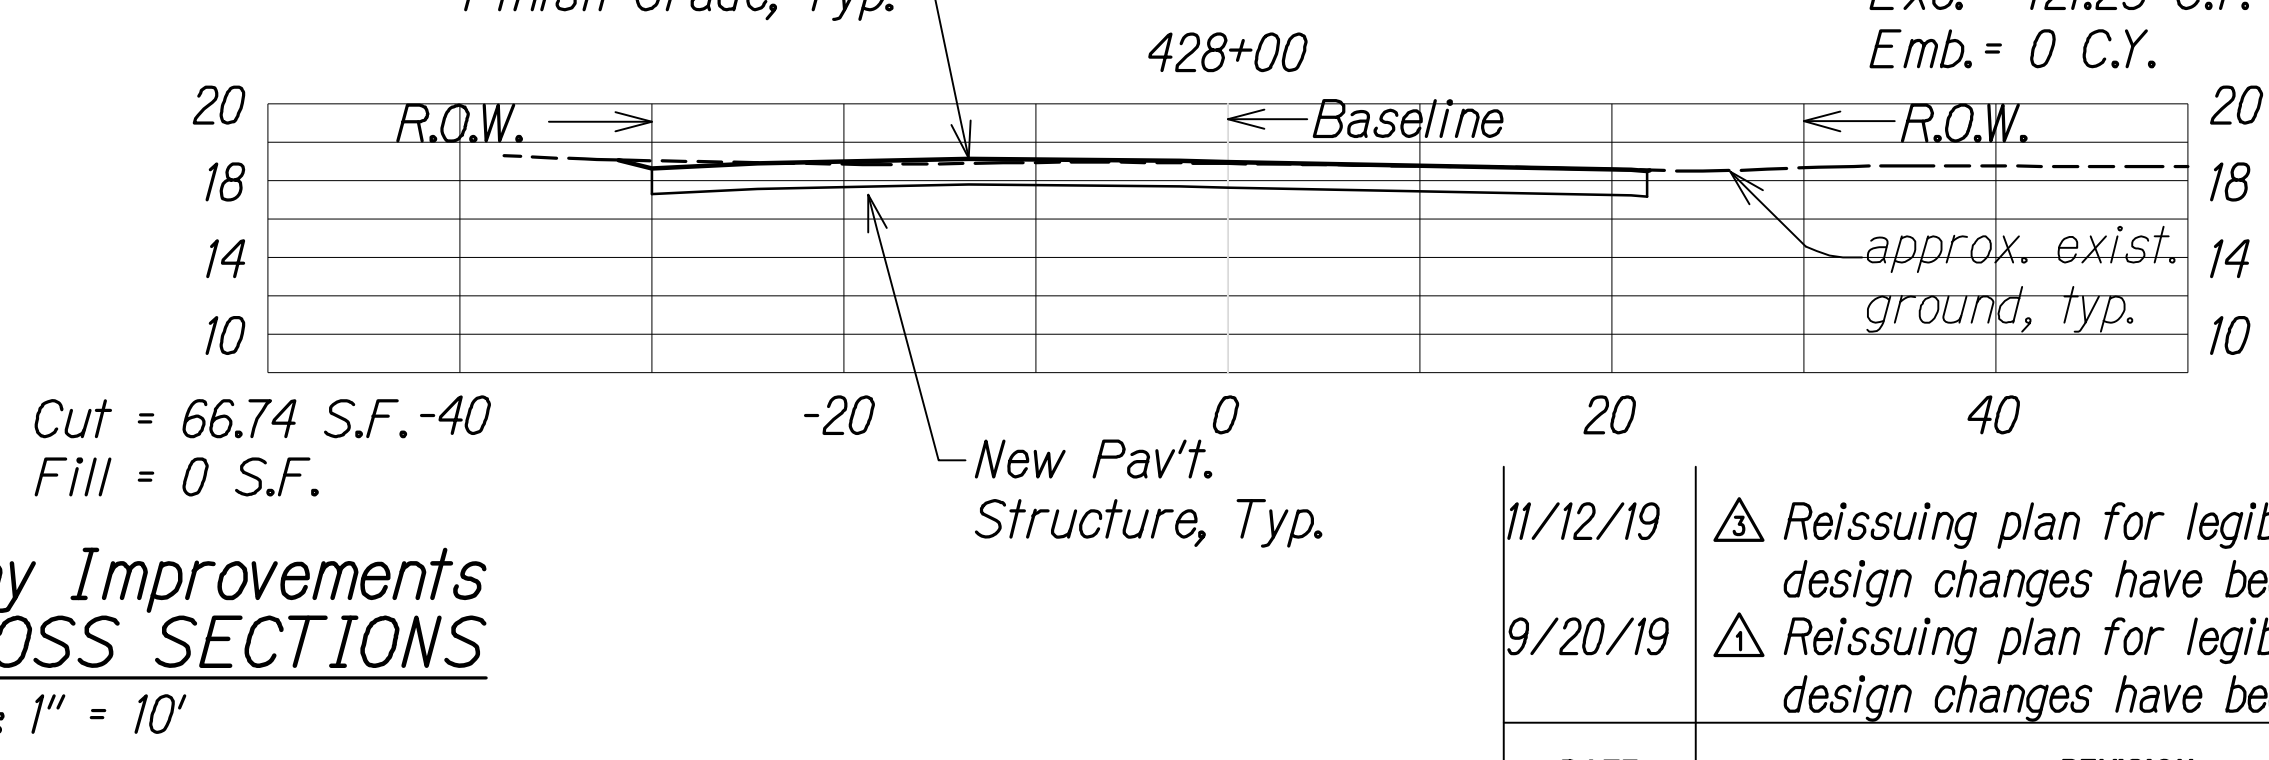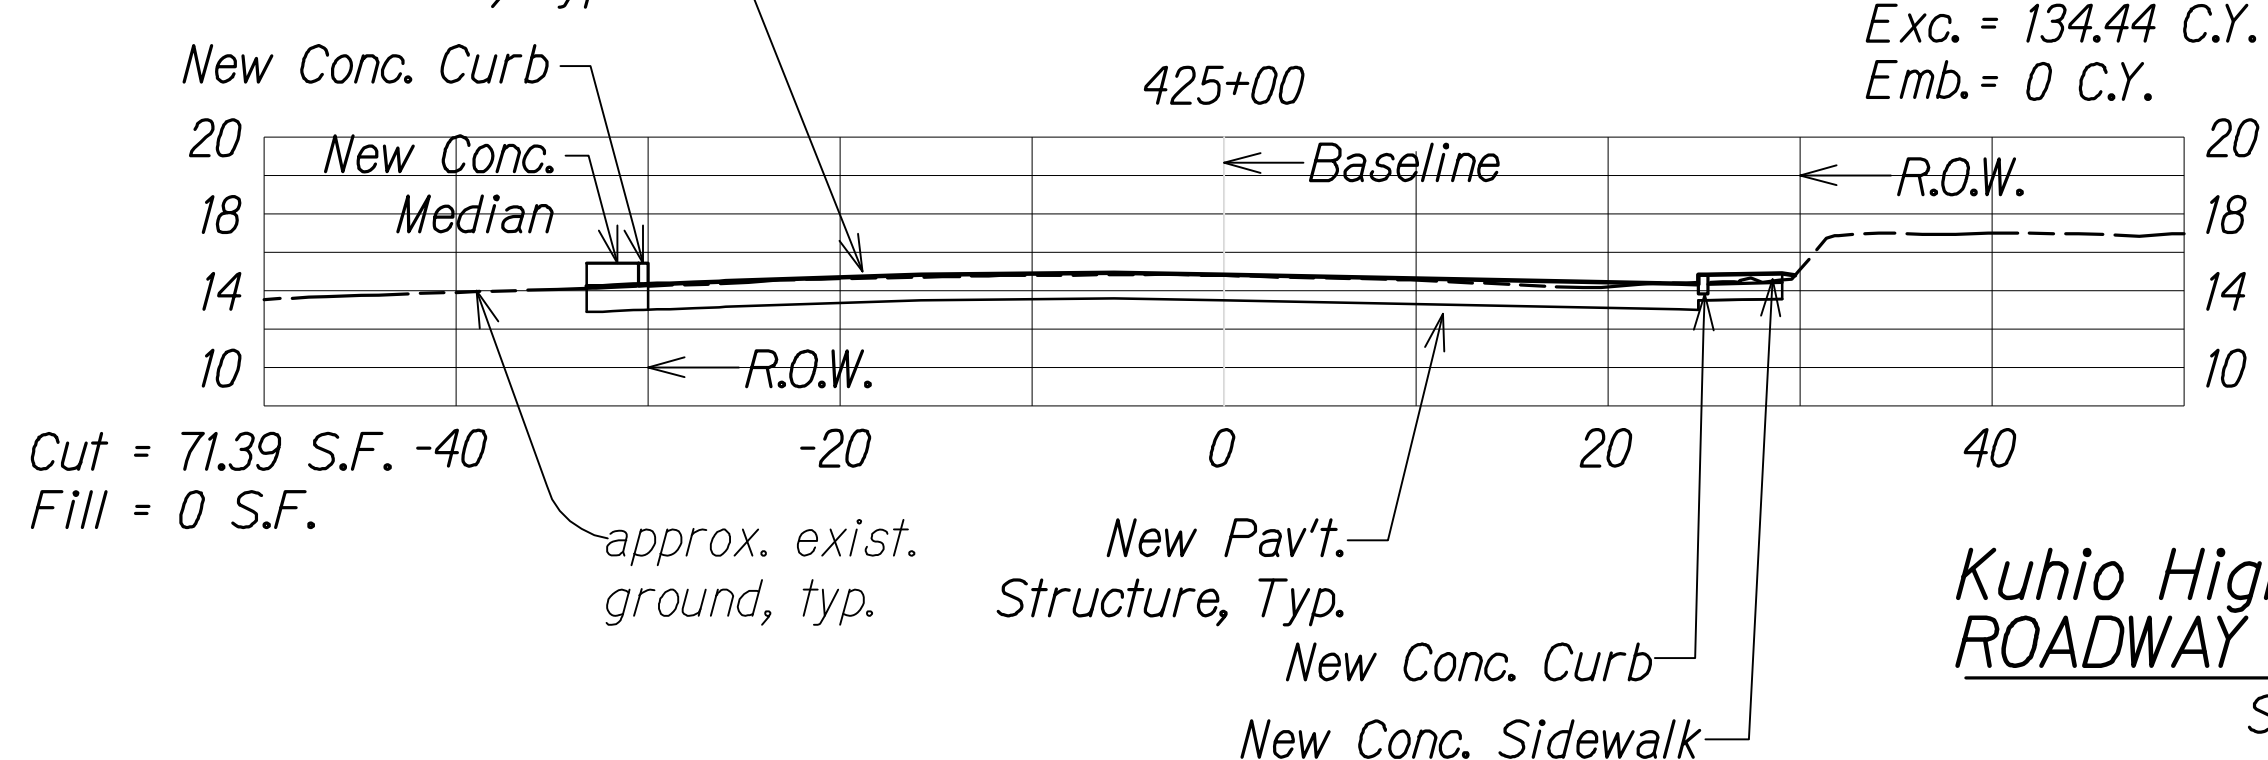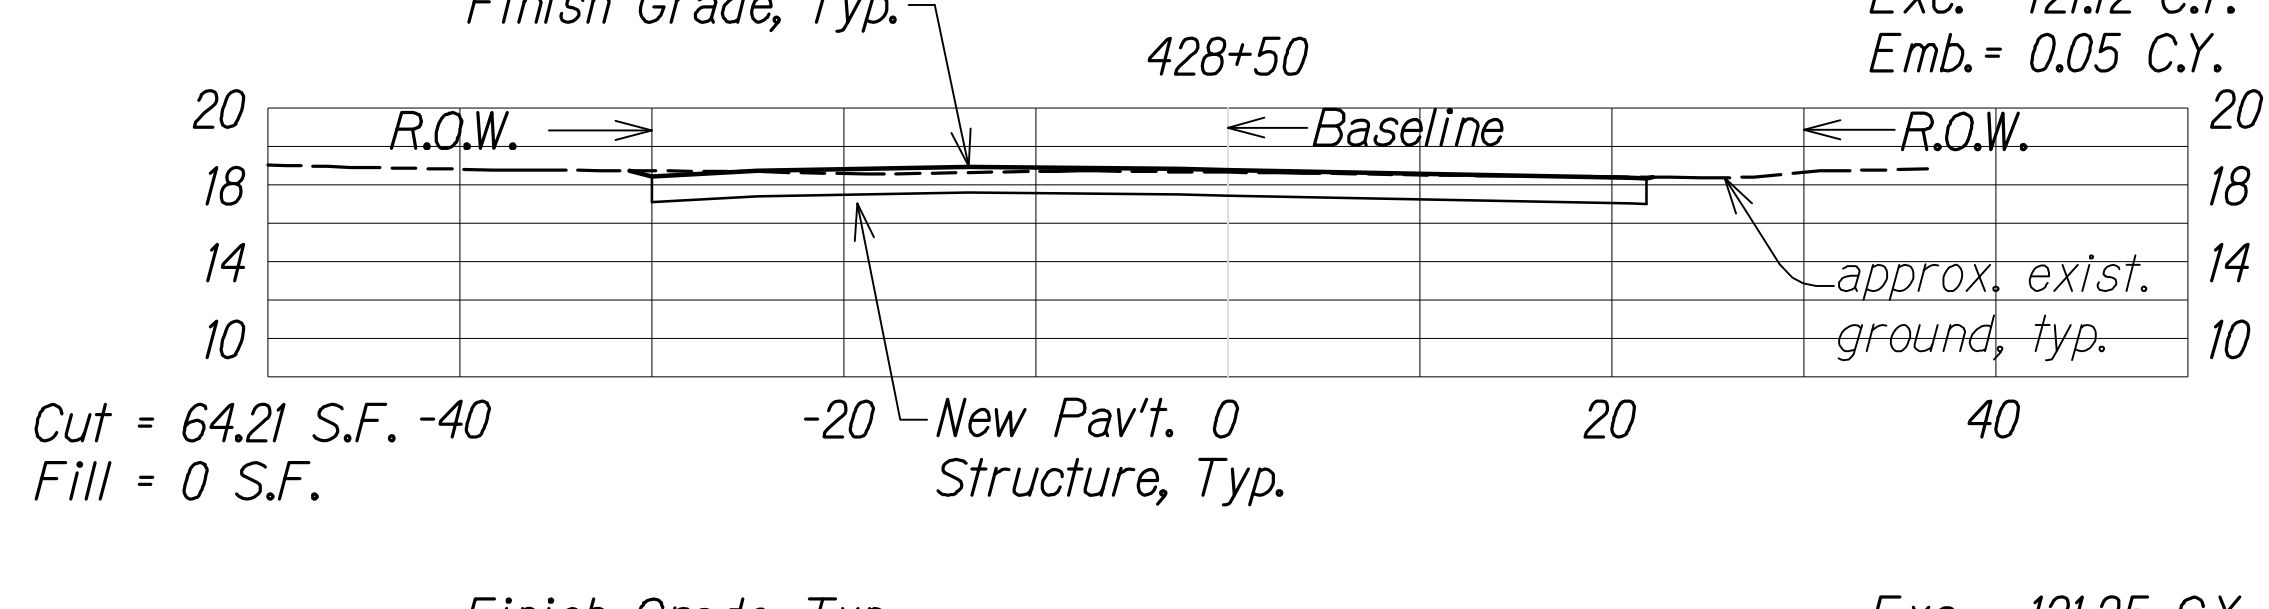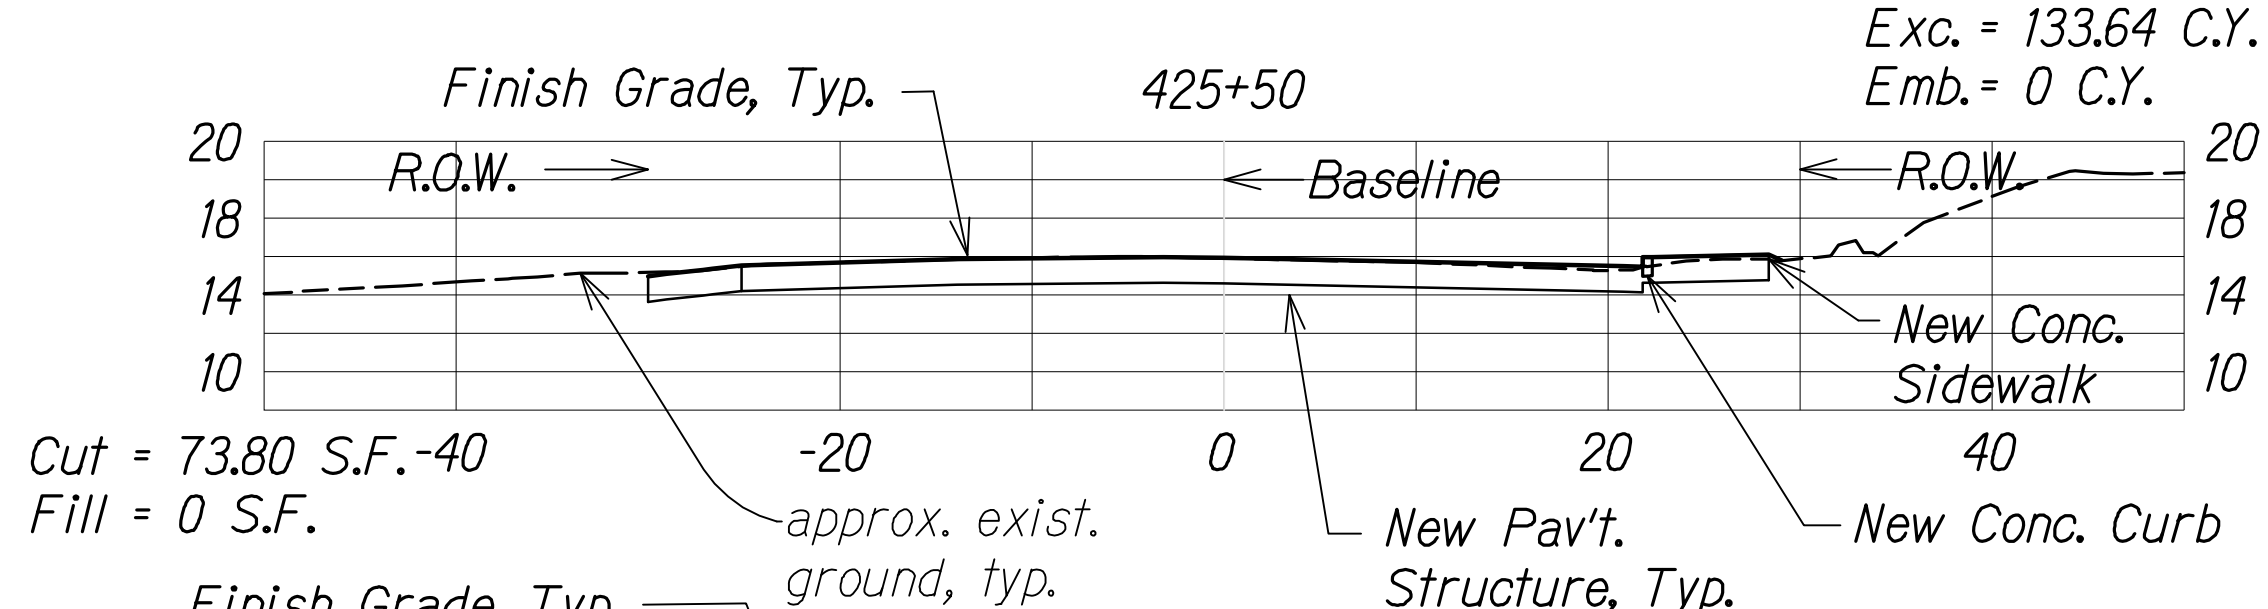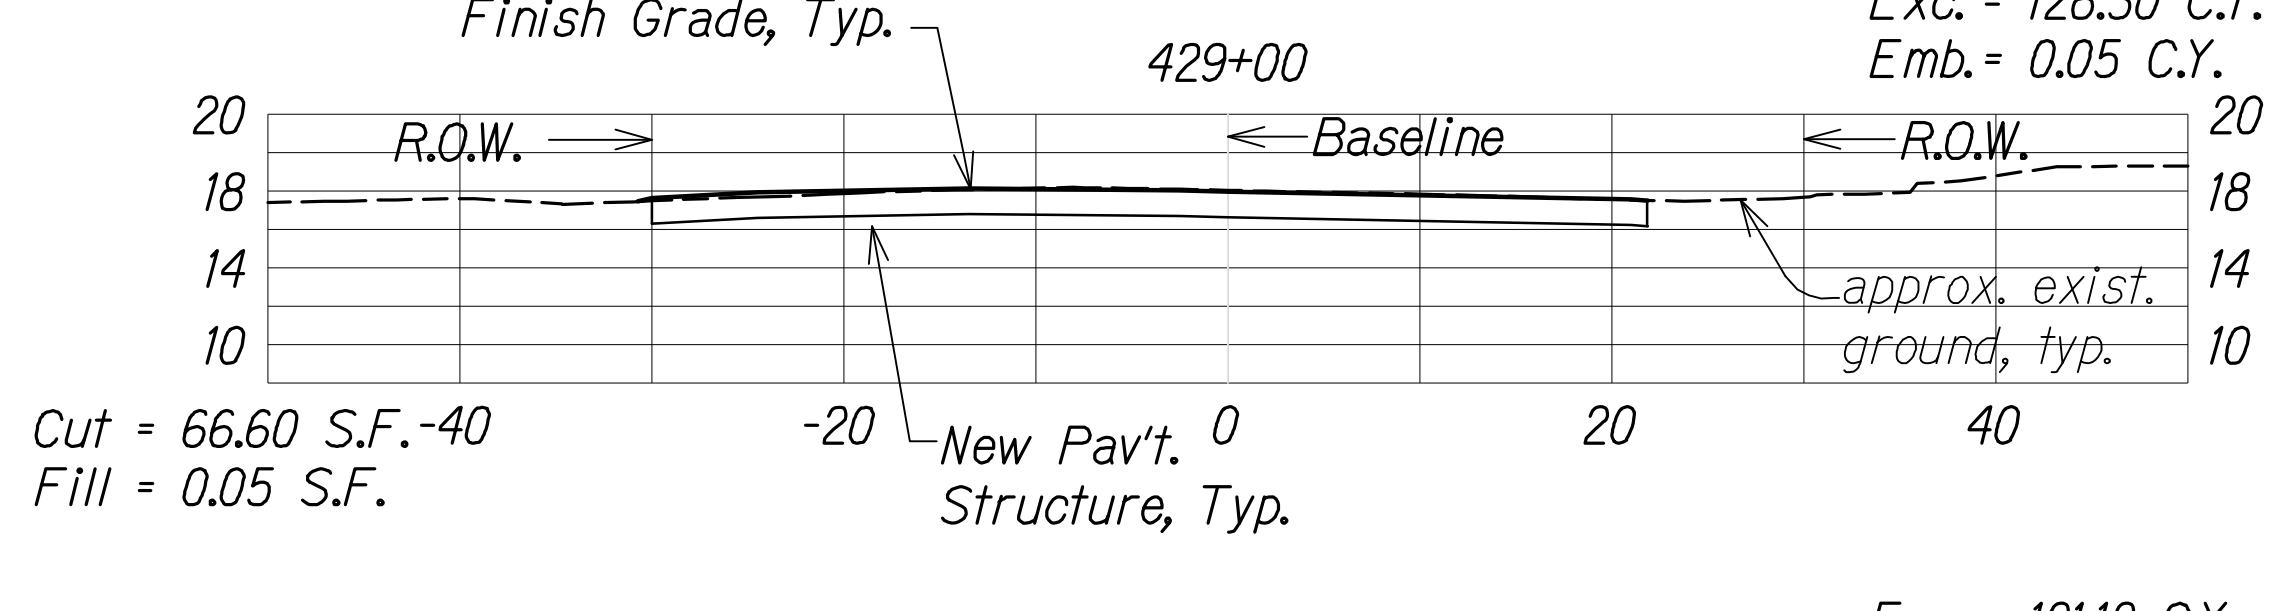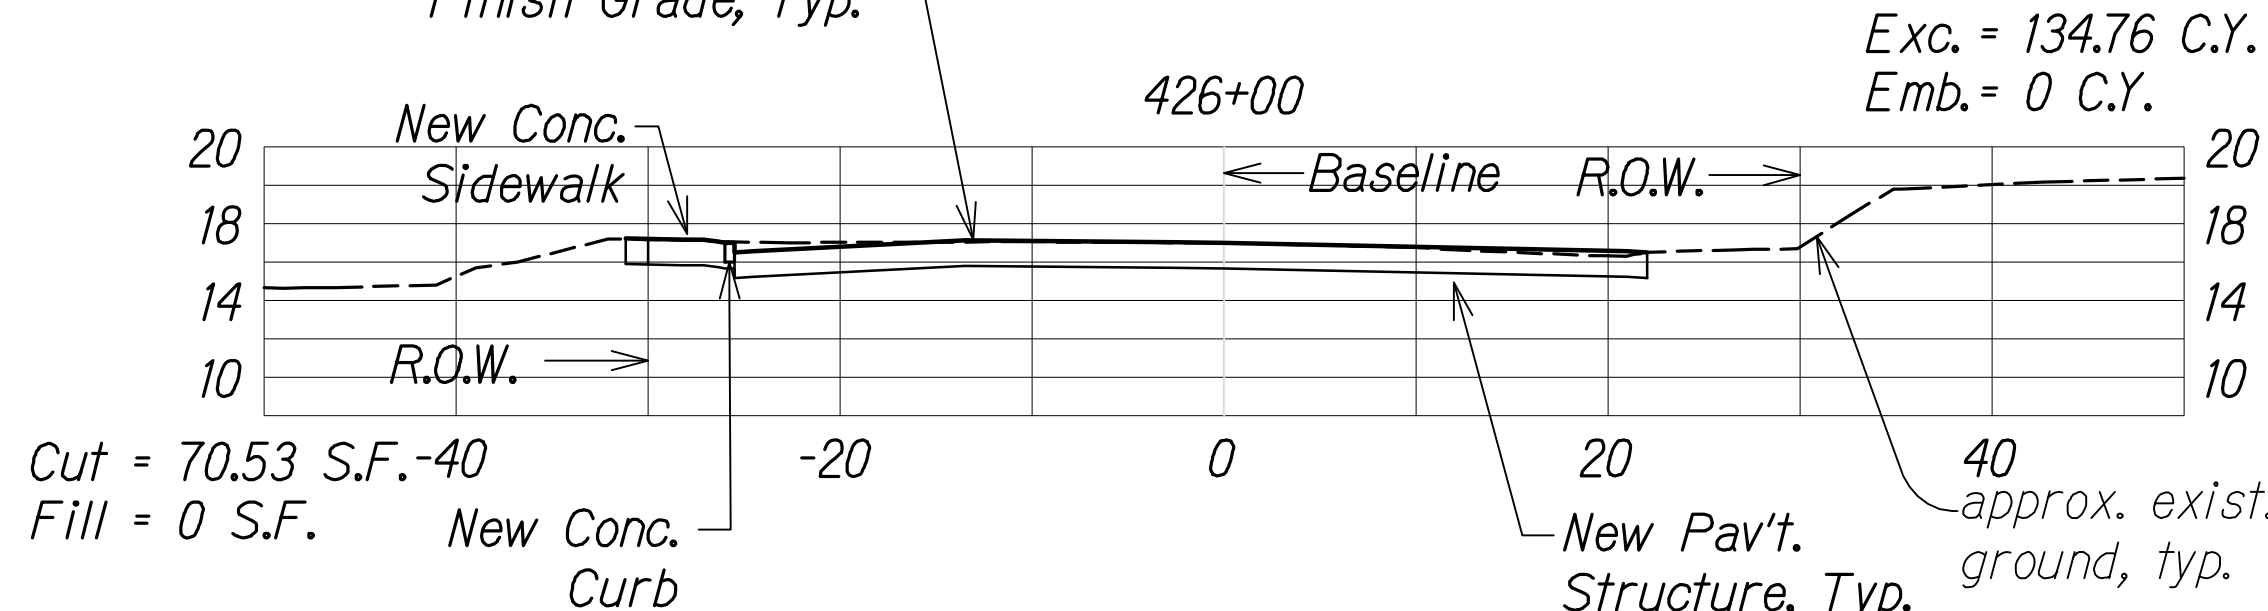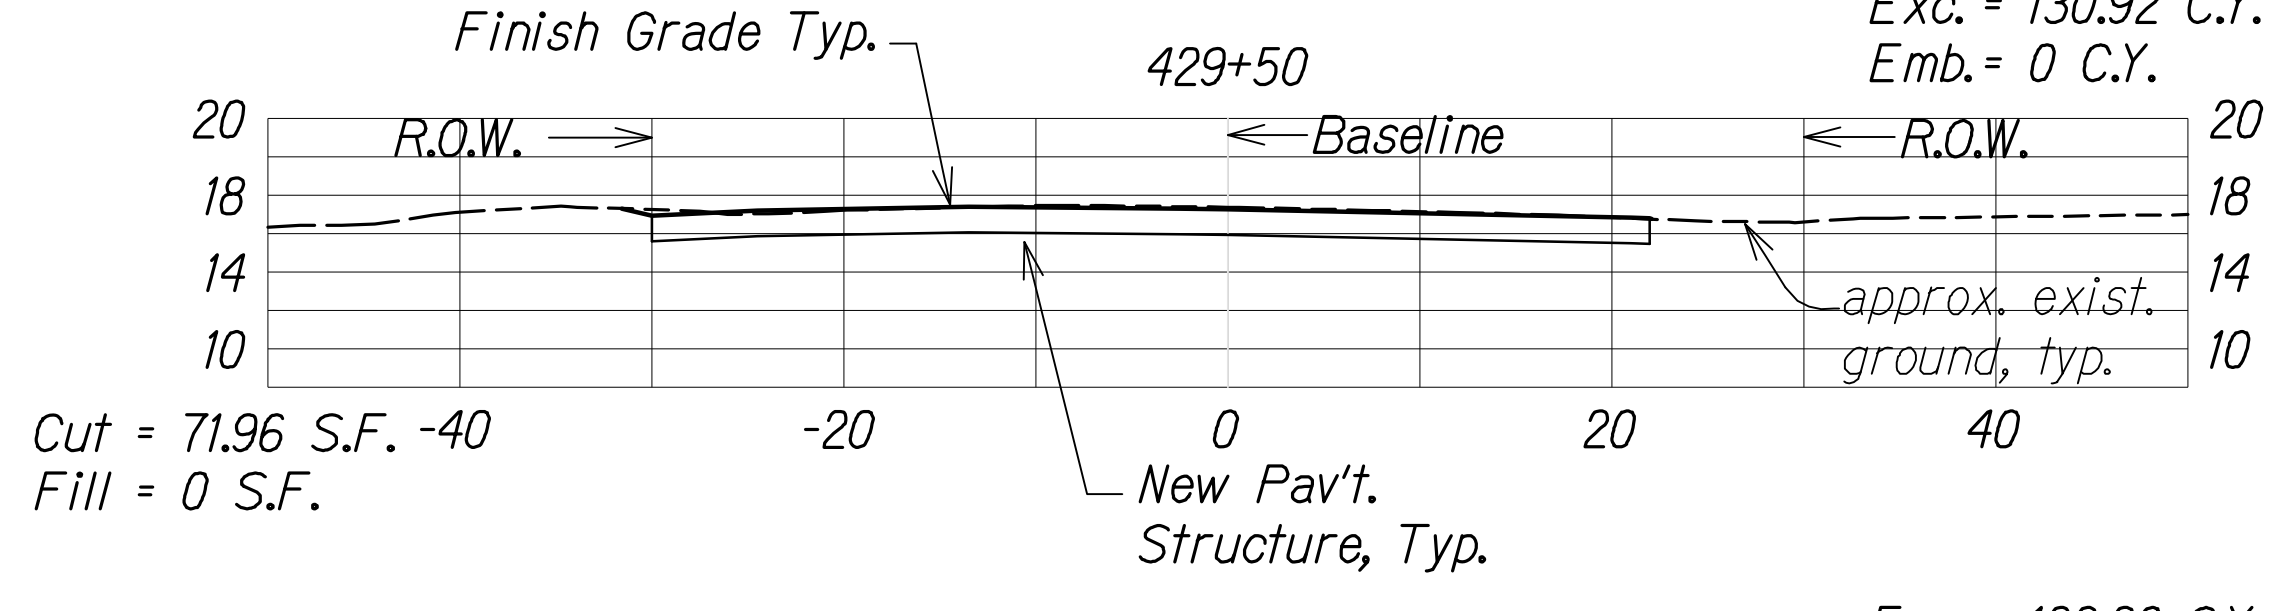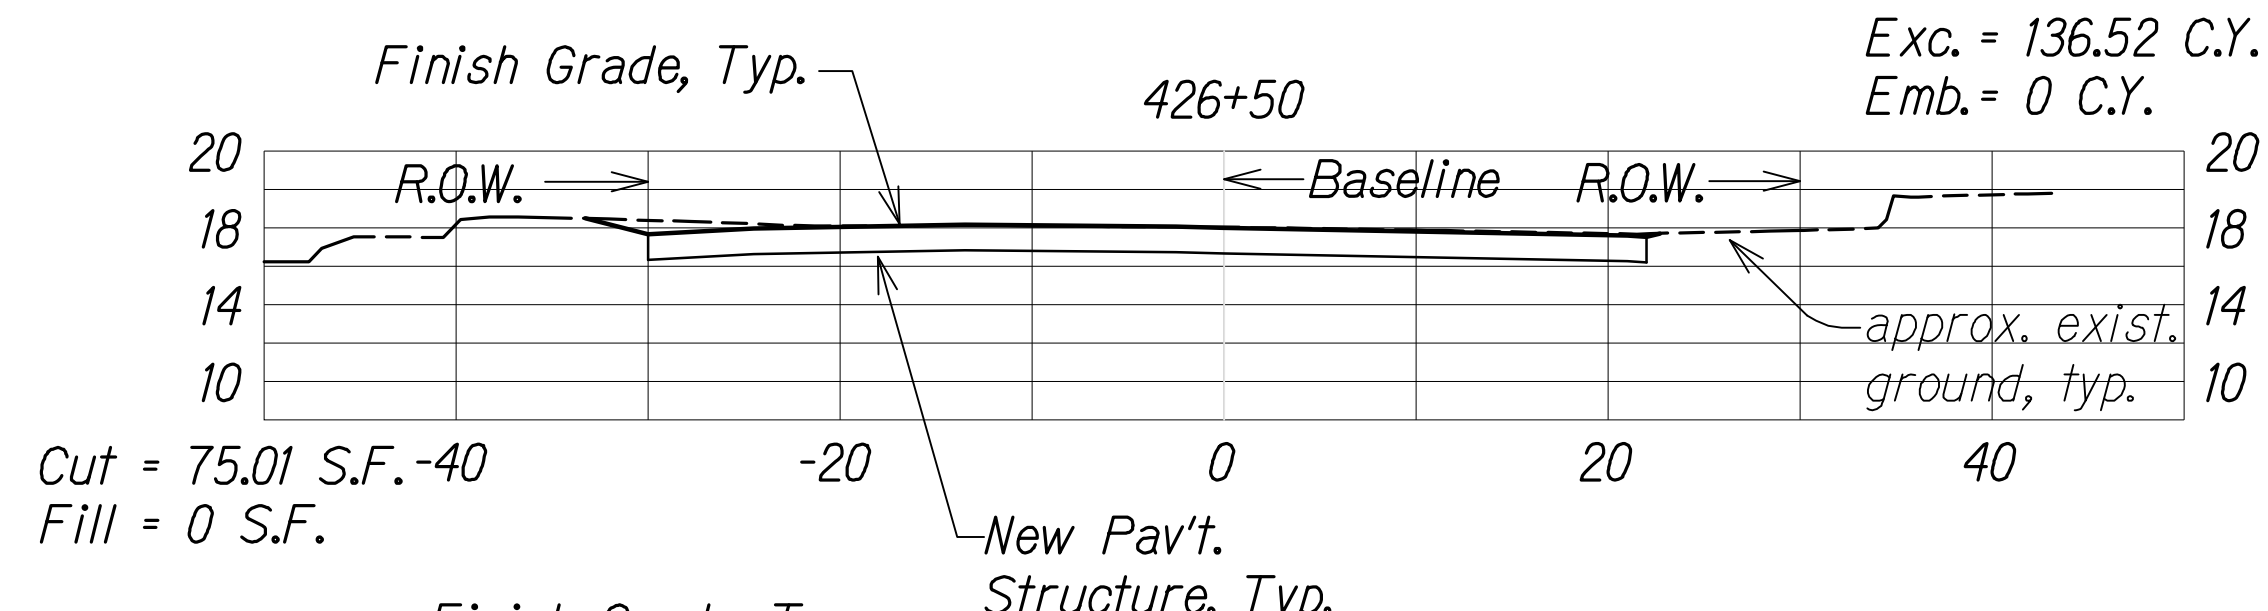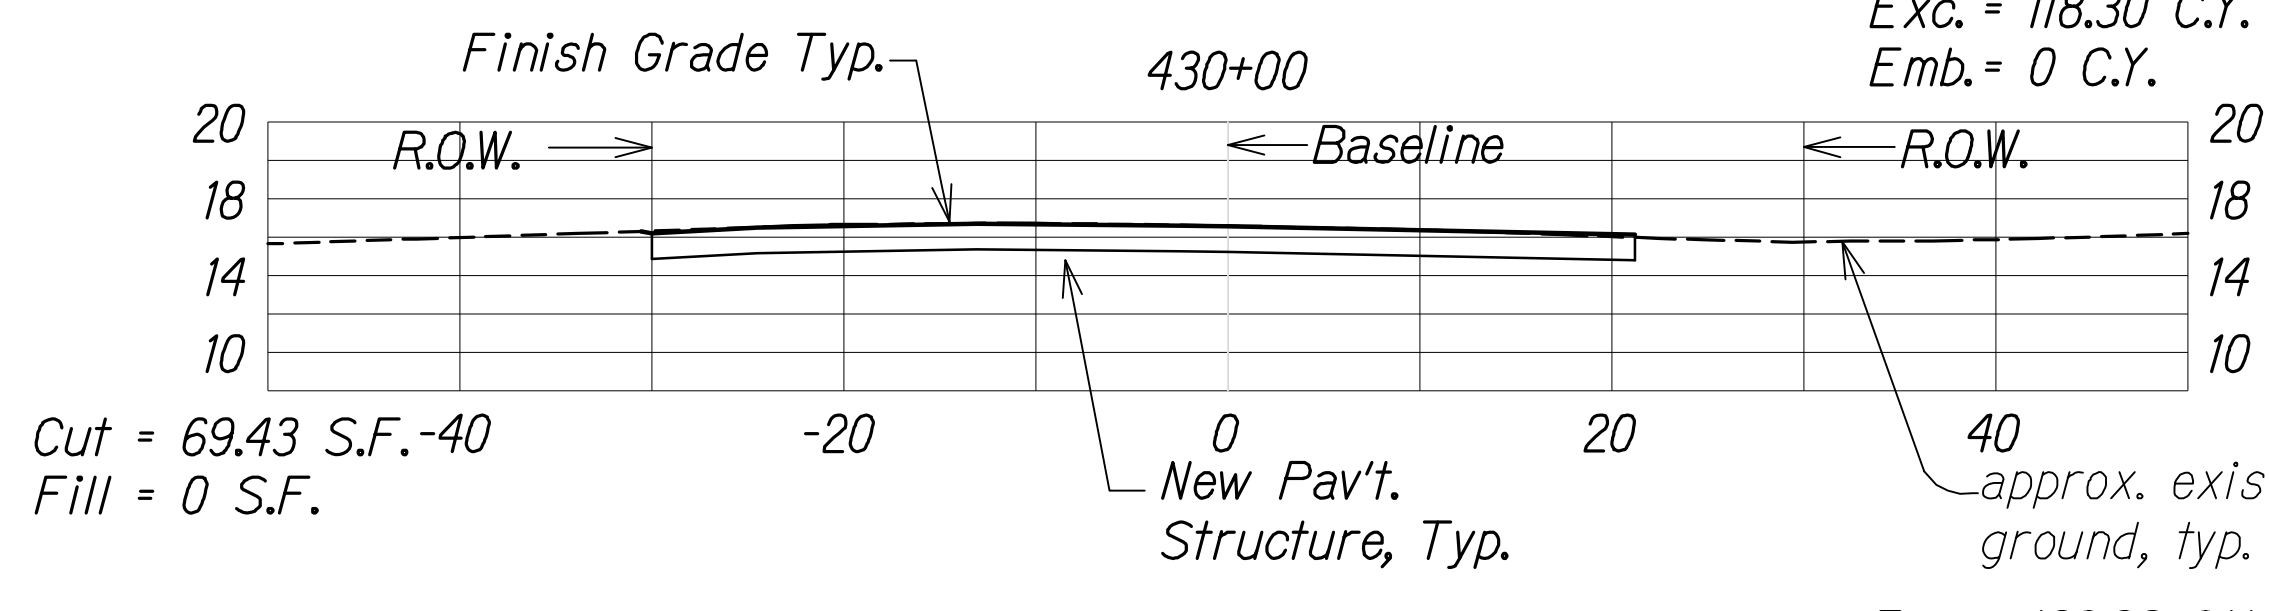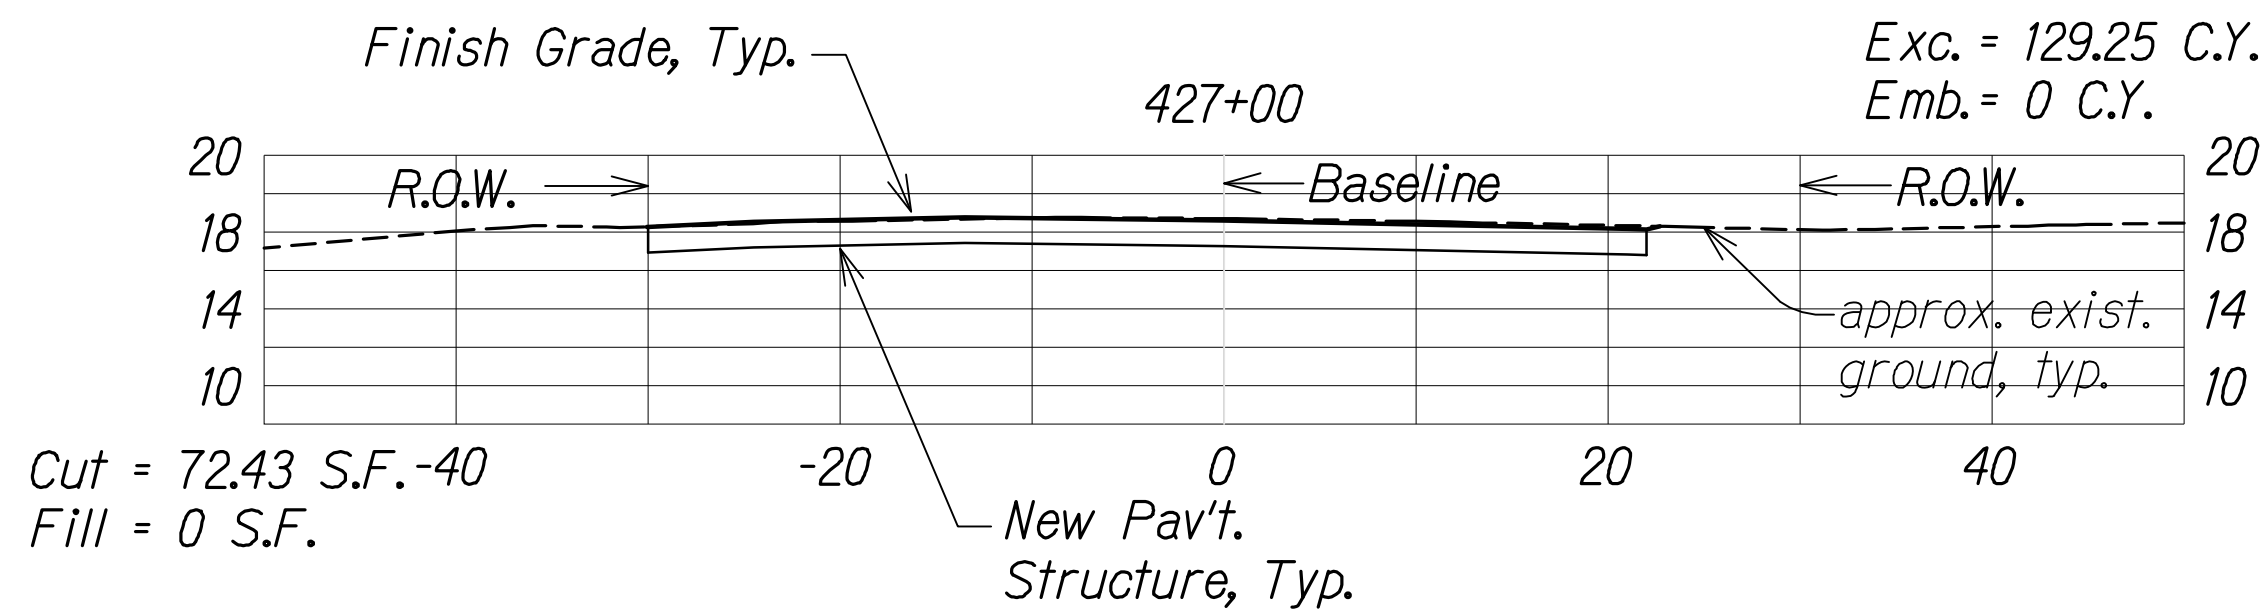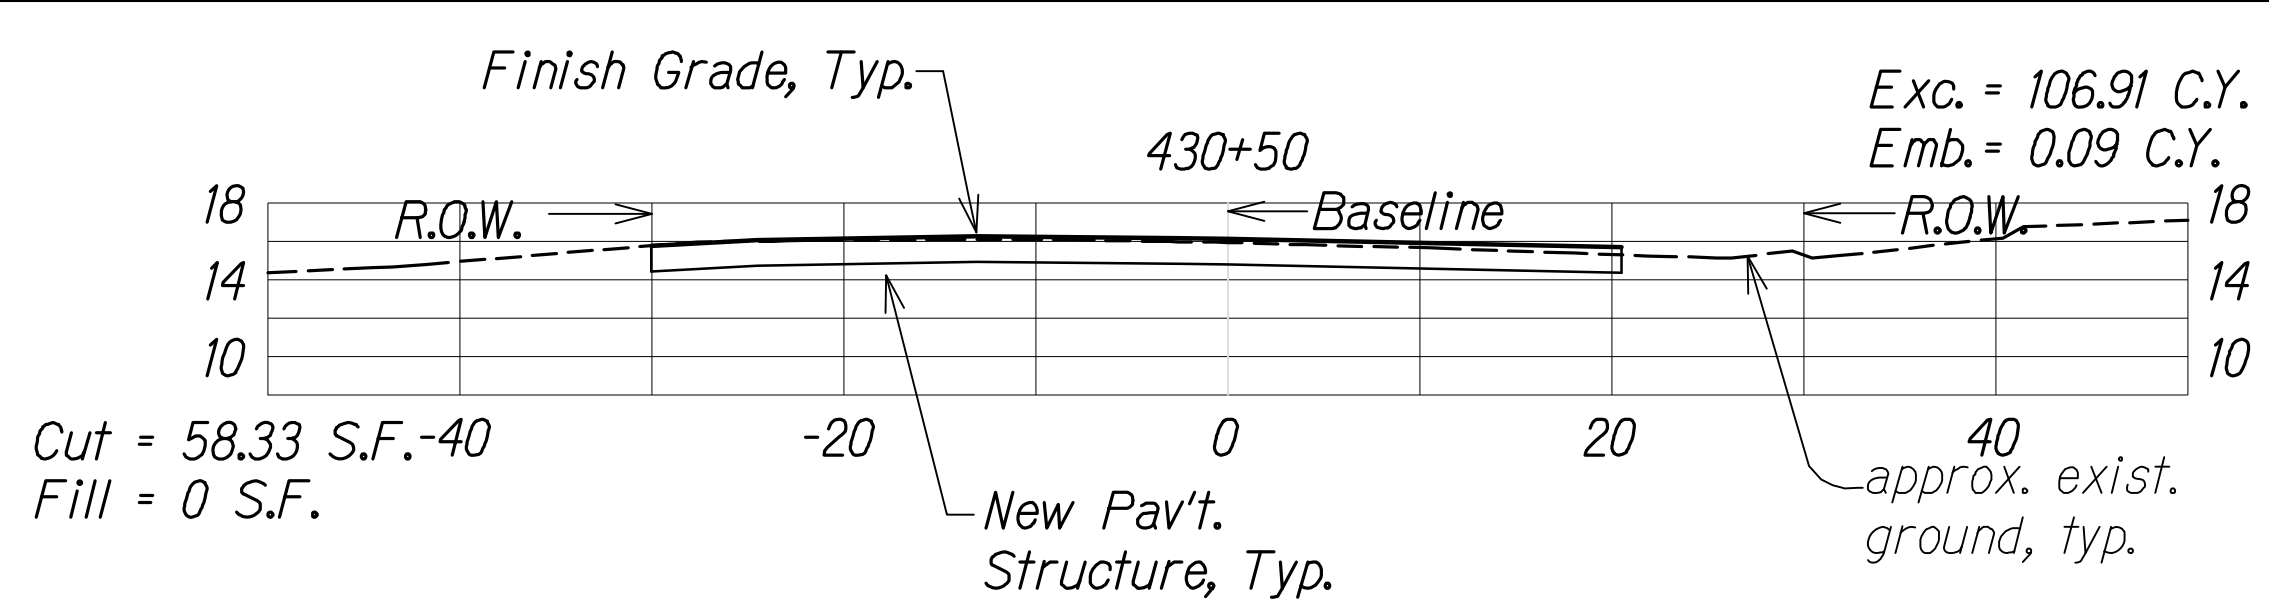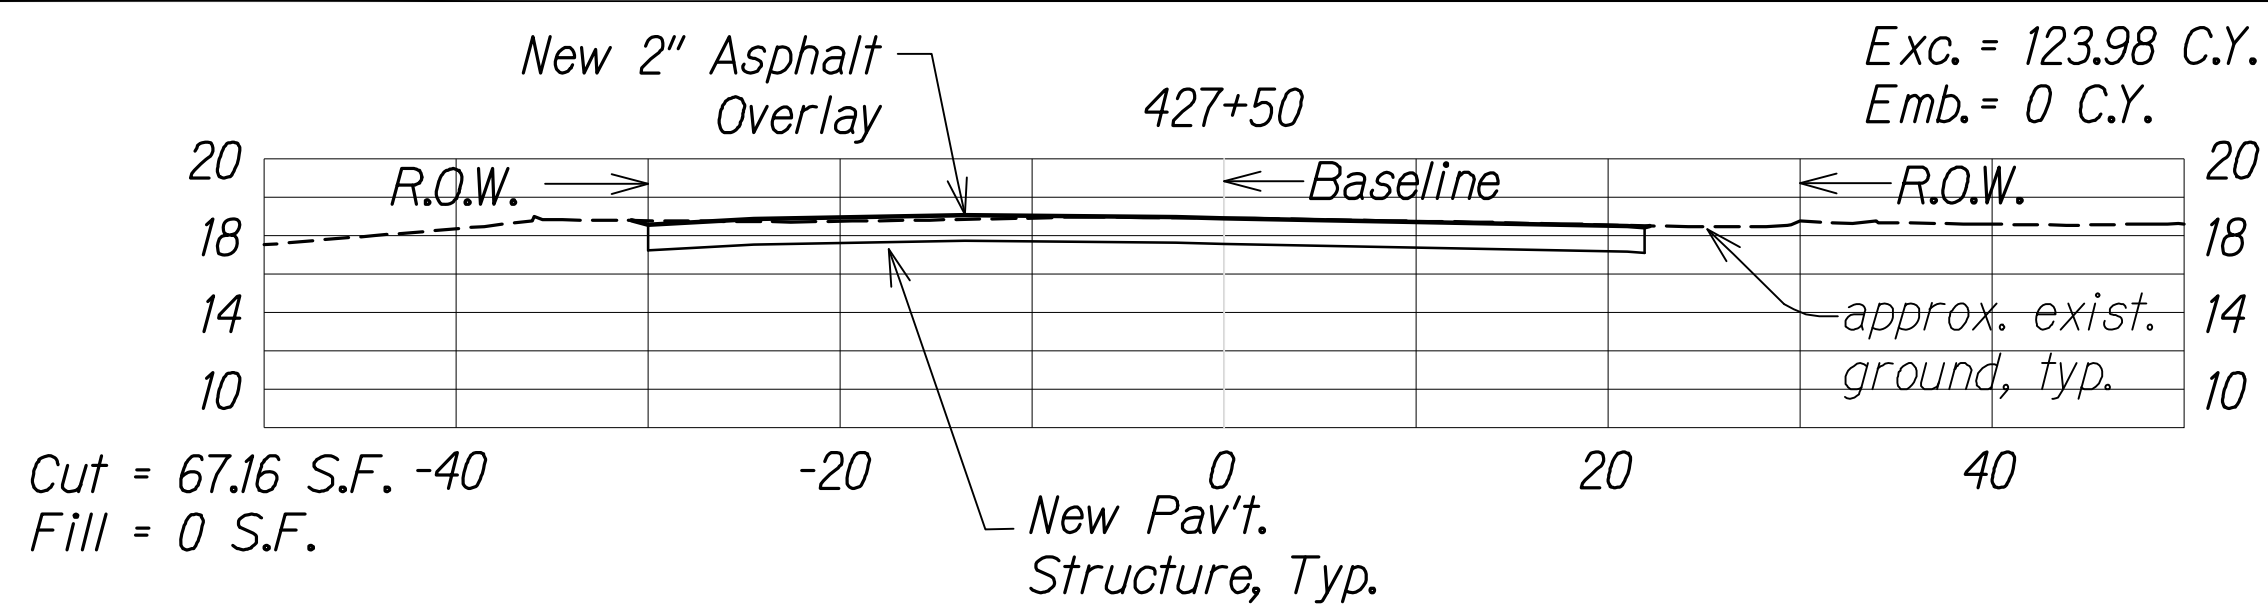

Sheet Total  
Exc. = 1519.37 C.Y.  
Emb. = 0.19 C.Y.

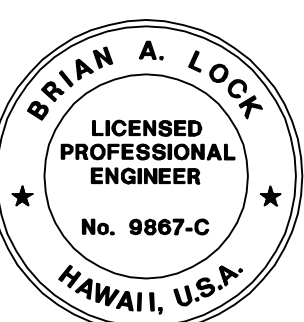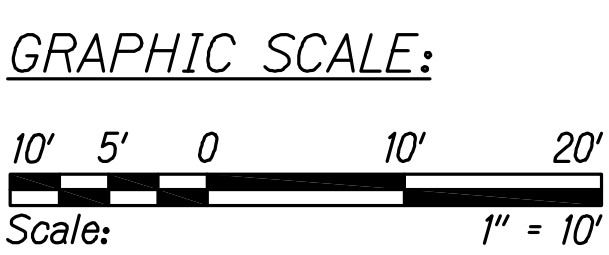

THIS WORK WAS PREPARED BY ME  
OR UNDER MY SUPERVISION.  
APRIL 30, 2020  
WILSON OKAMOTO CORPORATION LIC. EXP. DATE

STATE OF HAWAII  
DEPARTMENT OF TRANSPORTATION  
HIGHWAYS DIVISION

**ROADWAY CROSS SECTIONS**

KUHIO HIGHWAY SHORT-TERM  
IMPROVEMENTS KUAMOO ROAD  
TO TEMPORARY KAPAA BYPASS ROAD  
Fed. Aid Proj. No. NH-056-1(50)  
Scale: 1" = 10' Date: July 2019

SHEET No. XS4 OF 8 SHEETS














SURVEY PLOTTED BY	DATE
DRAWN BY	
TRACED BY	
CHECKED BY	
ORIGINAL PLAN	
NOTE BOOK	
No.	

Kuhio Highway Improvements  
ROADWAY CROSS SECTIONS  
Scale: 1" = 10'

DATE	REVISION
11/12/19	△ Reissuing plan for legibility only. No design changes have been made.
9/20/19	△ Reissuing plan for legibility only. No design changes have been made.

FED. ROAD DIST. NO.	STATE	FED. AID PROJ. NO.	FISCAL YEAR	SHEET NO.	TOTAL SHEETS
KAUAI	HAW.	NH-056-1(50)	2019	ADD.183	244

Sheet Total  
Exc. = 1269.76 C.Y.  
Emb. = 29.90 C.Y.

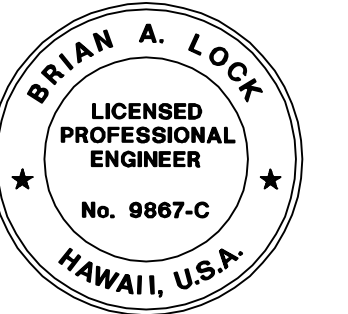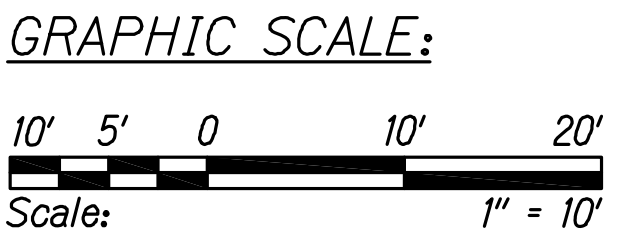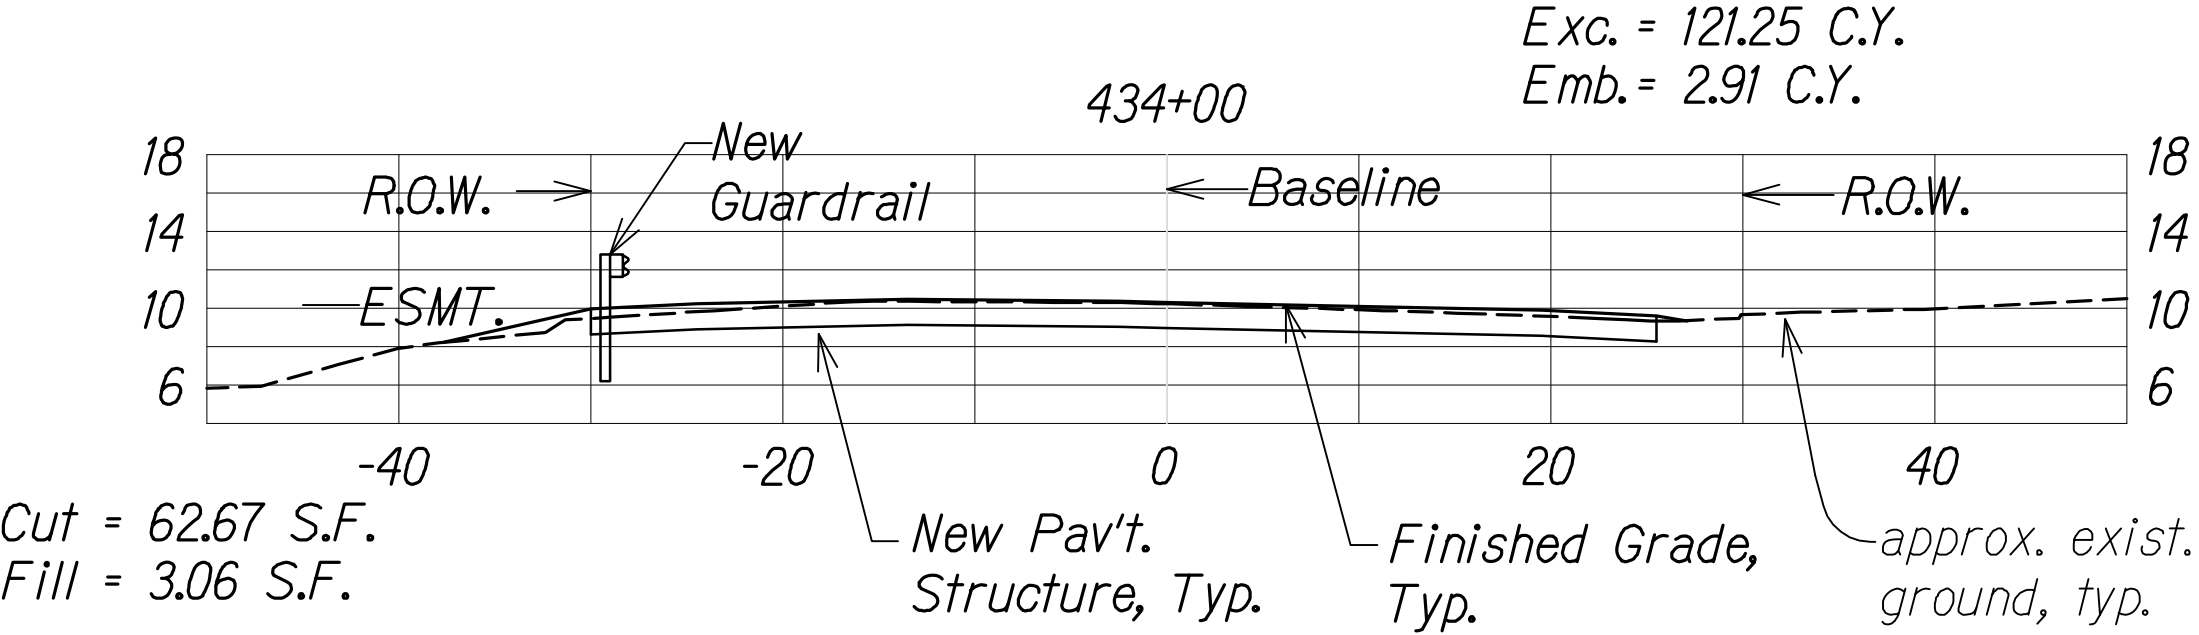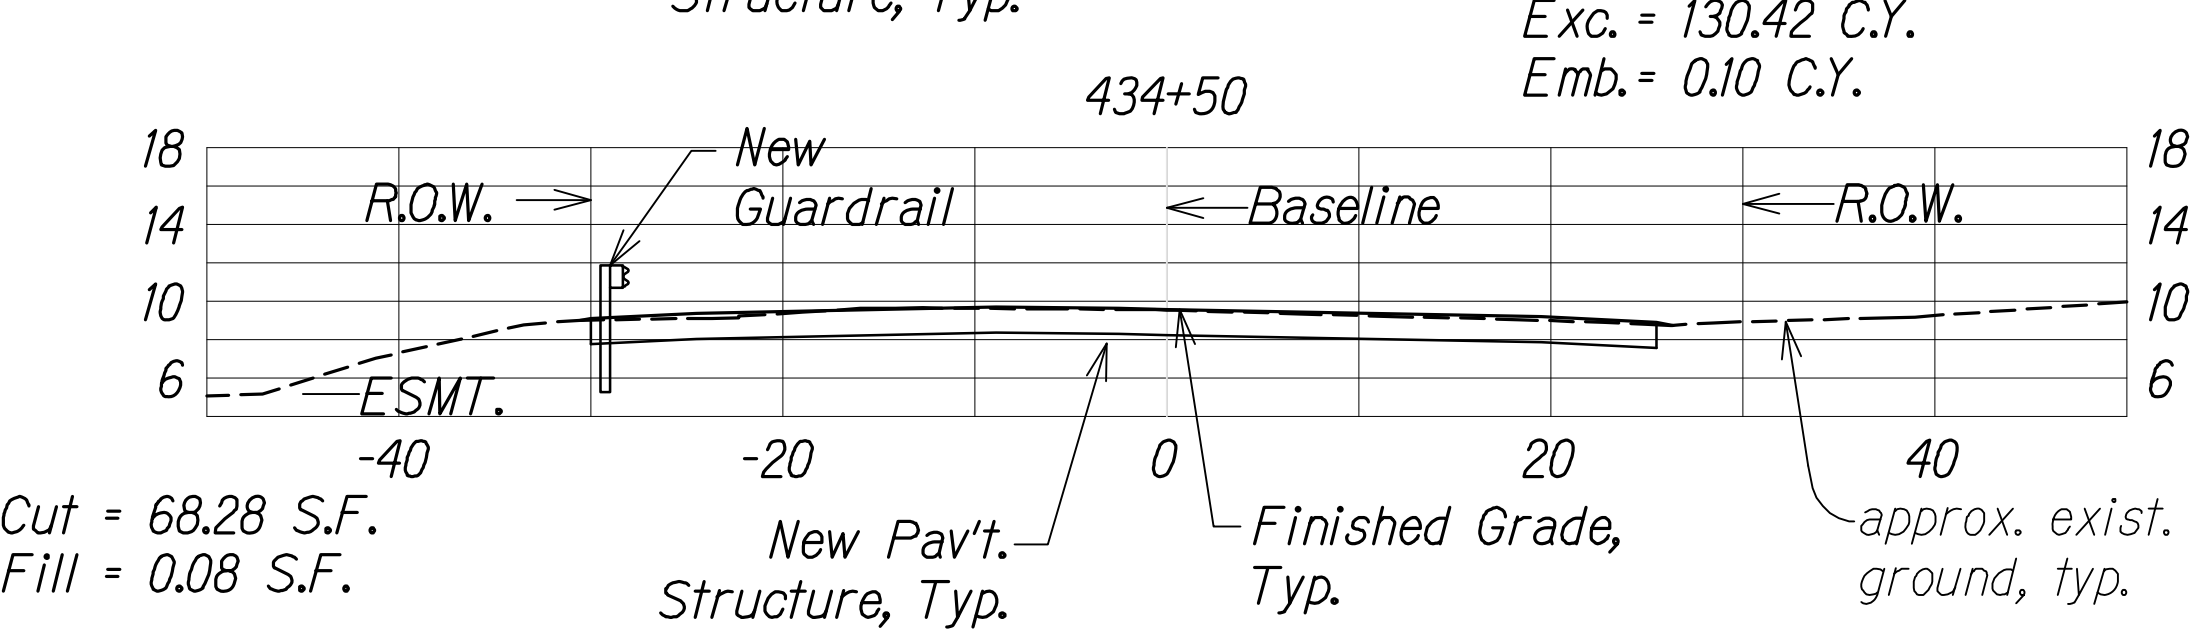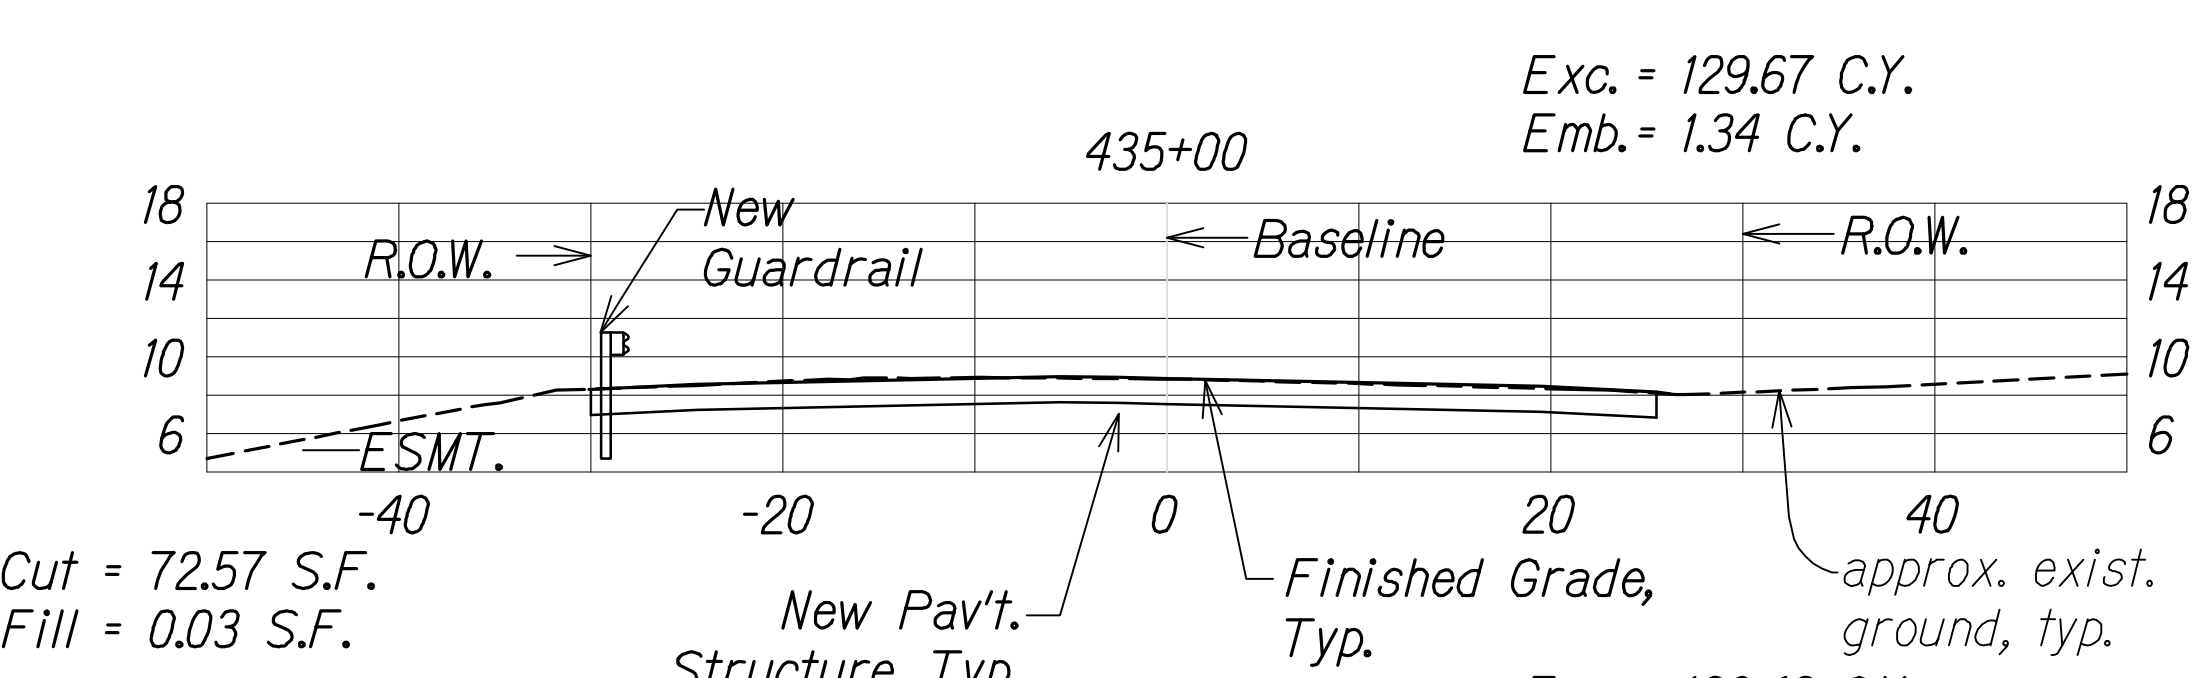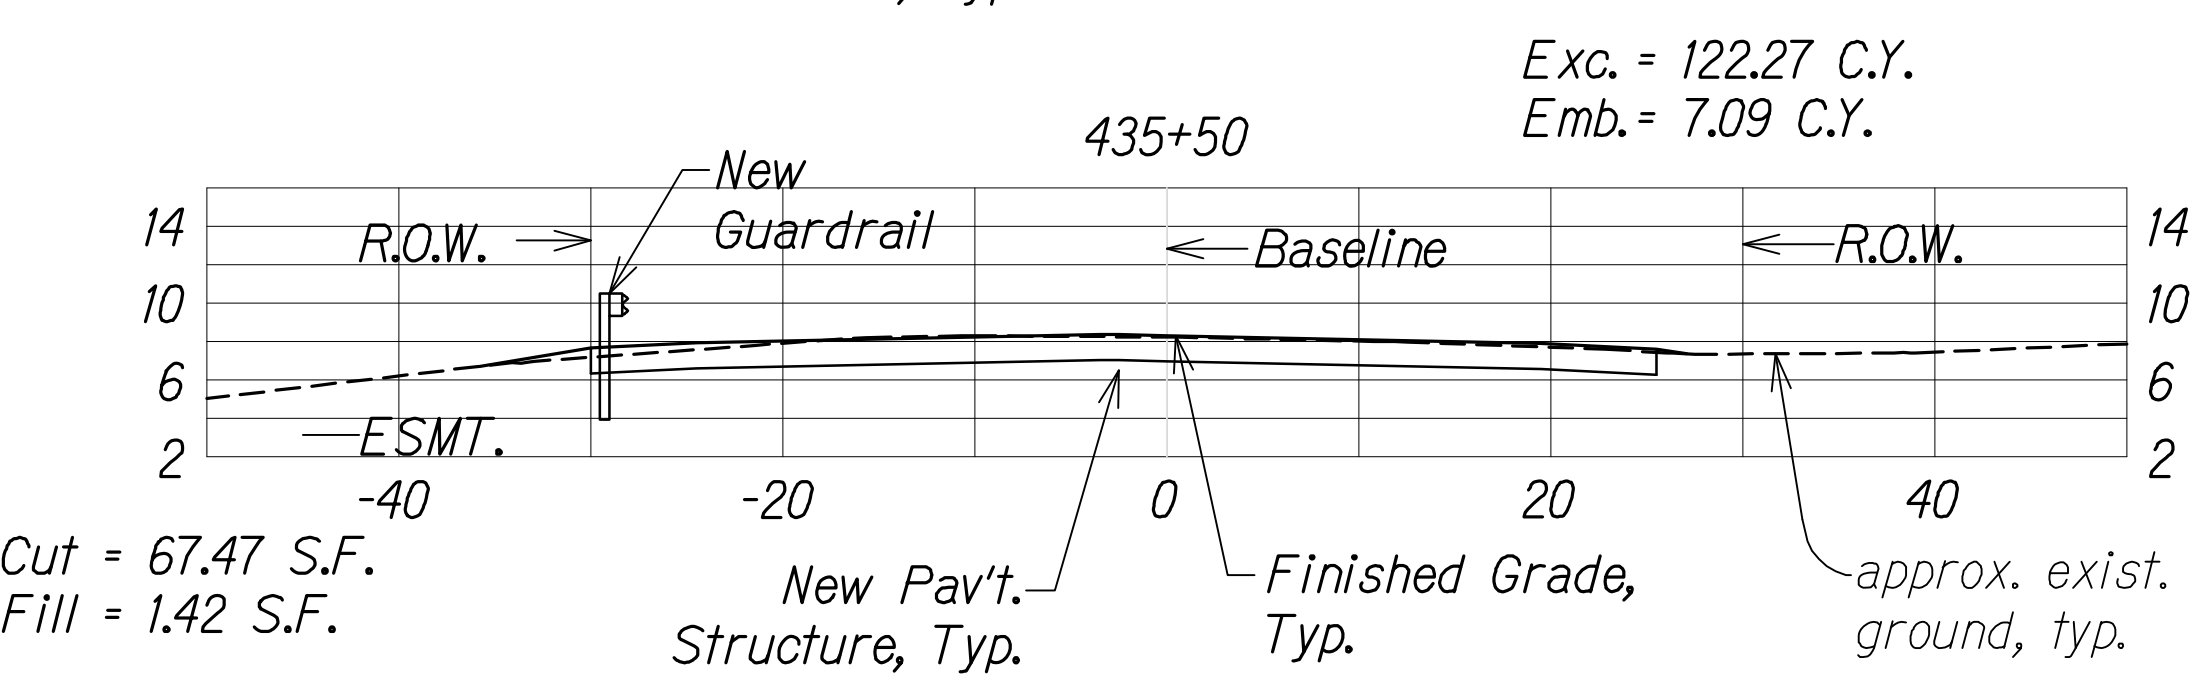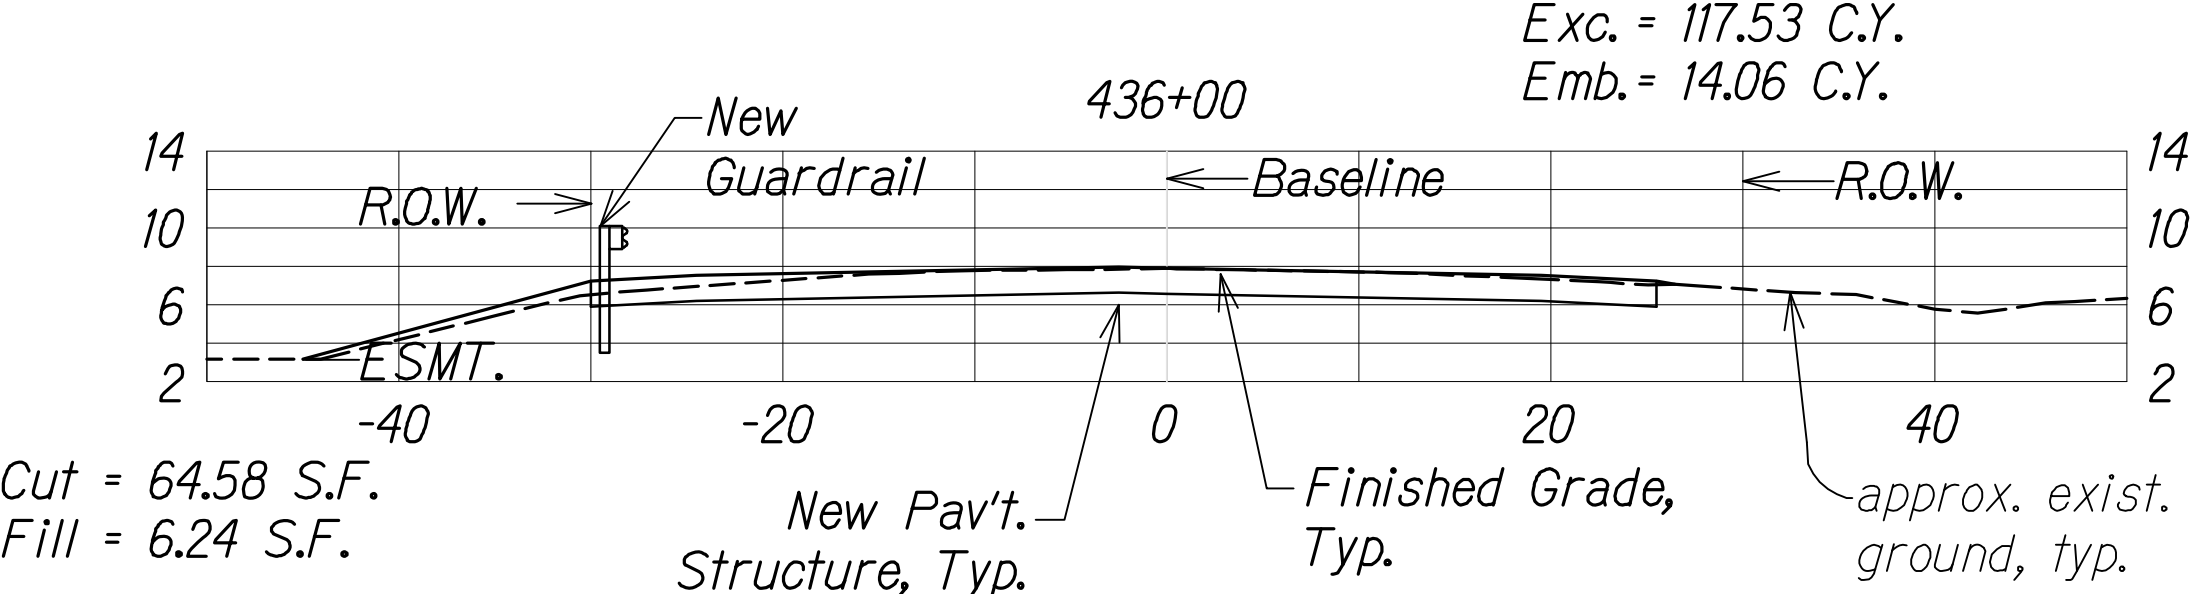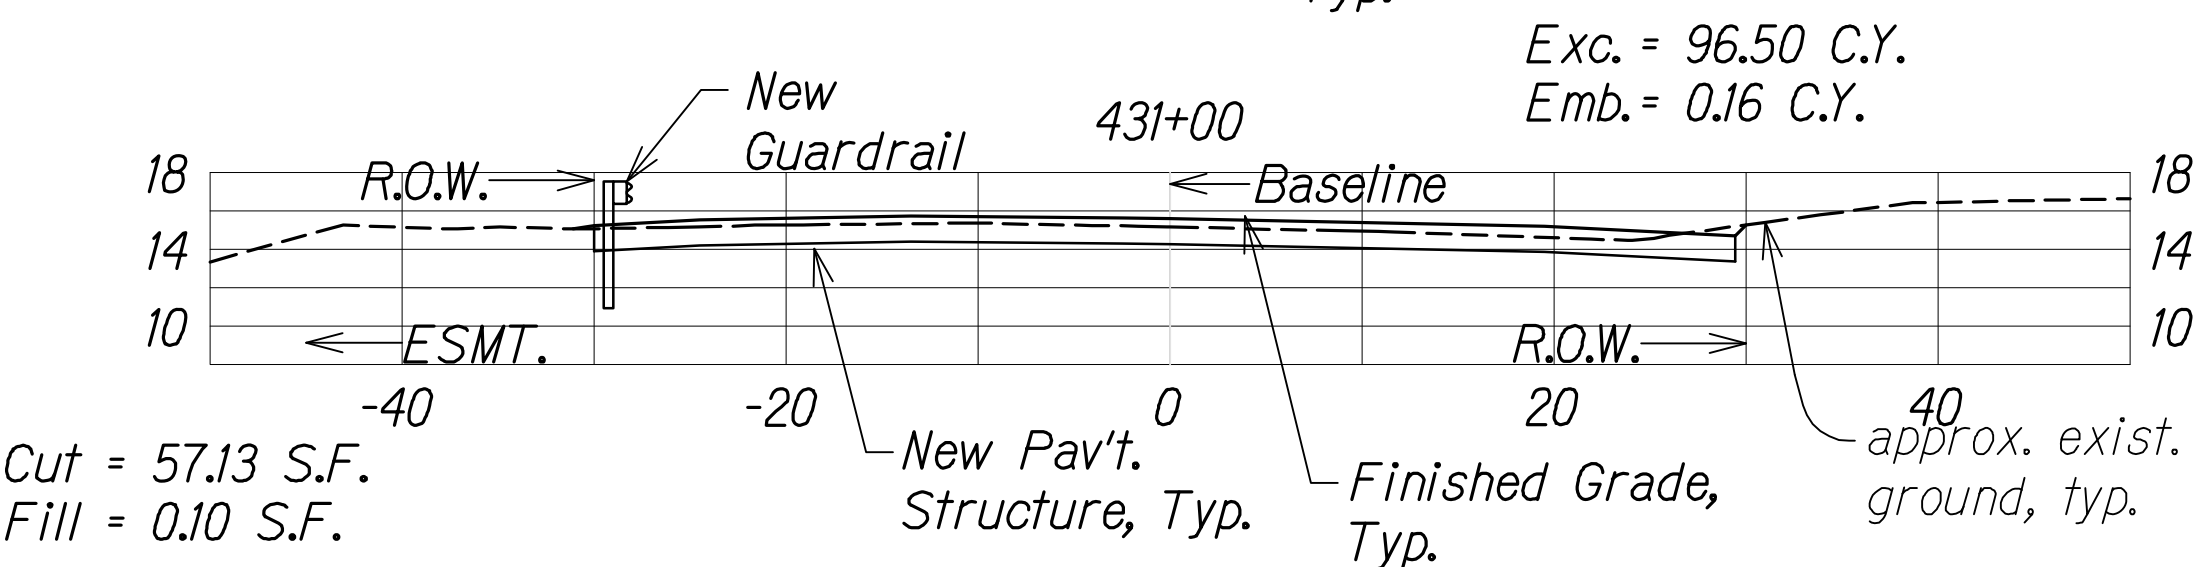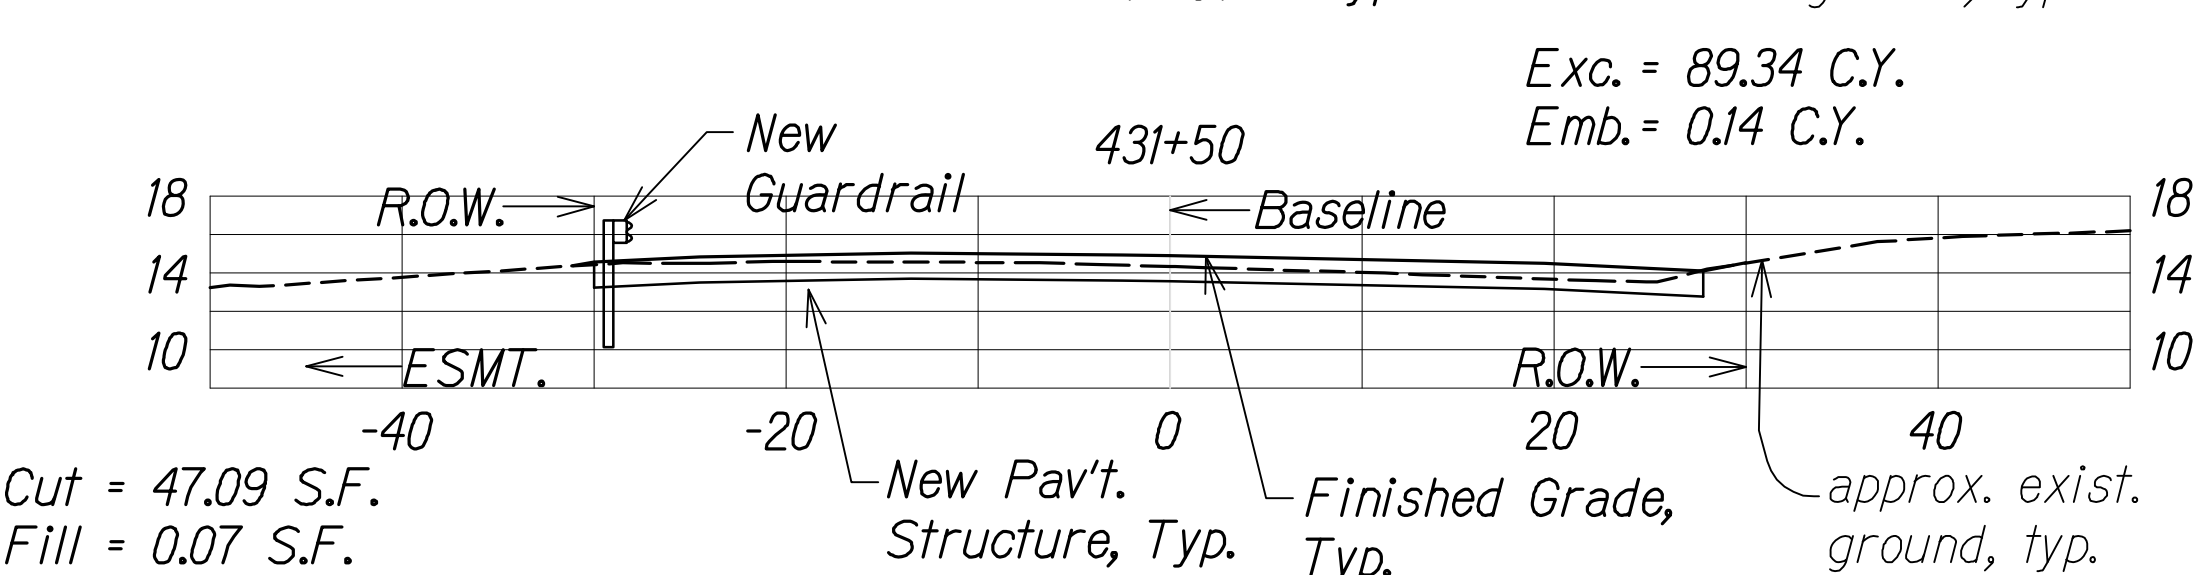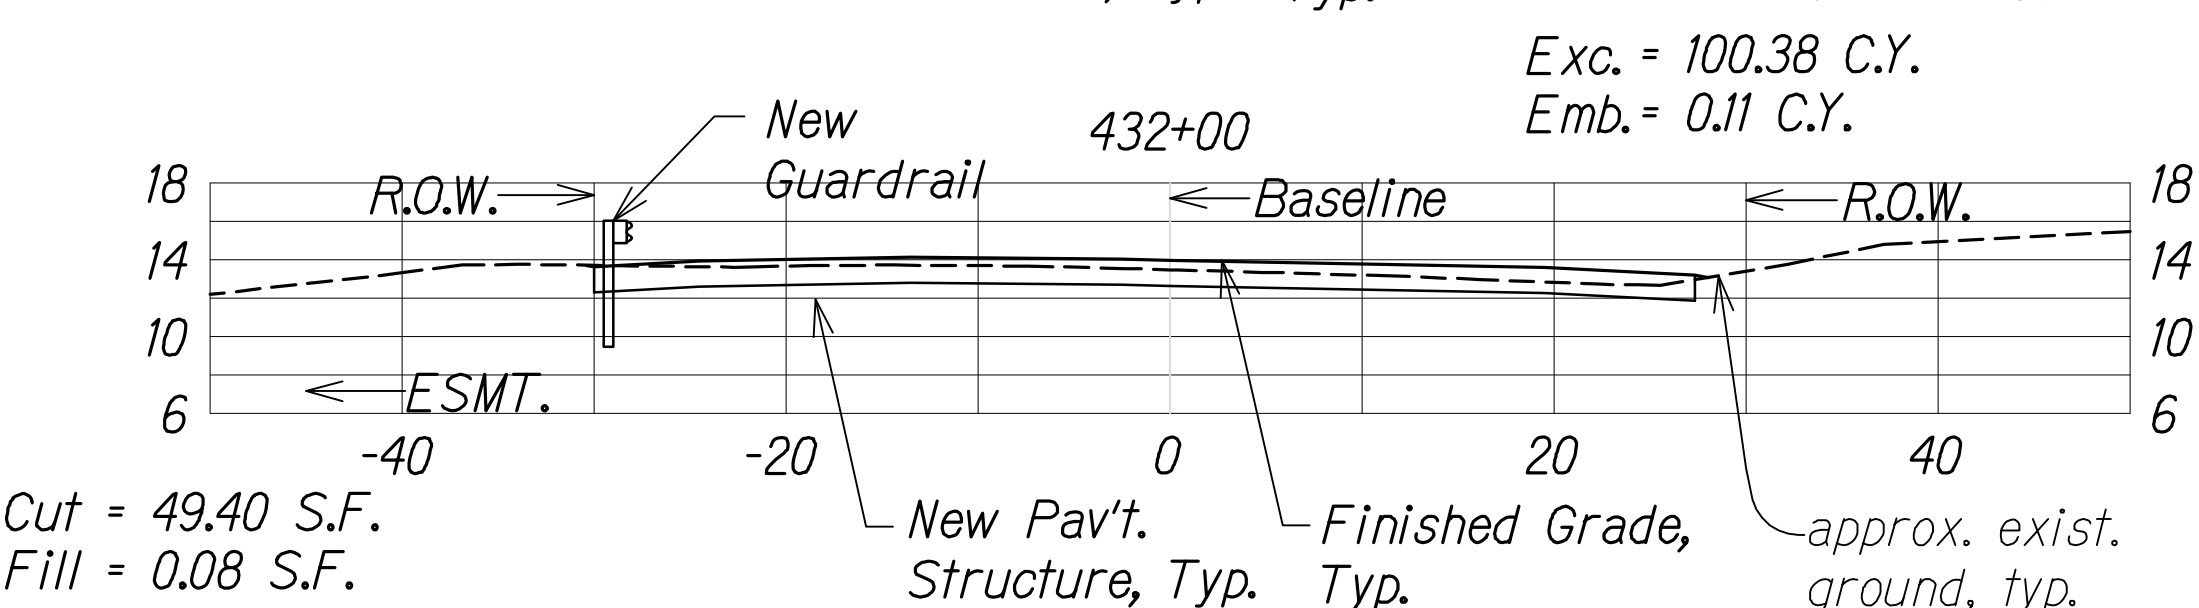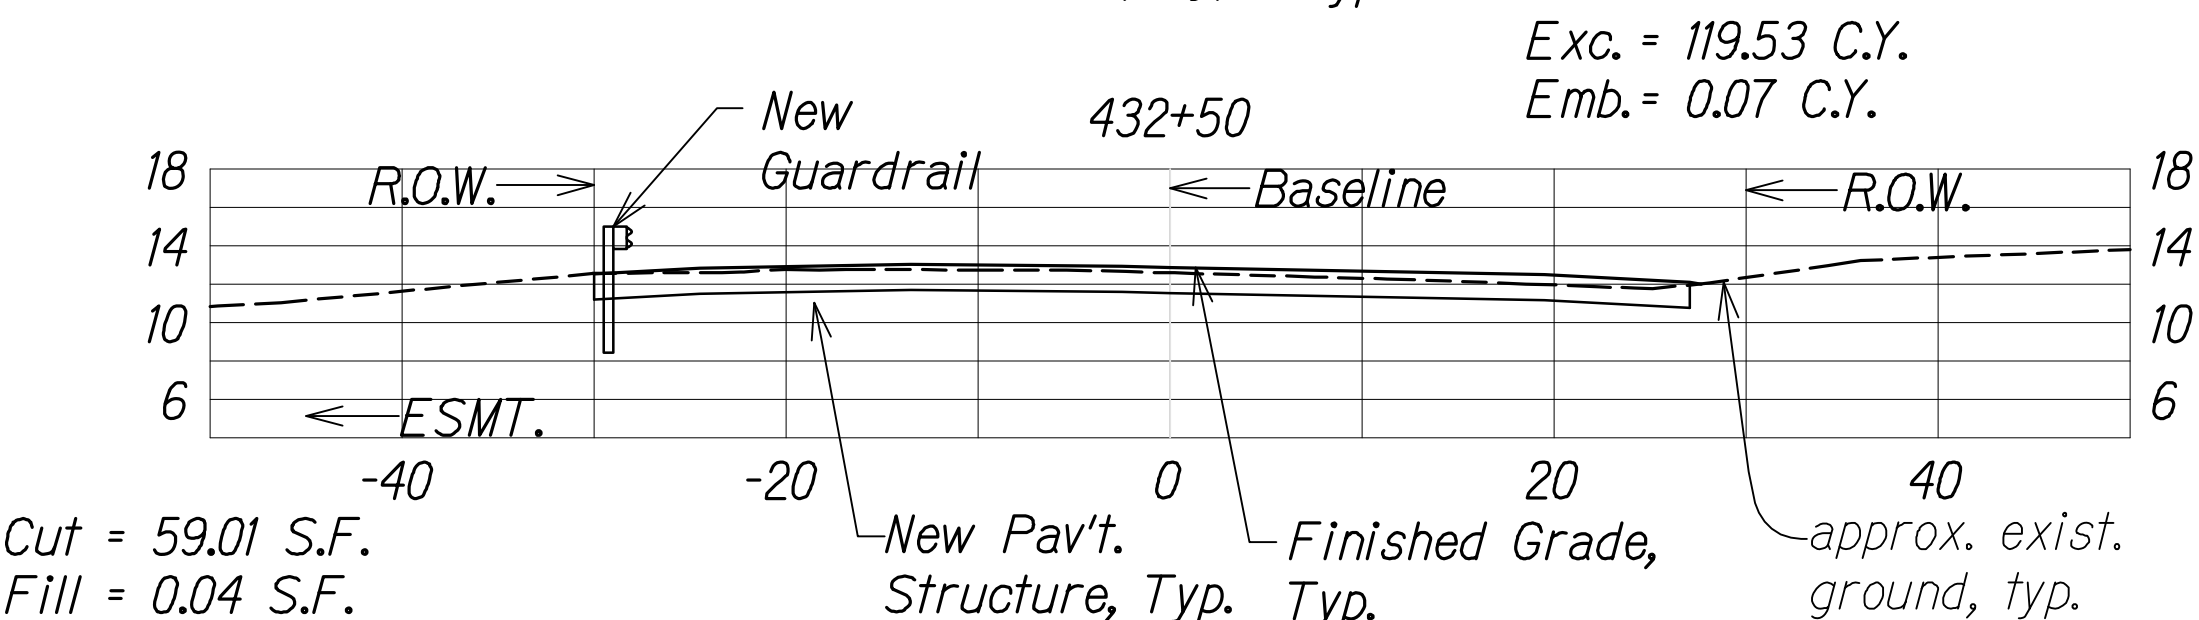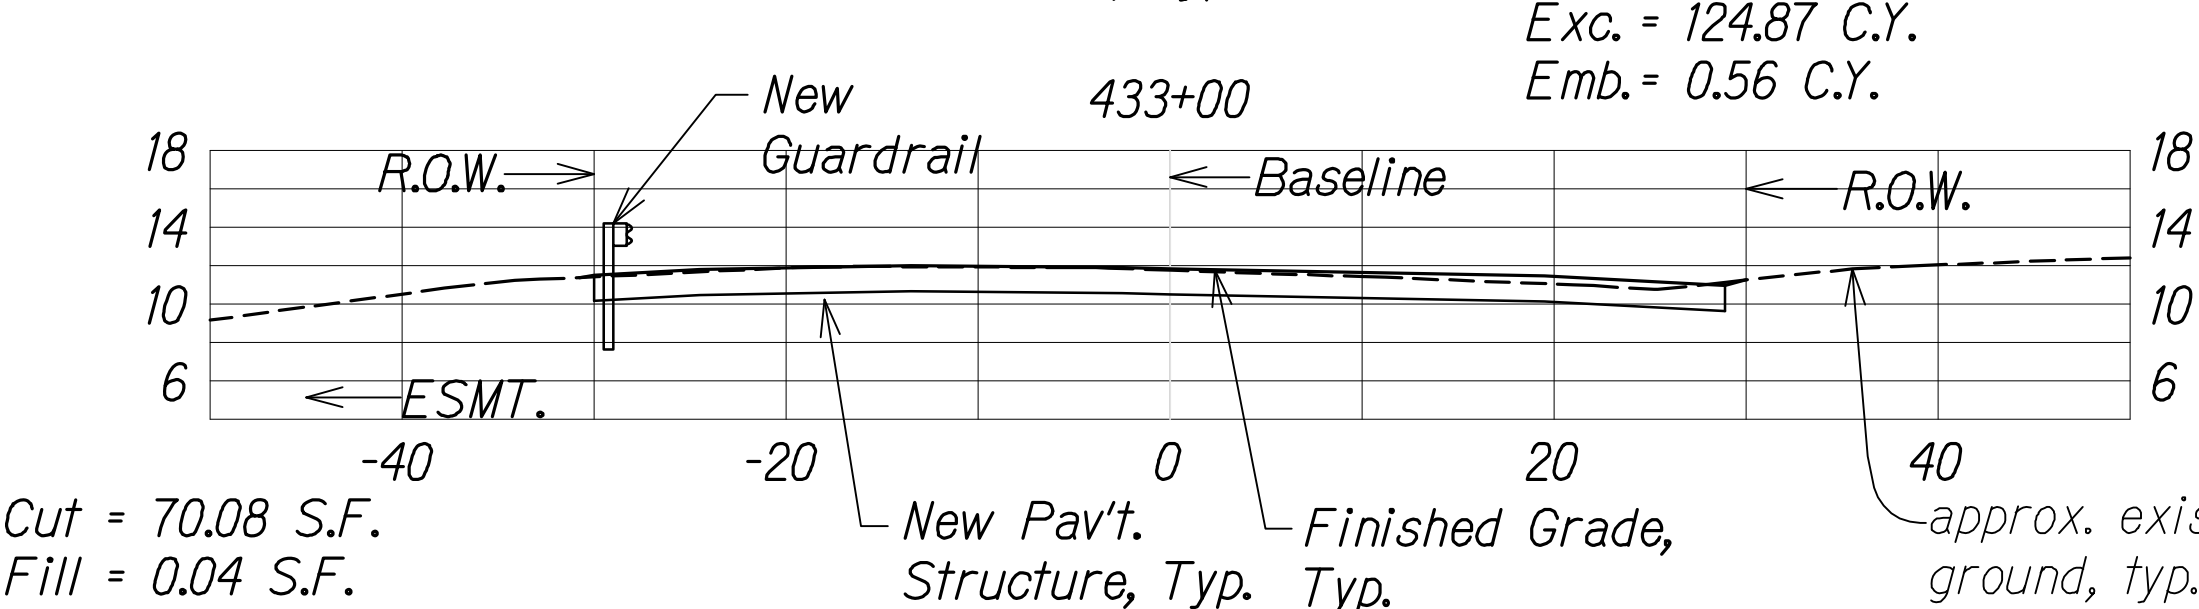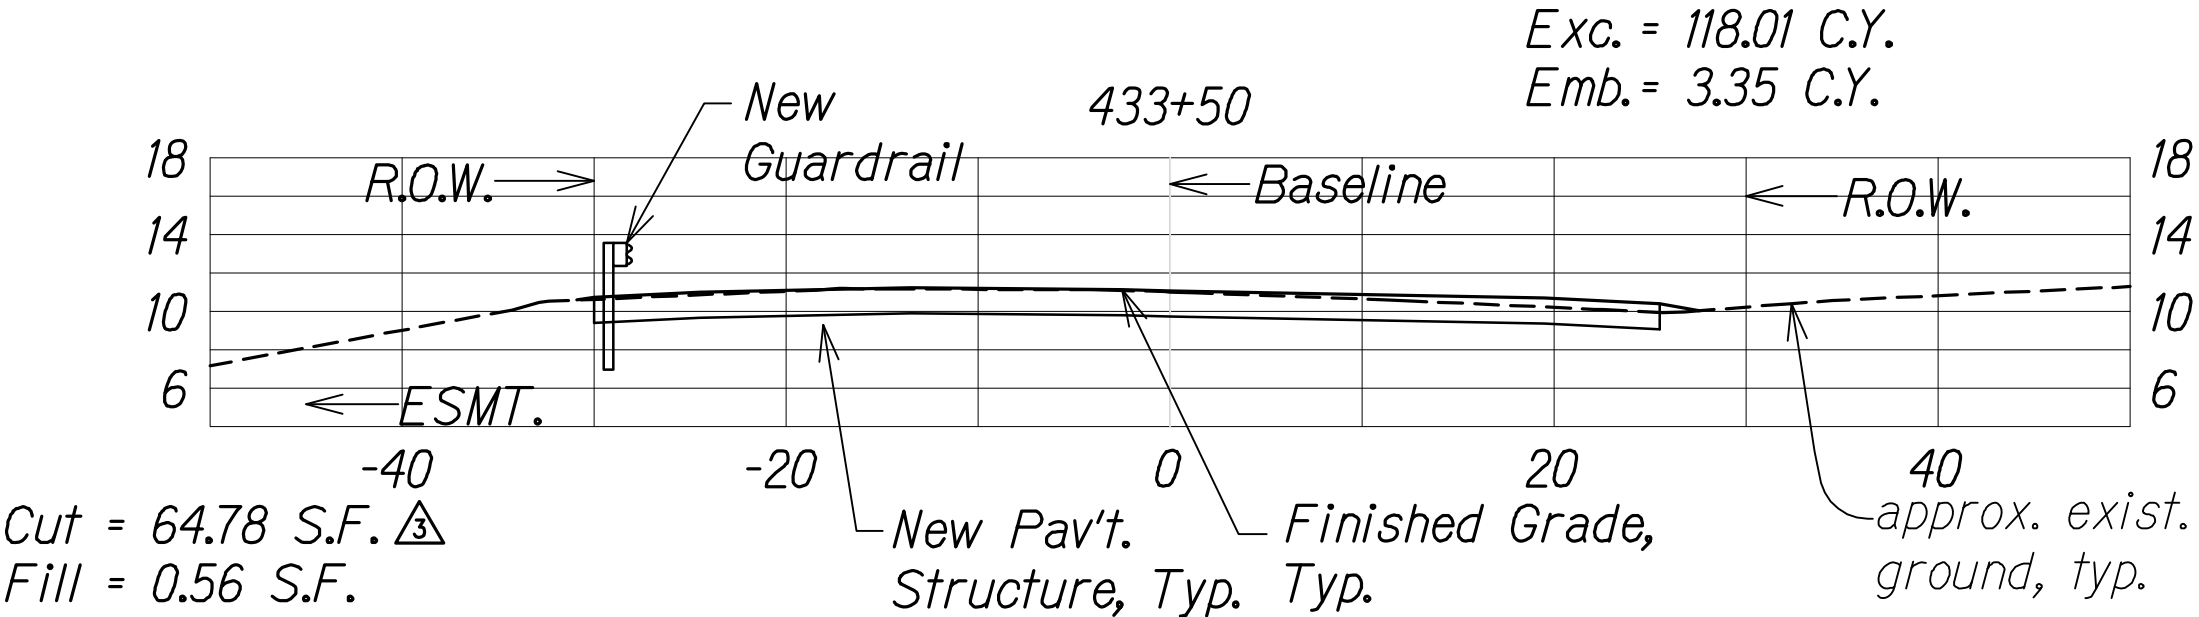

THIS WORK WAS PREPARED BY ME OR UNDER MY SUPERVISION.  
APRIL 30, 2020  
WILSON OKAMOTO CORPORATION LIC. EXP. DATE

STATE OF HAWAII  
DEPARTMENT OF TRANSPORTATION  
HIGHWAYS DIVISION

**ROADWAY CROSS SECTIONS**

KUHIO HIGHWAY SHORT-TERM IMPROVEMENTS KUAMOO ROAD TO TEMPORARY KAPAA BYPASS ROAD  
Fed. Aid Proj. No. NH-056-1(50)  
Scale: 1" = 10' Date: July 2019

SHEET No. XS5 OF 8 SHEETS



Kuhio Highway Improvements  
ROADWAY CROSS SECTIONS  
Scale: 1" = 10'

DATE	REVISION
11/12/19	△ Reissuing plan for legibility; revised cross section
9/20/19	△ Reissuing plan for legibility only. No design changes have been made.

SURVEY PLOTTED BY	DATE
DRAWN BY	
TRACED BY	
CHECKED BY	
ORIGINAL PLAN	
NOTE BOOK	
No.	


FED. ROAD DIST. NO.	STATE	FED. AID PROJ. NO.	FISCAL YEAR	SHEET NO.	TOTAL SHEETS
KAUAI	HAW.	NH-056-1(50)	2019	ADD.184	244

Sheet Total  
Exc. = 1379.36 C.Y.  
Emb. = 229.69 C.Y.

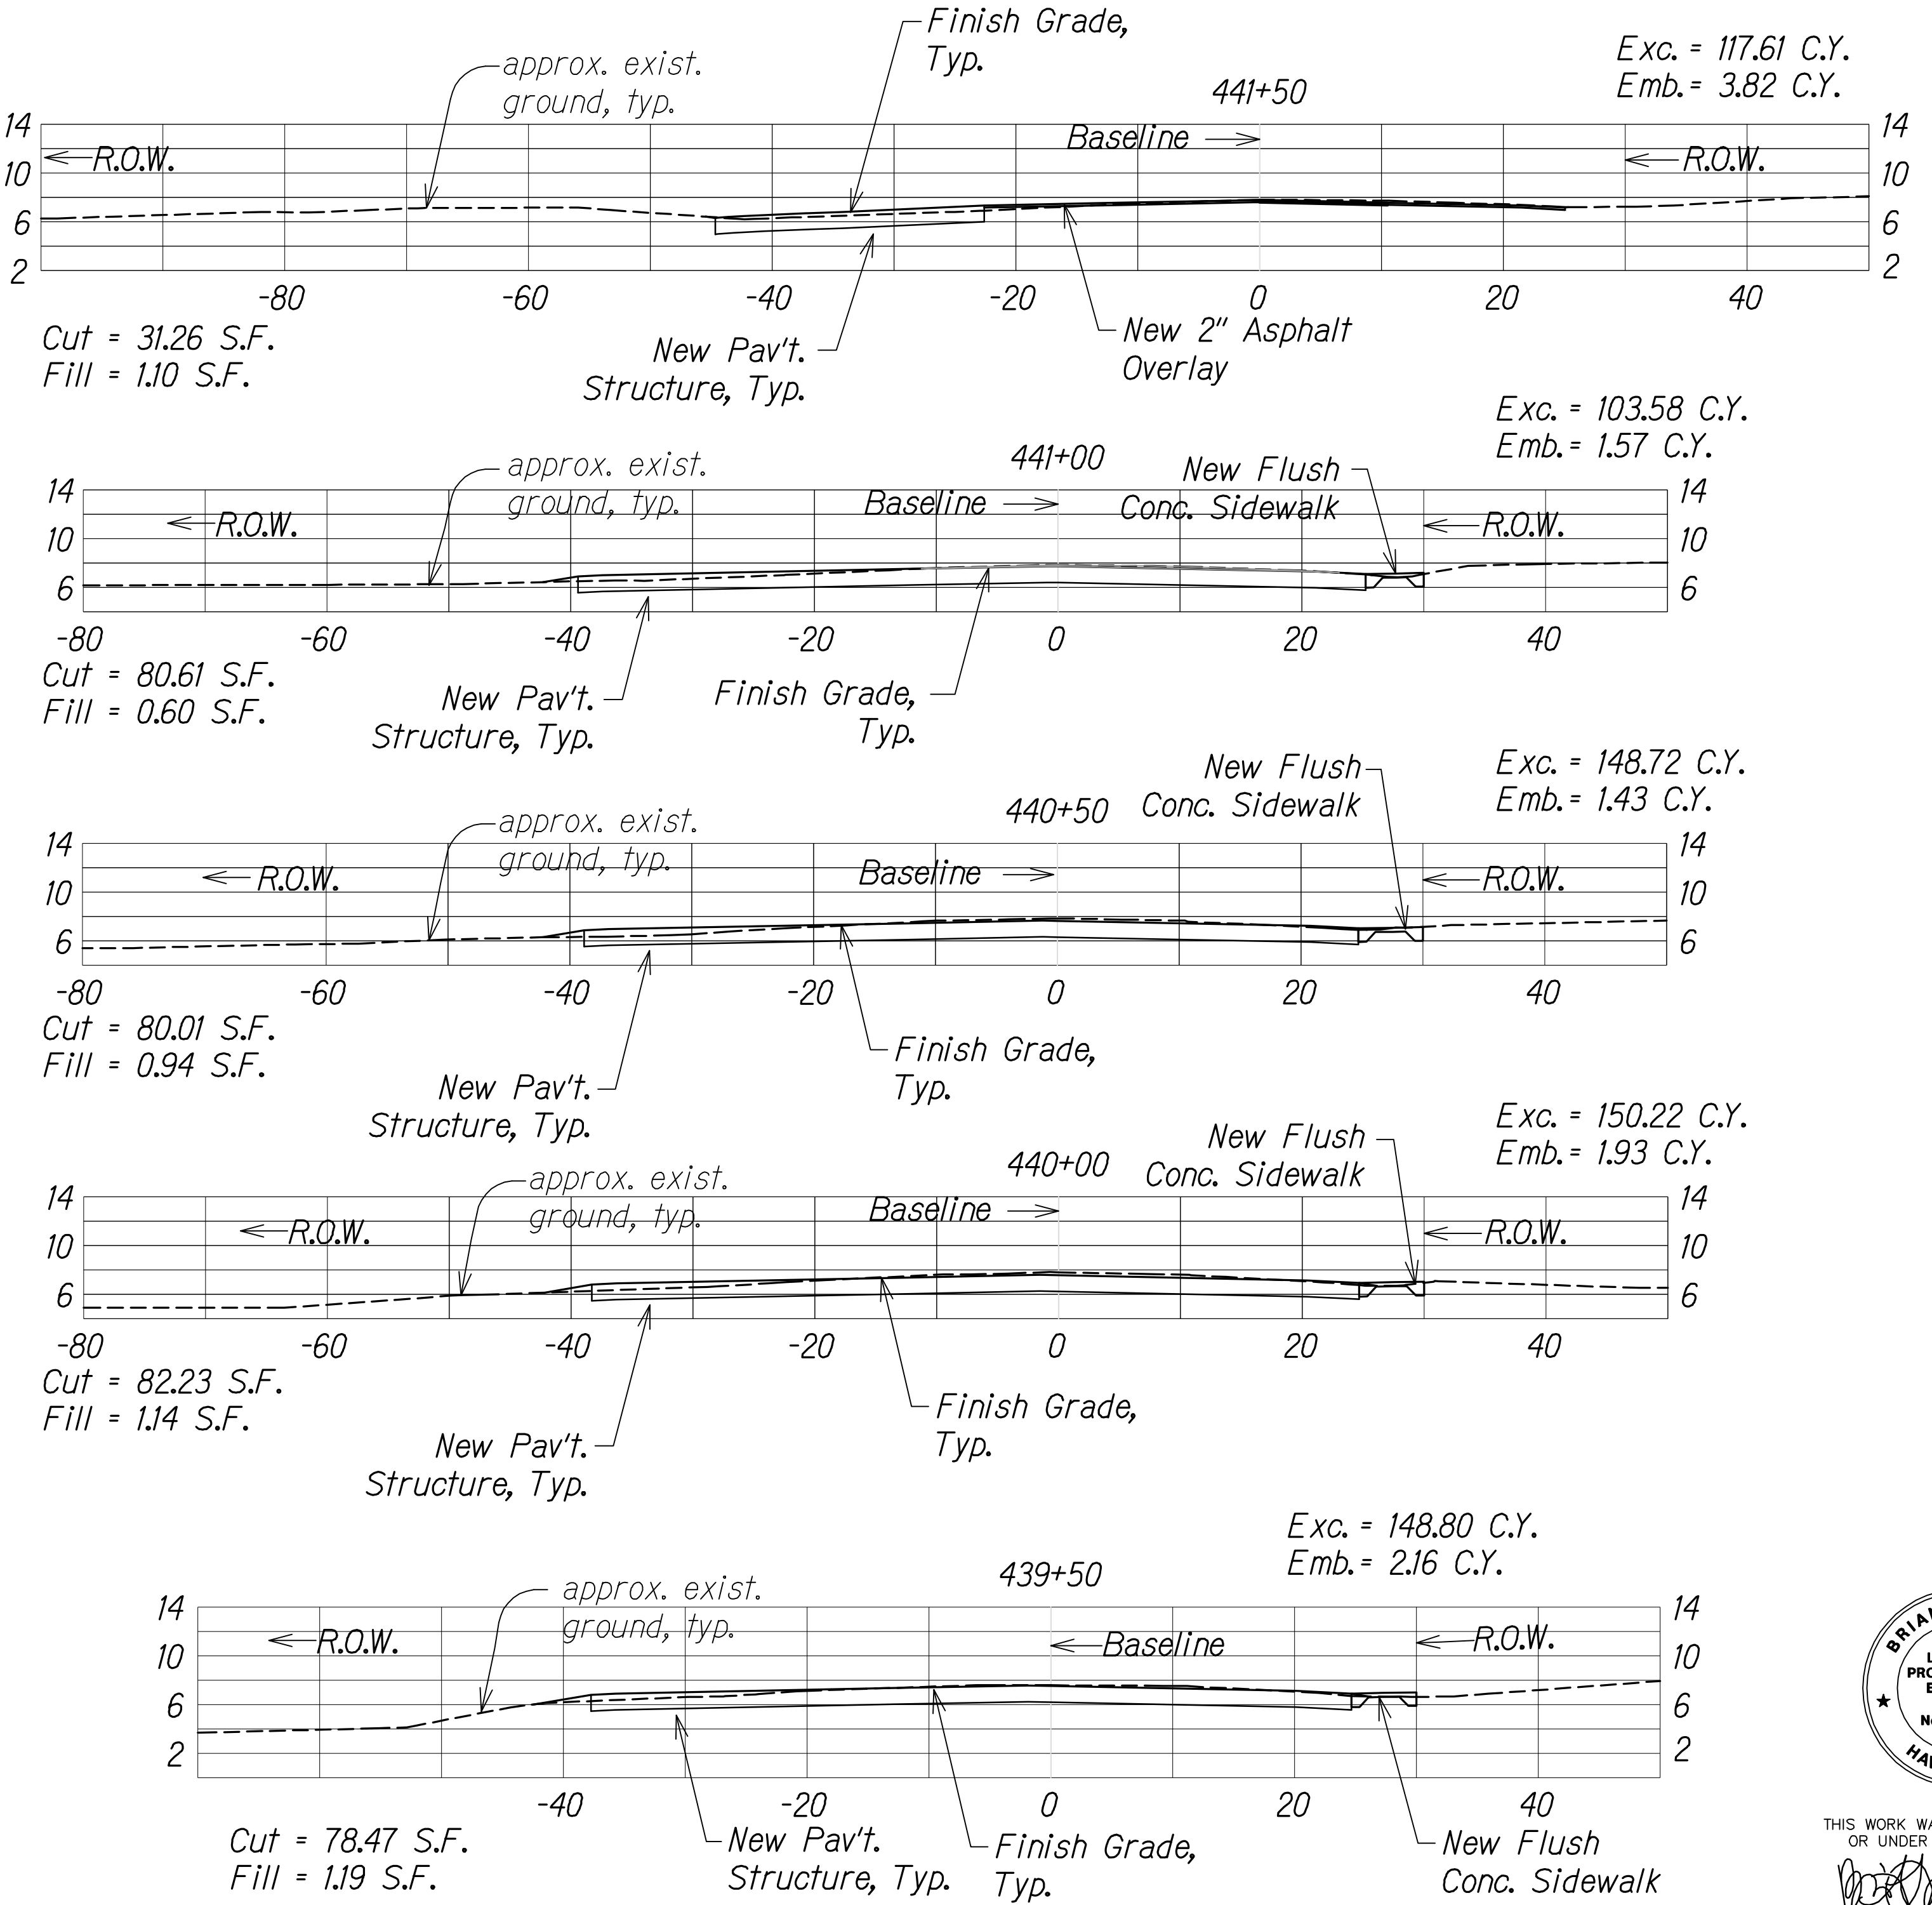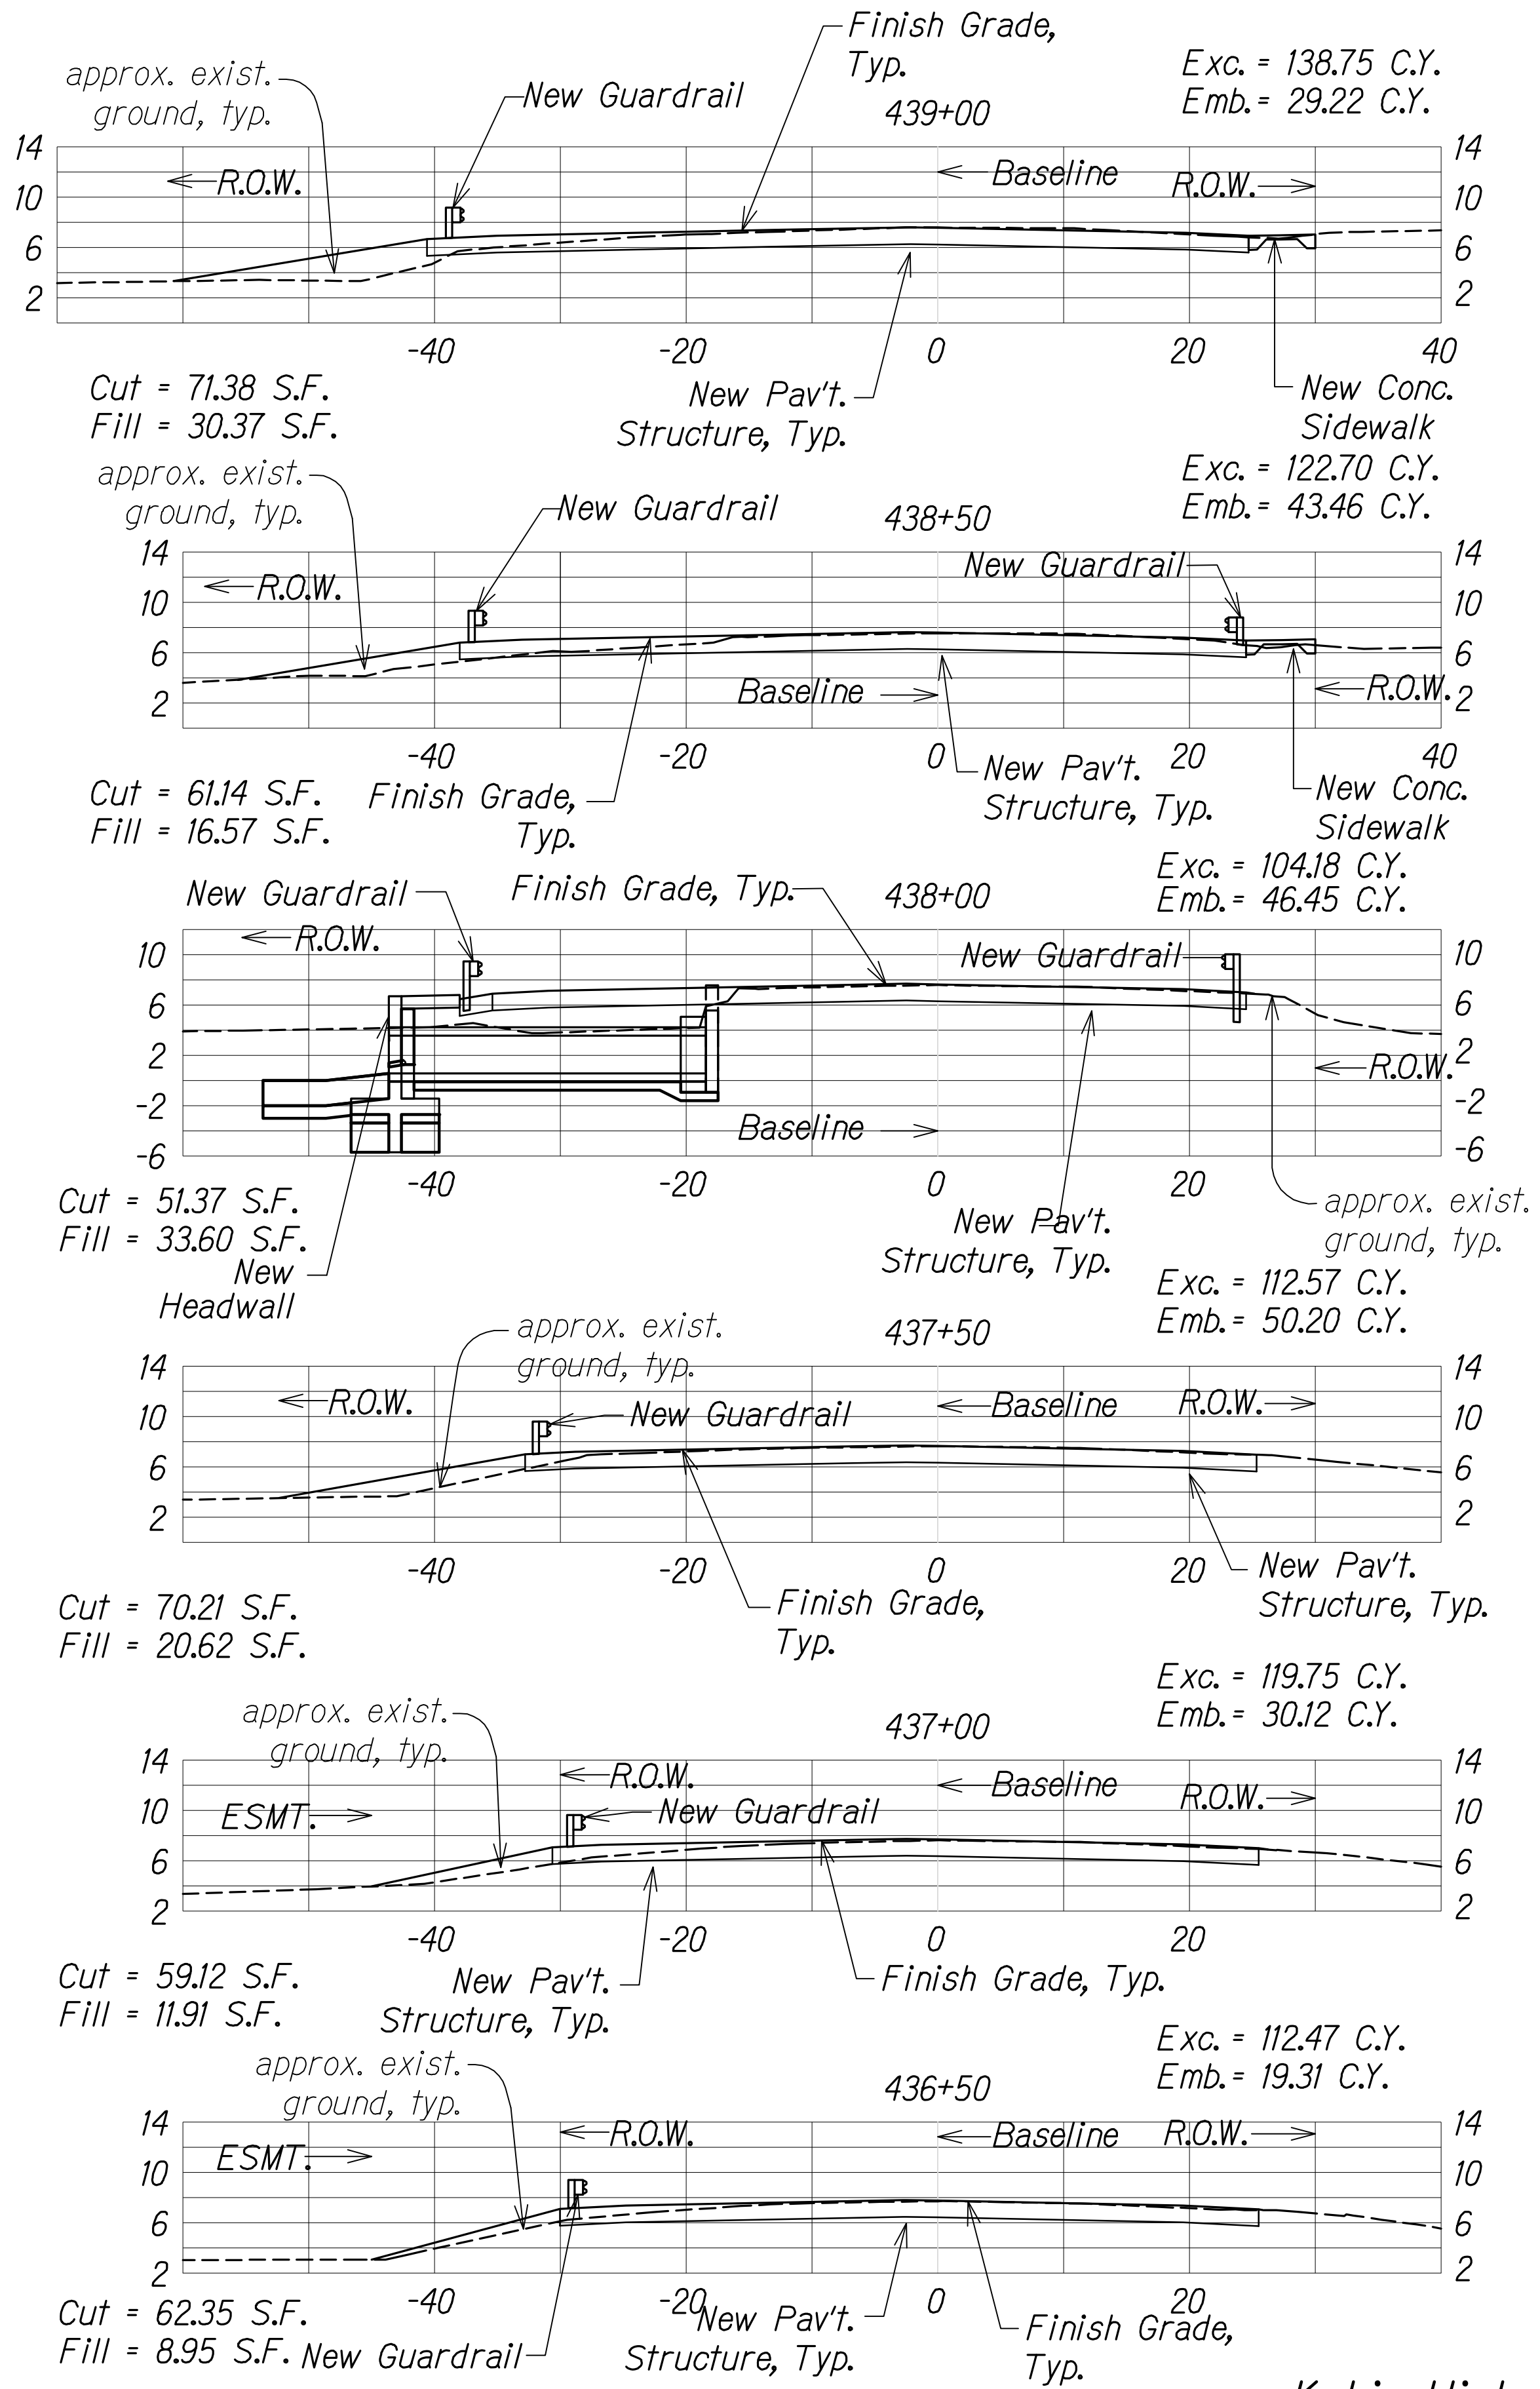

SURVEY PLOTTED BY	DATE
DRAWN BY	
TRACED BY	
CHECKED BY	
ORIGINAL PLAN	
NOTE BOOK	
No.	

Kuhio Highway Improvements  
ROADWAY CROSS SECTIONS  
Scale: 1" = 10'

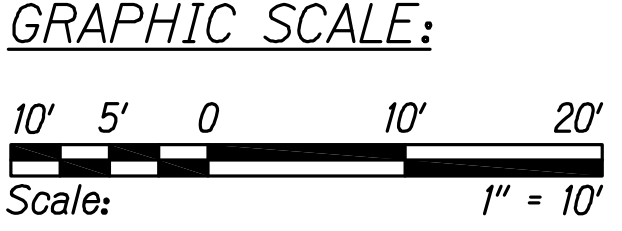

DATE	REVISION
11/12/19	△ Reissuing plan for legibility only. No design changes have been made.
9/20/19	△ Reissuing plan for legibility only. No design changes have been made.

THIS WORK WAS PREPARED BY ME OR UNDER MY SUPERVISION.  
*[Signature]*  
WILSON OKAMOTO CORPORATION LIC. EXP. DATE APRIL 30, 2020

STATE OF HAWAII  
DEPARTMENT OF TRANSPORTATION  
HIGHWAYS DIVISION

**ROADWAY CROSS SECTIONS**

KUHIO HIGHWAY SHORT-TERM IMPROVEMENTS KUAMOO ROAD TO TEMPORARY KAPAA BYPASS ROAD  
Fed. Aid Proj. No. NH-056-1(50)  
Scale: 1" = 10' Date: July 2019

SHEET No. XS6 OF 8 SHEETS




FED. ROAD DIST. NO.	STATE	FED. AID PROJ. NO.	FISCAL YEAR	SHEET NO.	TOTAL SHEETS
KAUAI	HAW.	NH-056-1(50)	2019	ADD.185	244

Sheet Total


Exc. = 102.95 C.Y.  
Emb. = 4.38 C.Y.

Roadway Total  $\Delta$

Total Exc. = 9,034.19 C.Y.  
Total Emb. = 325.08 C.Y.

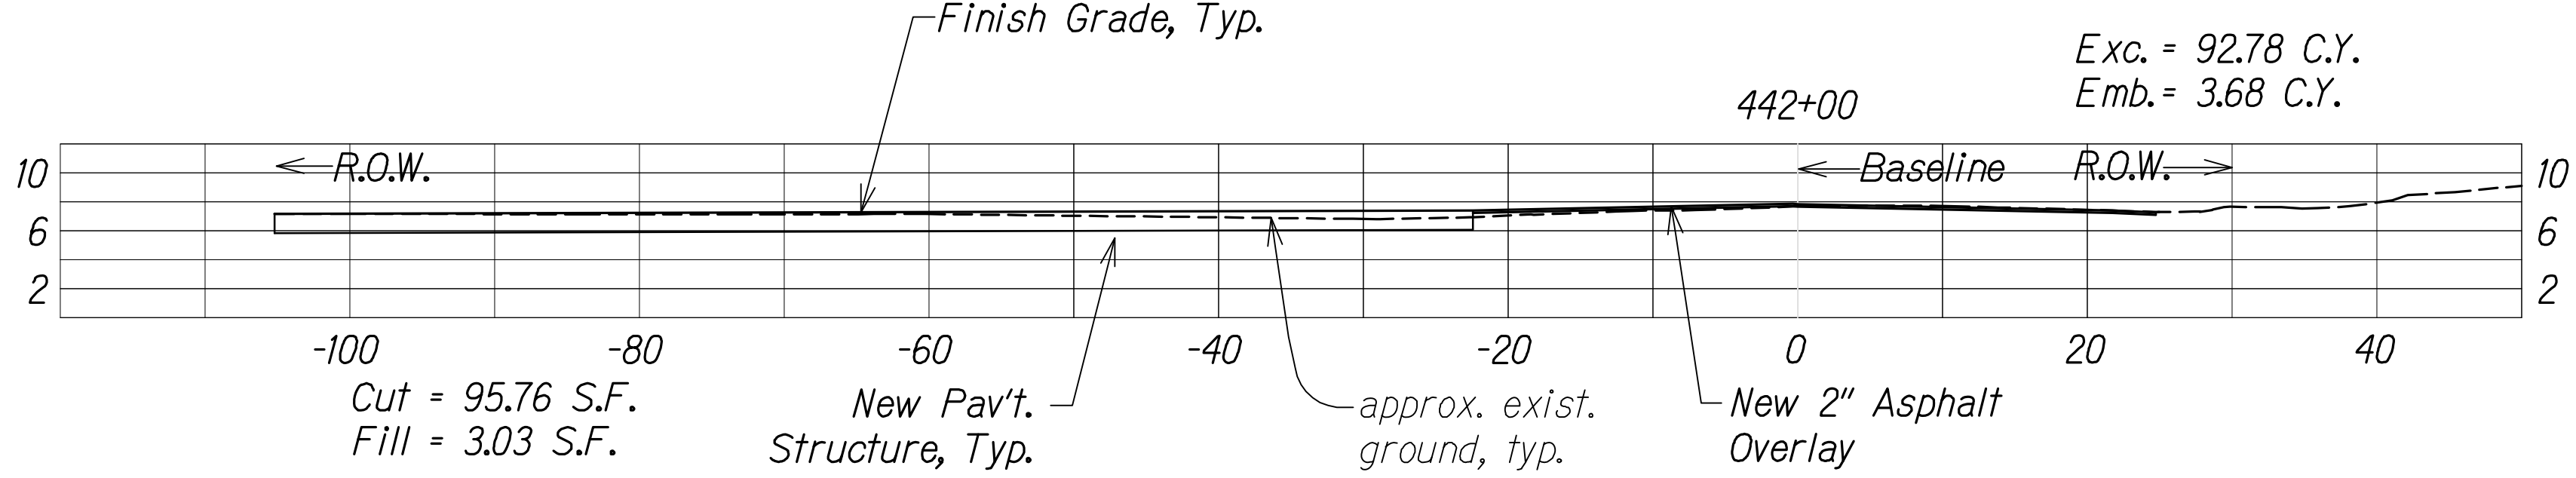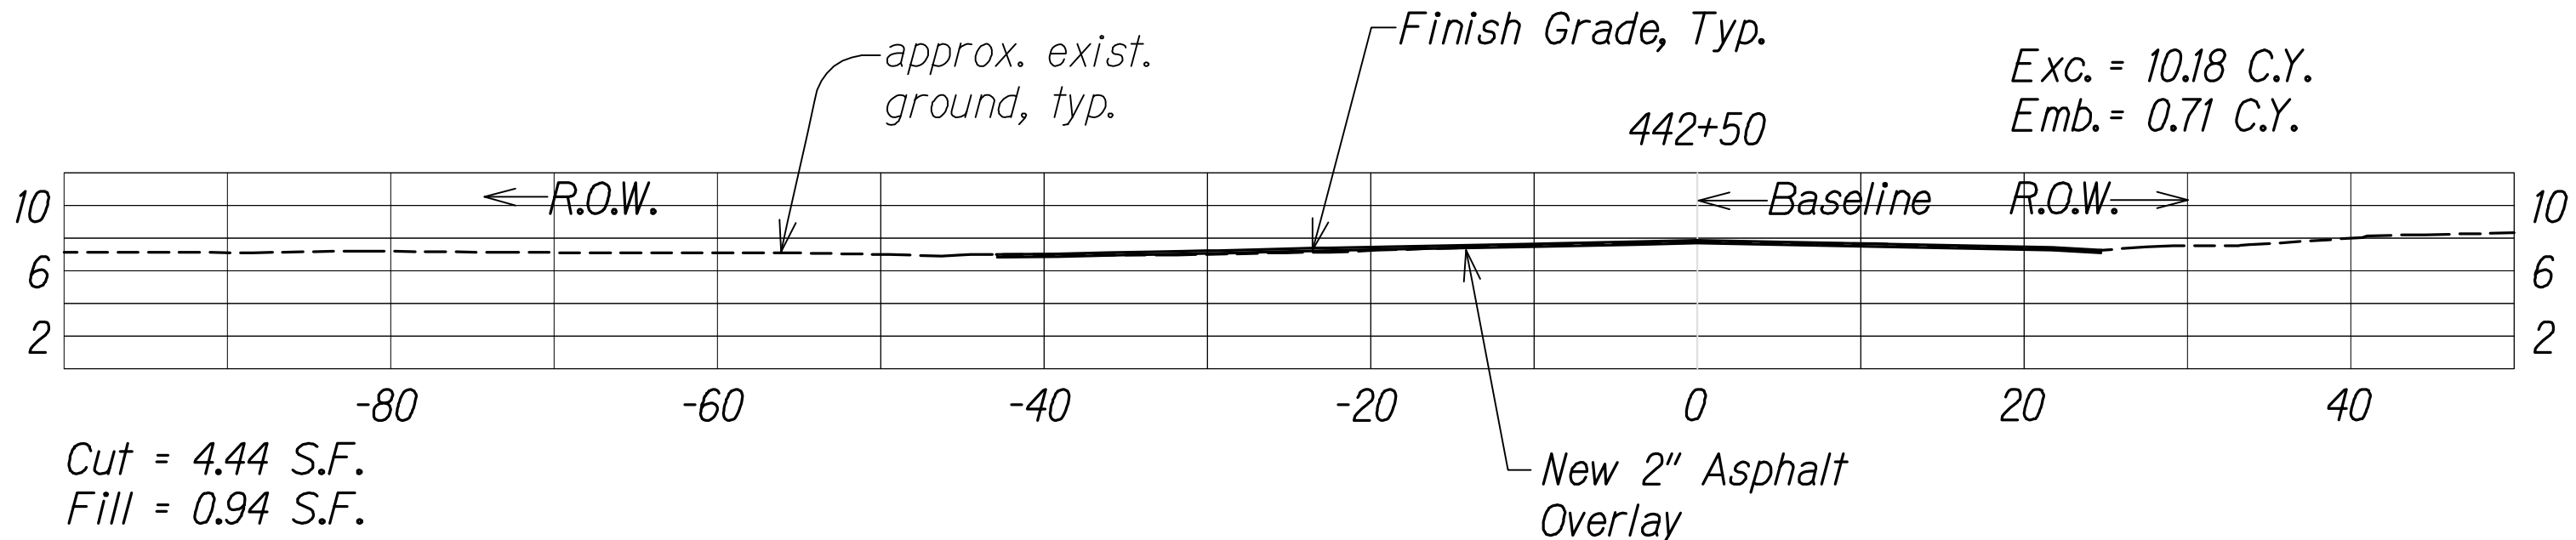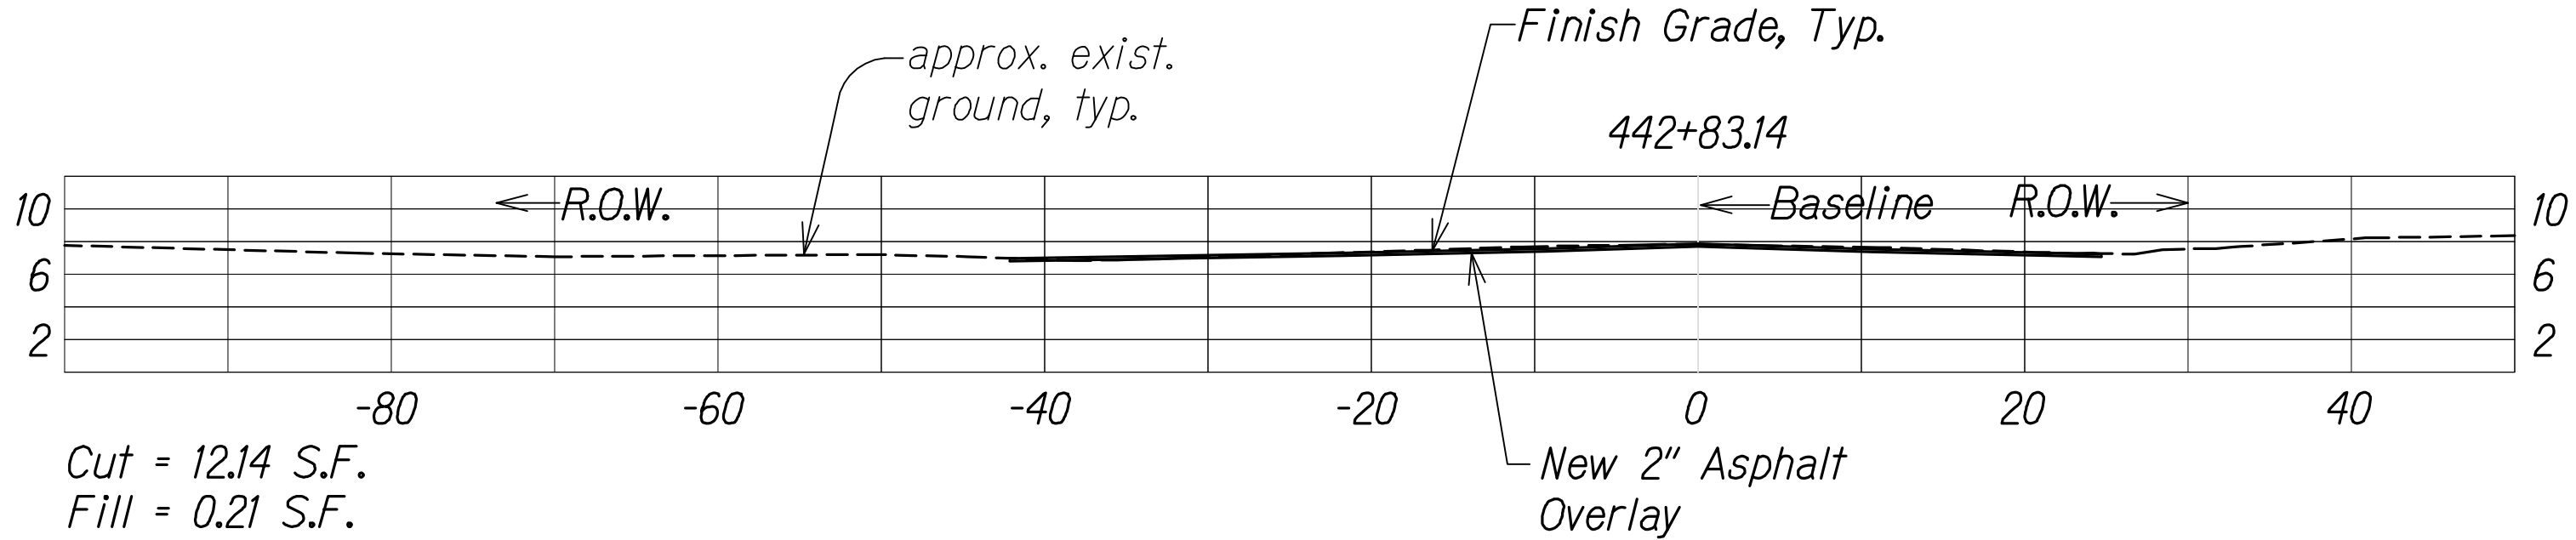

GRAPHIC SCALE:

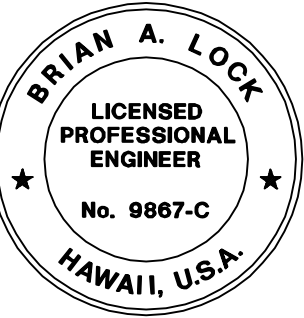

THIS WORK WAS PREPARED BY ME  
OR UNDER MY SUPERVISION.  
*[Signature]*  
WILSON OKAMOTO CORPORATION LIC. EXP. DATE

STATE OF HAWAII  
DEPARTMENT OF TRANSPORTATION  
HIGHWAYS DIVISION

ROADWAY CROSS SECTIONS

KUHIO HIGHWAY SHORT-TERM  
IMPROVEMENTS KUAMOO ROAD  
TO TEMPORARY KAPAA BYPASS ROAD  
Fed. Aid Proj. No. NH-056-1(50)  
Scale: 1" = 10' Date: July 2019

DATE REVISION

11/12/19  $\Delta$  Reissuing plan for legibility; revised total quantities

9/20/19  $\Delta$  Reissuing plan for legibility only. No design changes have been made.

SHEET No. X57 OF 8 SHEETS







Kuhio Highway Improvements  
ROADWAY CROSS SECTIONS  
Scale: 1" = 10'

SURVEY PLOTTED BY	DATE
DRAWN BY	
TRACED BY	
CHECKED BY	
ORIGINAL PLAN	
NOTE BOOK	
No.	



FED. ROAD DIST. NO.	STATE	FED. AID PROJ. NO.	FISCAL YEAR	SHEET NO.	TOTAL SHEETS
KAUAI	HAW.	NH-056-1(50)	2019	C.O.ADD.186	244

Total Exc.= 364.31 C.Y.  
Total Emb.= 0 C.Y.

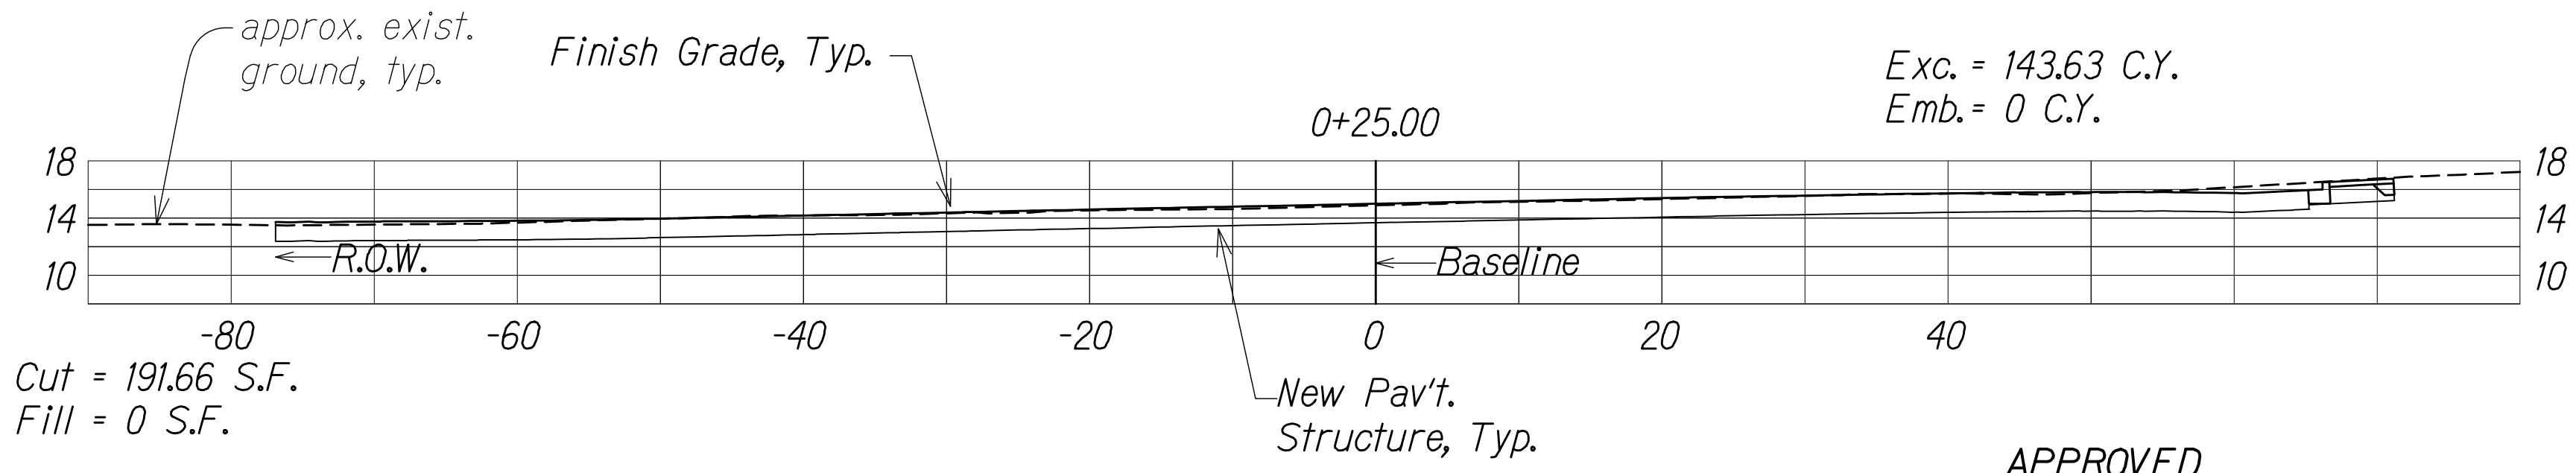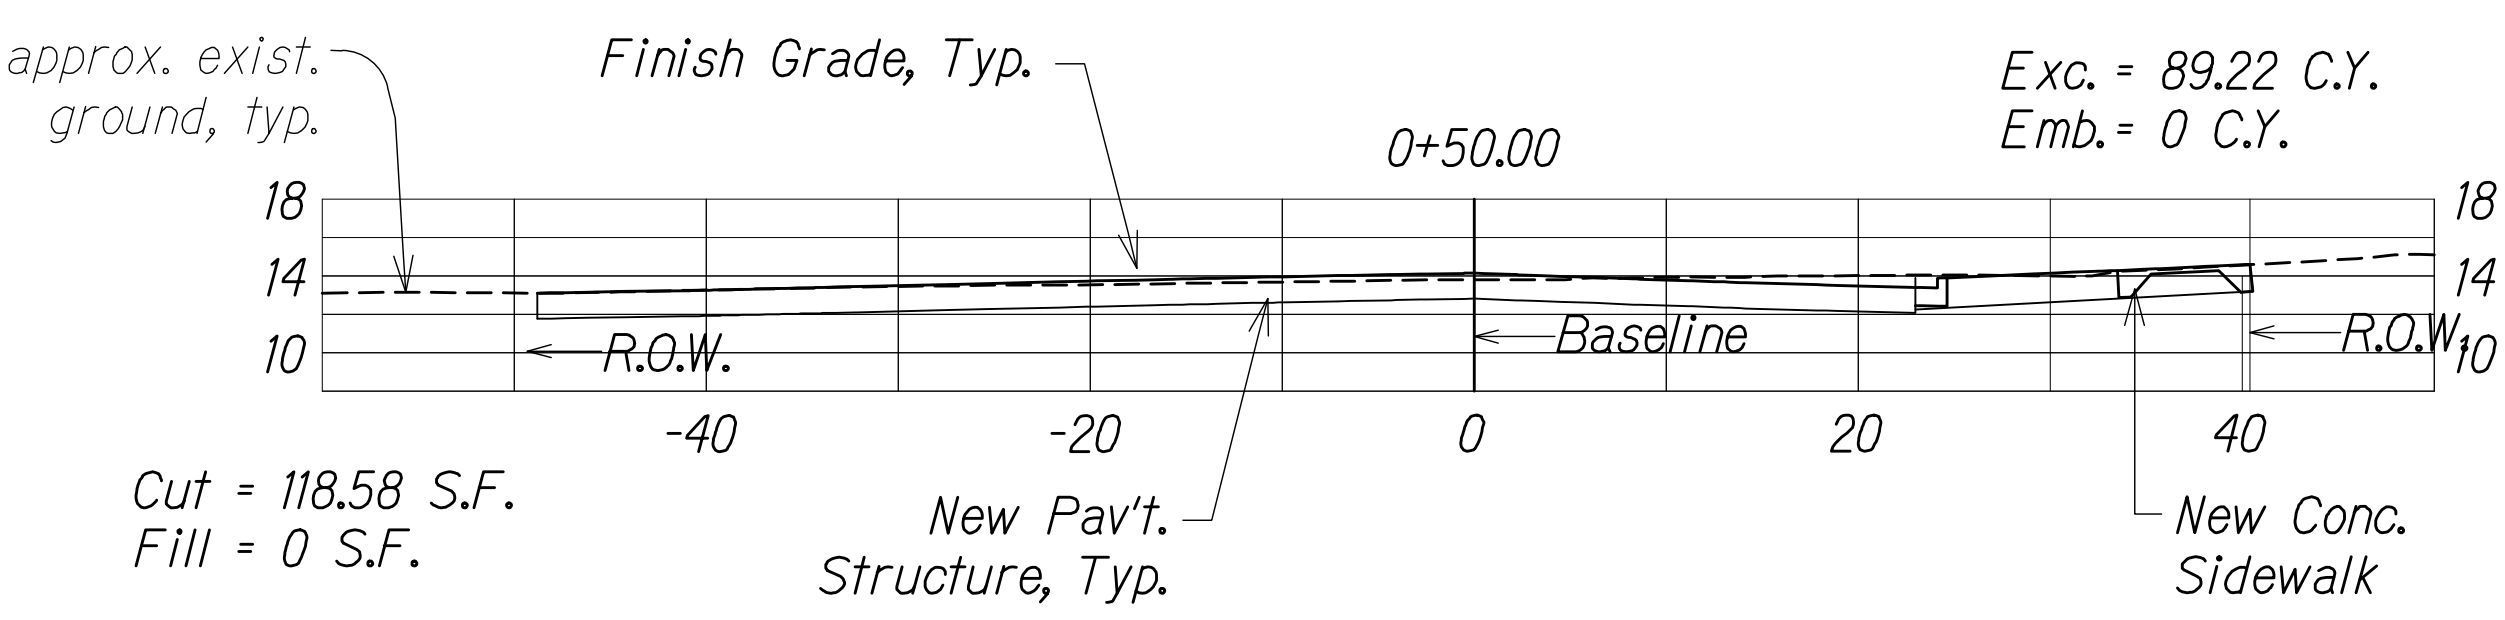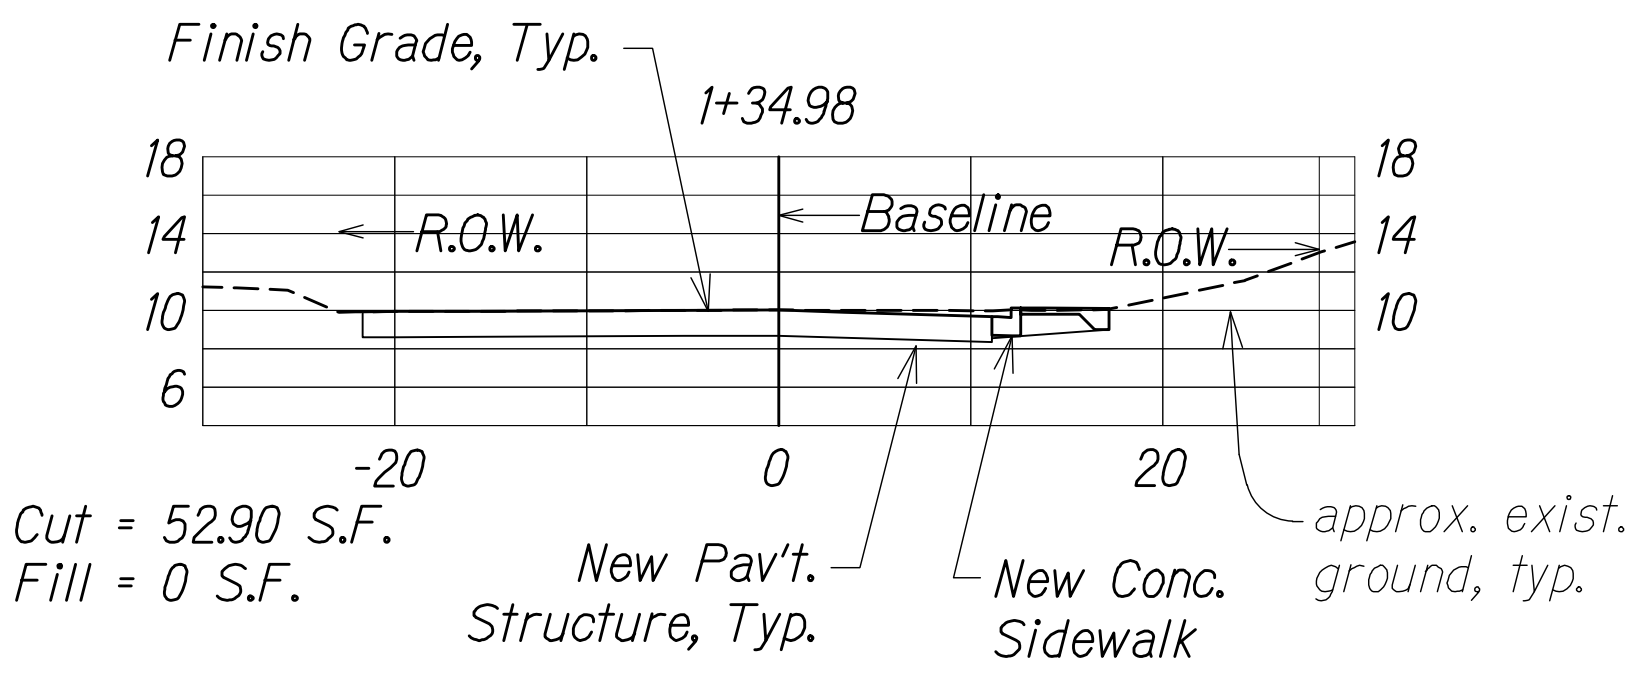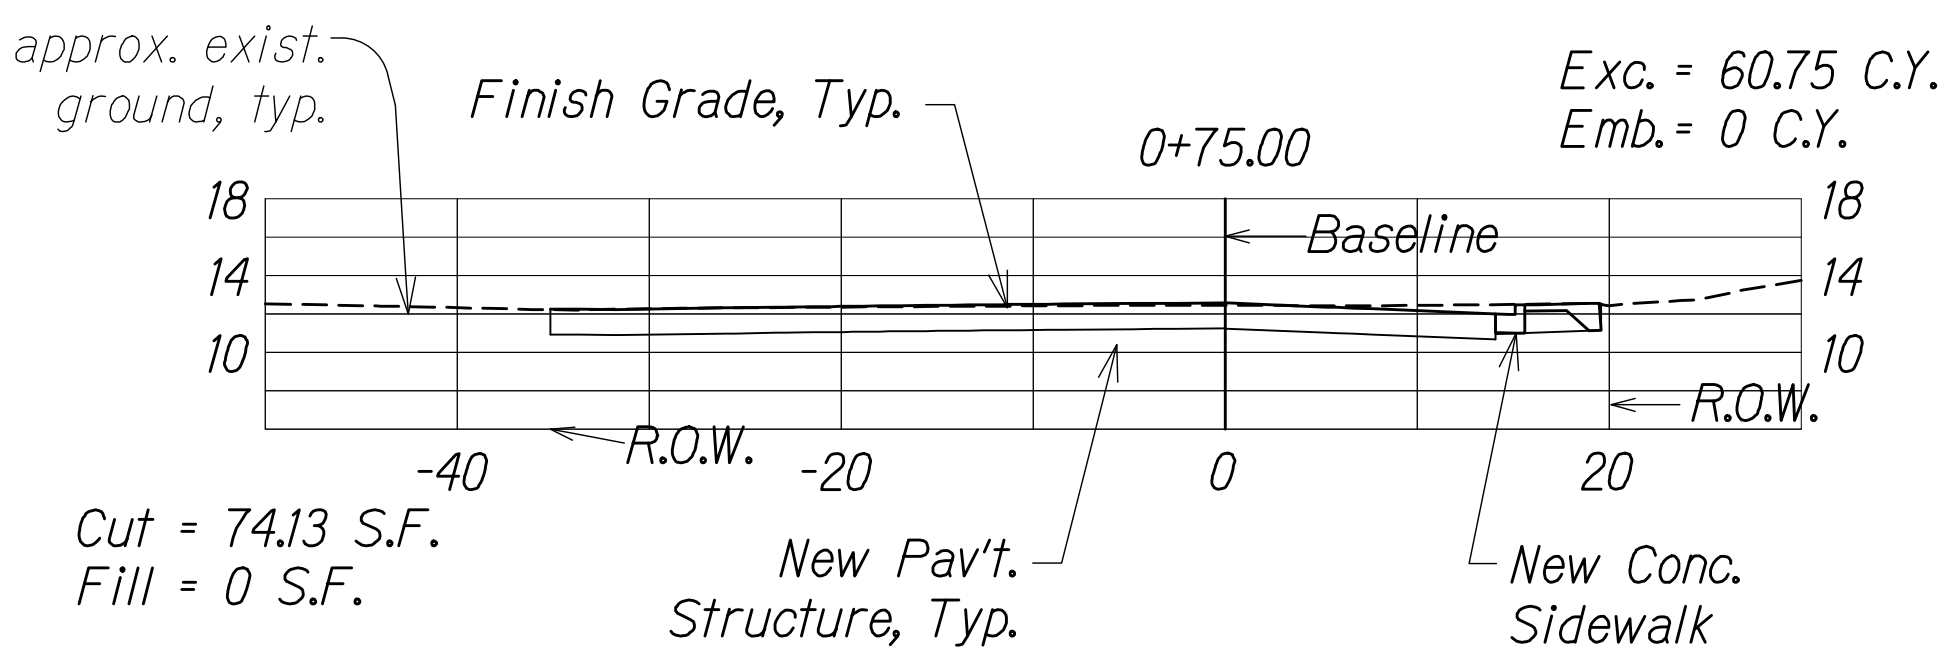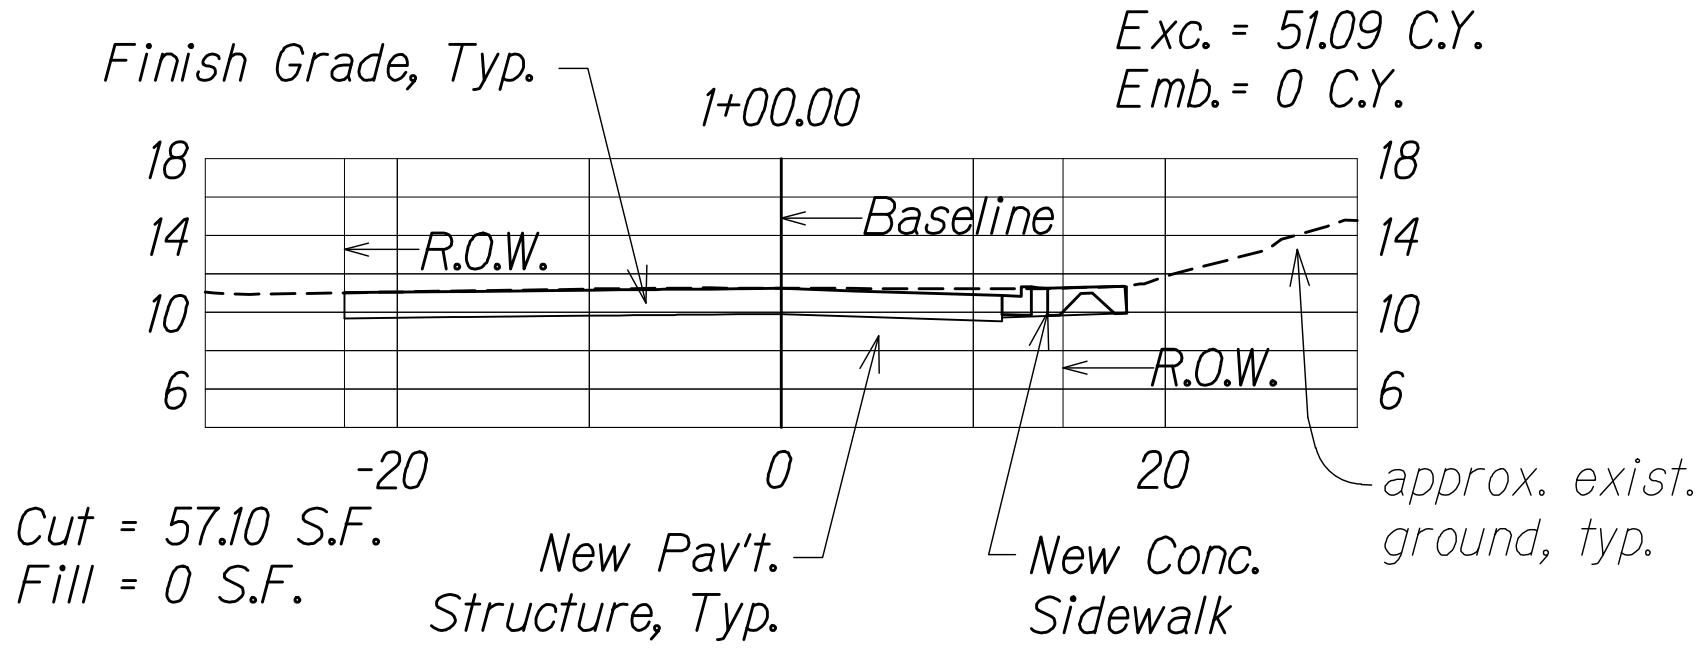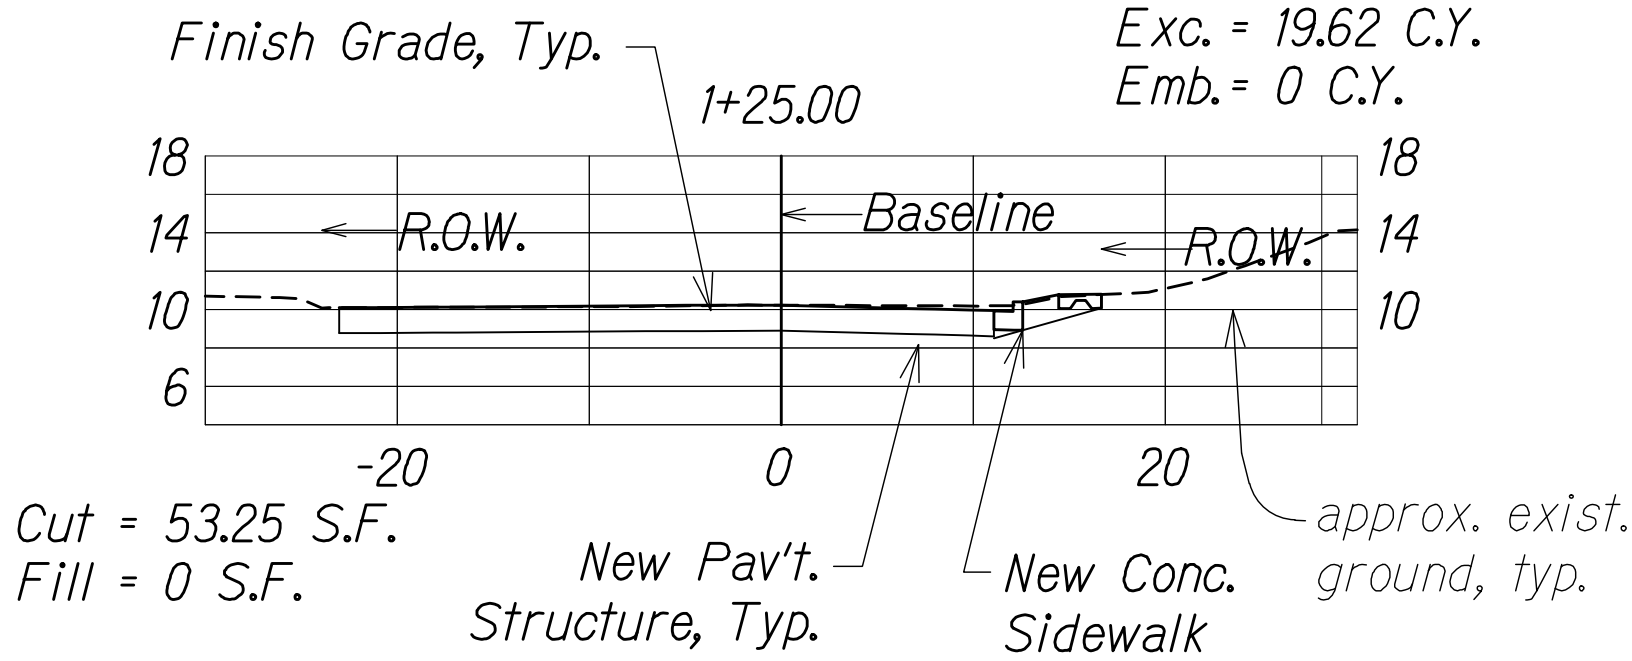

Haleilio Road Improvements  
ROADWAY CROSS SECTIONS  
Scale: 1" = 10'

APPROVED

County Engineer  
County of Kaua'i  
(For Work Within the County Right-of-Way)



Date

11/12/19  
9/20/19  
Reissuing plan for legibility only. No design changes have been made.  
Reissuing plan for legibility only. No design changes have been made.

DATE REVISION

THESE PLANS HAVE BEEN PREPARED UTILIZING INFORMATION PROVIDED BY THE PROJECT CONTRACTOR. THE UPDATED CONSTRUCTION INFORMATION DEPICTED HEREIN HAS NOT BEEN VERIFIED FOR ACCURACY AND COMPLETENESS. NO REPRESENTATION IS BEING MADE TO ITS VALIDITY.

GRAPHIC SCALE:

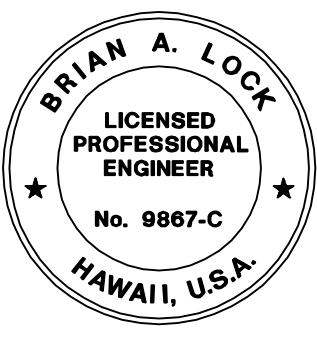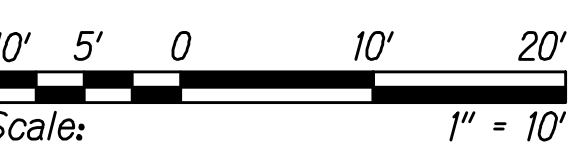

THIS WORK WAS PREPARED BY ME OR UNDER MY SUPERVISION.  
WILSON OKAMOTO CORPORATION  
APRIL 30, 2020  
LIC. EXP. DATE

STATE OF HAWAII  
DEPARTMENT OF TRANSPORTATION  
HIGHWAYS DIVISION  
ROADWAY CROSS SECTIONS  
KUHIO HIGHWAY SHORT-TERM IMPROVEMENTS KUAMOO ROAD TO TEMPORARY KAPAA BYPASS ROAD  
Fed. Aid Proj. No. NH-056-1(50)  
Scale: 1" = 10' Date: July 2019  
SHEET No. XS8 OF 8 SHEETS

"AS-BUILT"

C.O.ADD.186

SURVEY PLOTTED BY	DATE
DRAWN BY	
TRACED BY	
CHECKED BY	
ORIGINAL PLAN	
NOTE BOOK	
No.	