


FED. ROAD DIST. NO.	STATE	PROJ. NO.	FISCAL YEAR	SHEET NO.	TOTAL SHEETS
HAWAII	HAW.	56D-03-08M	2008	9	20

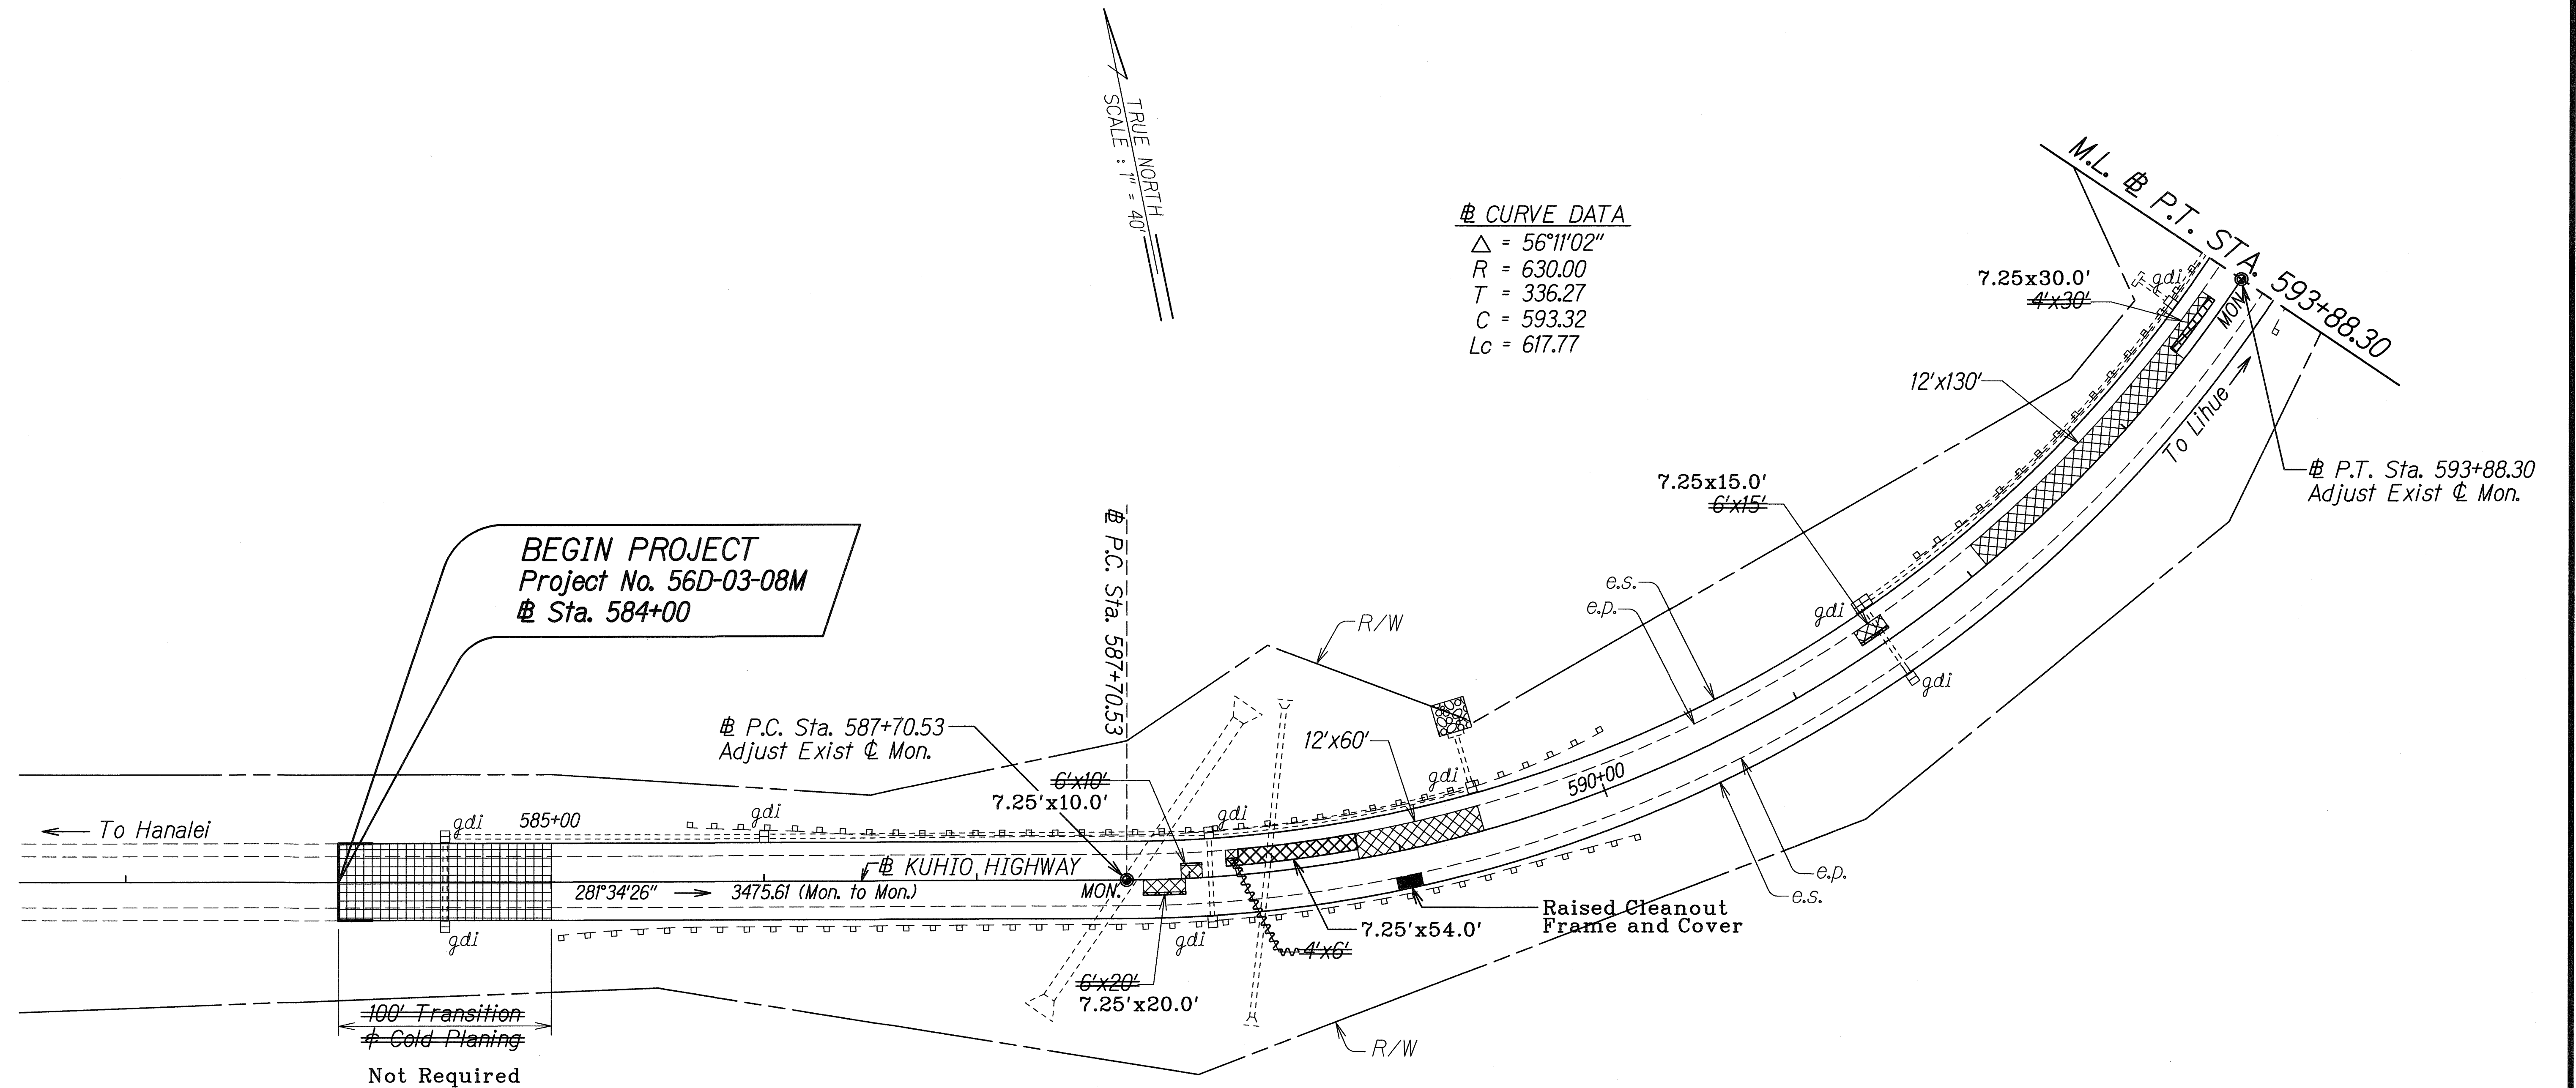

CURVE DATA
 $\Delta = 56^{\circ}11'02''$
 $R = 630.00$
 $T = 336.27$
 $C = 593.32$
 $L_c = 617.77$

BEGIN PROJECT
 Project No. 56D-03-08M
 # Sta. 584+00

P.C. Sta. 587+70.53
 Adjust Exist # Mon.

P.T. Sta. 593+88.30
 Adjust Exist # Mon.

To Hanalei

100' Transition
 # Cold Planing
 Not Required

Raised Cleanout Frame and Cover



LEGEND FOR AS-BUILT POSTINGS	
	Squiggly line for as-built deletion
	Double line for as-built deletion
Roadway	Text for as-built posting

STATE OF HAWAII
 DEPARTMENT OF TRANSPORTATION
 HIGHWAYS DIVISION
ROADWAY PLAN
KUHIO HIGHWAY RESURFACING
Anini Vista Drive to Mile Post 27.0
Project No. 56D-03-08M
 Scale: 1"=40' Date: March 2008
 SHEET No. 1 OF 5 SHEETS

"AS-BUILT"

ORIGINAL PLAN	DATE
DESIGNED BY	12/07
CHECKED BY	
NOTED BY	
DATE	

FED. ROAD DIST. NO.	STATE	PROJ. NO.	FISCAL YEAR	SHEET NO.	TOTAL SHEETS
HAWAII	HAW.	56D-03-08M	2008	10	20

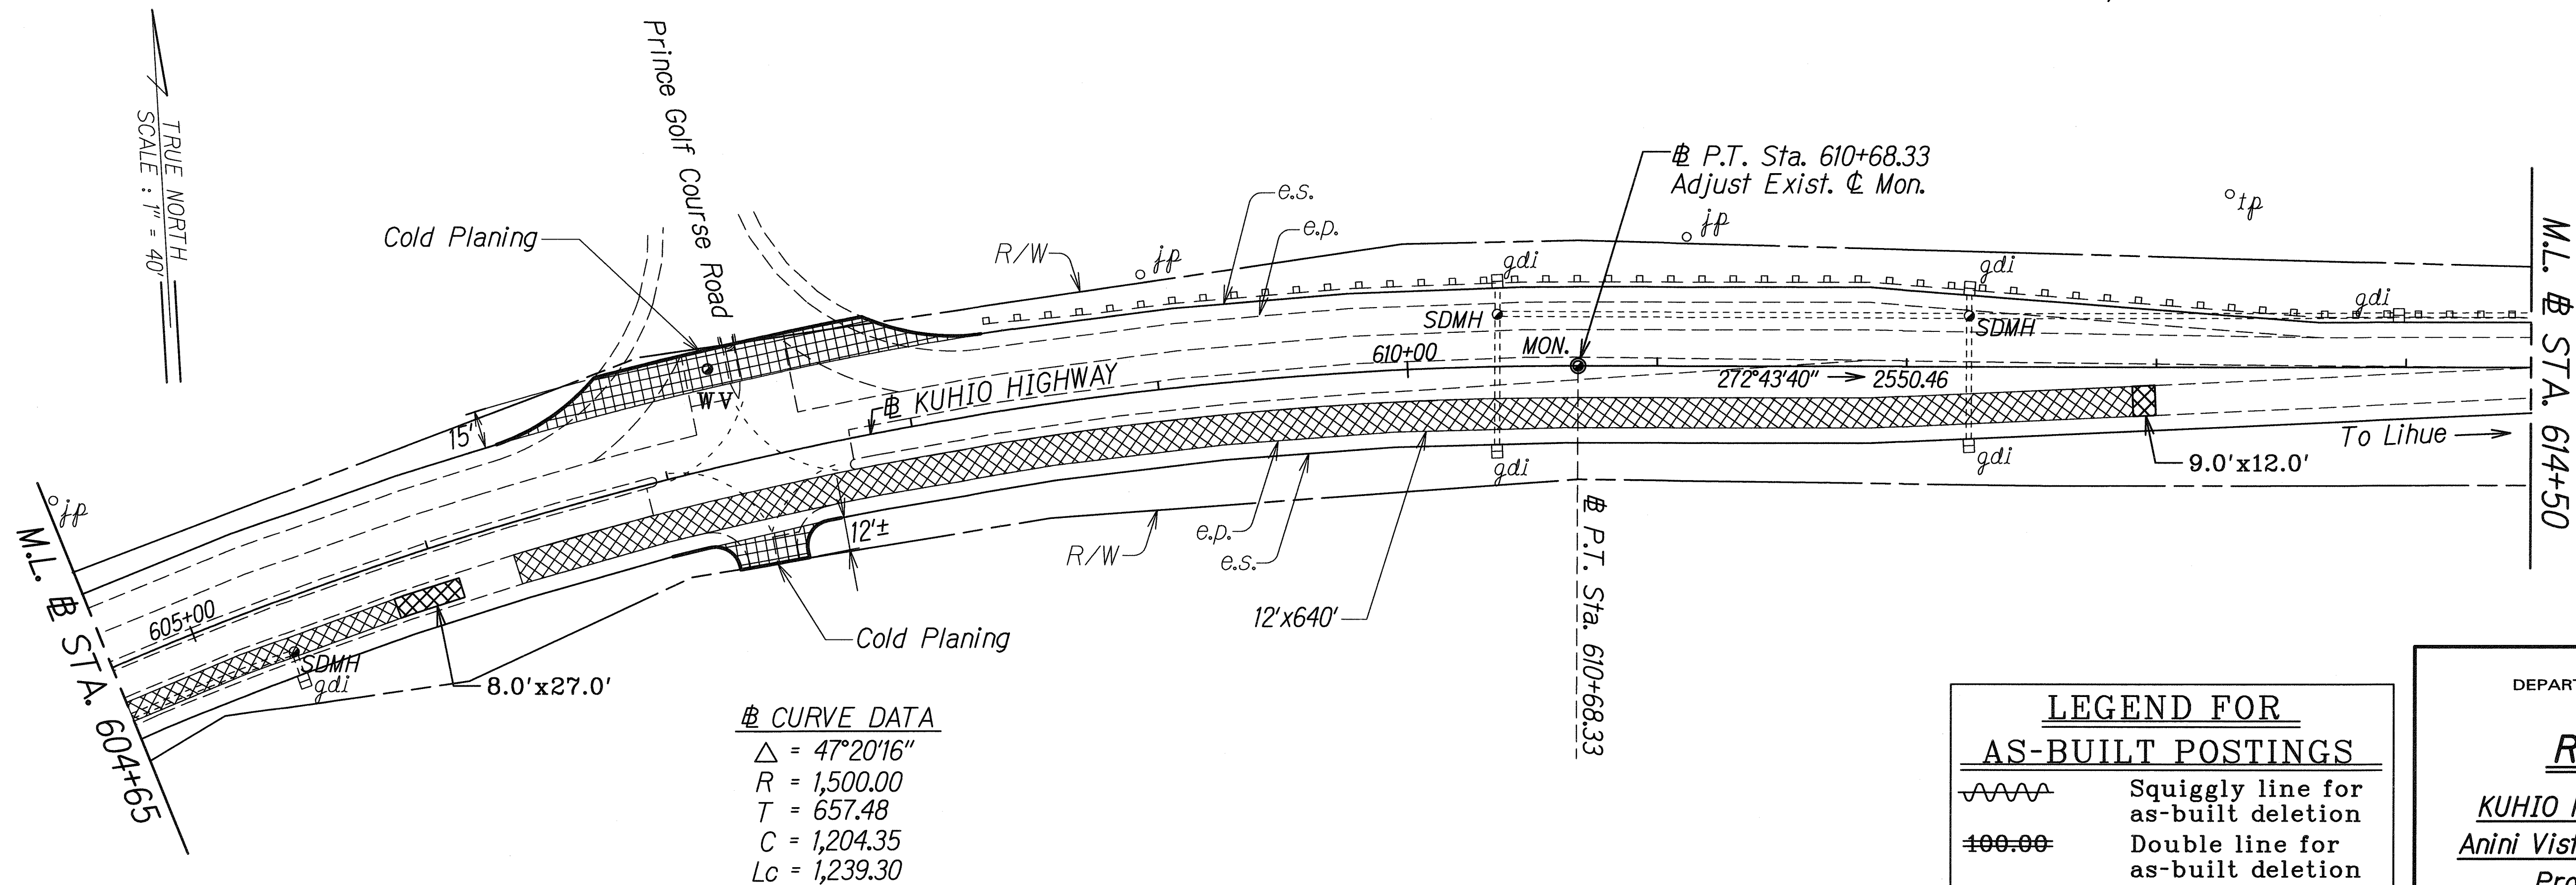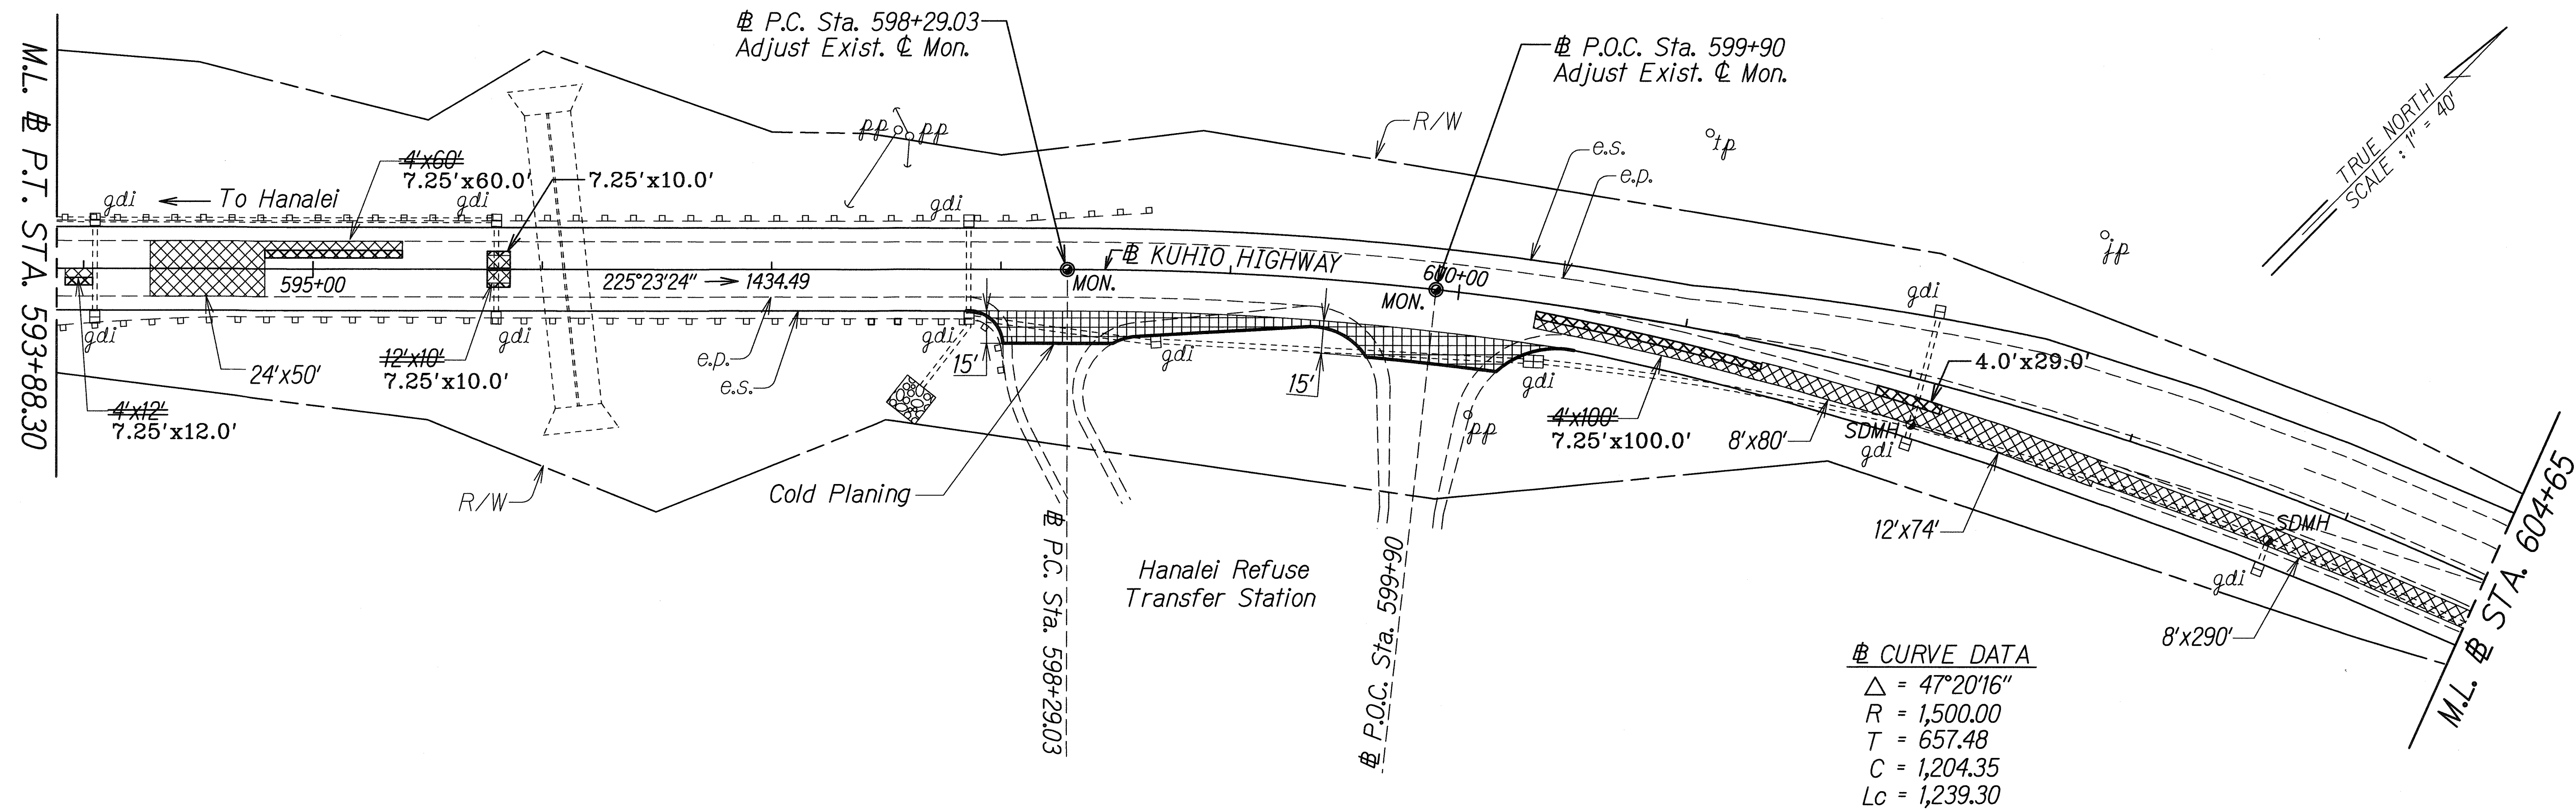

LEGEND FOR AS-BUILT POSTINGS	
	Squiggly line for as-built deletion
	Double line for as-built deletion
Roadway	Text for as-built posting

STATE OF HAWAII
DEPARTMENT OF TRANSPORTATION
HIGHWAYS DIVISION

ROADWAY PLAN

KUHIO HIGHWAY RESURFACING
Anini Vista Drive to Mile Post 27.0
Project No. 56D-03-08M



Scale: 1"=40' Date: March 2008

SHEET No. 2 OF 5 SHEETS

SURVEY PLOTTED BY	DATE
DESIGNED BY	12/07
CHECKED BY	
QUANTITIES BY	
NOTED BY	
ORIGINAL PLAN	

"AS-BUILT"

FED. ROAD DIST. NO.	STATE	PROJ. NO.	FISCAL YEAR	SHEET NO.	TOTAL SHEETS
HAWAII	HAW.	56D-03-08M	2008	12	20

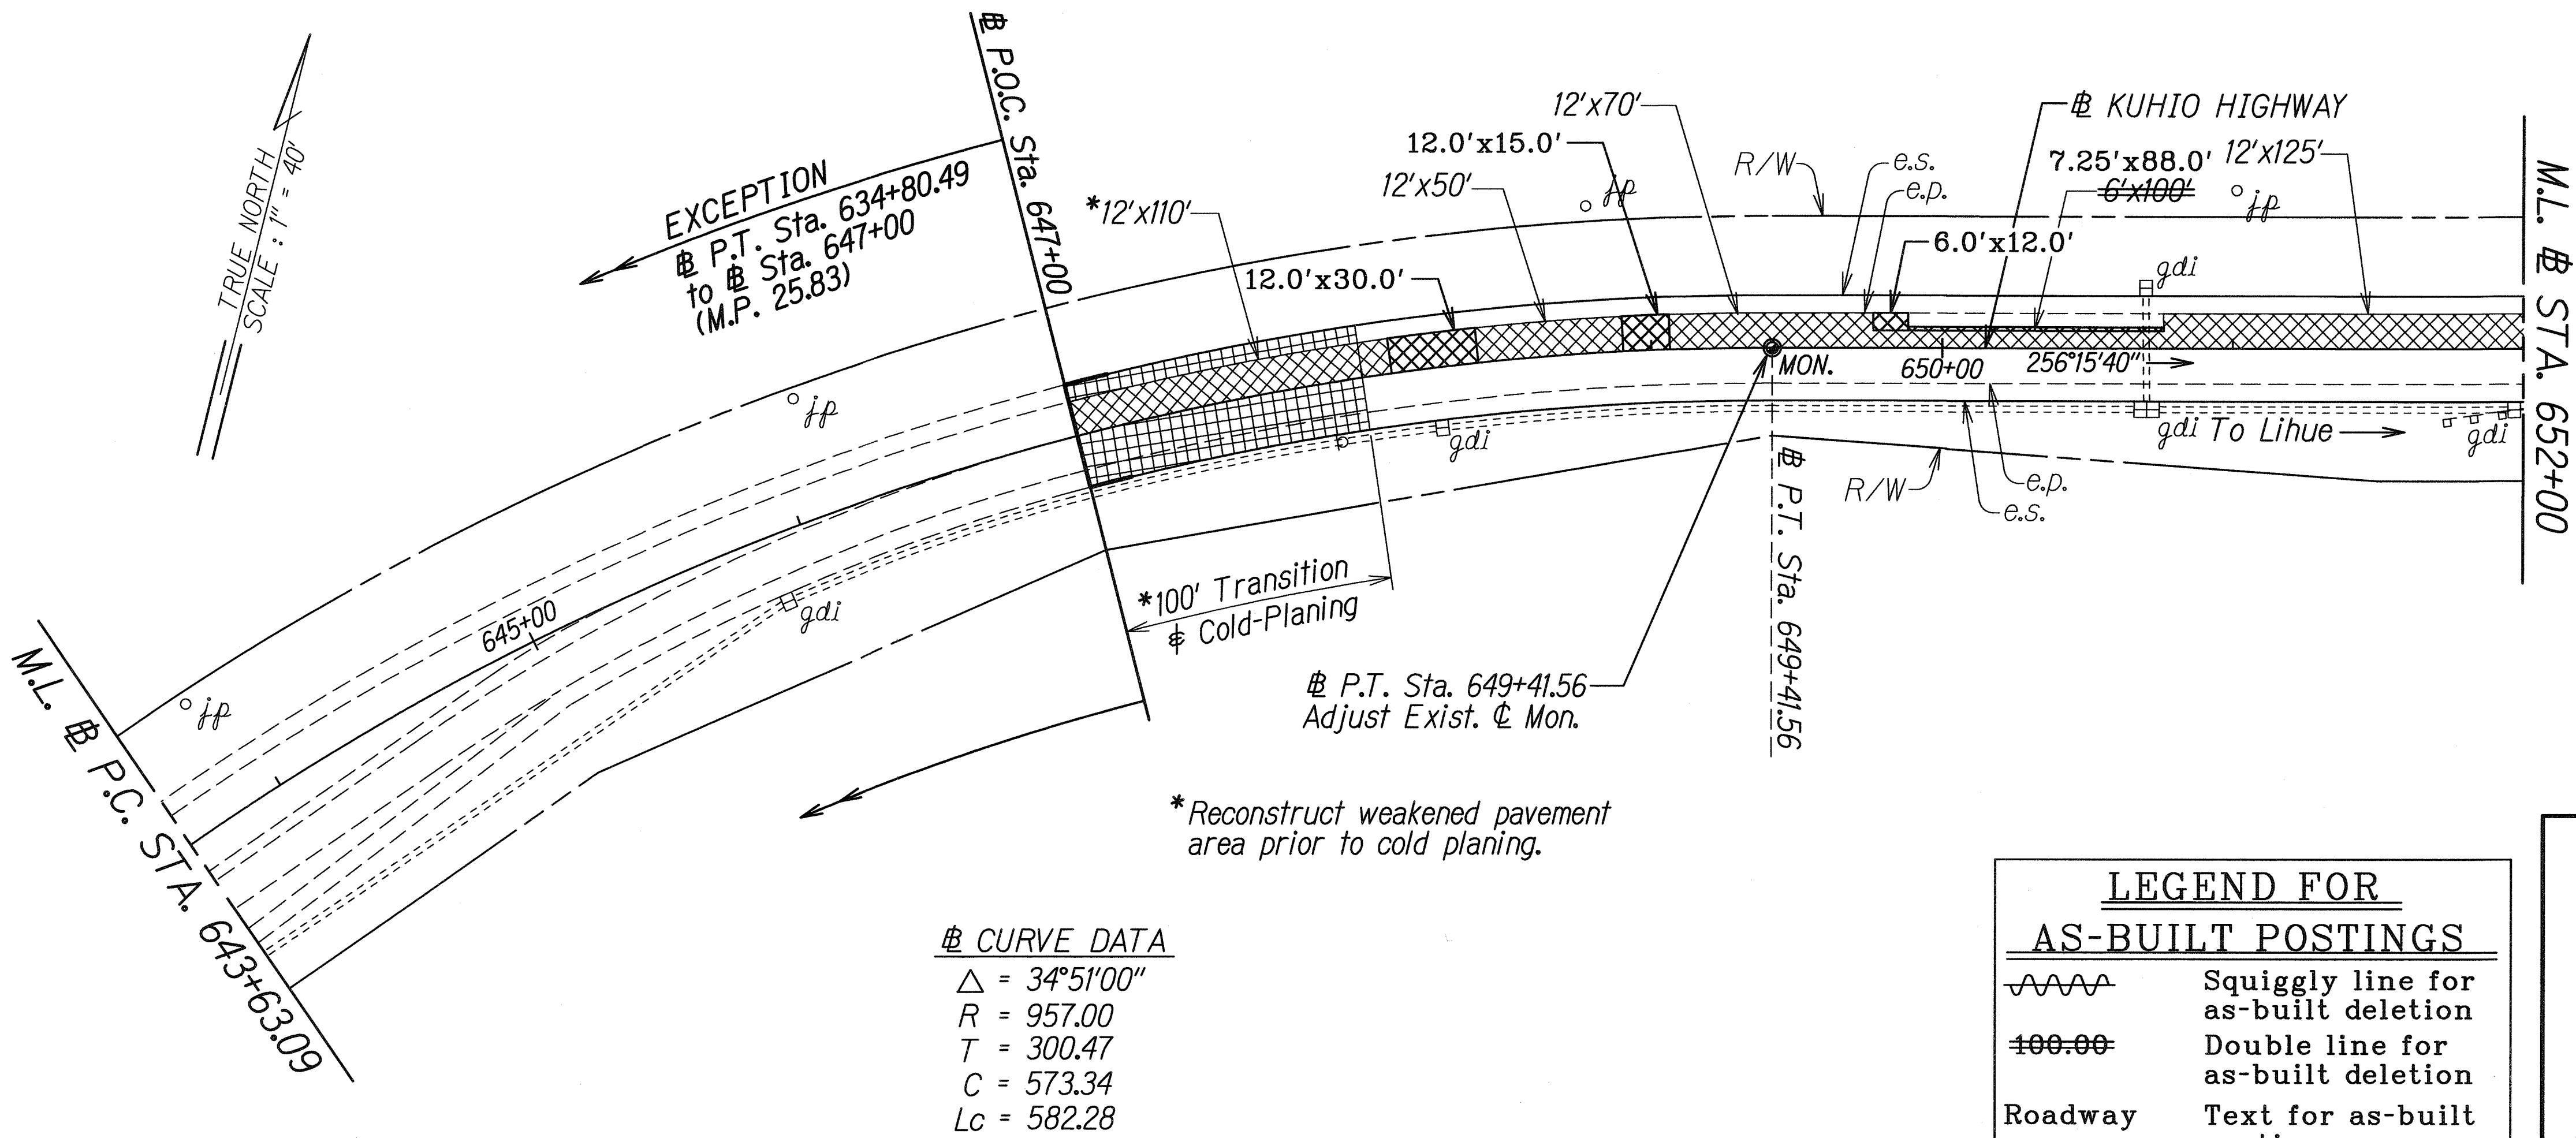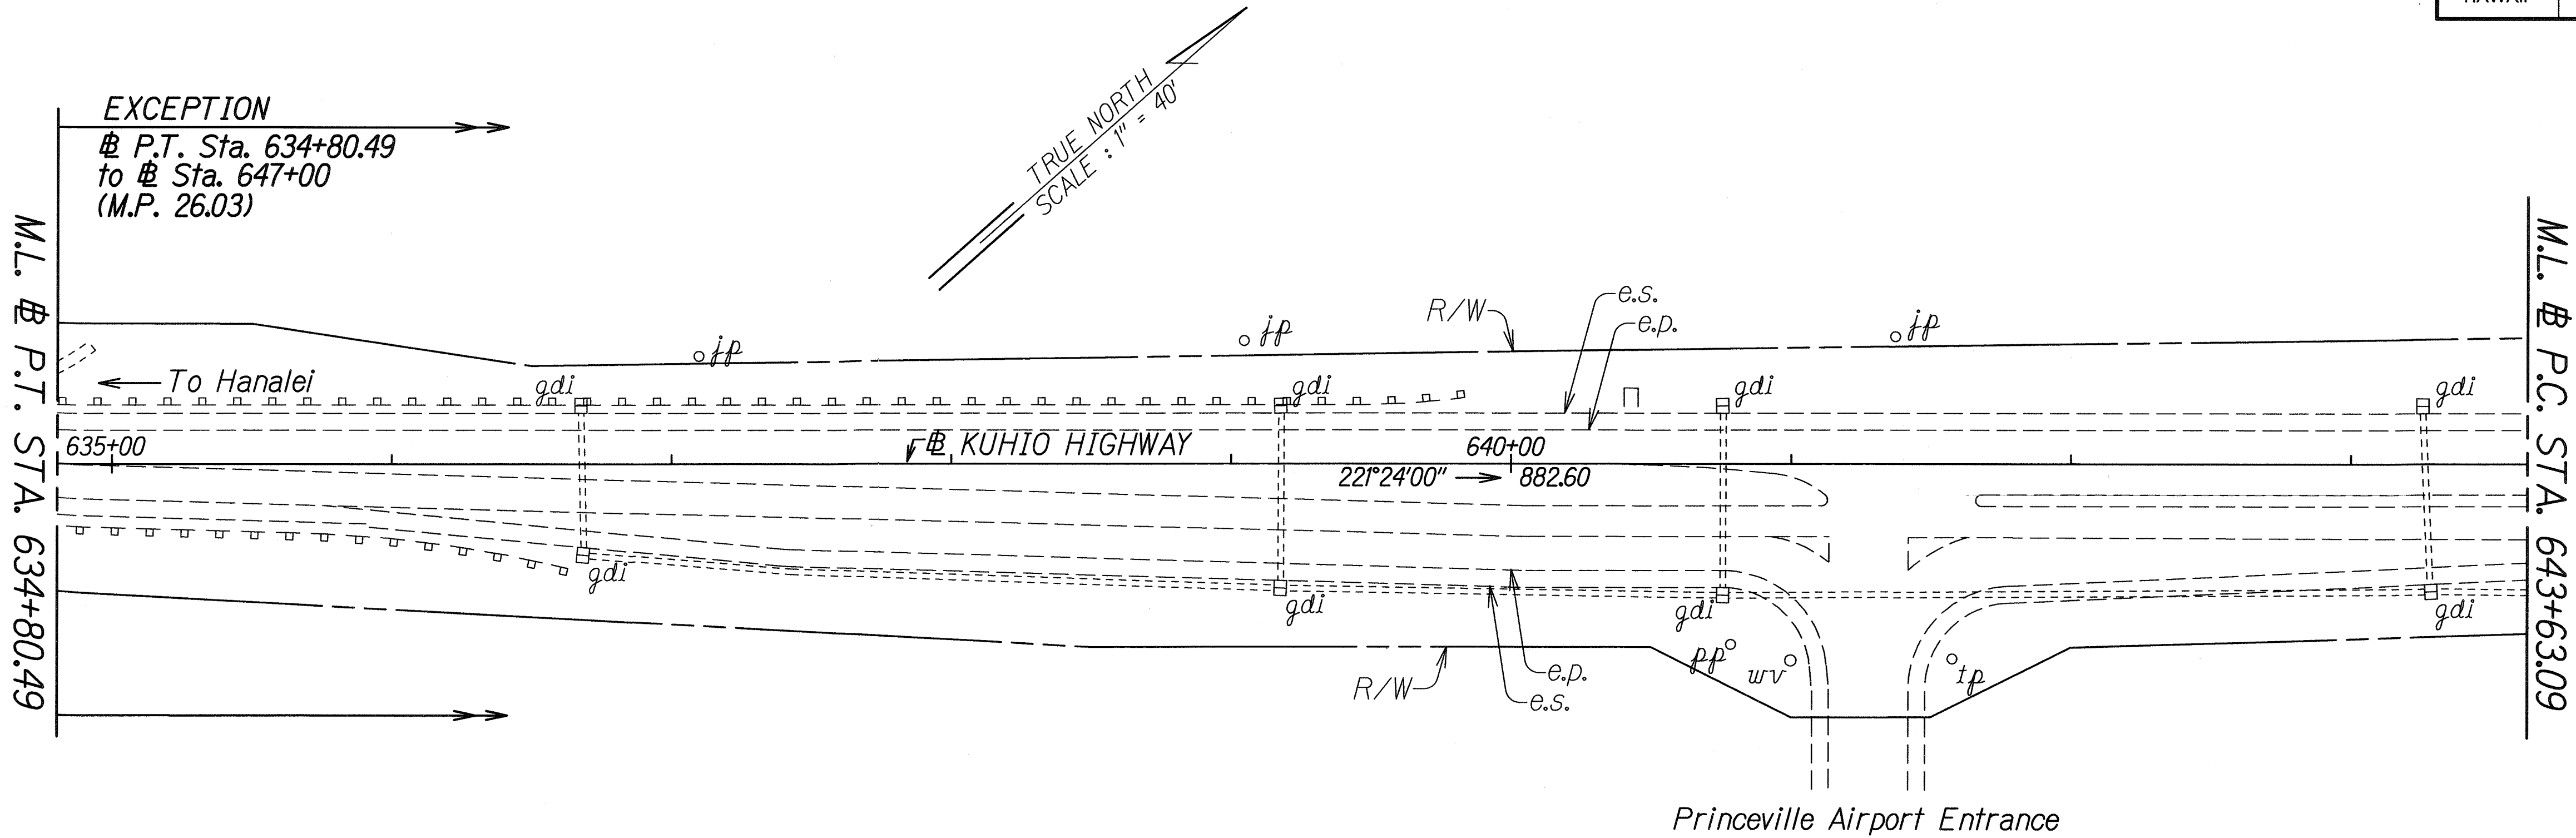

CURVE DATA
 $\Delta = 34^{\circ}51'00''$
 $R = 957.00$
 $T = 300.47$
 $C = 573.34$
 $L_c = 582.28$

LEGEND FOR AS-BUILT POSTINGS	
	Squiggly line for as-built deletion
	Double line for as-built deletion
Roadway	Text for as-built posting

STATE OF HAWAII
DEPARTMENT OF TRANSPORTATION
HIGHWAYS DIVISION


ROADWAY PLAN
KUHIO HIGHWAY RESURFACING
Anini Vista Drive to Mile Post 27.0
Project No. 56D-03-08M

Scale: 1"=40'
Date: March 2008

SHEET No. 4 OF 5 SHEETS

ORIGINAL PLAN	DATE
DESIGNED BY	12/07
TRACED BY	
QUANTITIES BY	
CHECKED BY	

FED. ROAD DIST. NO.	STATE	PROJ. NO.	FISCAL YEAR	SHEET NO.	TOTAL SHEETS
HAWAII	HAW.	56D-03-08M	2008	13	20

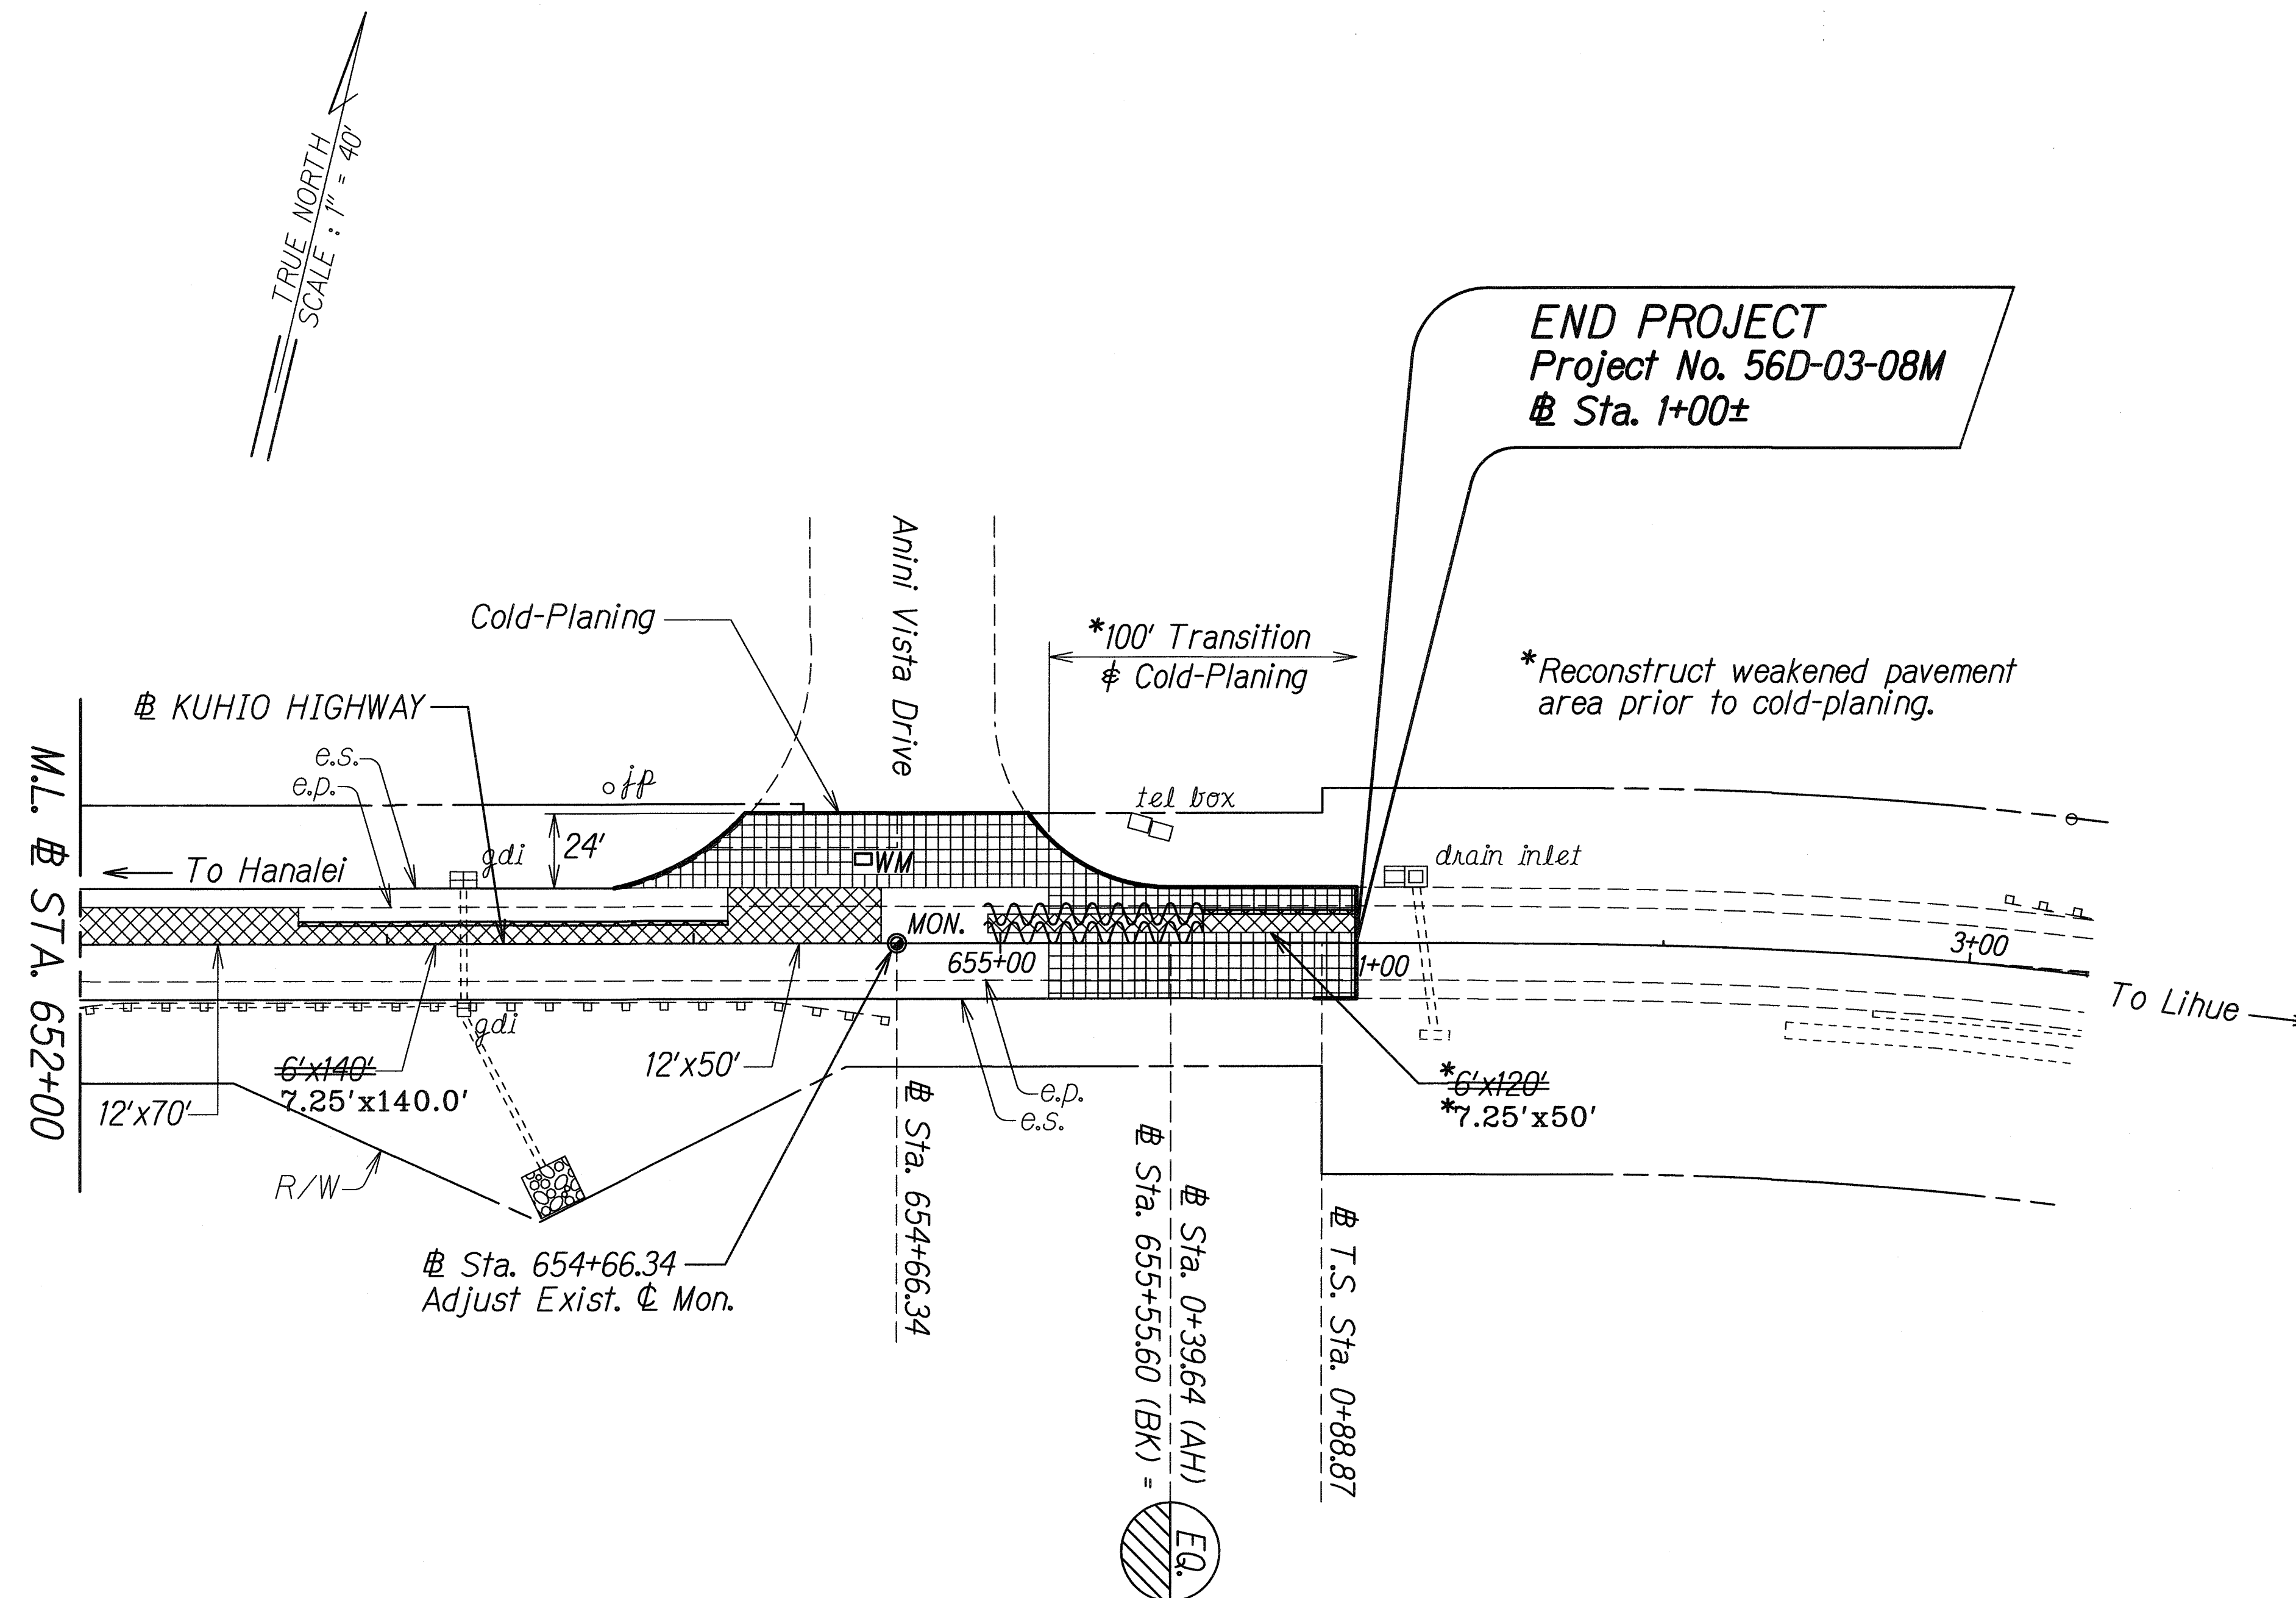

LEGEND FOR AS-BUILT POSTINGS	
	Squiggly line for as-built deletion
	Double line for as-built deletion
Roadway	Text for as-built posting

STATE OF HAWAII
DEPARTMENT OF TRANSPORTATION
HIGHWAYS DIVISION

ROADWAY PLAN

KUHIO HIGHWAY RESURFACING
Anini Vista Drive to Mile Post 27.0
Project No. 56D-03-08M

Scale: 1"=40' Date: March 2008

SHEET No. 5 OF 5 SHEETS

DATE	12/07
SURVEY PLOTTED BY	
DESIGNED BY	
TRACED BY	
NOTE BOOK	
QUANTITIES BY	
CHECKED BY	

"AS-BUILT"