


FED. ROAD DIST. NO.	STATE	PROJ. NO.	FISCAL YEAR	SHEET NO.	TOTAL SHEETS
HAWAII	HAW.	56D-01-08	2008	10	19

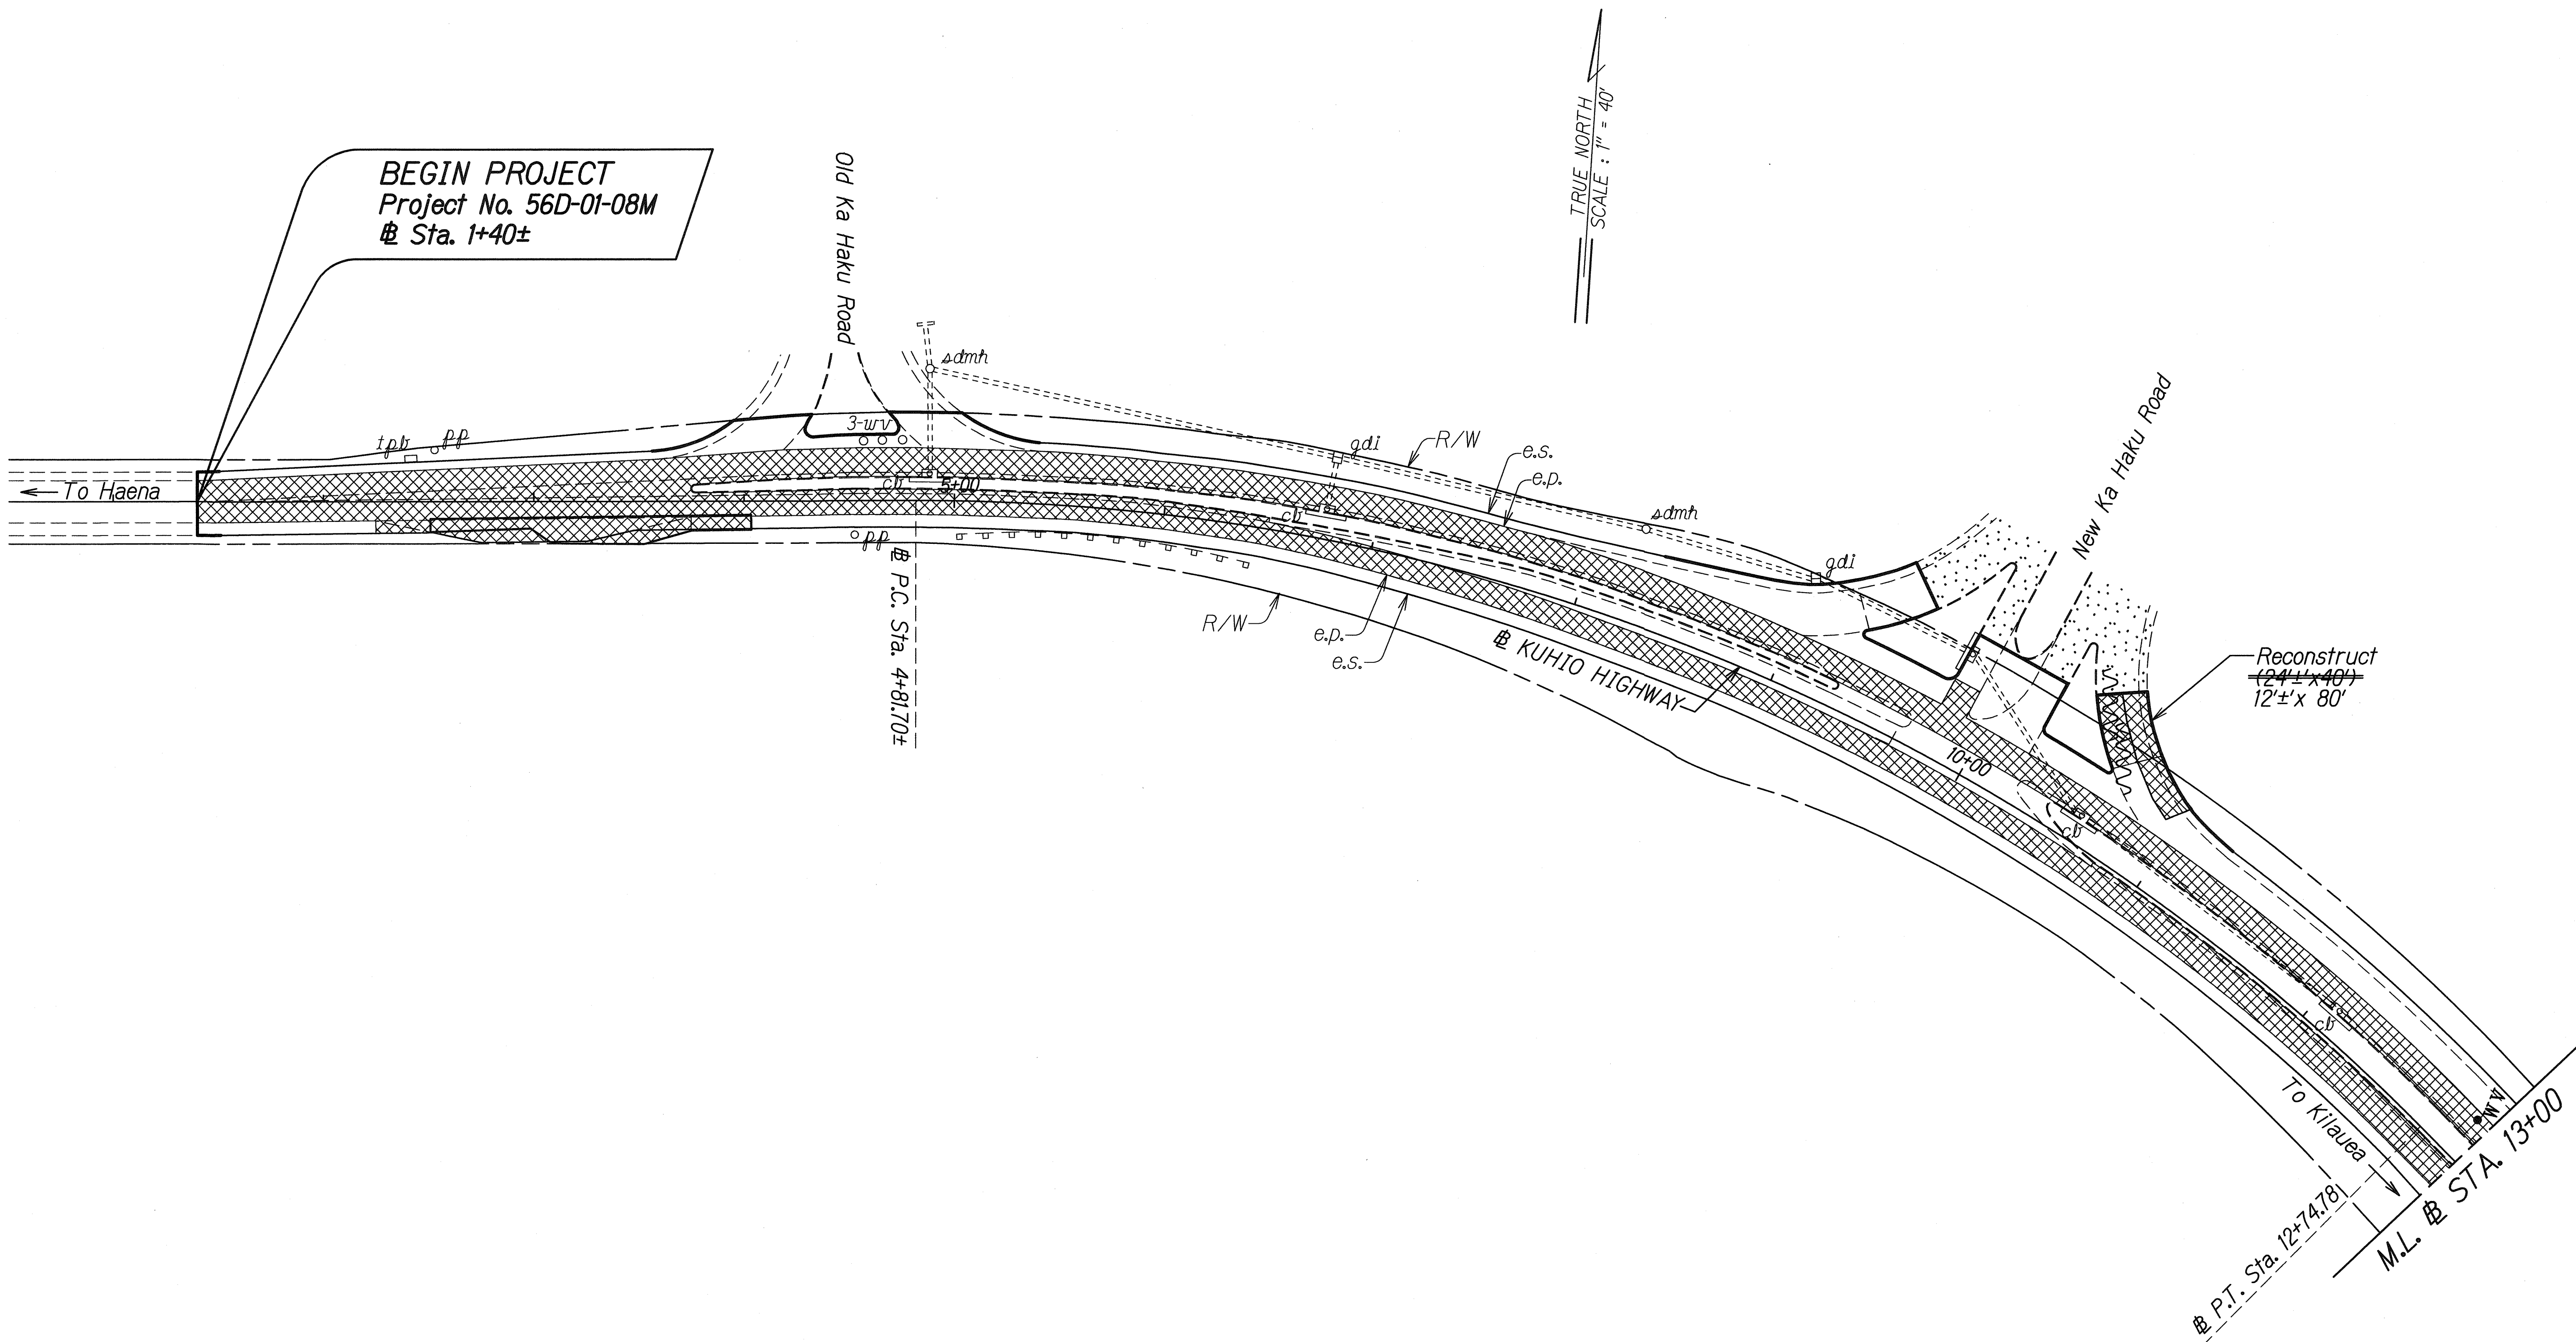

ORIGINAL PLAN	SURVEY PLOTTED BY	DATE
	DRAWN BY	10/08
	TRACED BY	
	DESIGNED BY	
NOTE BOOK	CHECKED BY	

LEGEND FOR AS-BUILT POSTINGS	
	Squiggly line for as-built deletion
	Double line for as-built deletion
Roadway	Text for as-built posting

STATE OF HAWAII
DEPARTMENT OF TRANSPORTATION
HIGHWAYS DIVISION



ROADWAY PLAN

KUHIO HIGHWAY RESURFACING
Mile Post 27.0 to Princeville
Project No. 56D-01-08M

Scale: 1" = 40'
Date: April 2008

SHEET No. 1 OF 4 SHEETS

FED. ROAD DIST. NO.	STATE	PROJ. NO.	FISCAL YEAR	SHEET NO.	TOTAL SHEETS
HAWAII	HAW.	56D-01-08	2008	11	19

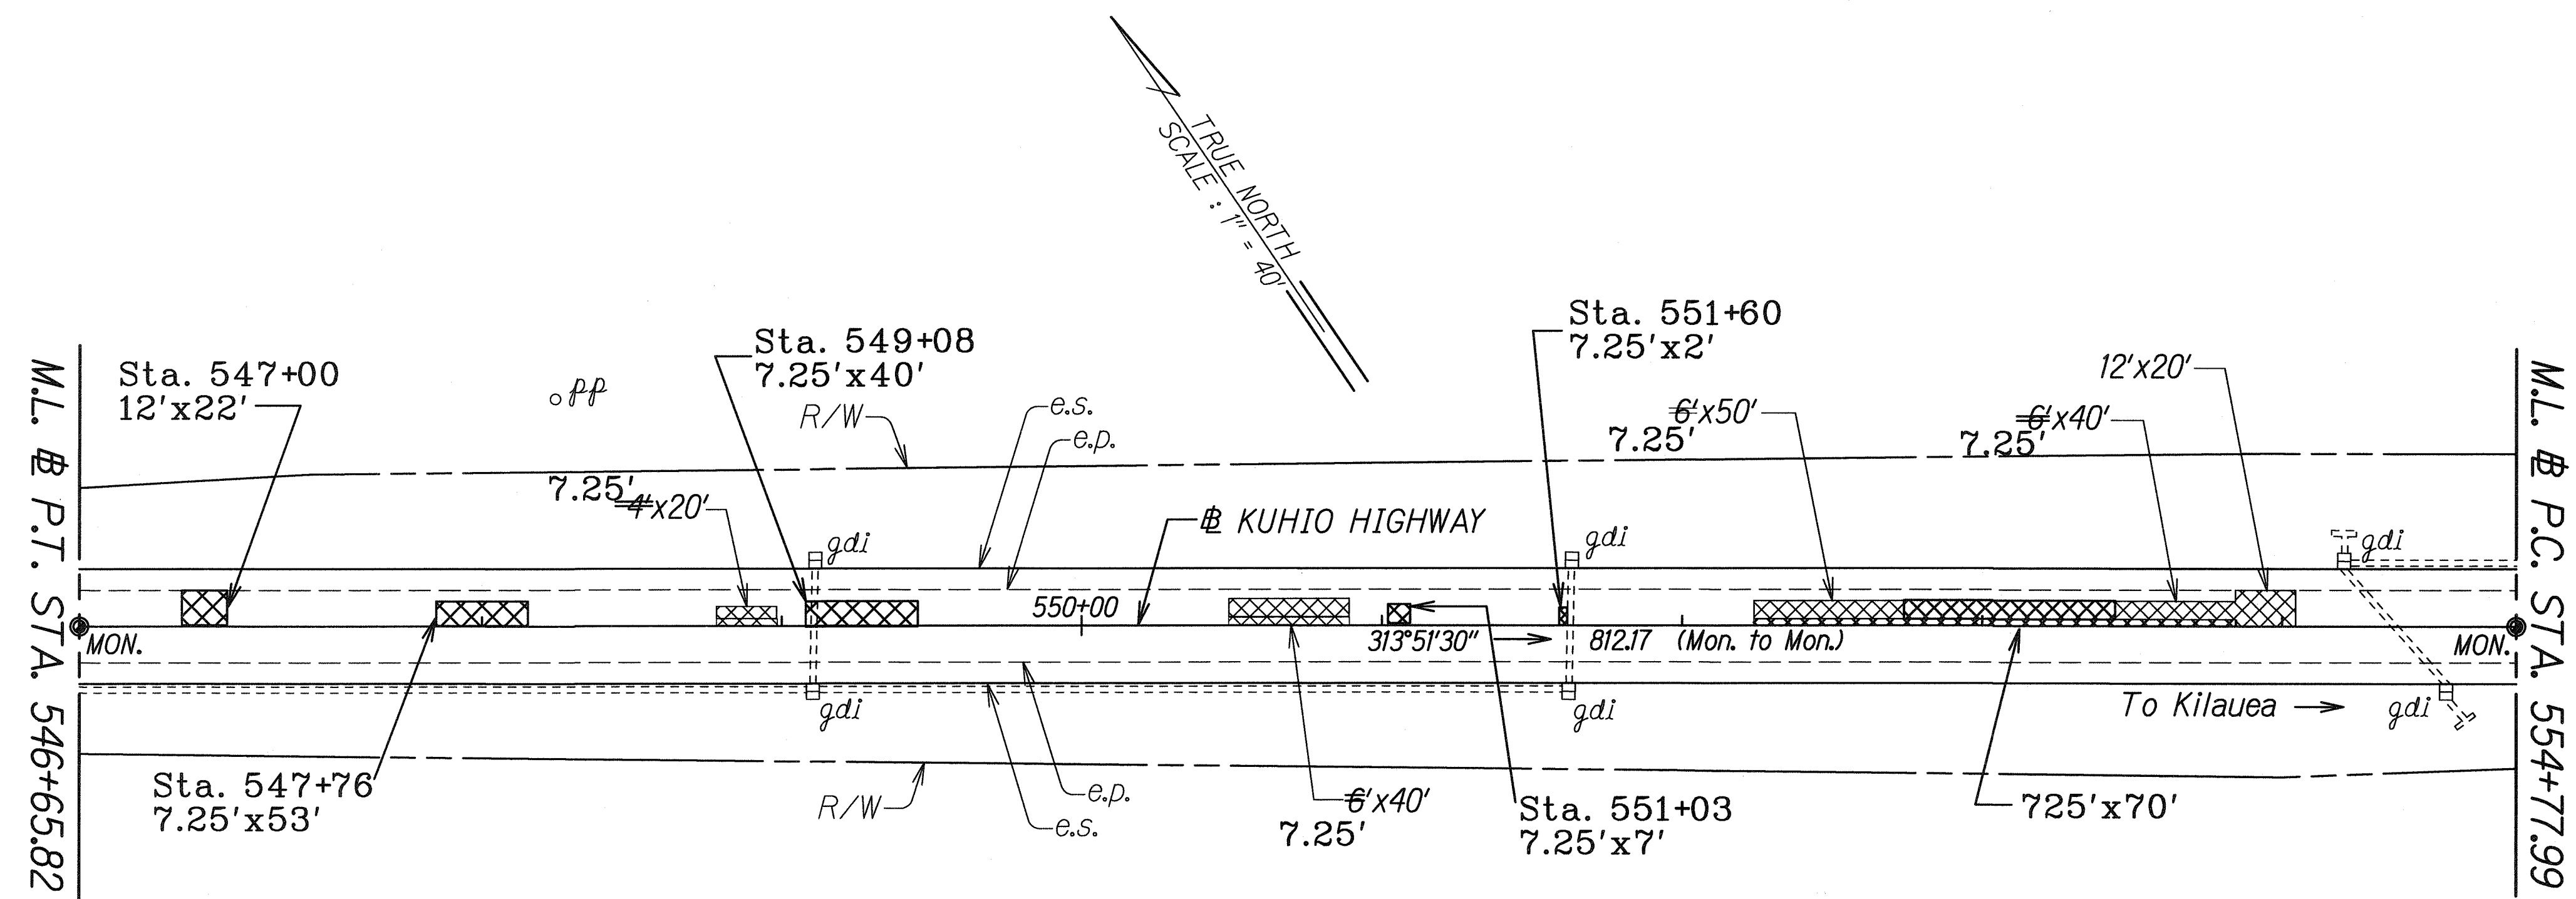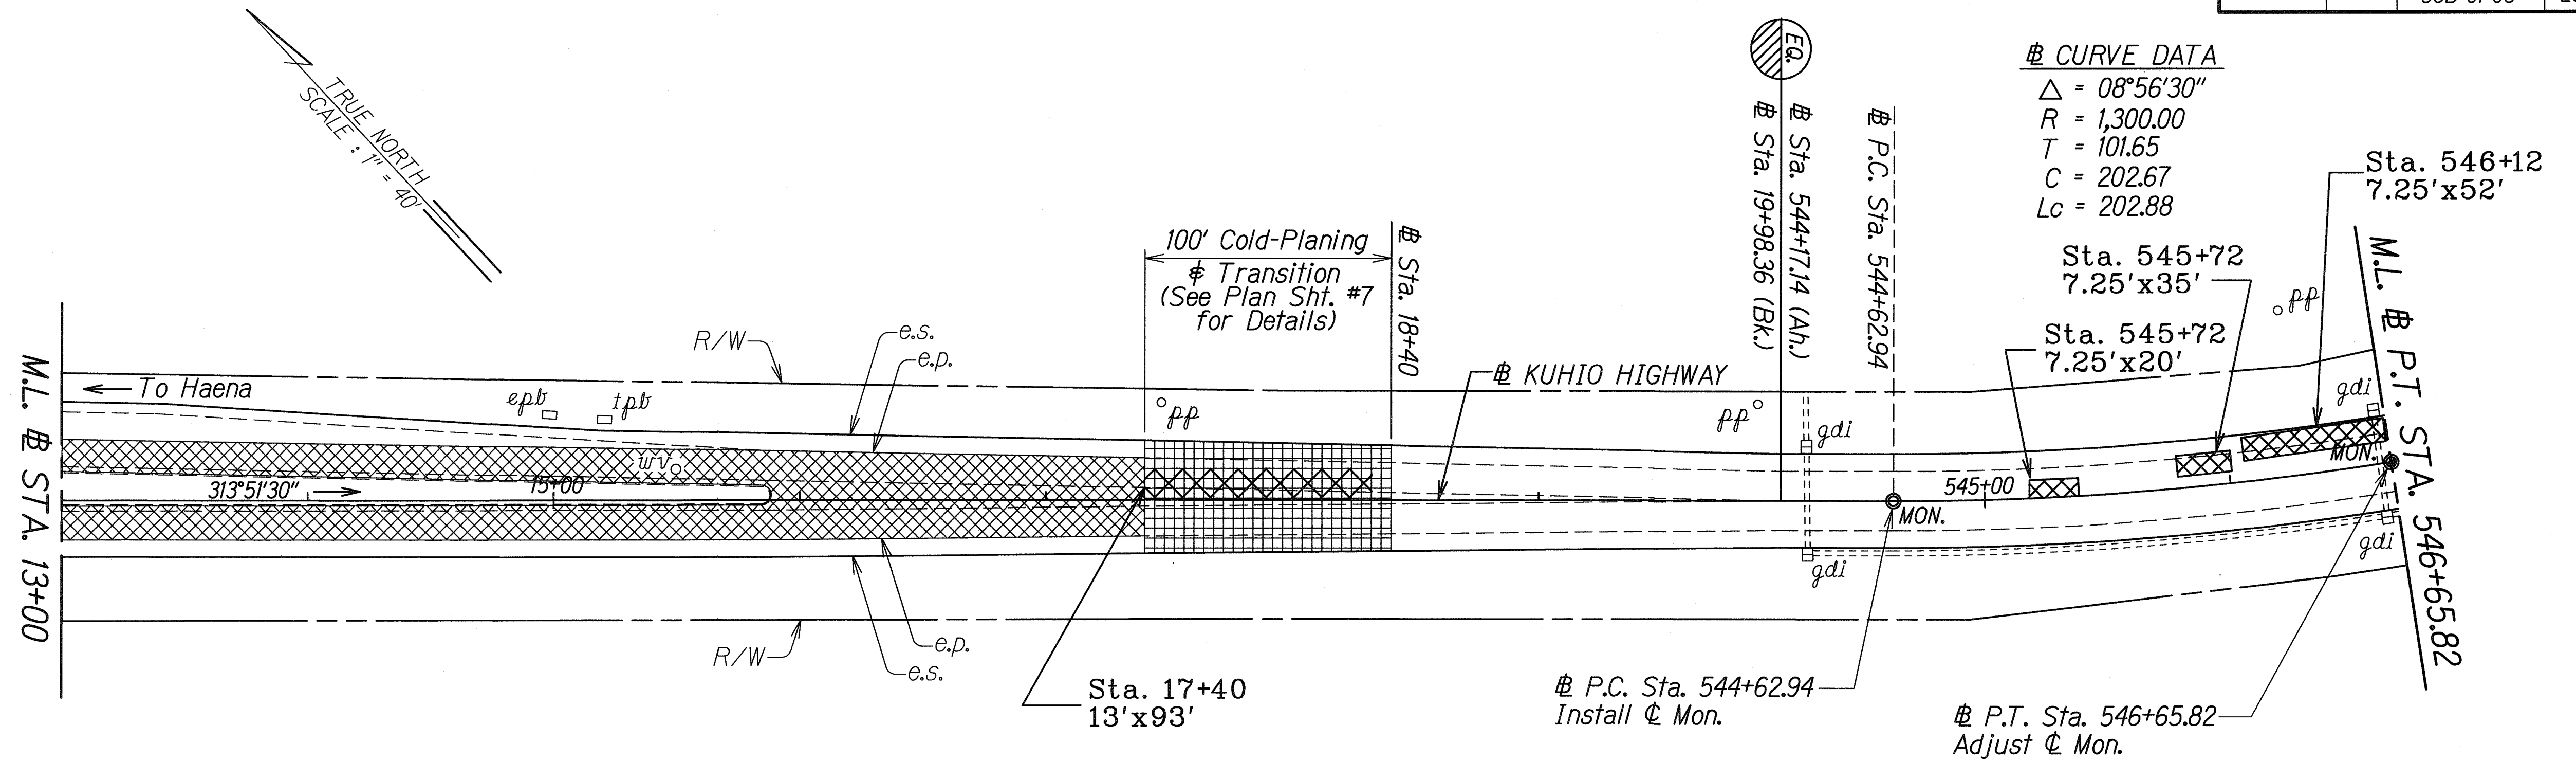

DATE	10/03/08
DESIGNED BY	...
DRAWN BY	...
CHECKED BY	...
NOTED BY	...
ORIGINAL PLAN	...

LEGEND FOR AS-BUILT POSTINGS	
	Squiggly line for as-built deletion
	Double line for as-built deletion
Roadway	Text for as-built posting

STATE OF HAWAII
DEPARTMENT OF TRANSPORTATION
HIGHWAYS DIVISION


ROADWAY PLAN

KUHIO HIGHWAY RESURFACING
Mile Post 27.0 to Princeville
Project No. 56D-01-08M

Scale: 1" = 40' Date: April 2008

SHEET No. 2 OF 4 SHEETS

FED. ROAD DIST. NO.	STATE	PROJ. NO.	FISCAL YEAR	SHEET NO.	TOTAL SHEETS
HAWAII	HAW.	56D-01-08	2008	13	19

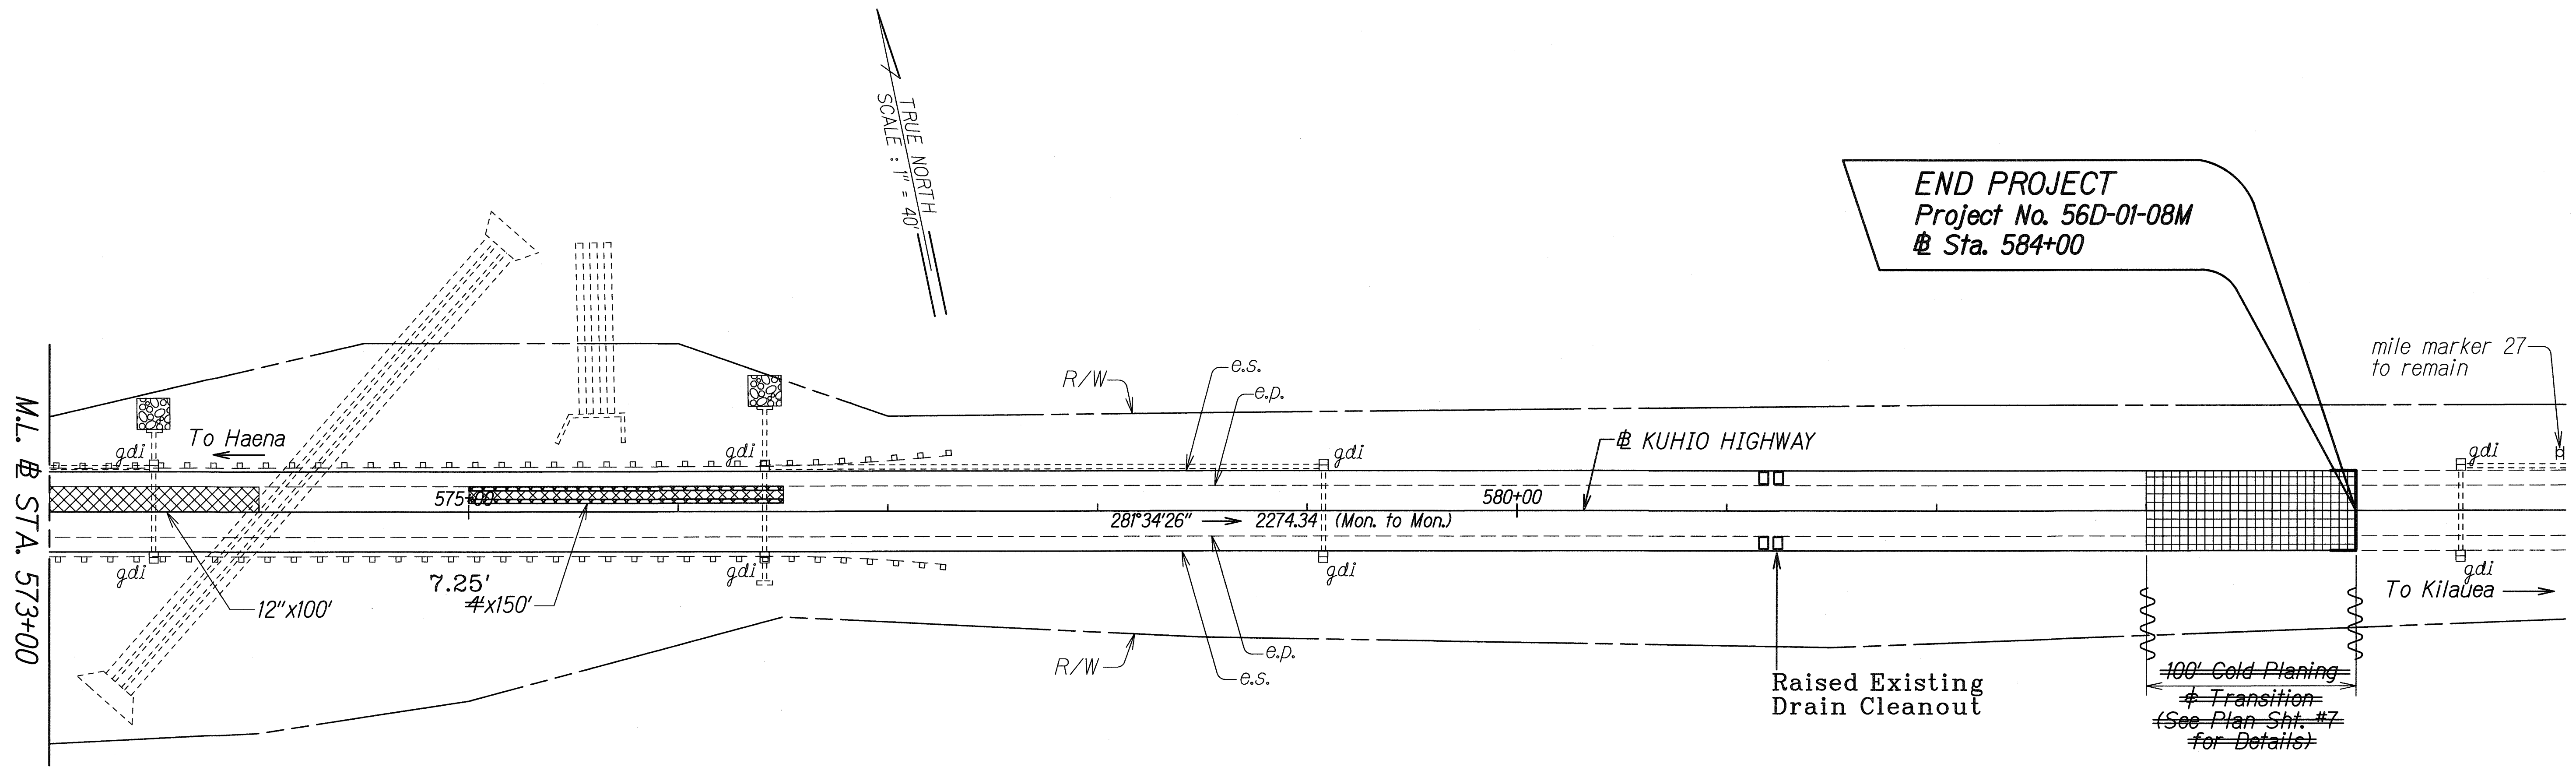

END PROJECT
Project No. 56D-01-08M
@ Sta. 584+00

ORIGINAL PLAN	SURVEY PLOTTED BY	DATE
NOTED WORK	DRAWN BY	10/08
NOTED WORK	DESIGNED BY	
NOTED WORK	CHECKED BY	

LEGEND FOR AS-BUILT POSTINGS	
	Squiggly line for as-built deletion
	Double line for as-built deletion
Roadway	Text for as-built posting

STATE OF HAWAII
DEPARTMENT OF TRANSPORTATION
HIGHWAYS DIVISION

ROADWAY PLAN

KUHIO HIGHWAY RESURFACING
Mile Post 27.0 to Princeville
Project No. 56D-01-08M

Scale: 1" = 40' Date: April 2008

SHEET No. 4 OF 4 SHEETS

"AS-BUILT"