

INDEX TO DRAWINGS	
SHEET NO.	DESCRIPTION
1	TITLE SHEET
2	STANDARD PLANS SUMMARY
3	GENERAL NOTES AND LEGEND
4 – 5	WATER POLLUTION AND EROSION CONTROL NOTES
6 – 9	TYPICAL SECTIONS
10 – 13	ROADWAY PLAN
14	PAVEMENT MARKING LEGEND, DETAILS AND NOTES
15 – 18	PAVEMENT MARKING AND TRAFFIC SIGNING PLAN
19	LOW SPEED UNDIVIDED HIGHWAY WORK ZONE SIGNING PLAN, NOTES AND DETAILS

STATE OF HAWAII

DEPARTMENT OF TRANSPORTATION

HIGHWAYS DIVISION

HONOLULU, HAWAII

"AS-BUILT"

PLANS FOR


KUHIO HIGHWAY RESURFACING

MILE POST 27.0 TO PRINCEVILLE


PROJECT NO. 56D-01-08M

DISTRICT OF HANAIEI
ISLAND OF KAUAI

FED. ROAD DIST. NO.	STATE	PROJ. NO.	FISCAL YEAR	SHEET NO.	TOTAL SHEETS
HAWAII	HAW.	56D-01-08M	2008	1	19

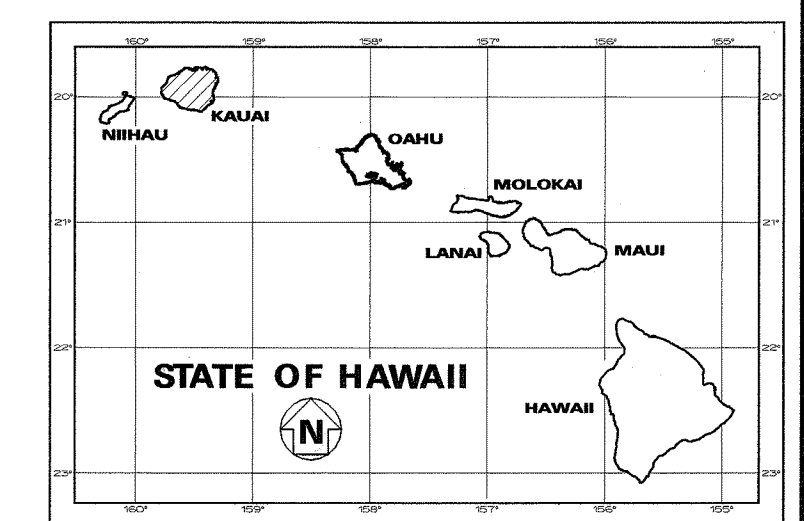

PROJECT LOCATION

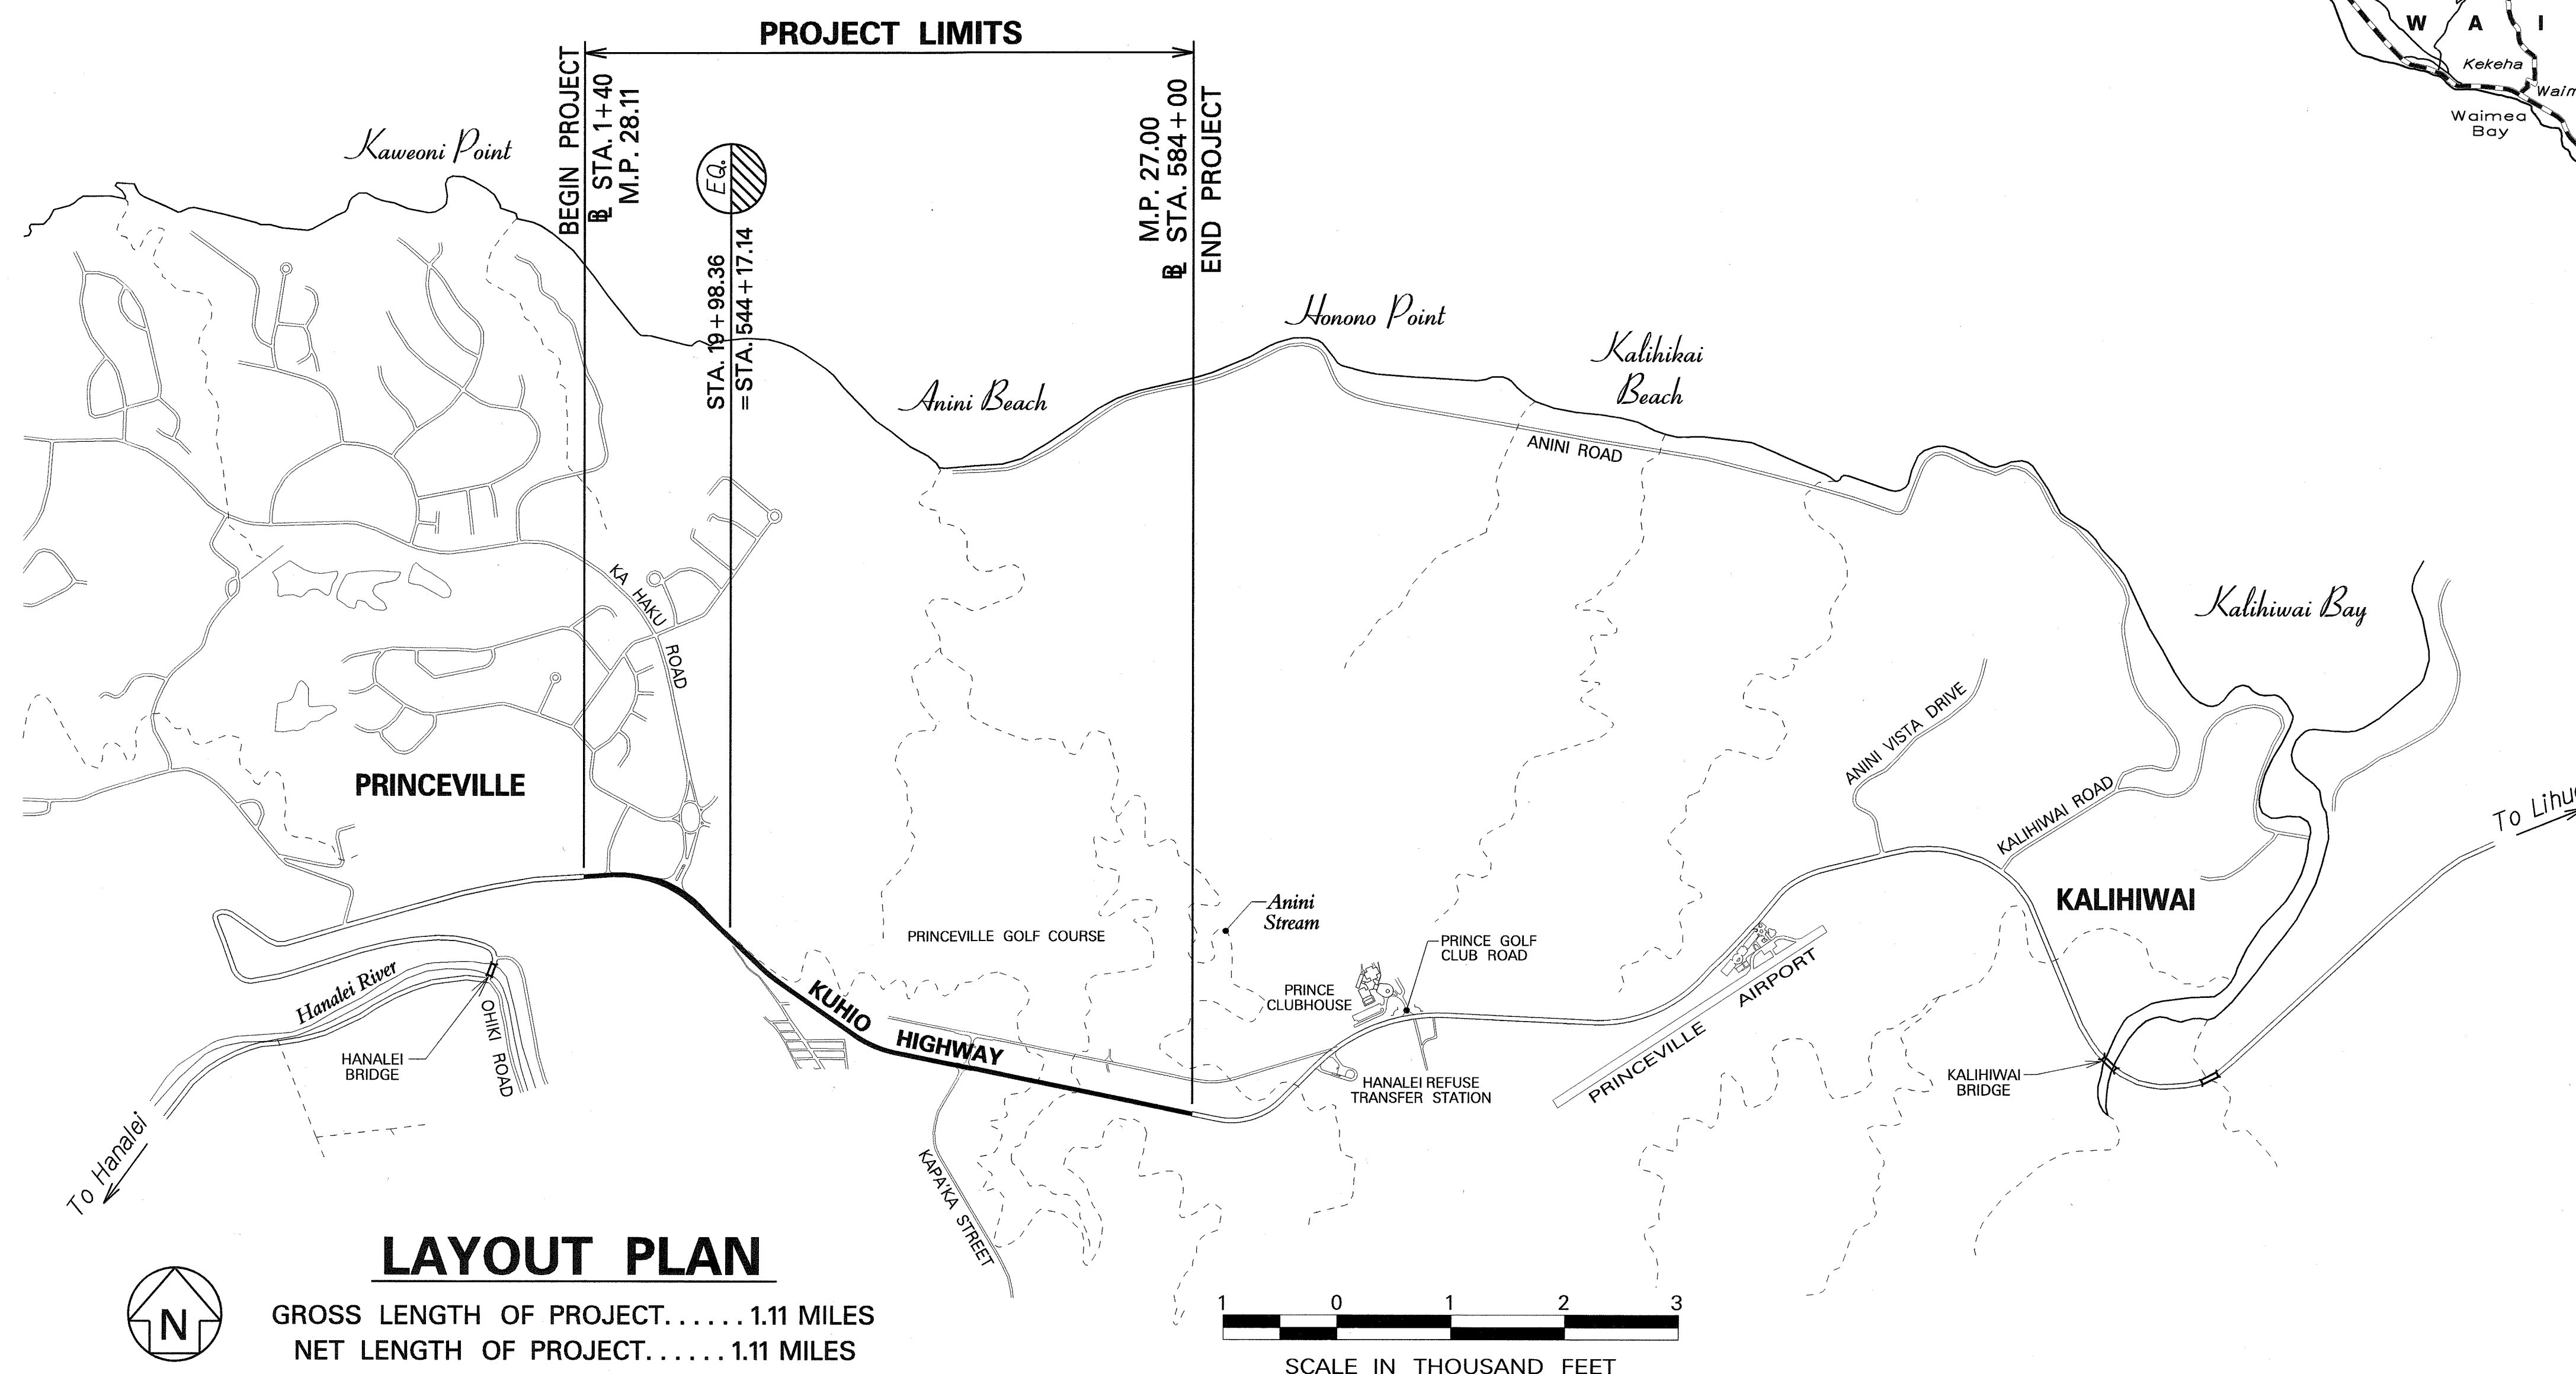

**FEDERAL AID PROJECTS PREVIOUSLY
CONSTRUCTED OR UNDER CONSTRUCTION**

MILE POST 27.00 TO MILE POST 28.11

CHANGES MADE DURING CONSTRUCTION HAVE BEEN INCORPORATED ON THESE PLANS EXCEPT CHANGES IN THE ORIGINAL THEORETICAL QUANTITIES. FOR ACTUAL QUANTITIES, REFER TO PROJECT LOGS AND/OR CONSTRUCTION BOOK.

[Handwritten signature] 8/31/10

DEPARTMENT OF TRANSPORTATION
STATE OF HAWAII

APPROVED:

for [Signature] 3-31-08
DIR. OF TRANSPORTATION DATE