

TRUE NORTH
SCALE: 1" = 40'

BEGIN PROJECT
 Sta. 544+17.14 (Ahead)
END PROJECT
 Sta. 19+98.36 (Back)
 1918.31 N, 1448.72 W

10 ft. wide water pipeline easement

To Princeville

313°51'30.00"

588.39'

tp#119

Top of Cut

545+00

Curve No. 18 Data

Δ	= 08°56'30"
R	= 1,300.00'
T	= 101.65'
C	= 202.67'
L	= 202.88'

P.C. Sta. 544+62.94
R = 1,300.00'

P.T. Sta. 546+65.82

Toe of Fill

20"

1133.25'

304°55'00.00"

tp#117

Top

R/W

exist. sign

backflow preventer

10' pipe

pp

tp°

exist. r/w


Road

ww


coordinates are referred to mean sea level datum.

will be removed or relocated except where noted.


1. Azimuths and coordinates are referred to "Pooku" Δ
2. Bench marks are referred to mean sea level datum.
3. Utility Poles will be removed or relocated by others except where noted.

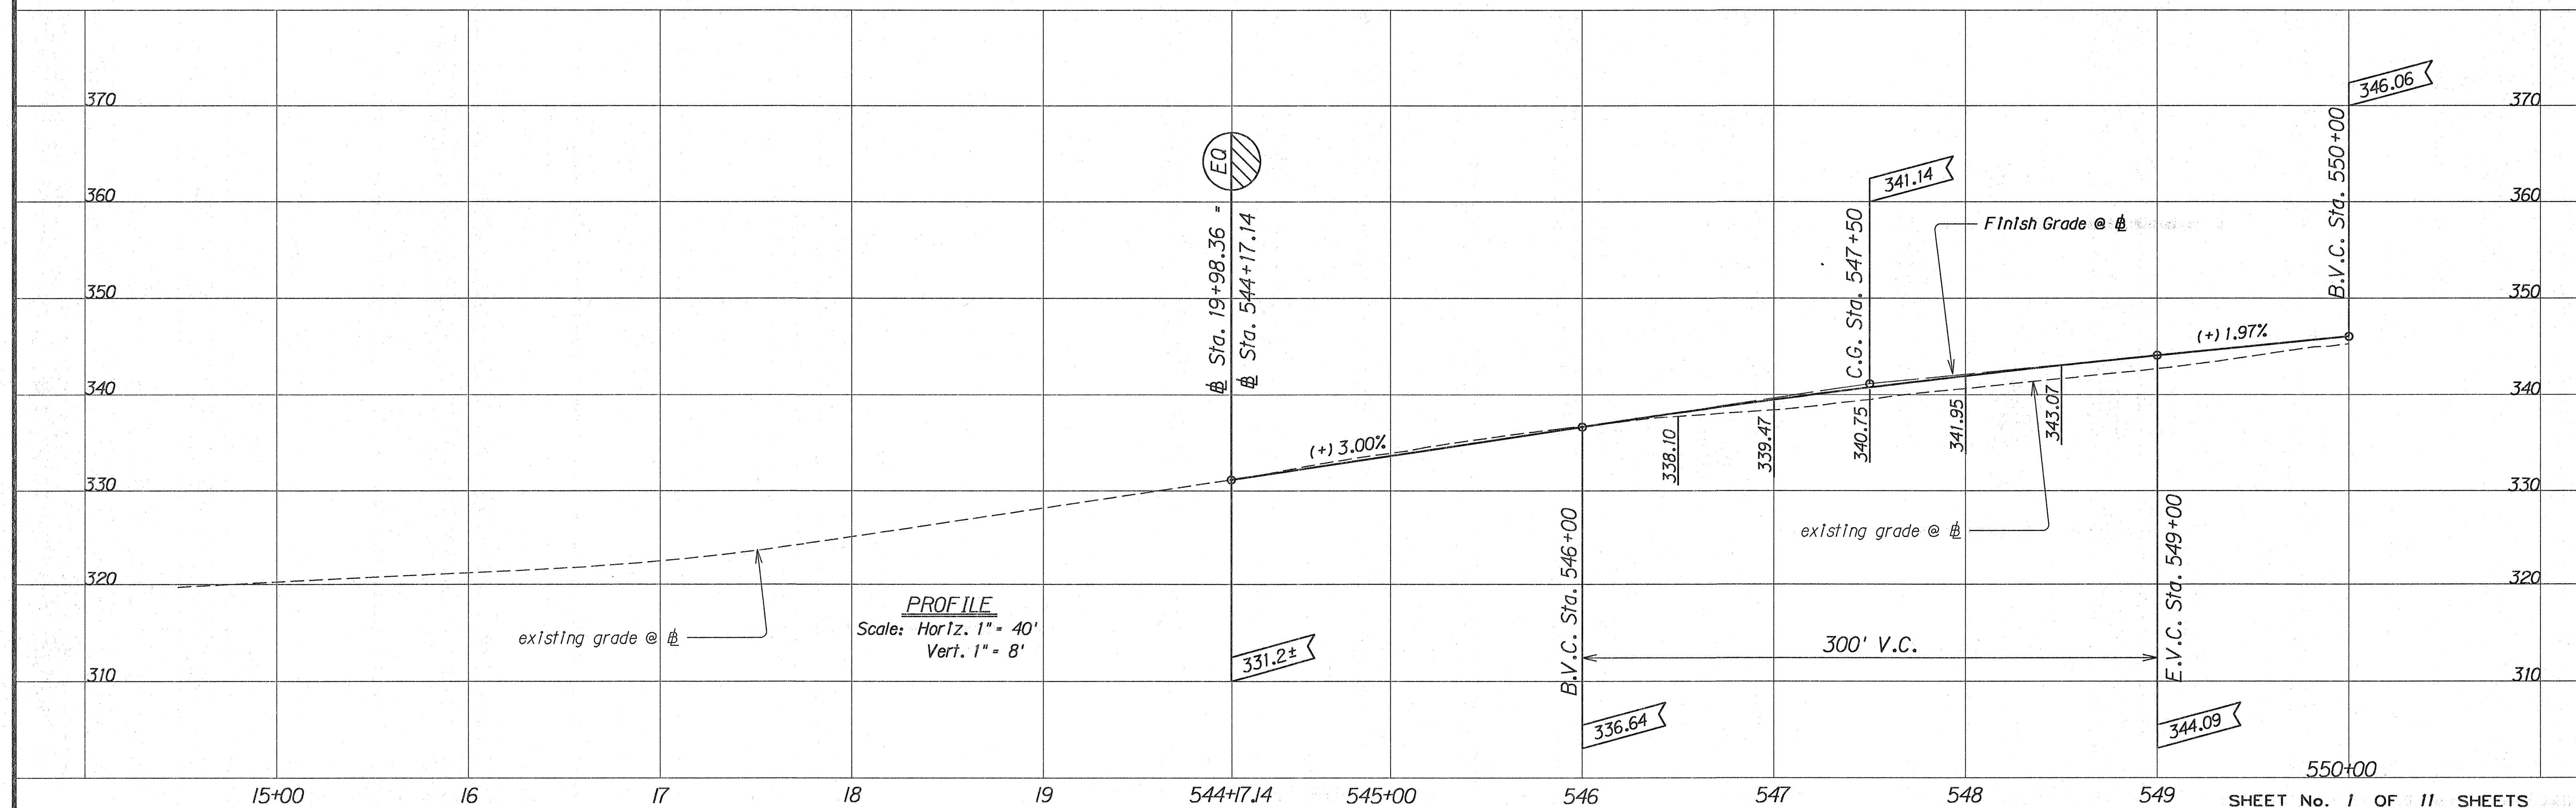

FED. ROAD DIST. NO.	STATE	FED. AID PROJ. NO.	FISCAL YEAR	SHEET NO.	TOTAL SHEETS
HAWAII	HAW.	F-056-1(31)	1991	8	126

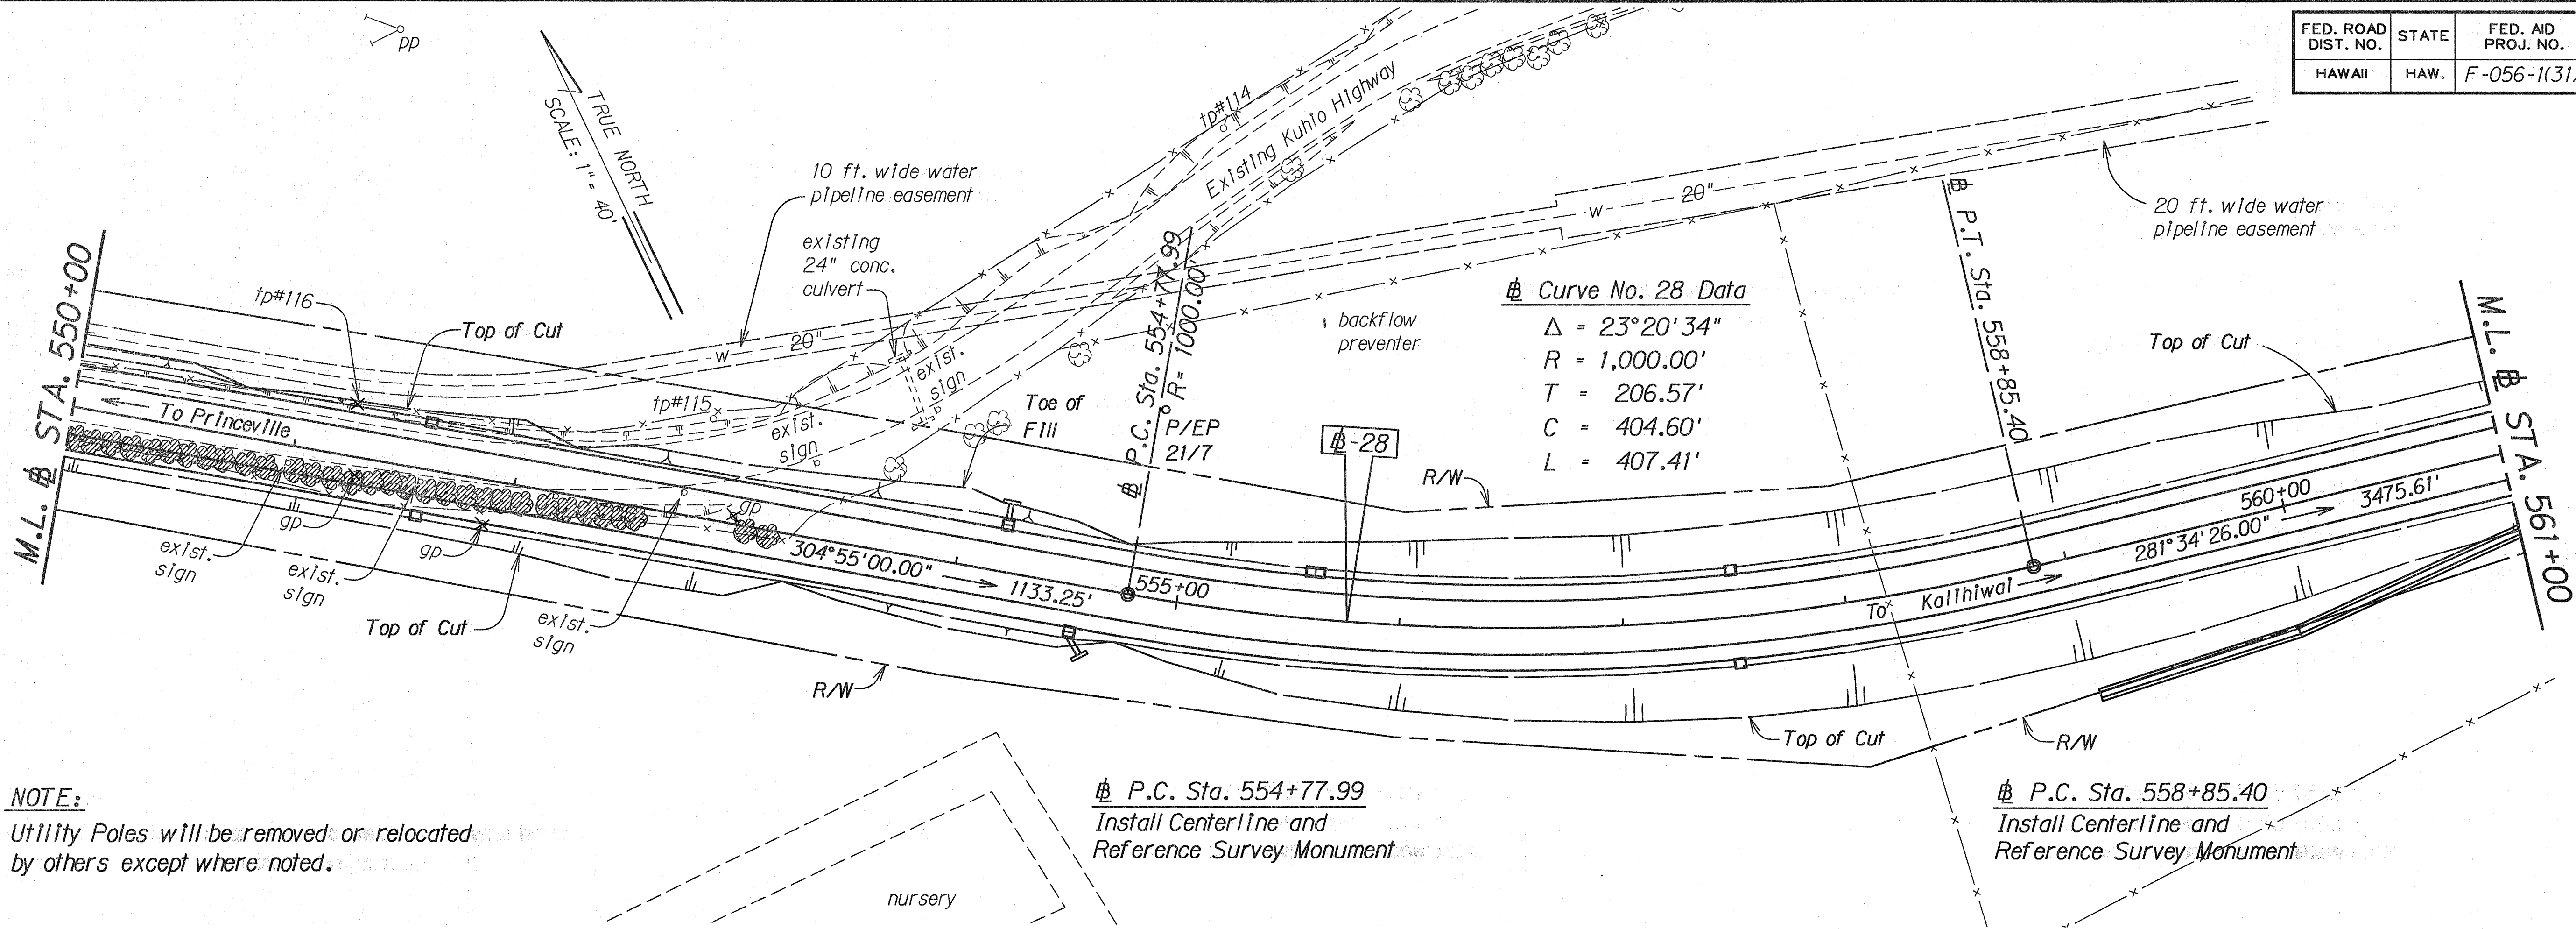


ORIGINAL PLAN	SURVEY PLOTTED BY	DATE
NOTE BOOK	DRAWN BY	
	DESIGNED BY	
	QUANTITIES BY	
	CHECKED BY	

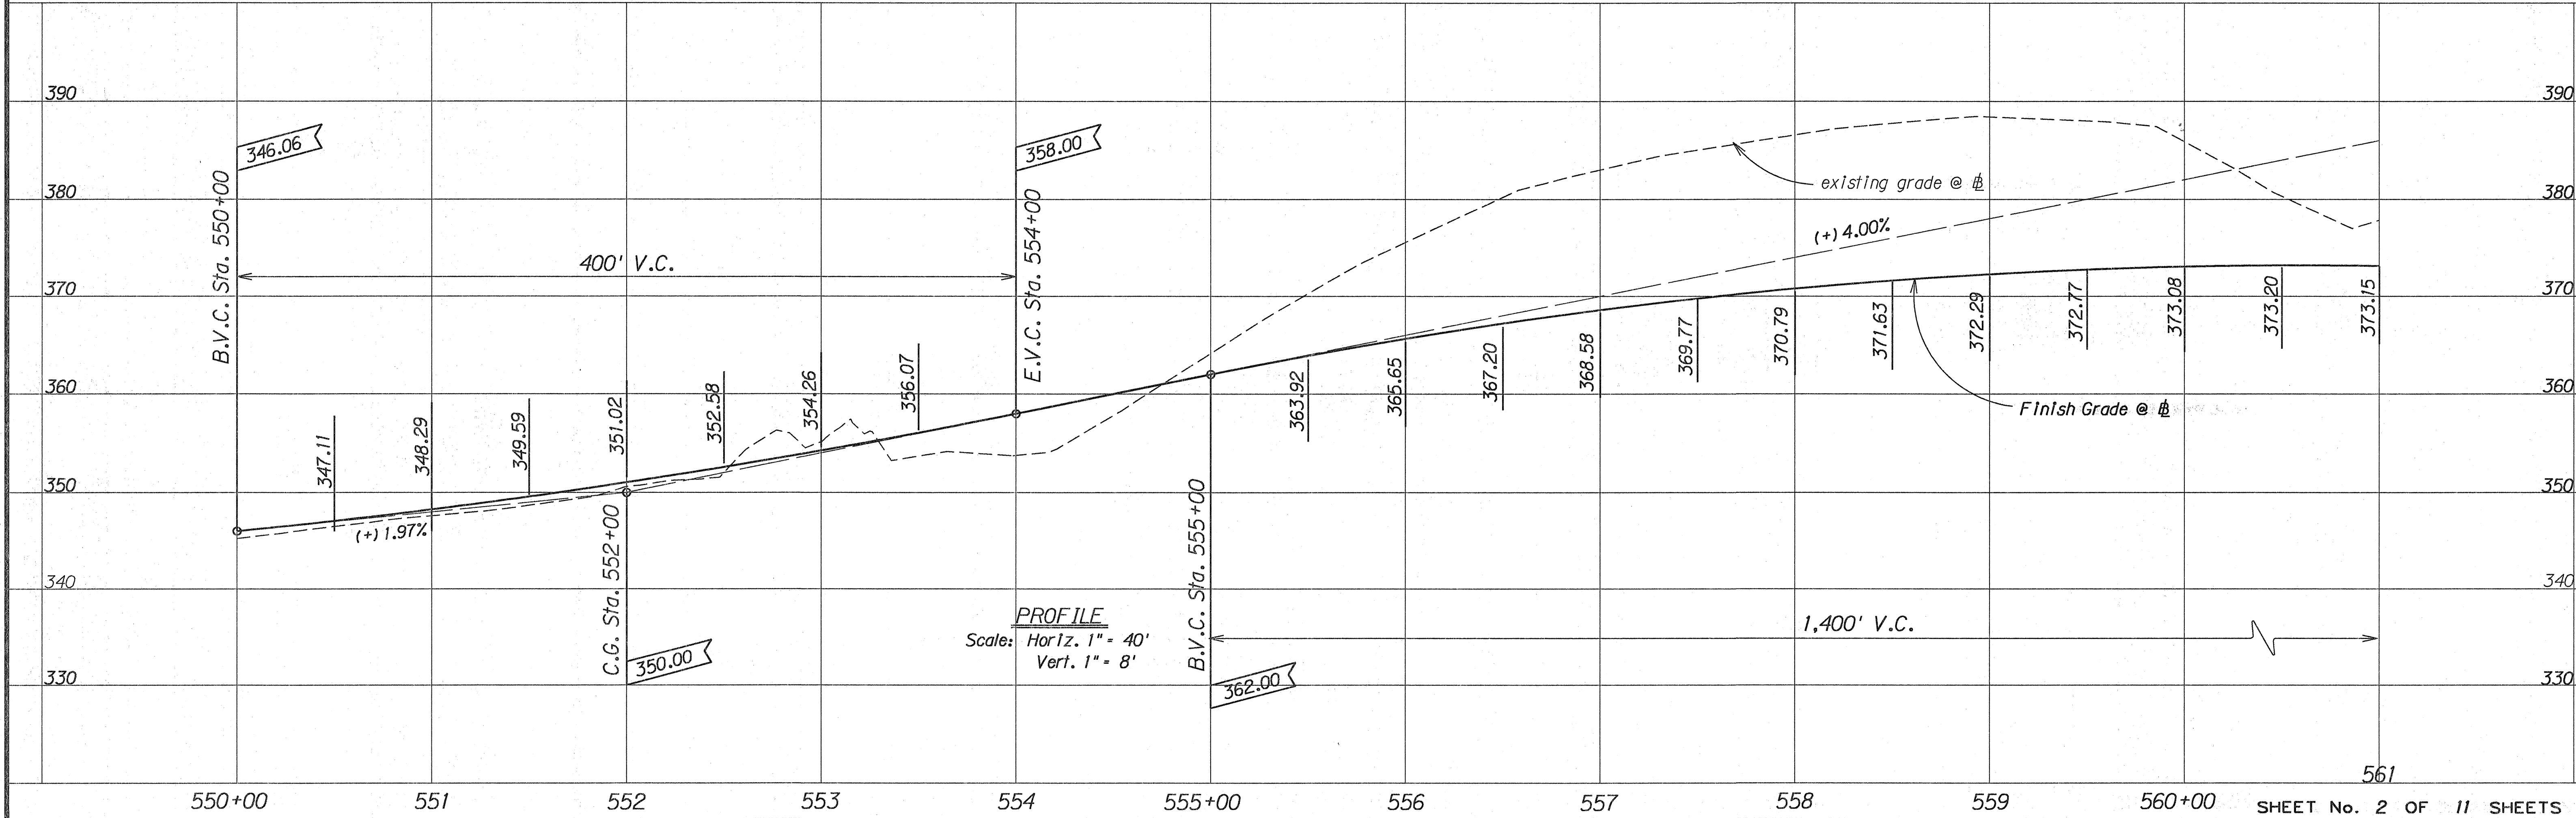

FED. ROAD DIST. NO.	STATE	FED. AID PROJ. NO.	FISCAL YEAR	SHEET NO.	TOTAL SHEETS
HAWAII	HAW.	F-056-1(31)	1991	9	126

TRUE NORTH
SCALE: 1" = 40'

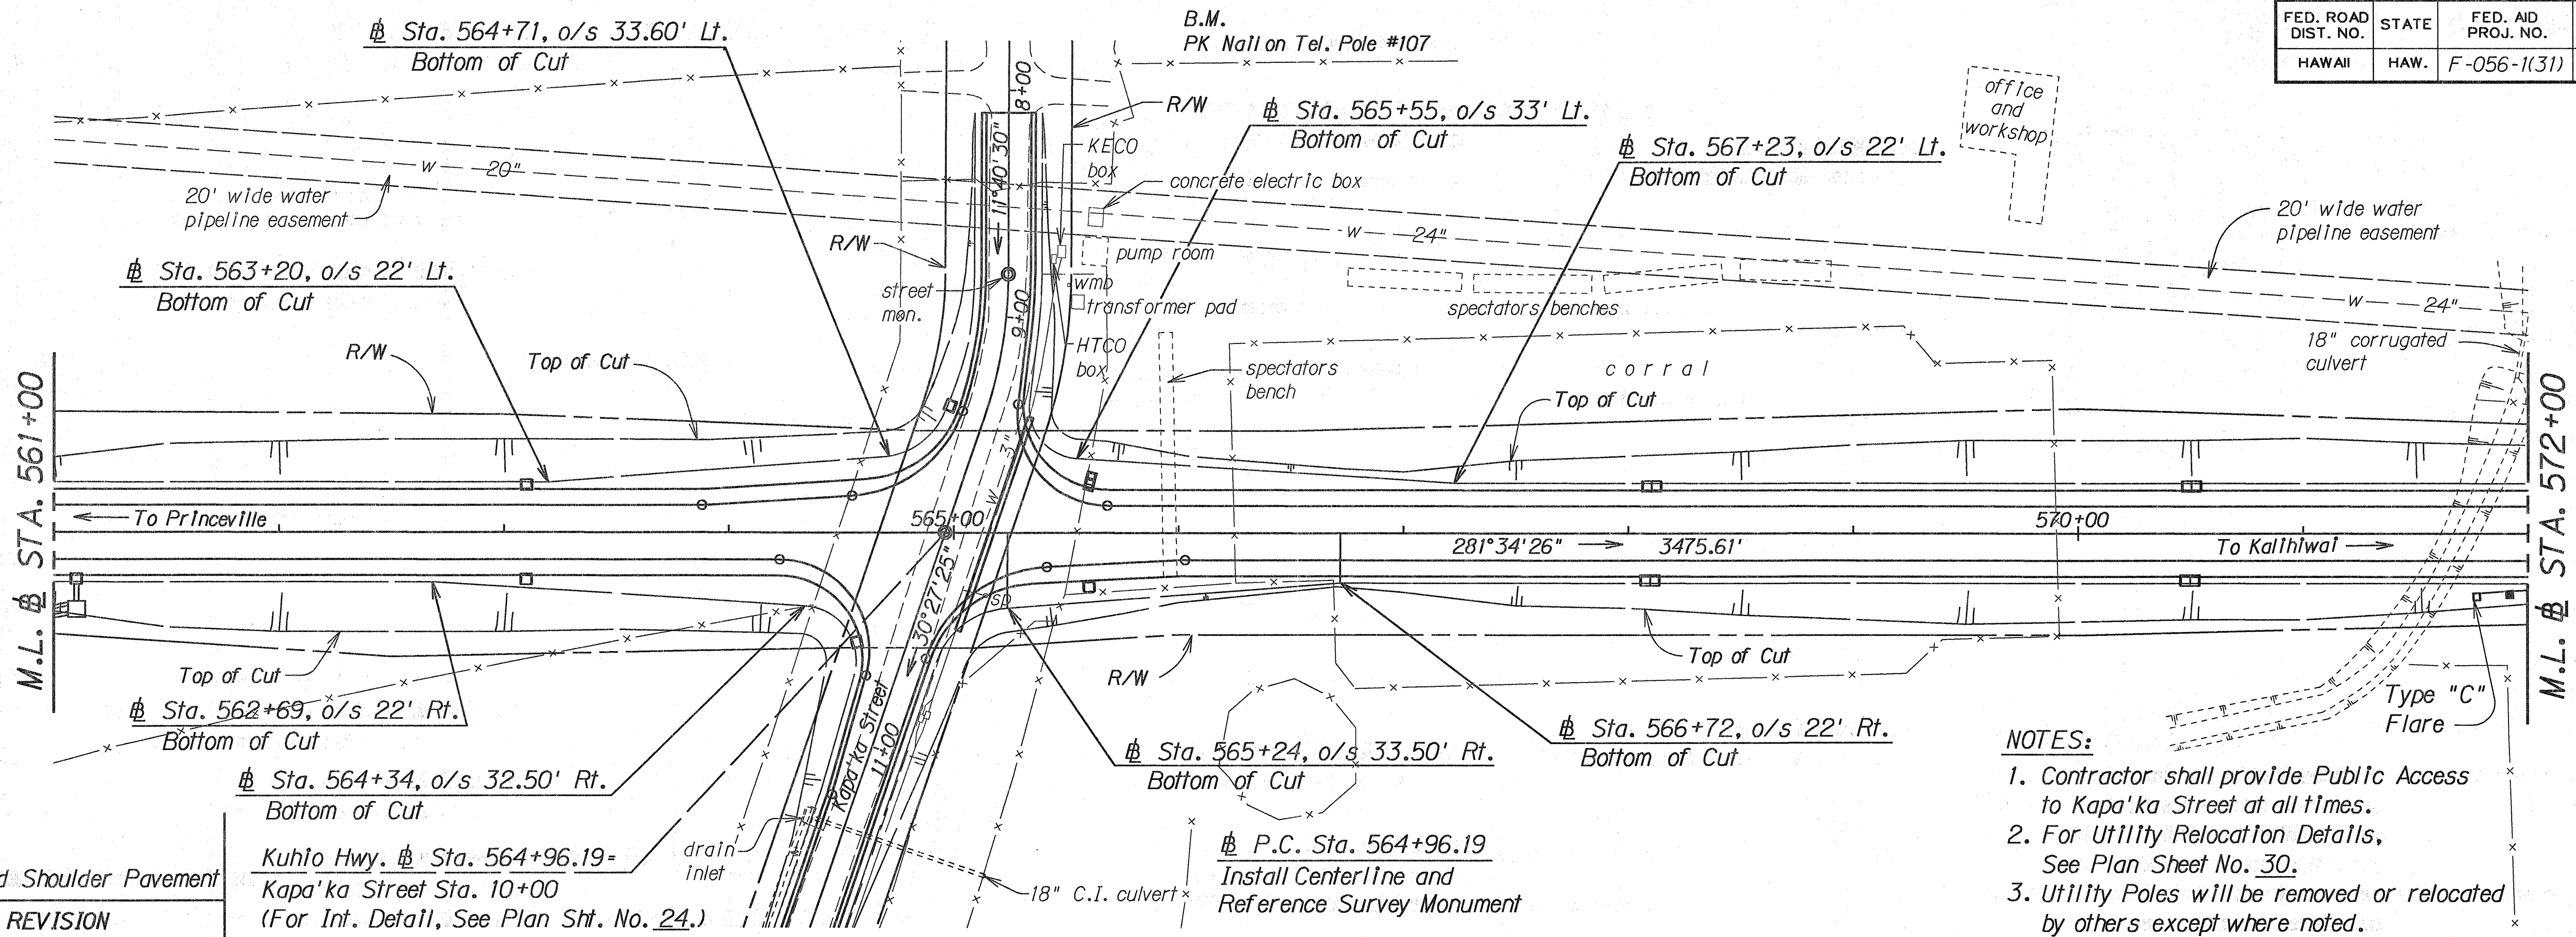


- NOTES:**
- Contractor shall provide Public Access to Kapa'ka Street at all times.
 - For Utility Relocation Details, See Plan Sheet No. 30.
 - Utility Poles will be removed or relocated by others except where noted.

DATE	REVISION
10-31-91	Revised Shoulder Pavement

Kuhio Hwy Sta. 564+96.19 =
Kapa'ka Street Sta. 10+00
(For Int. Detail, See Plan Sht. No. 24.)

P.C. Sta. 564+96.19
Install Centerline and
Reference Survey Monument



ORIGINAL PLAN	DATE
DESIGNED BY	
TRACED BY	
NOTED BY	
CHECKED BY	

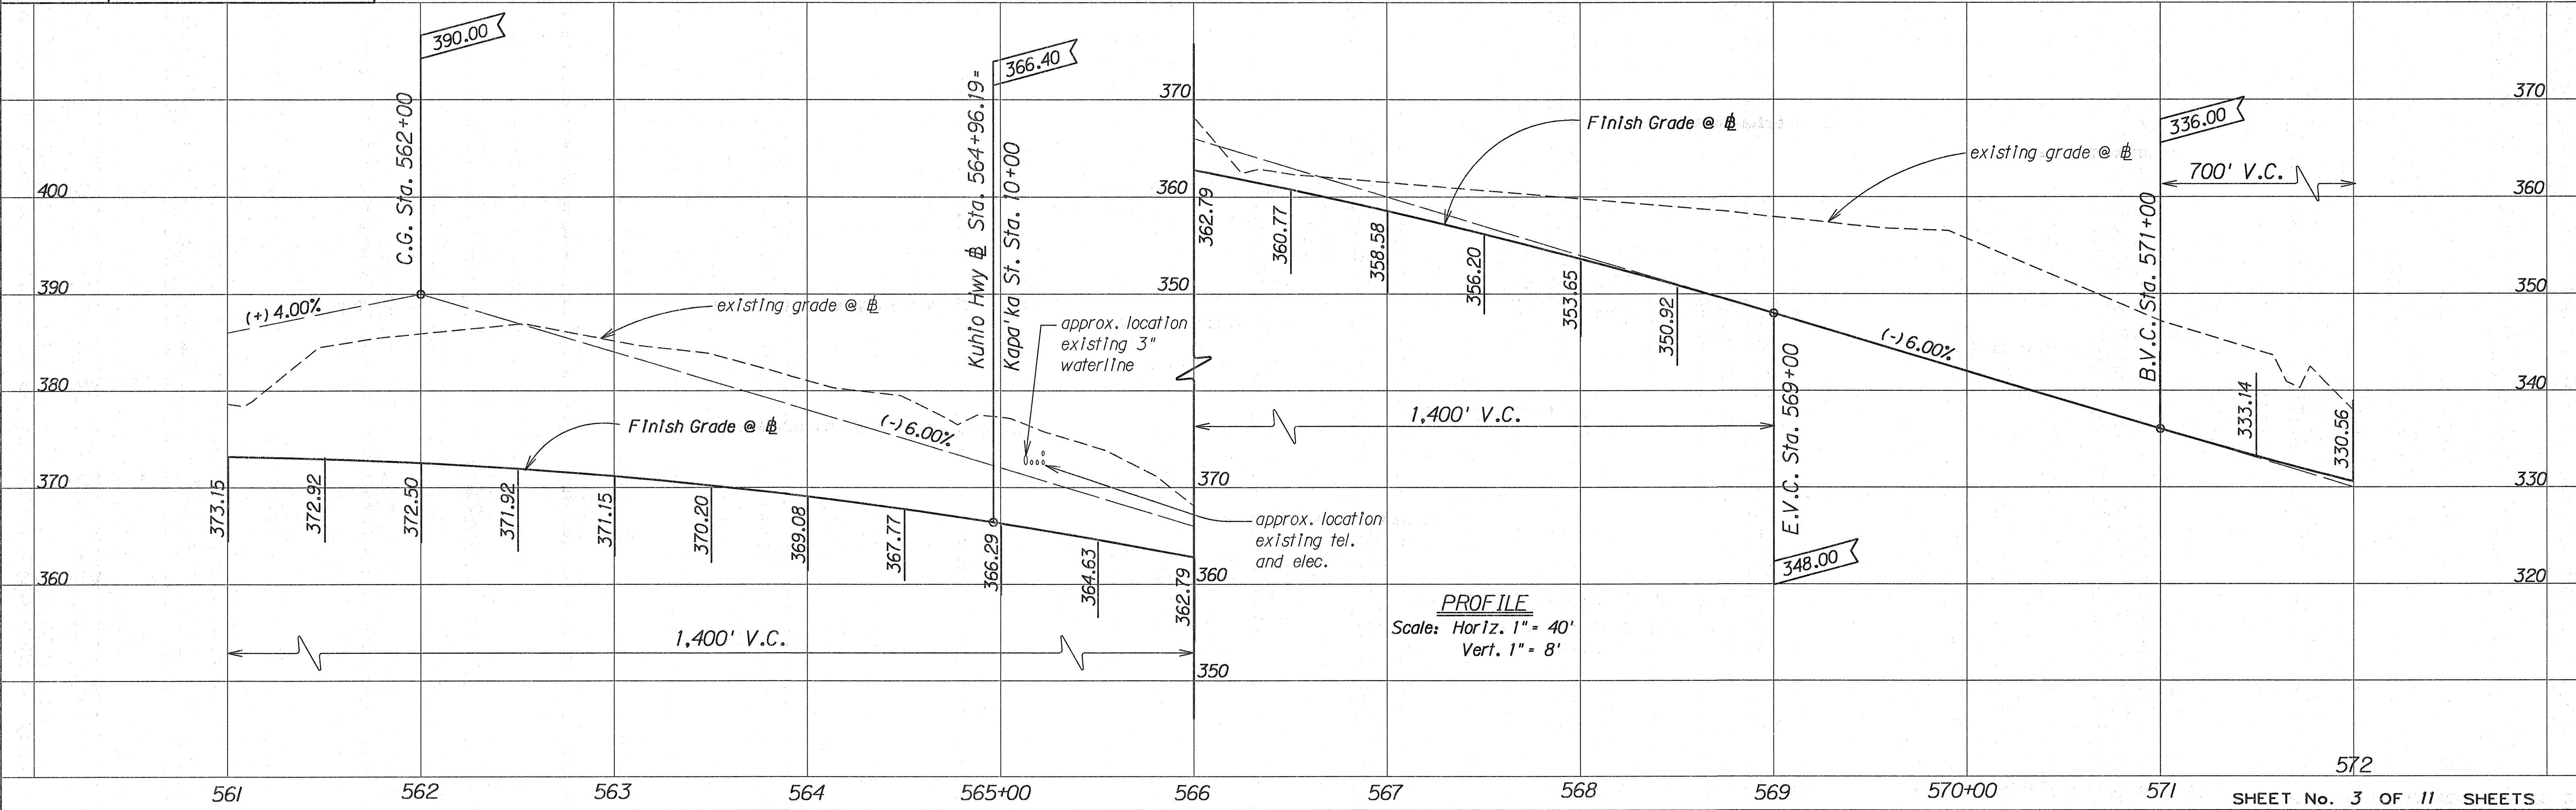

PROFILE
Scale: Horiz. 1" = 40'
Vert. 1" = 8'



FED. ROAD DIST. NO.	STATE	FED. AID PROJ. NO.	FISCAL YEAR	SHEET NO.	TOTAL SHEETS
HAWAII	HAW.	F-056-1(31)	1991	10	126

TRUE NORTH
SCALE: 1" = 40'

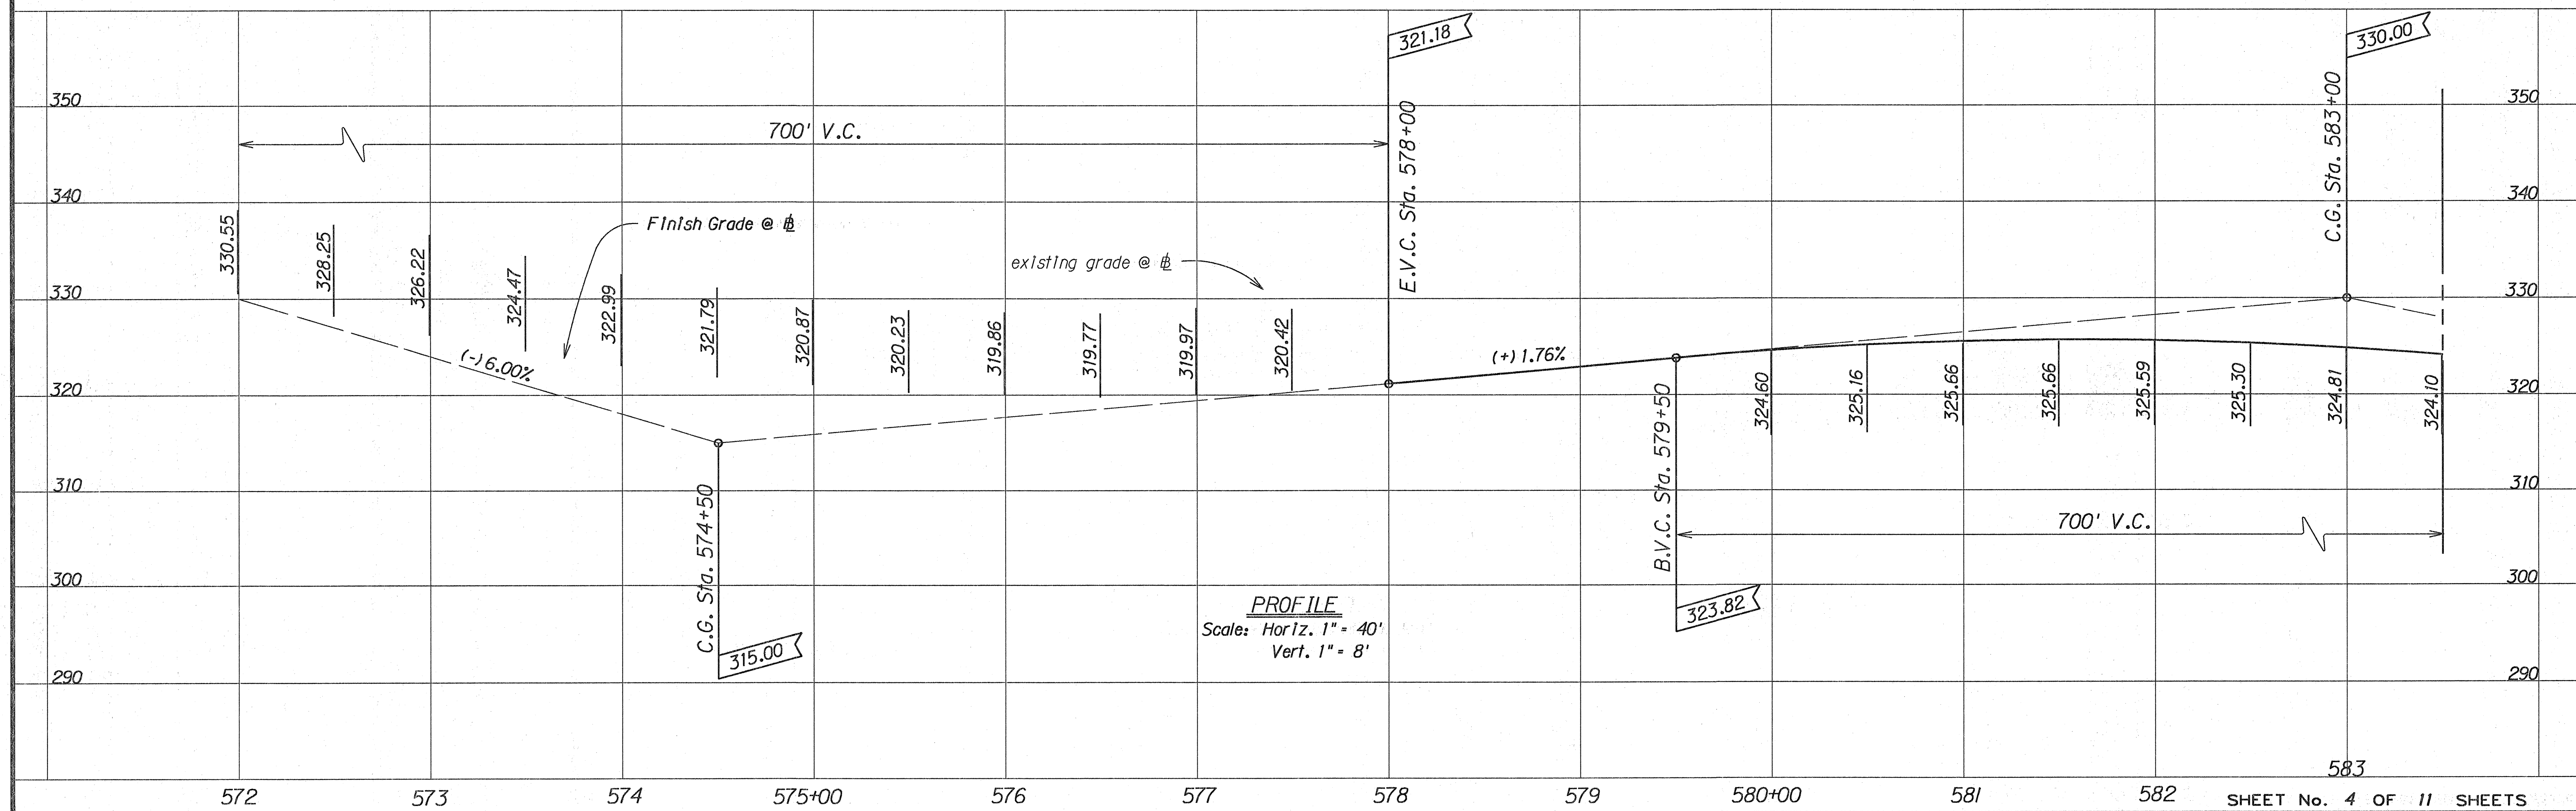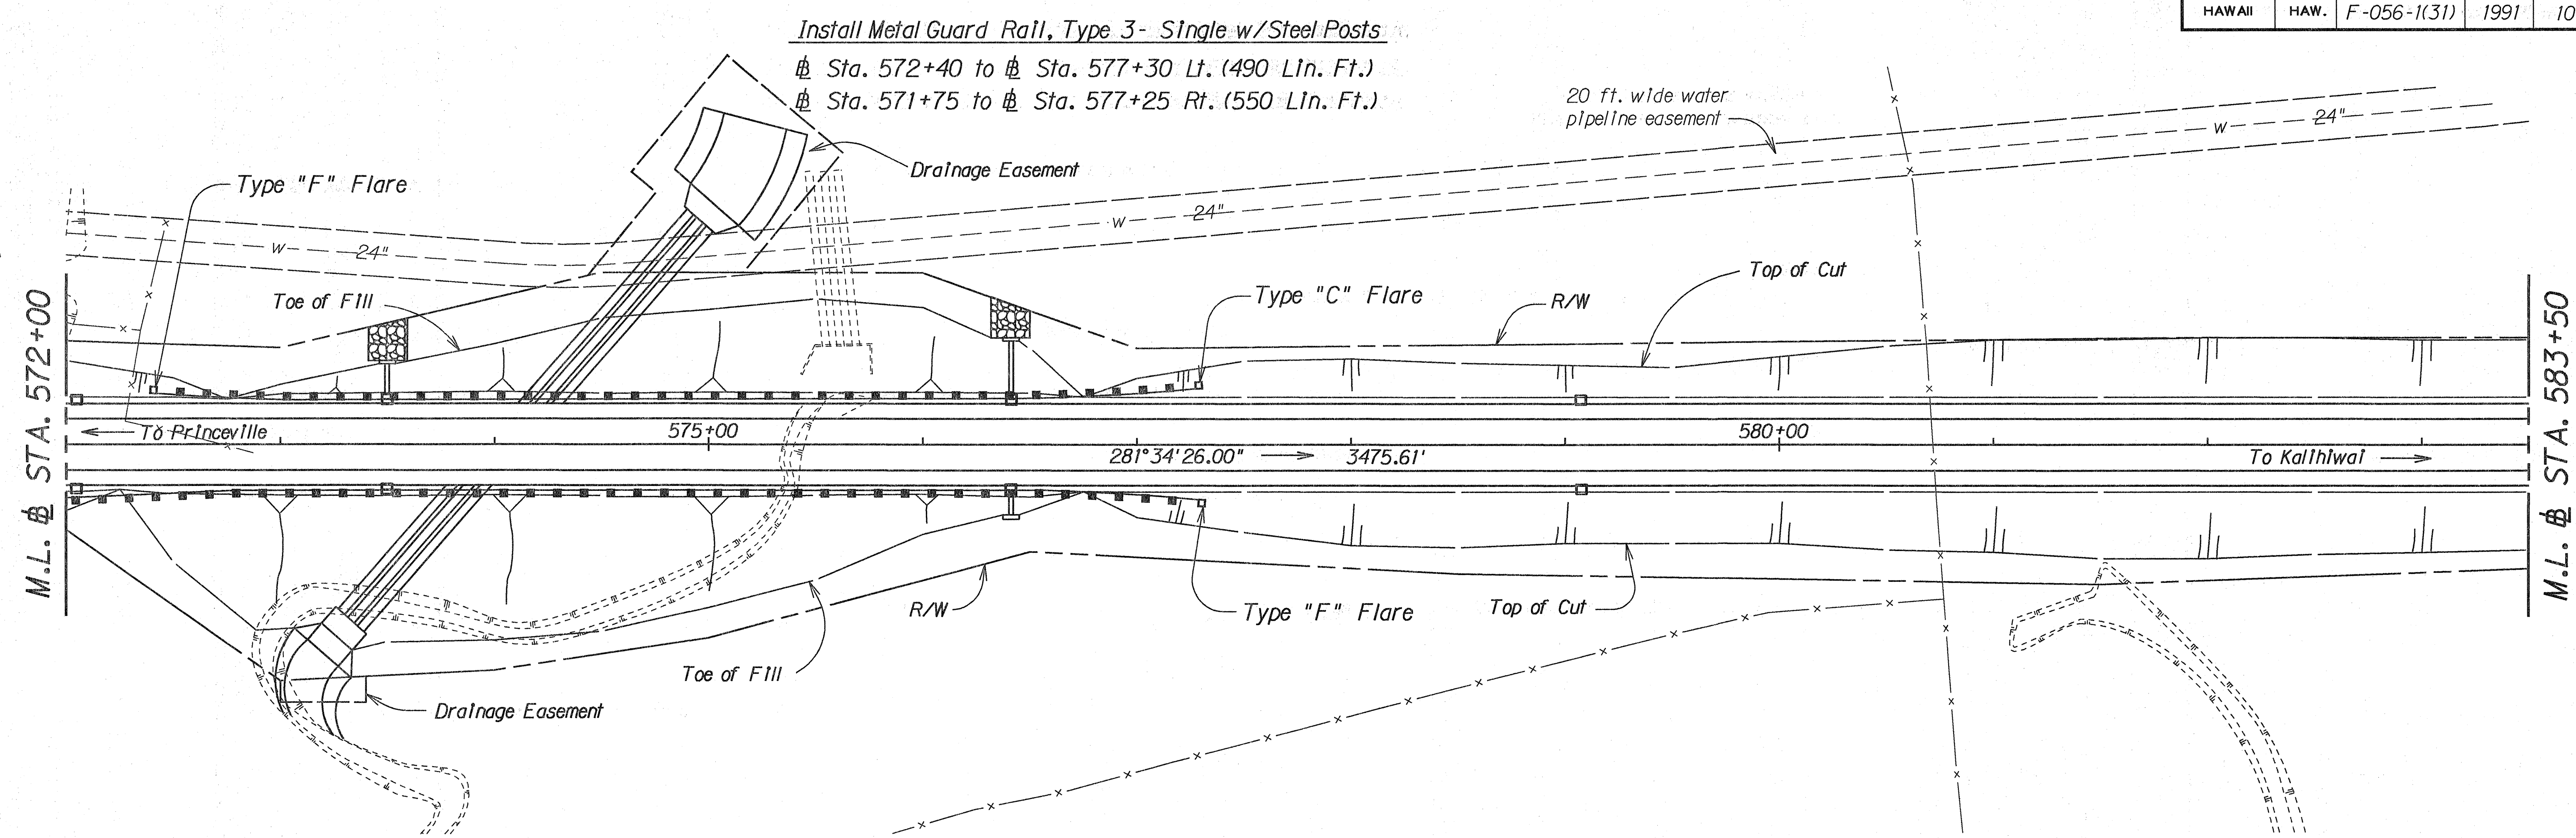


ORIGINAL PLAN	SURVEY PLOTTED BY	DATE
NOTE BOOK	DESIGNED BY	
	QUANTITIES BY	
	CHECKED BY	

FED. ROAD DIST. NO.	STATE	FED. AID PROJ. NO.	FISCAL YEAR	SHEET NO.	TOTAL SHEETS
HAWAII	HAW.	F-056-1(31)	1991	11	126

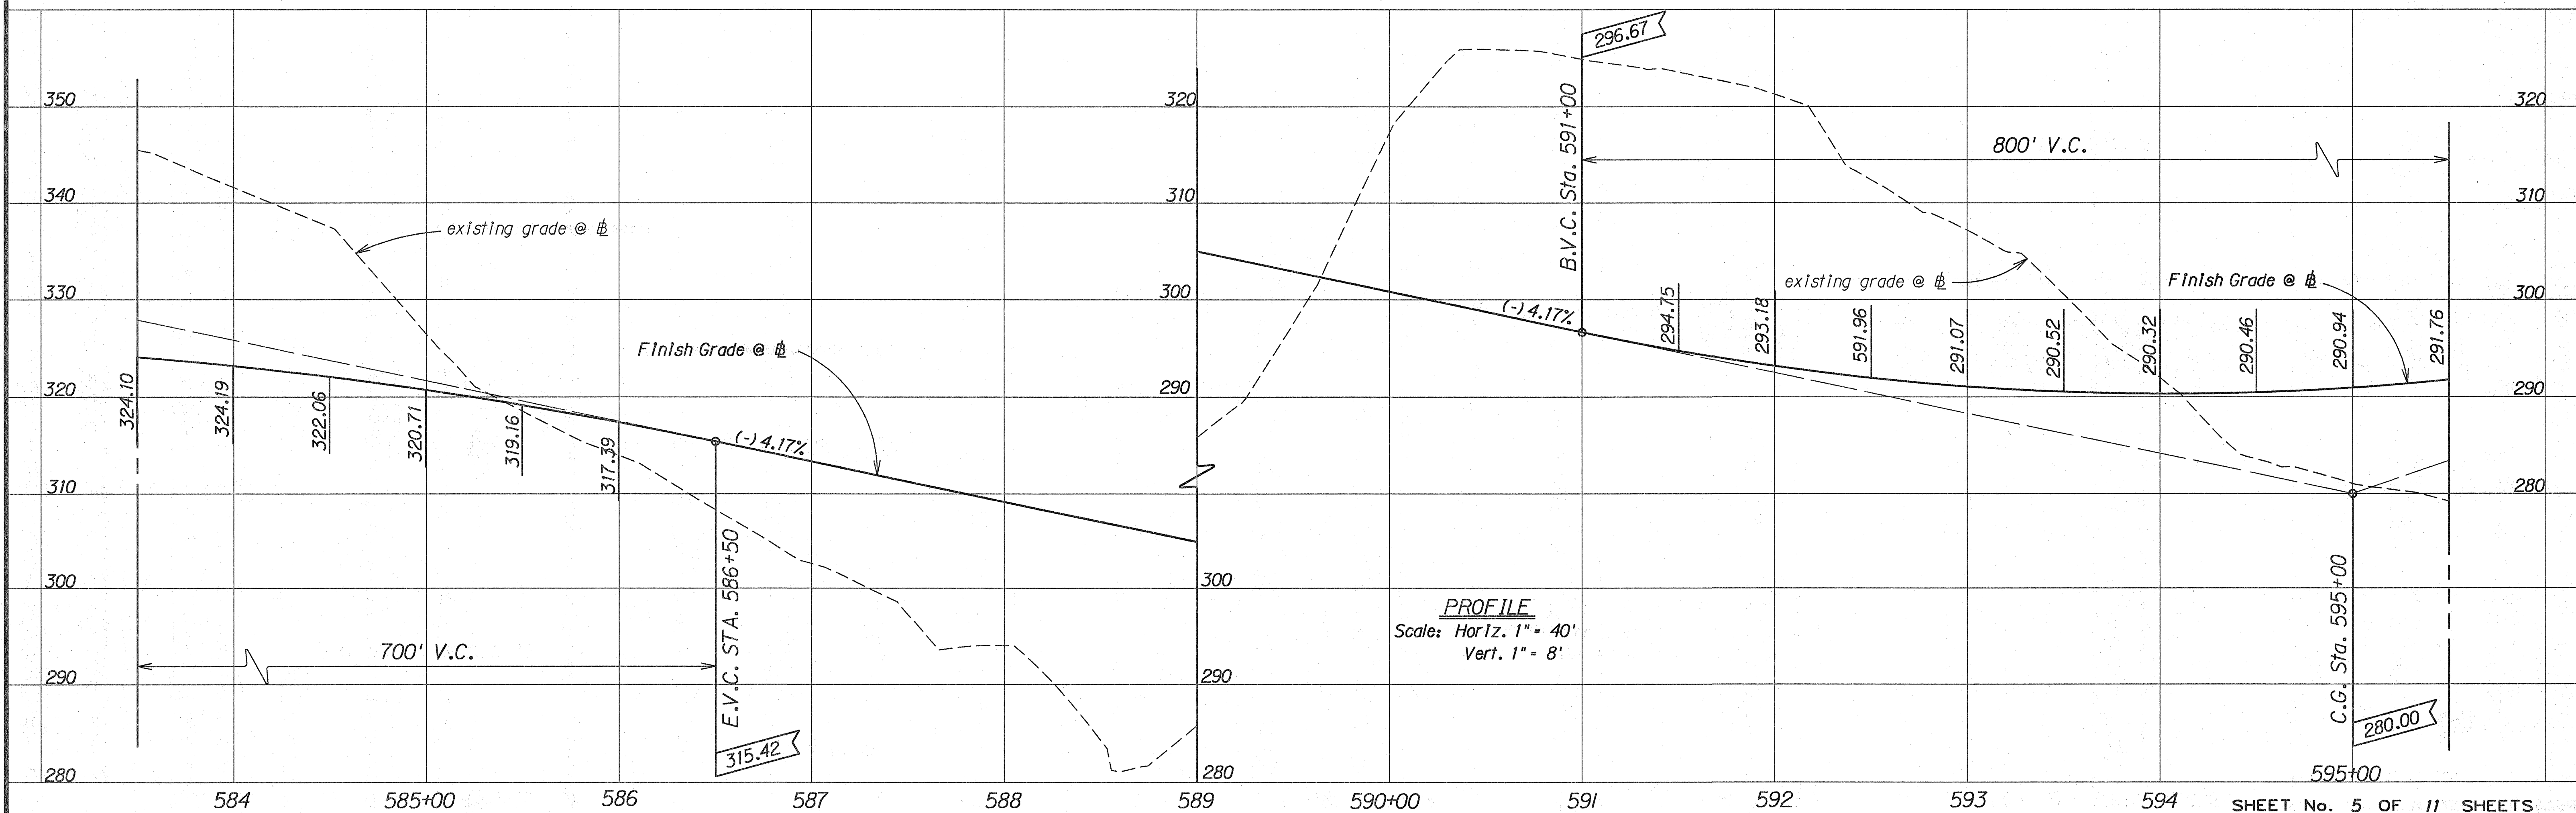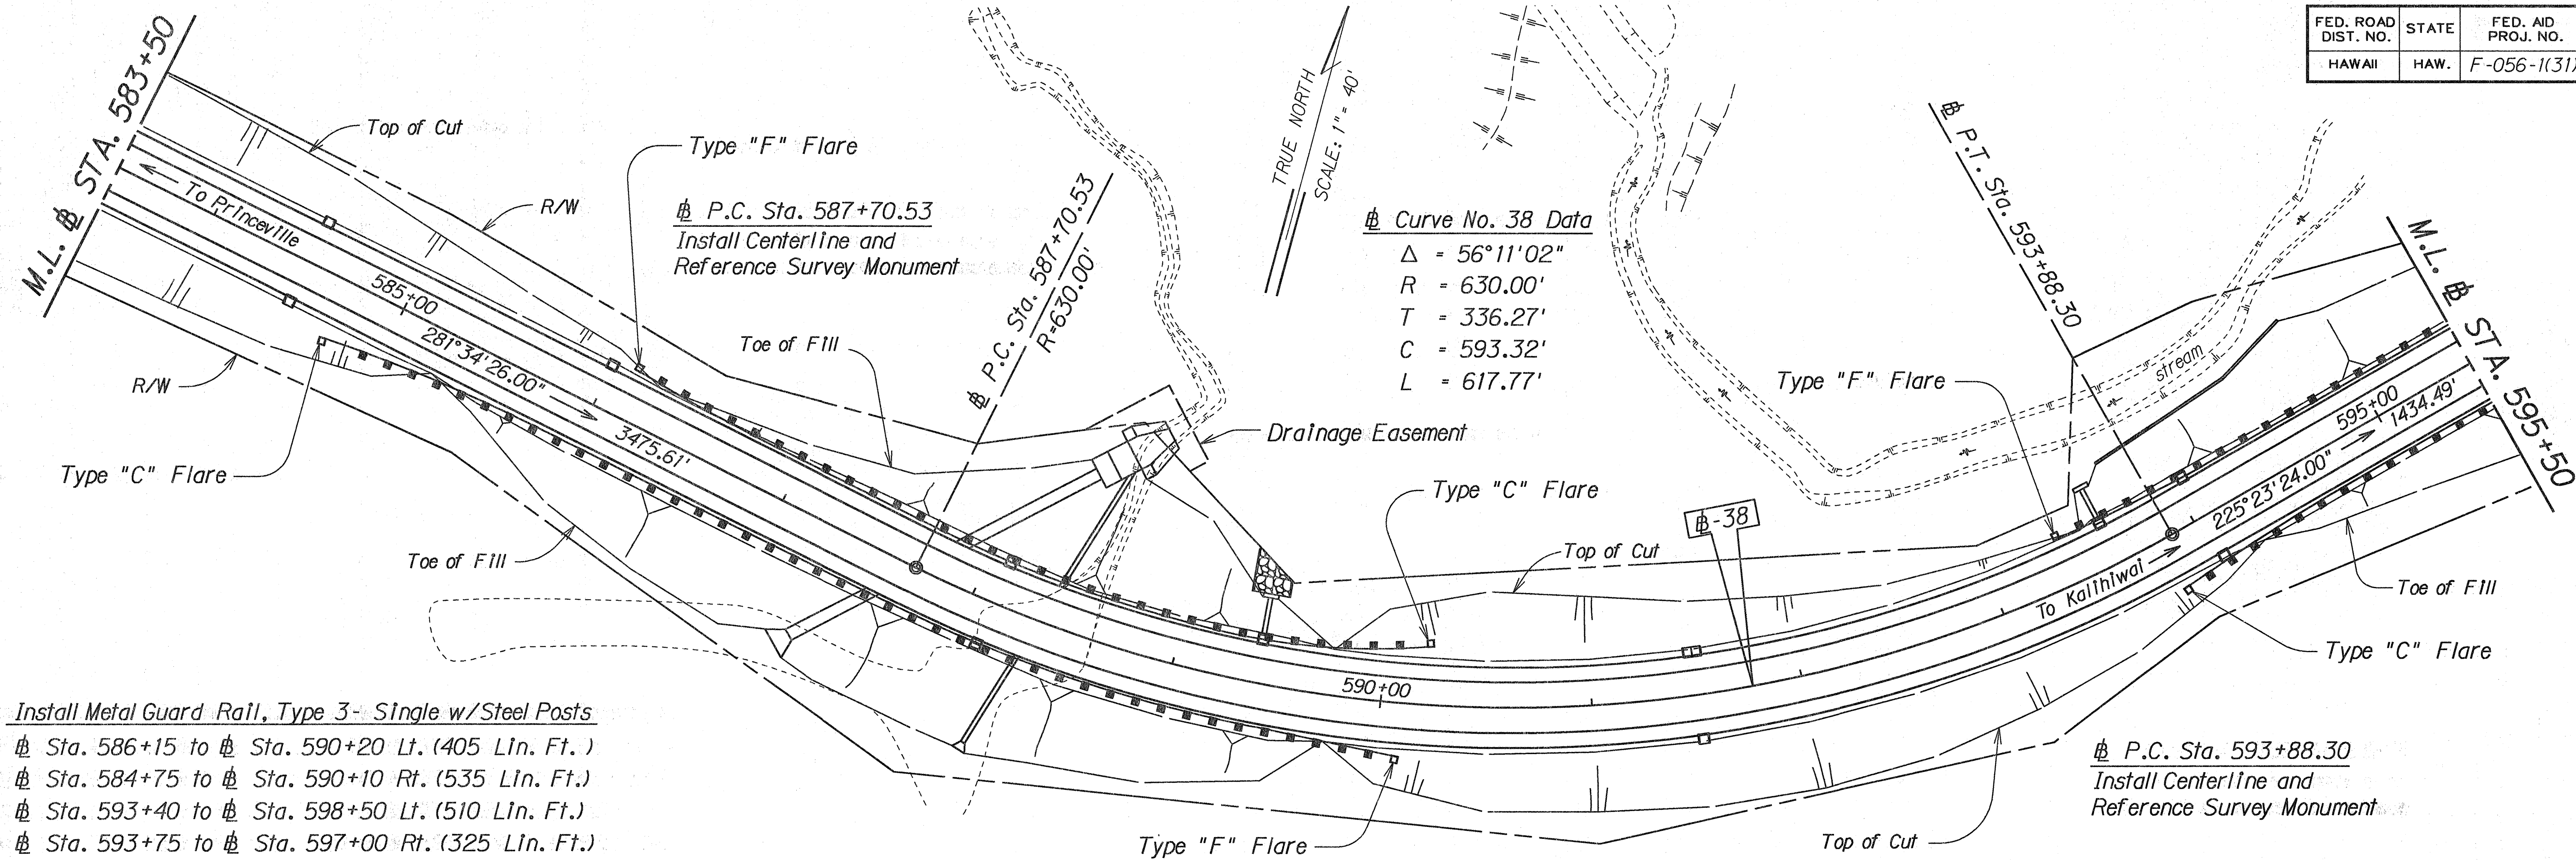


ORIGINAL PLAN	SURVEY PLOTTED BY	DATE
DESIGNED BY		
CHECKED BY		
NOTES BOOK		
N.		

FED. ROAD DIST. NO.	STATE	FED. AID PROJ. NO.	FISCAL YEAR	SHEET NO.	TOTAL SHEETS
HAWAII	HAW.	F-056-1(31)	1991	ADD. 12	126

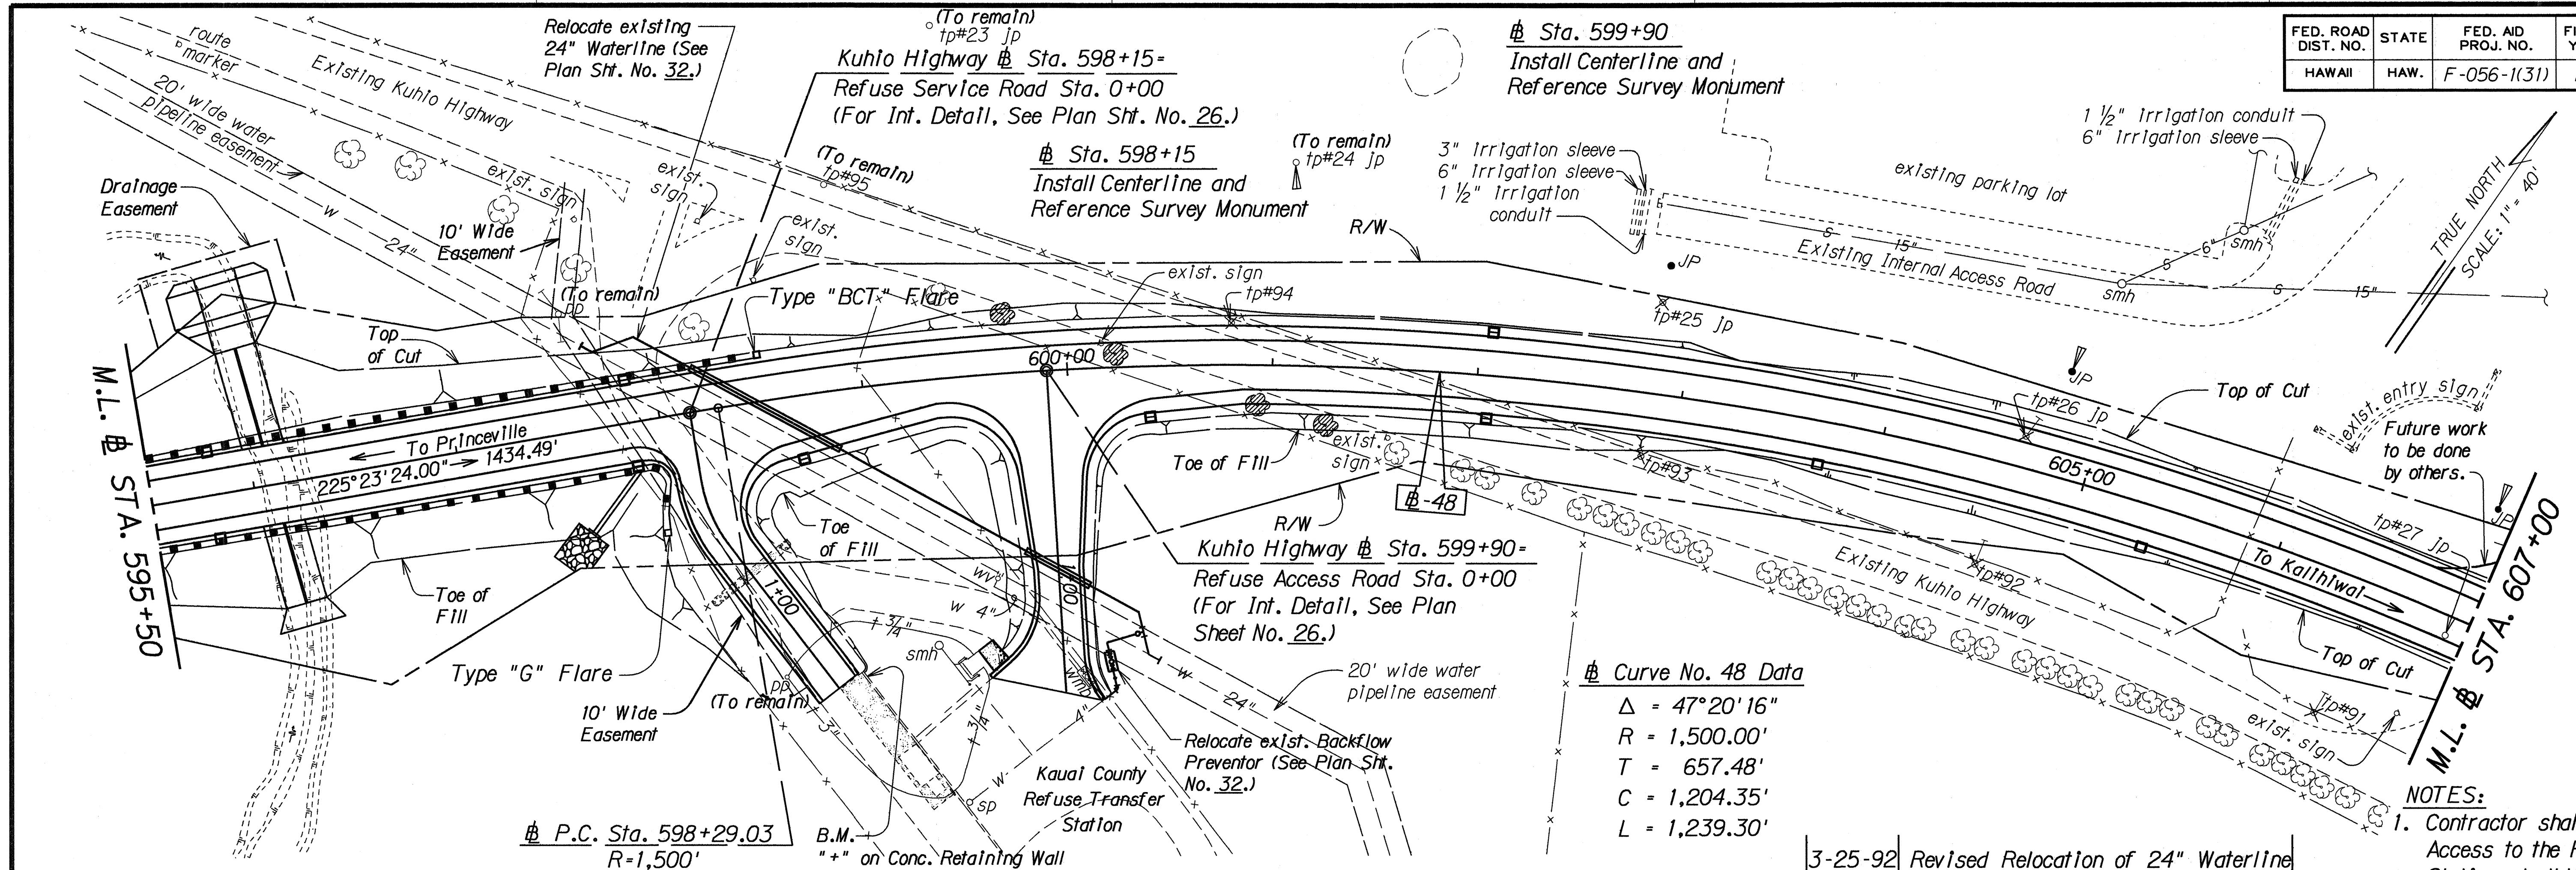


- NOTES:**
- Contractor shall provide Public Access to the Refuse Transfer Station at all times during operational hours and for work within the County Right-of-Way.
 - Utility Poles will be removed or relocated by others except where noted.

DATE	REVISION
3-25-92	Revised Relocation of 24" Waterline
12-5-91	Added New Pole Locations
11-5-91	Revised Shoulder Pavement
9-18-91	Deleted Concrete Protection for Existing 24" Waterline
	Added Waterline Relocation

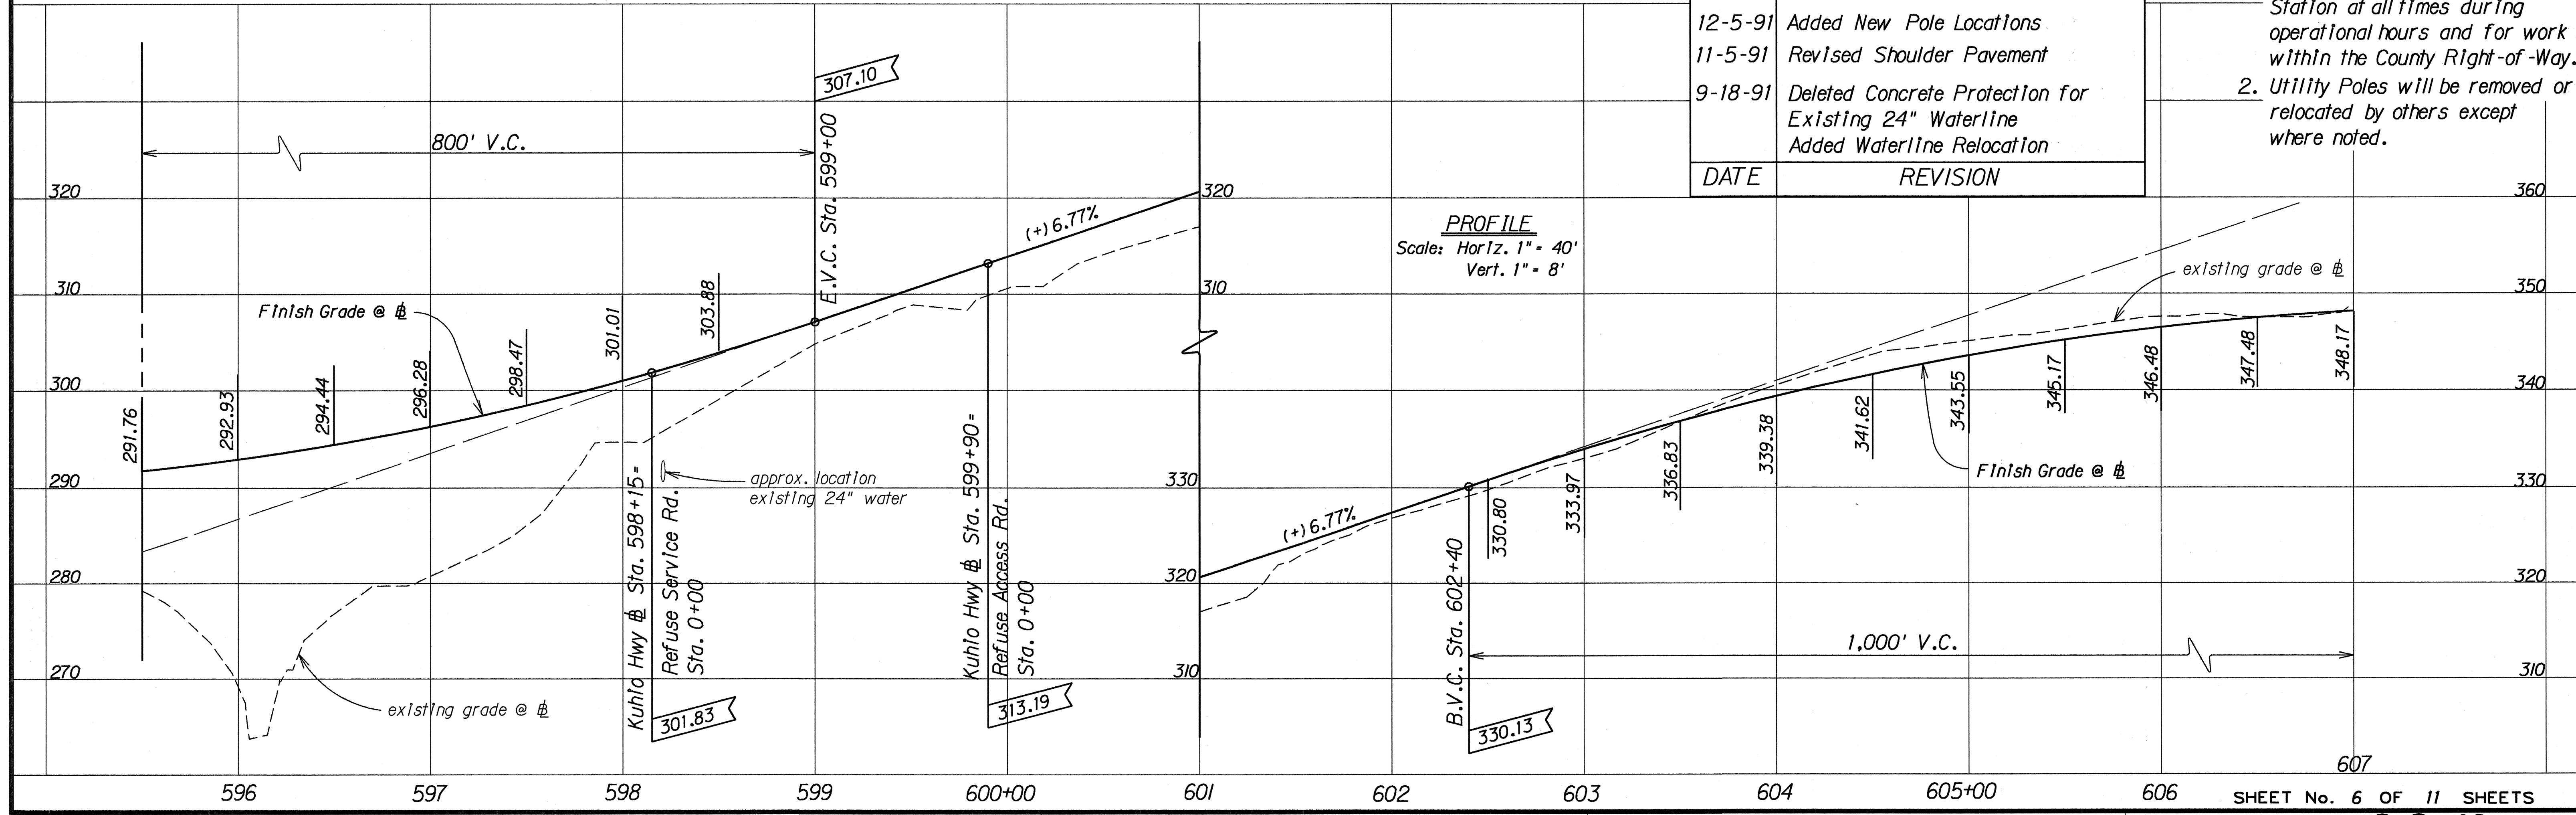


DESIGNED BY	DATE
TRACED BY	
NOTE BOOK	
QUANTITIES BY	
CHECKED BY	

FED. ROAD DIST. NO.	STATE	FED. AID PROJ. NO.	FISCAL YEAR	SHEET NO.	TOTAL SHEETS
HAWAII	HAW.	F-056-1(31)	1991	13	126

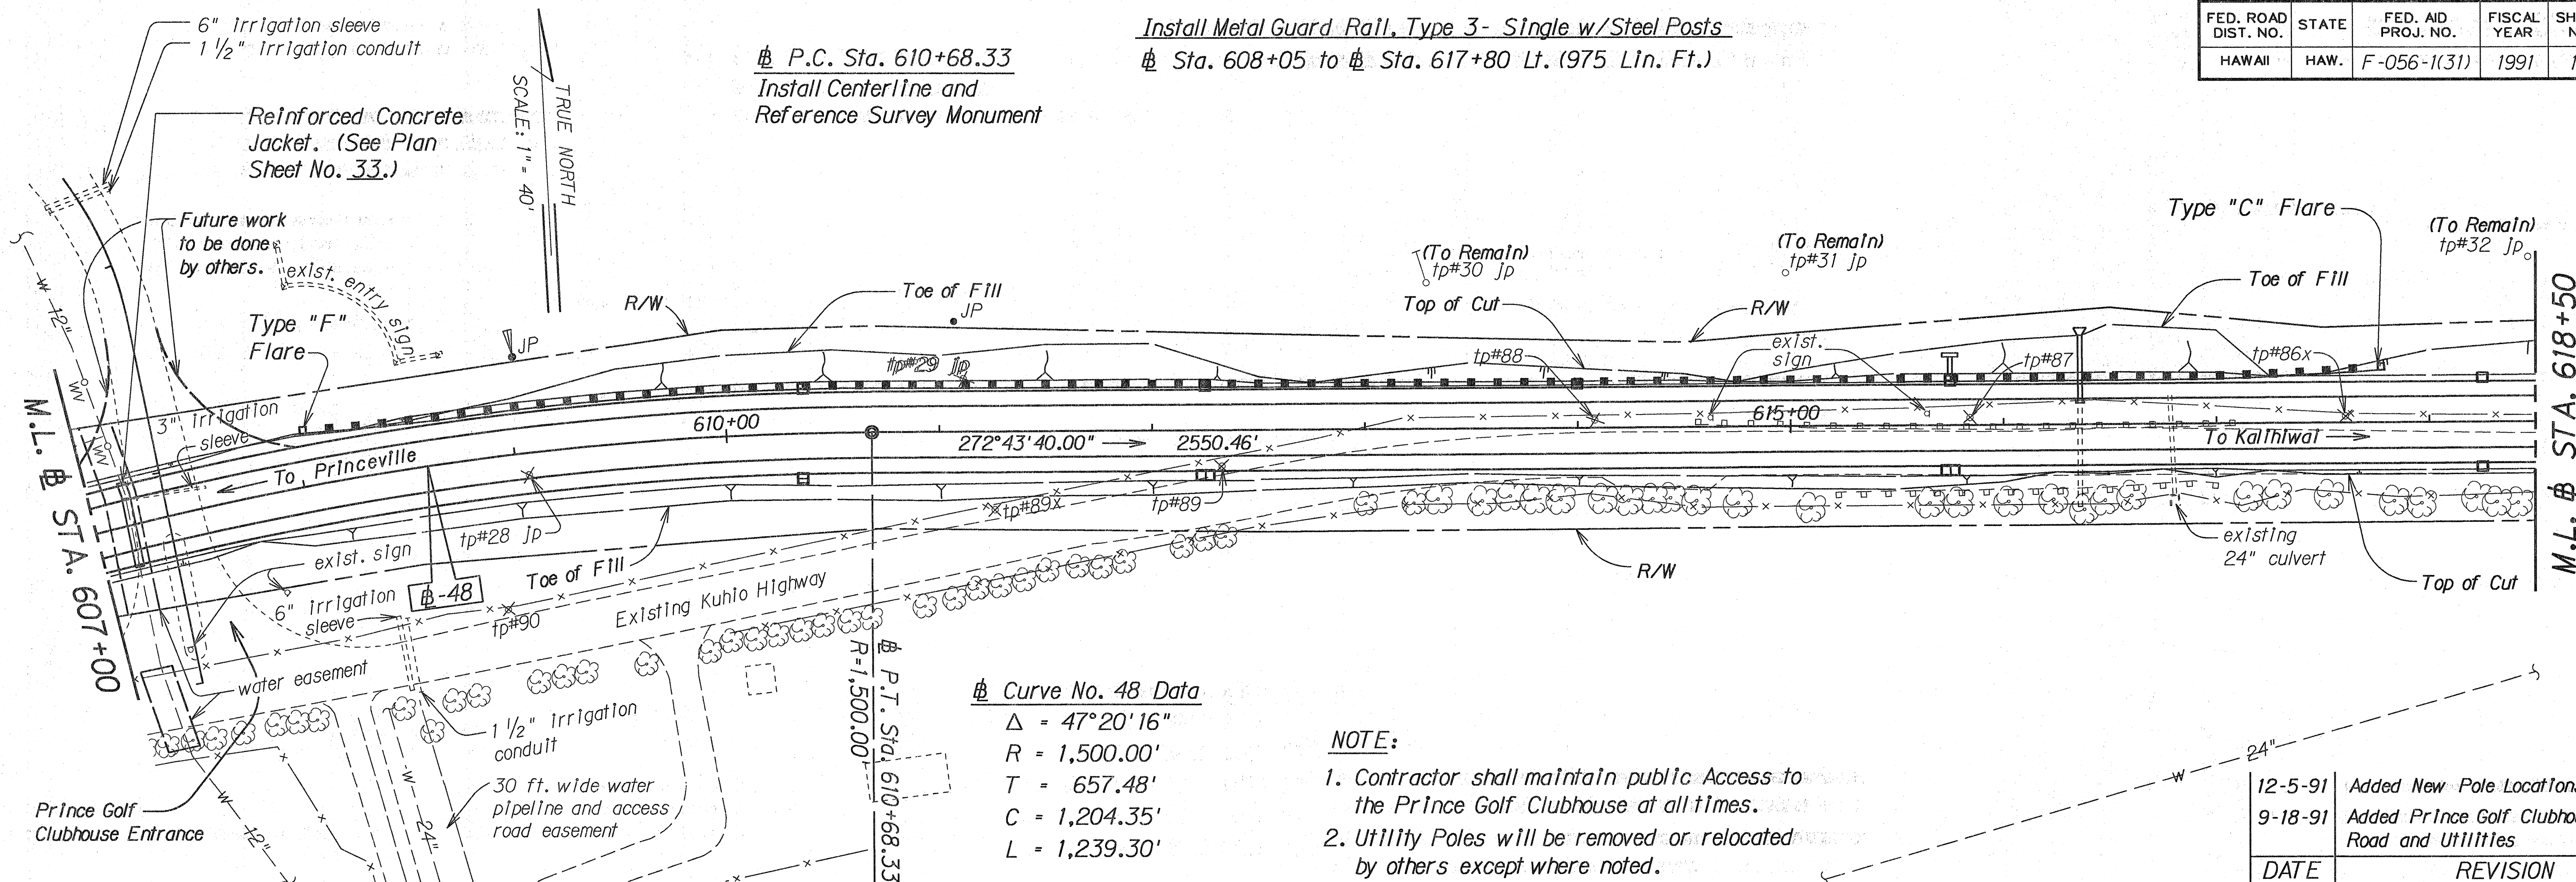

DATE	REVISION
12-5-91	Added New Pole Locations
9-18-91	Added Prince Golf Clubhouse Road and Utilities

ORIGINAL PLAN	DATE
DESIGNED BY	
NOTED BY	
CHECKED BY	
QUANTITIES BY	
NO.	

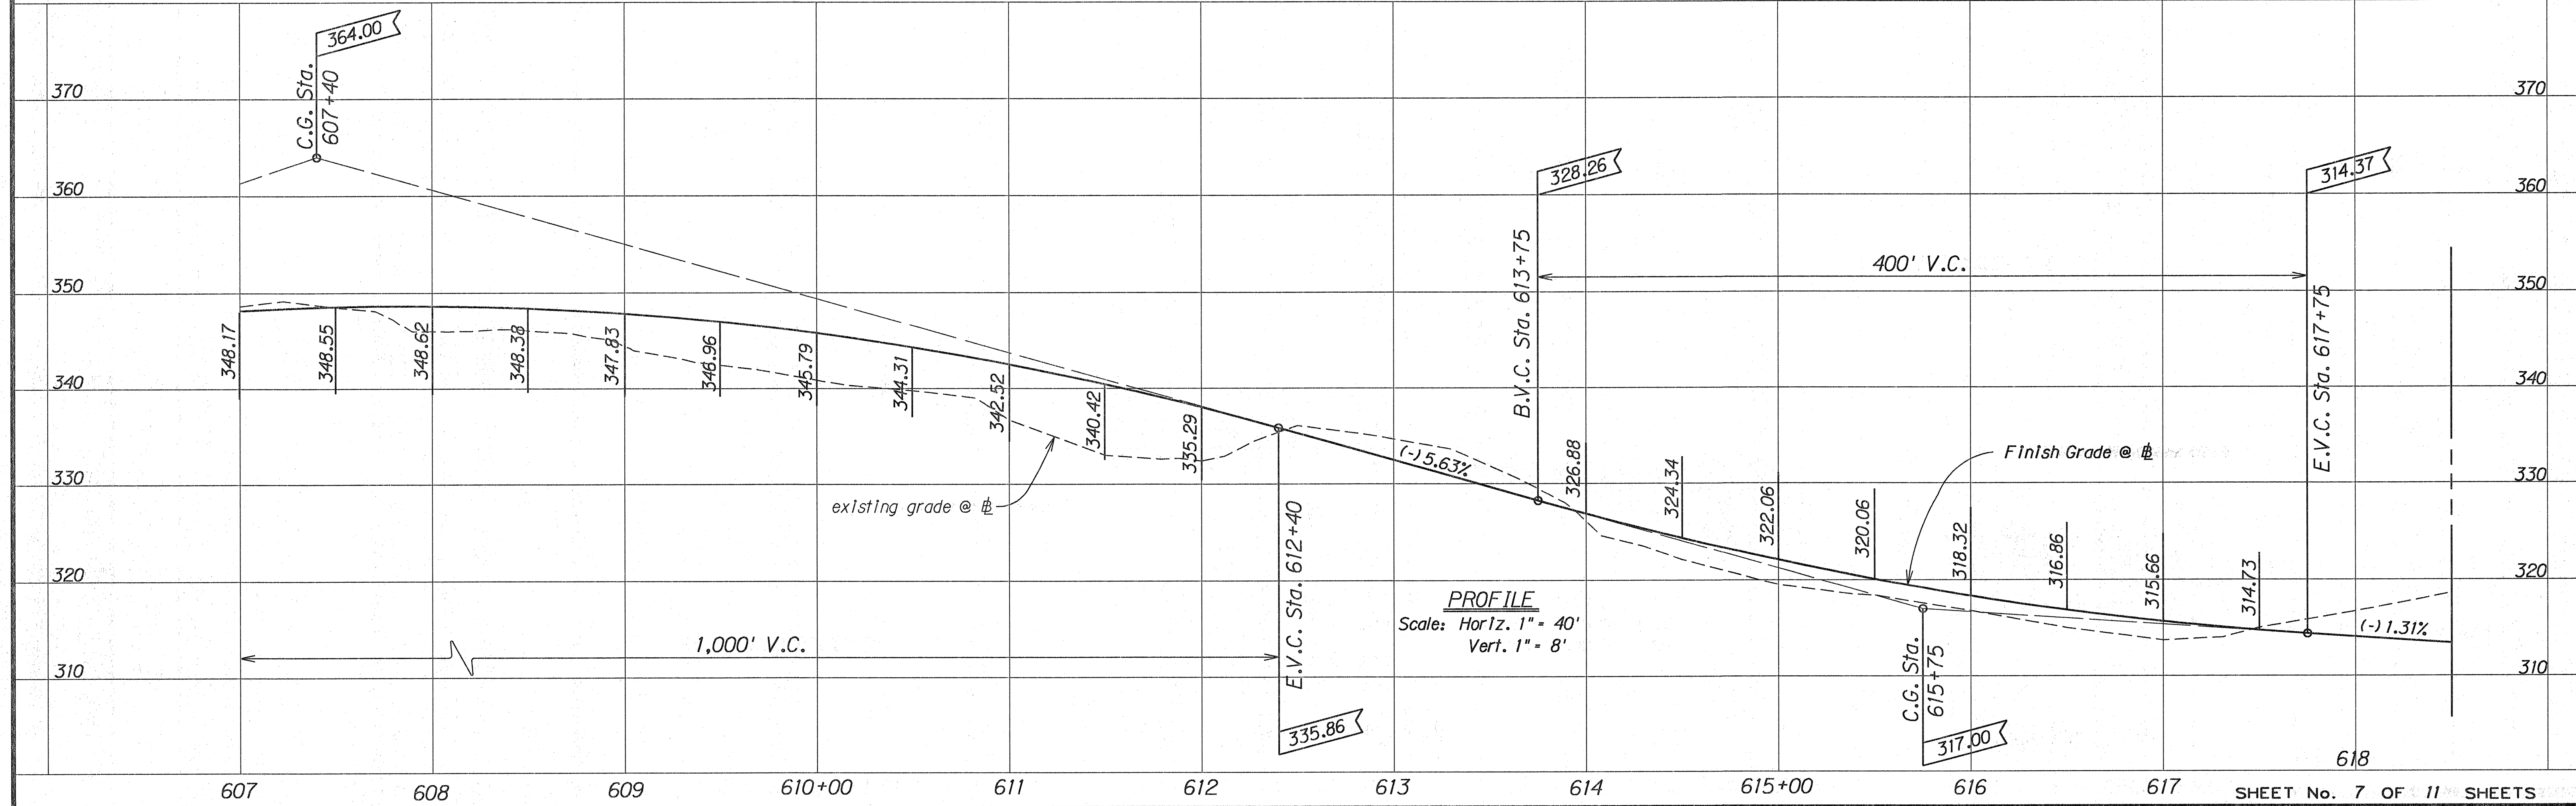


FED. ROAD DIST. NO.	STATE	FED. AID PROJ. NO.	FISCAL YEAR	SHEET NO.	TOTAL SHEETS
HAWAII	HAW.	F-056-1(31)	1991	14	126

Curve No. 58 Data

$\Delta = 51^\circ 19' 40''$
 $R = 1,250.00'$
 $T = 600.61'$
 $C = 1,082.72'$
 $L = 1,119.80'$

P.C. Sta. 623+60.69
 Install Centerline and
 Reference Survey Monument

TRUE NORTH
 SCALE: 1" = 40'

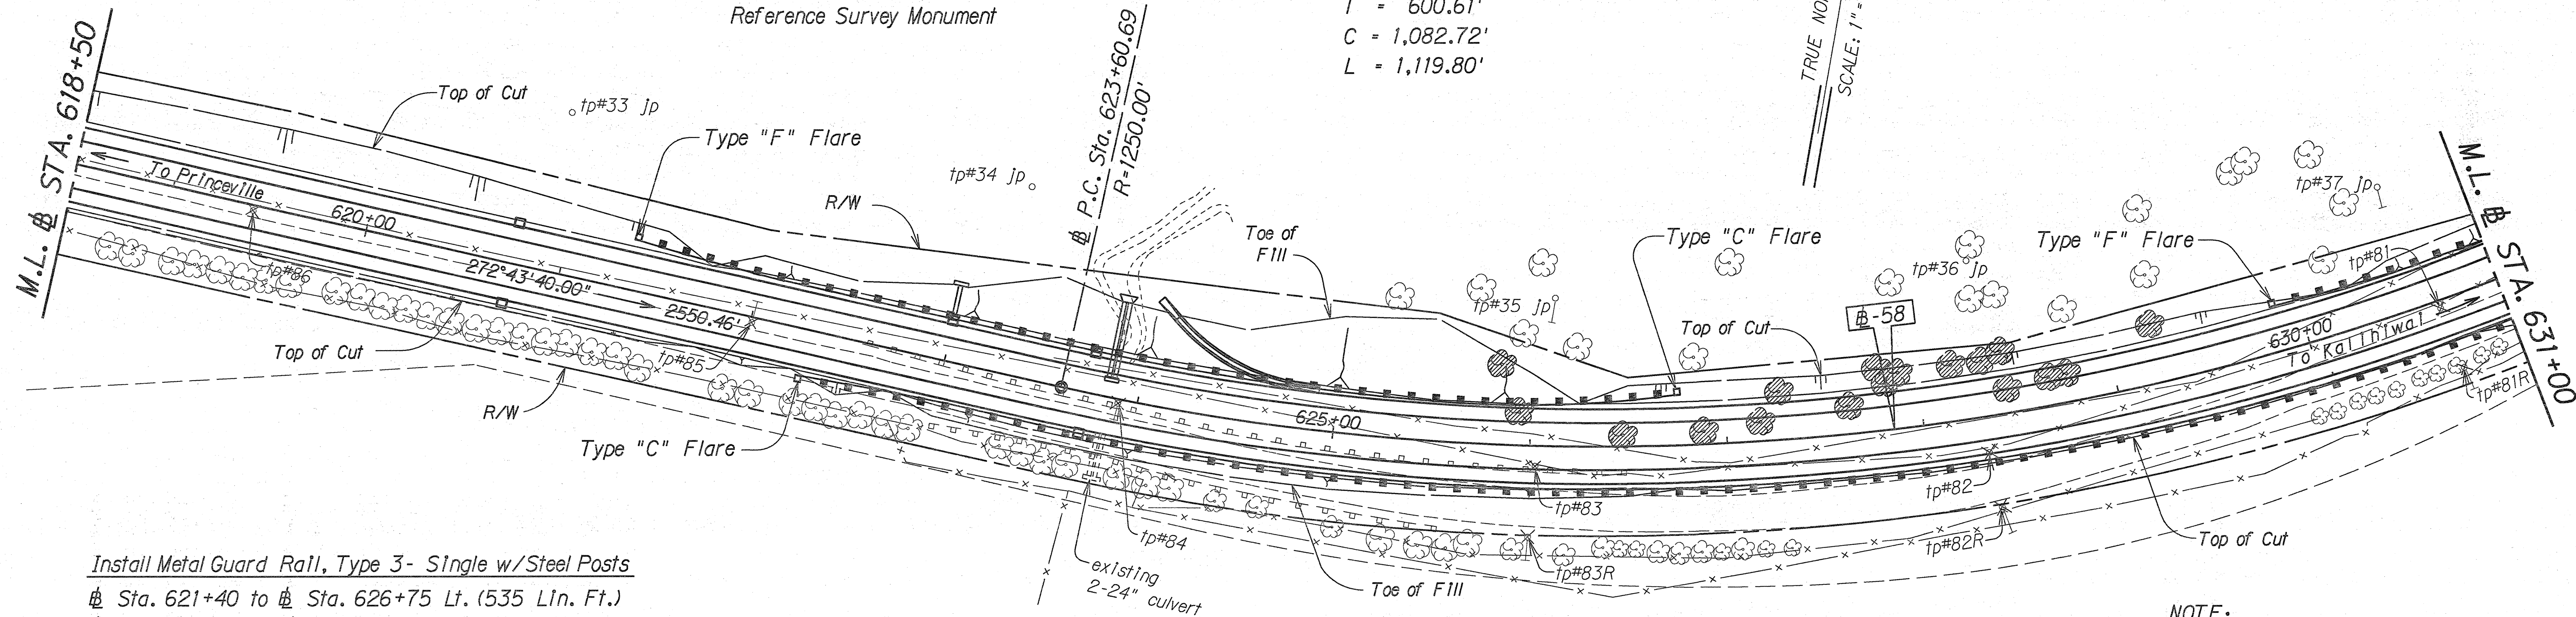


Install Metal Guard Rail, Type 3- Single w/Steel Posts

Sta. 621+40 to Sta. 626+75 Lt. (535 Lin. Ft.)
 Sta. 622+30 to Sta. 636+55 Rt. (1,425 Lin. Ft.)
 Sta. 629+90 to Sta. 639+90 Lt. (1,000 Lin. Ft.)

NOTE:


Utility Poles will be removed or relocated by others except where noted.

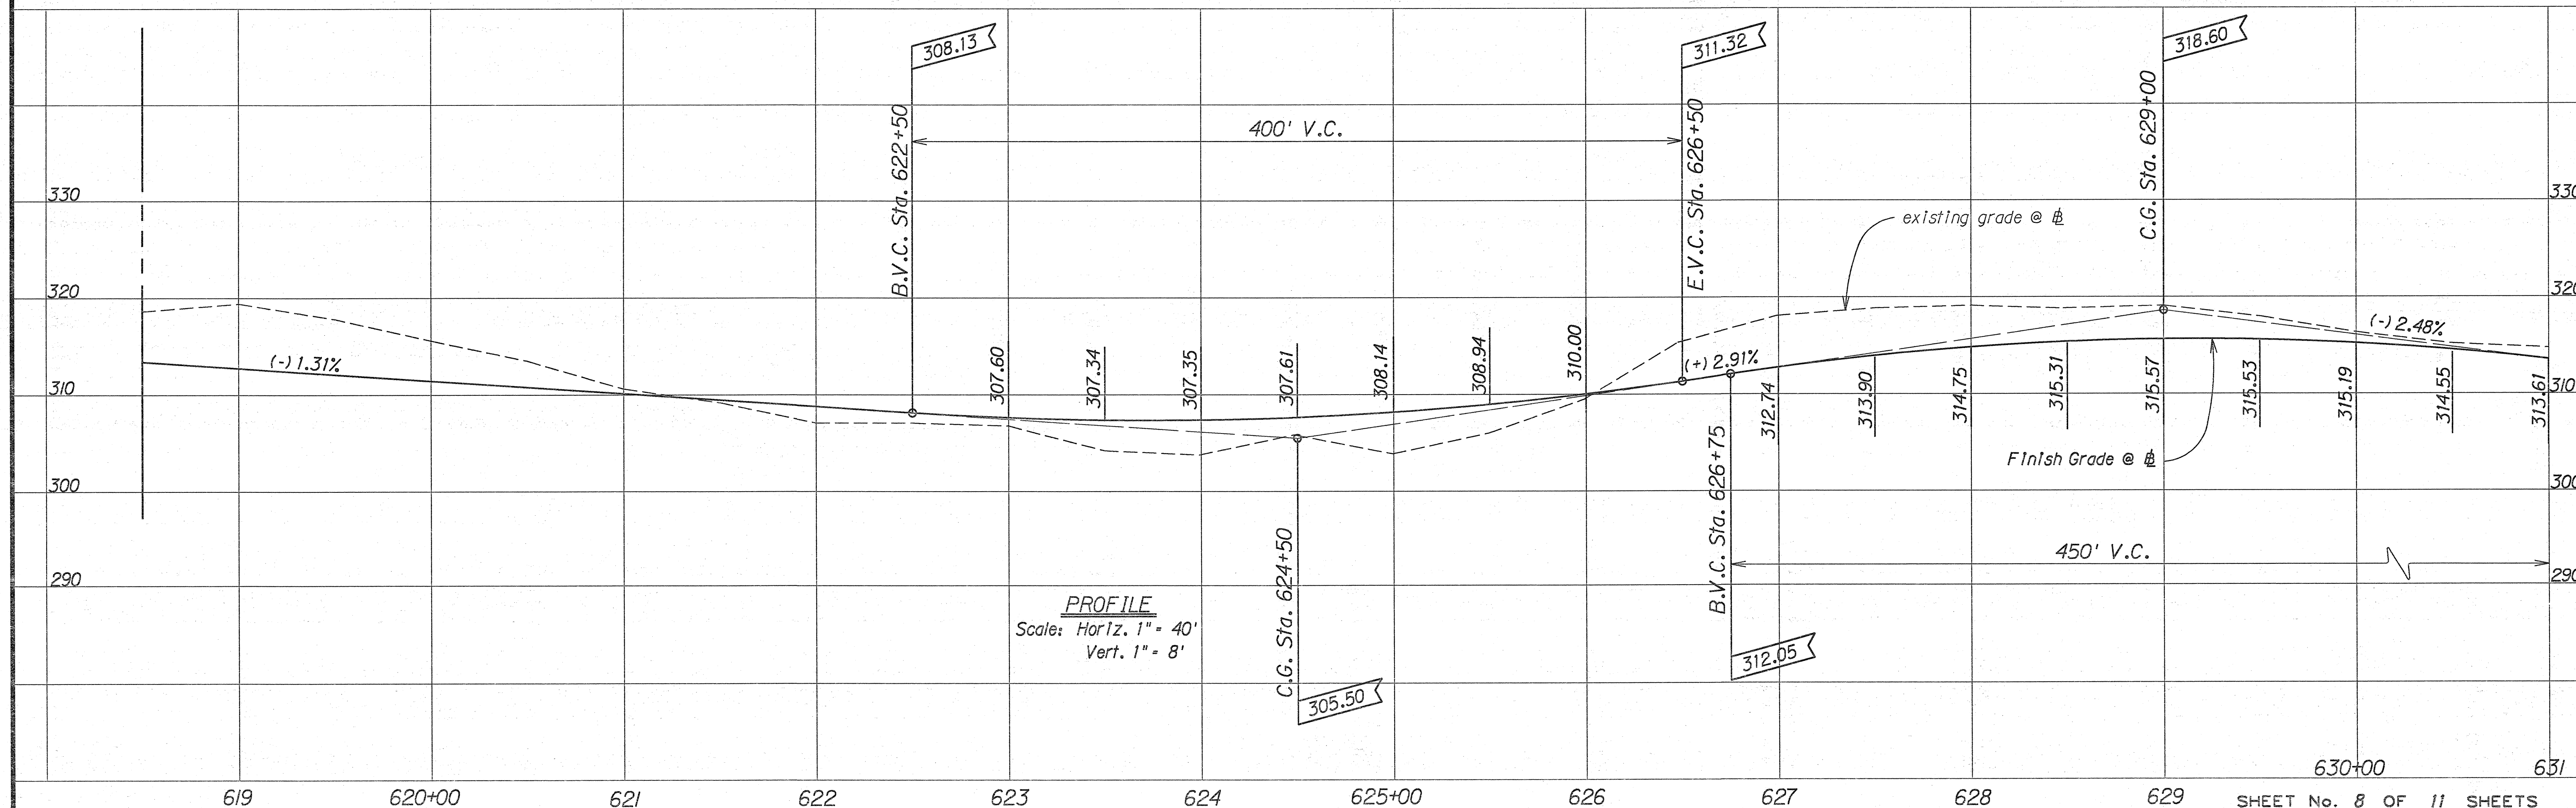


PROFILE
 Scale: Horiz. 1" = 40'
 Vert. 1" = 8'

ORIGINAL PLAN	SURVEY PLOTTED BY	DATE
NOTE BOOK	DRAWN BY	
CHECKED BY	DESIGNED BY	
	QUANTITIES BY	
	CHECKED BY	

FED. ROAD DIST. NO.	STATE	FED. AID PROJ. NO.	FISCAL YEAR	SHEET NO.	TOTAL SHEETS
HAWAII	HAW.	F-056-1(31)	1991	15	126

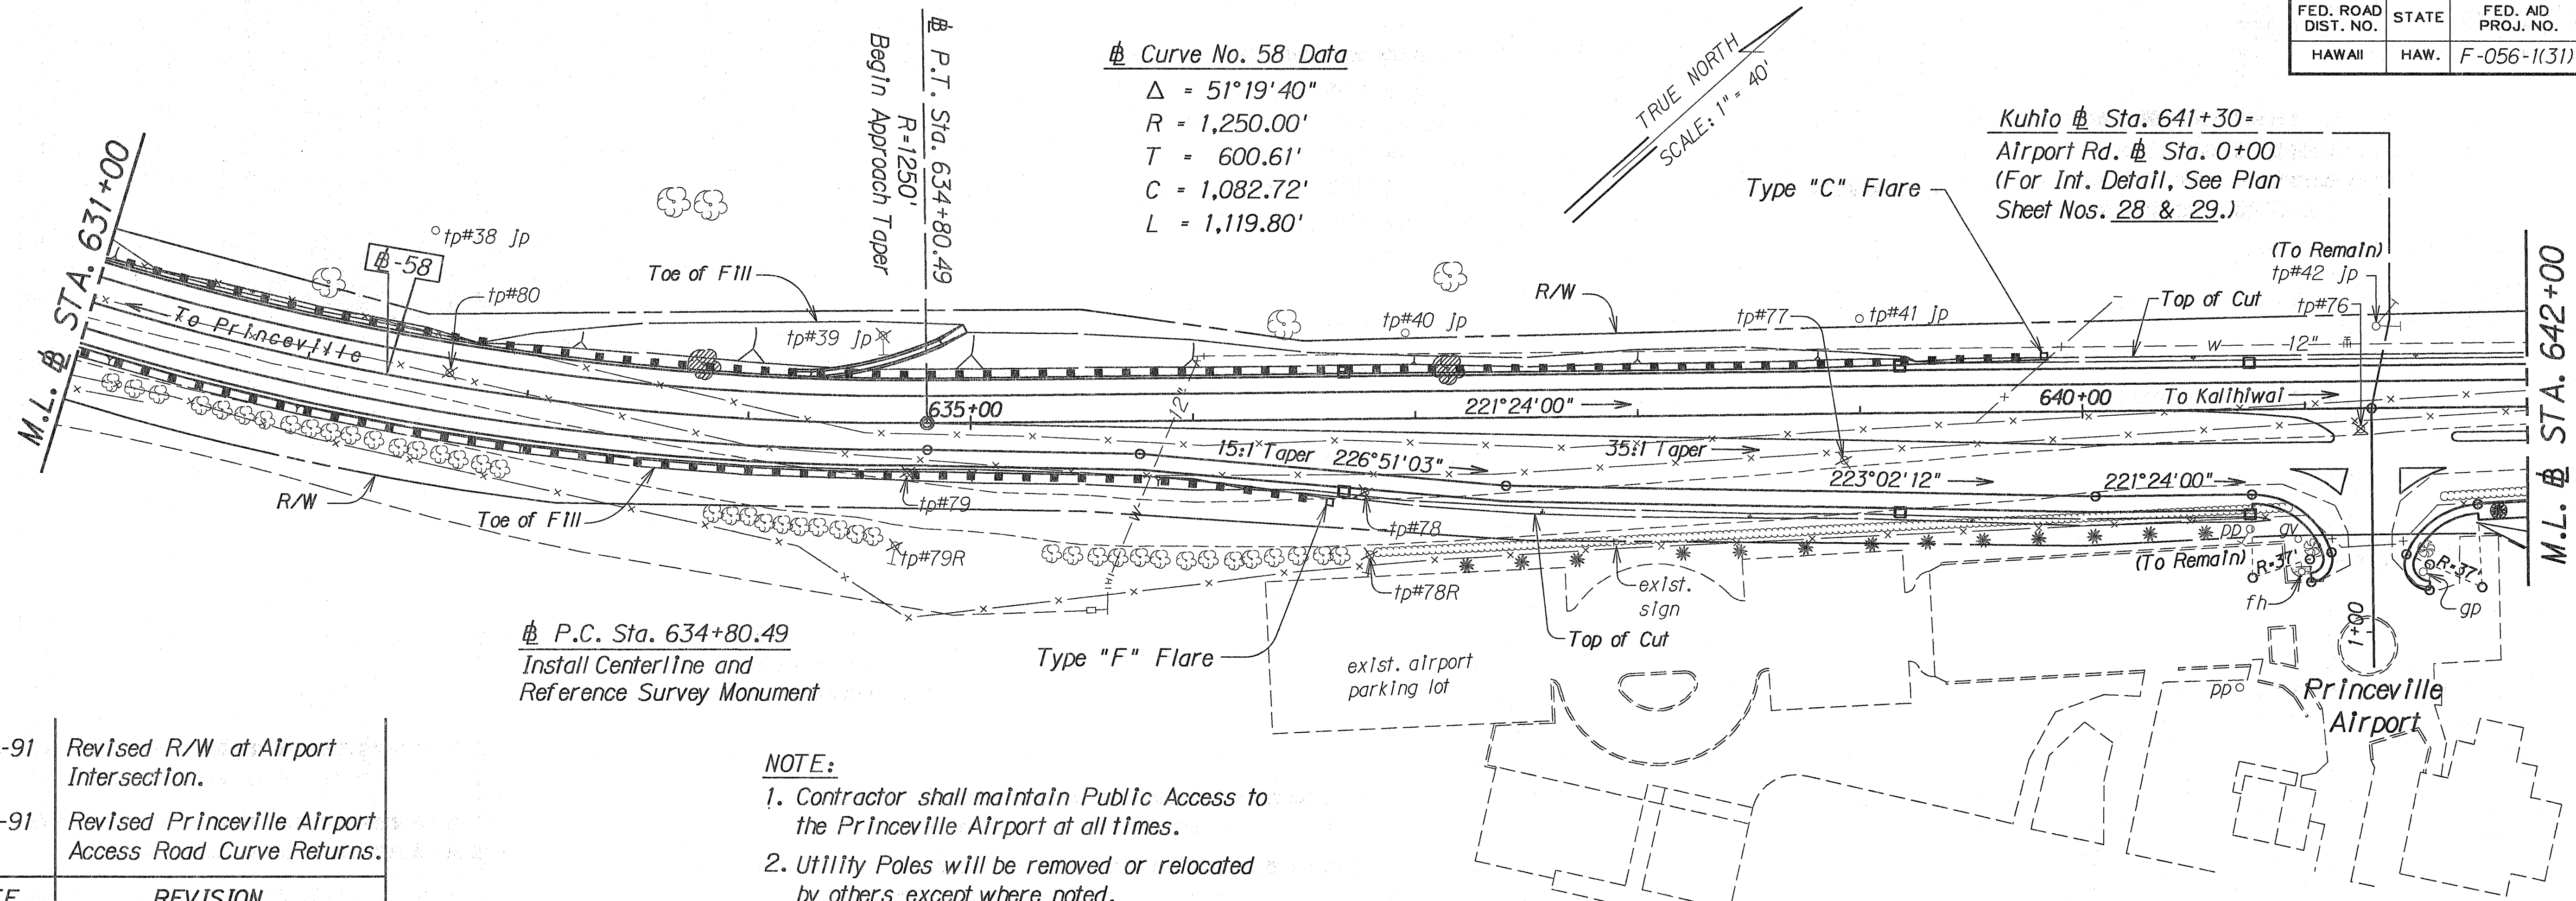

DATE	REVISION
11-27-91	Revised R/W at Airport Intersection.
11-12-91	Revised Princeville Airport Access Road Curve Returns.

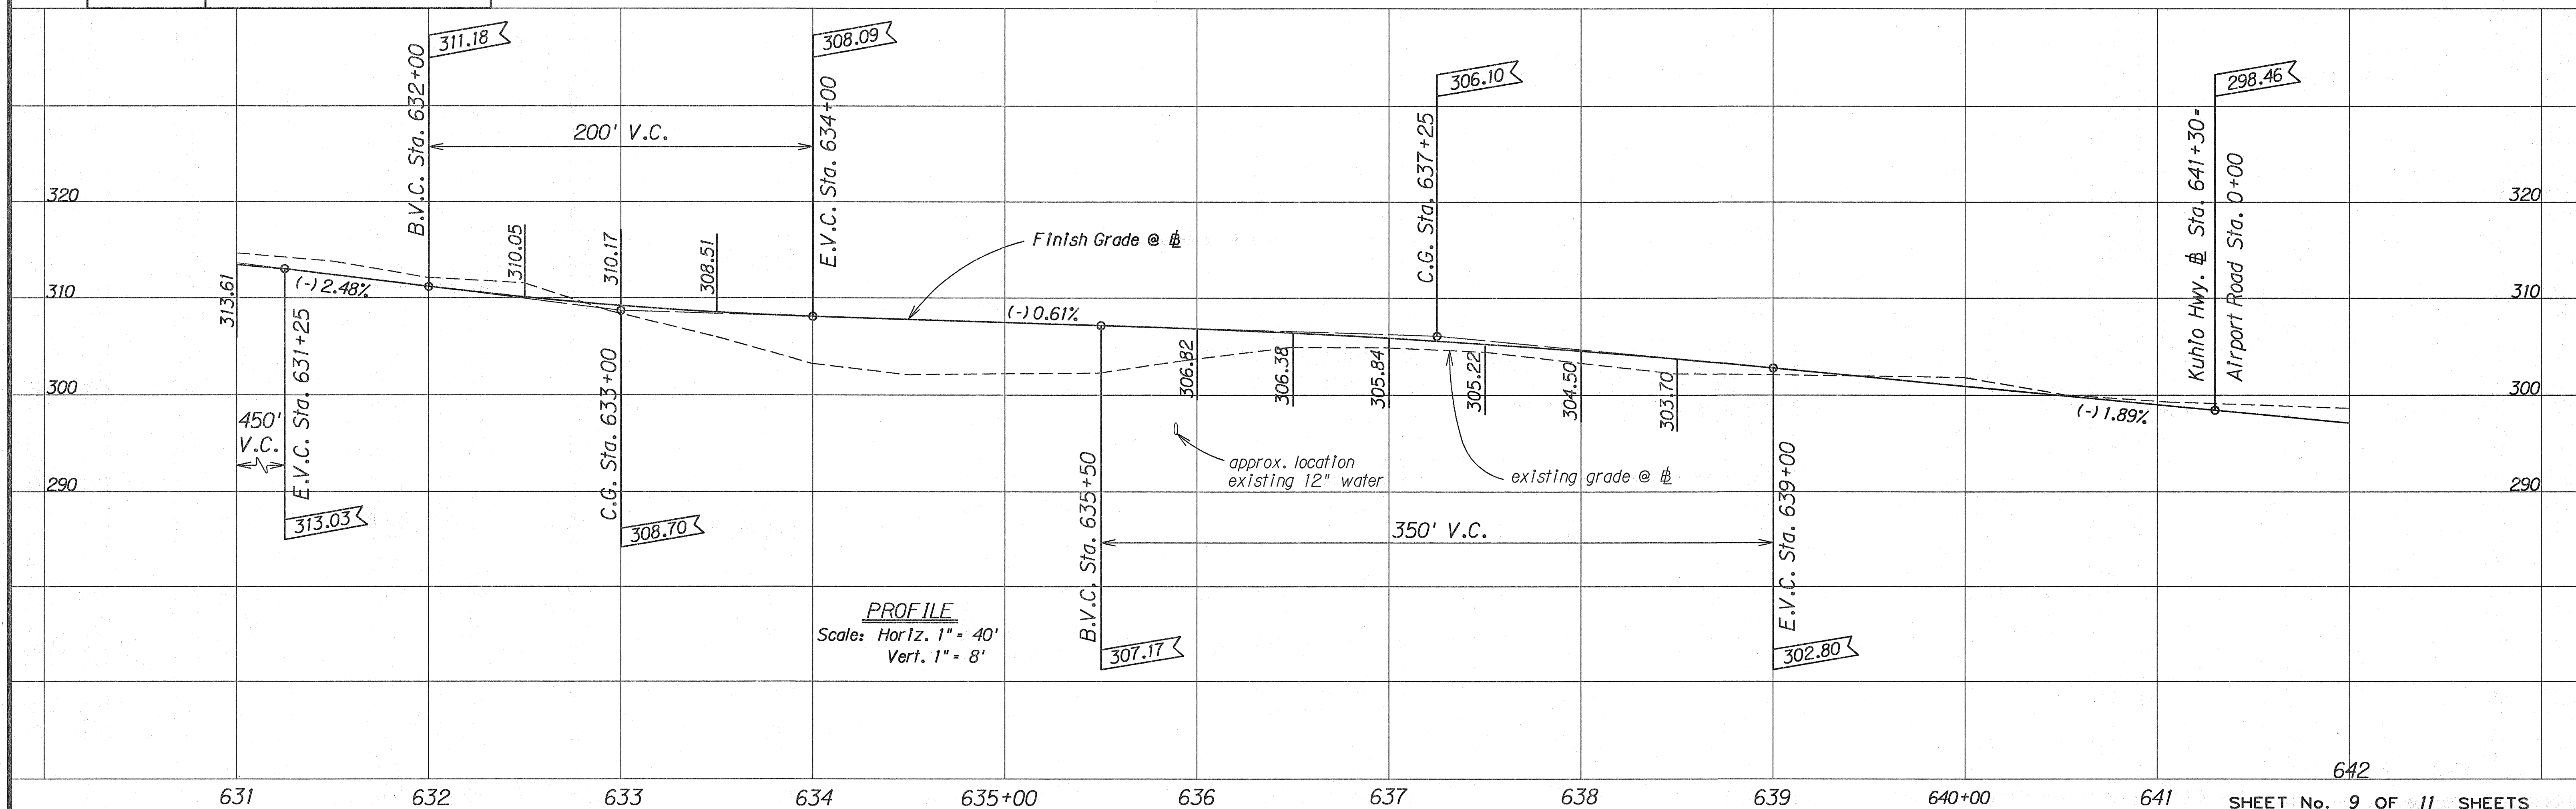


ORIGINAL PLAN	DATE
DESIGNED BY	
TRACED BY	
NOTE BOOK	
QUANTITIES BY	
CHECKED BY	
N.	

FED. ROAD DIST. NO.	STATE	FED. AID PROJ. NO.	FISCAL YEAR	SHEET NO.	TOTAL SHEETS
HAWAII	HAW.	F-056-1(31)	1991	16	126


Ⓜ P.C. Sta. 643+63.09
Install Centerline and
Reference Survey Monument

Ⓜ P.C. Sta. 649+41.56
Install Centerline and
Reference Survey Monument

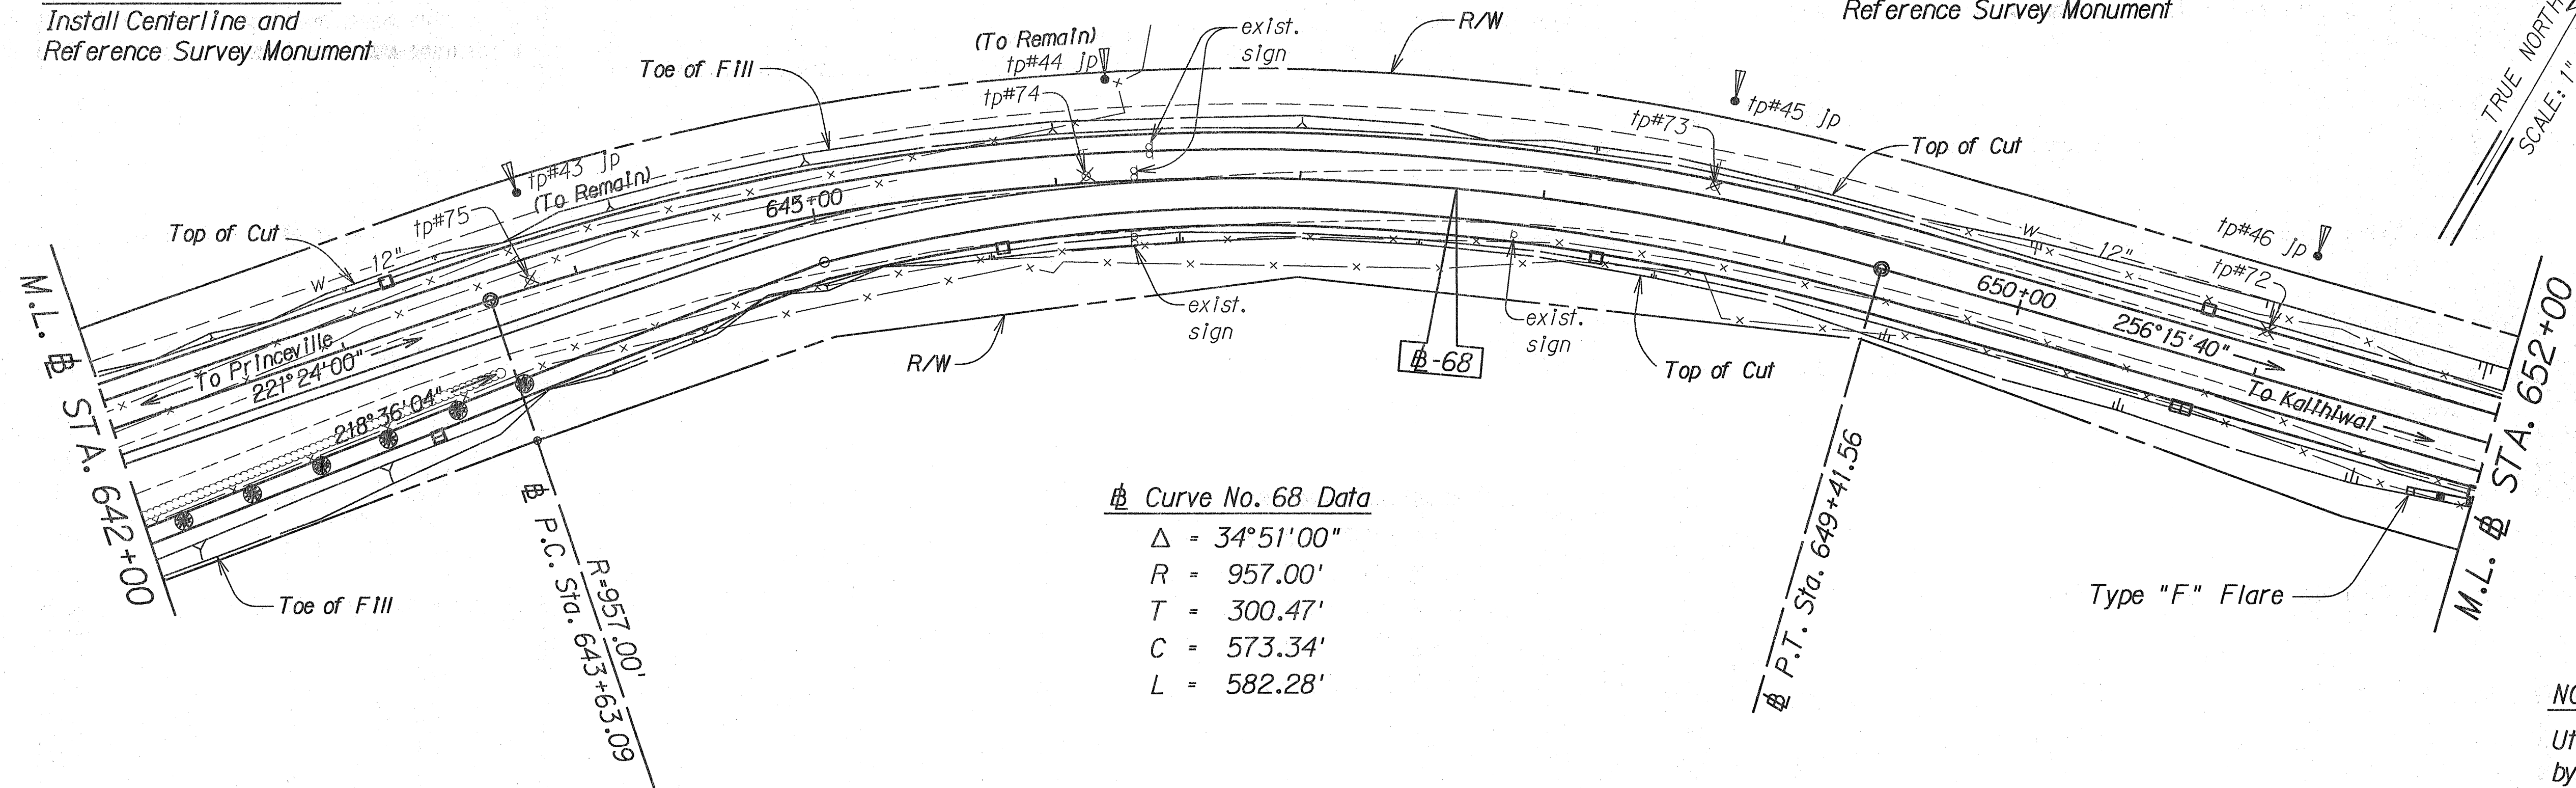


NOTE:

Utility Poles will be removed or relocated by others except where noted.

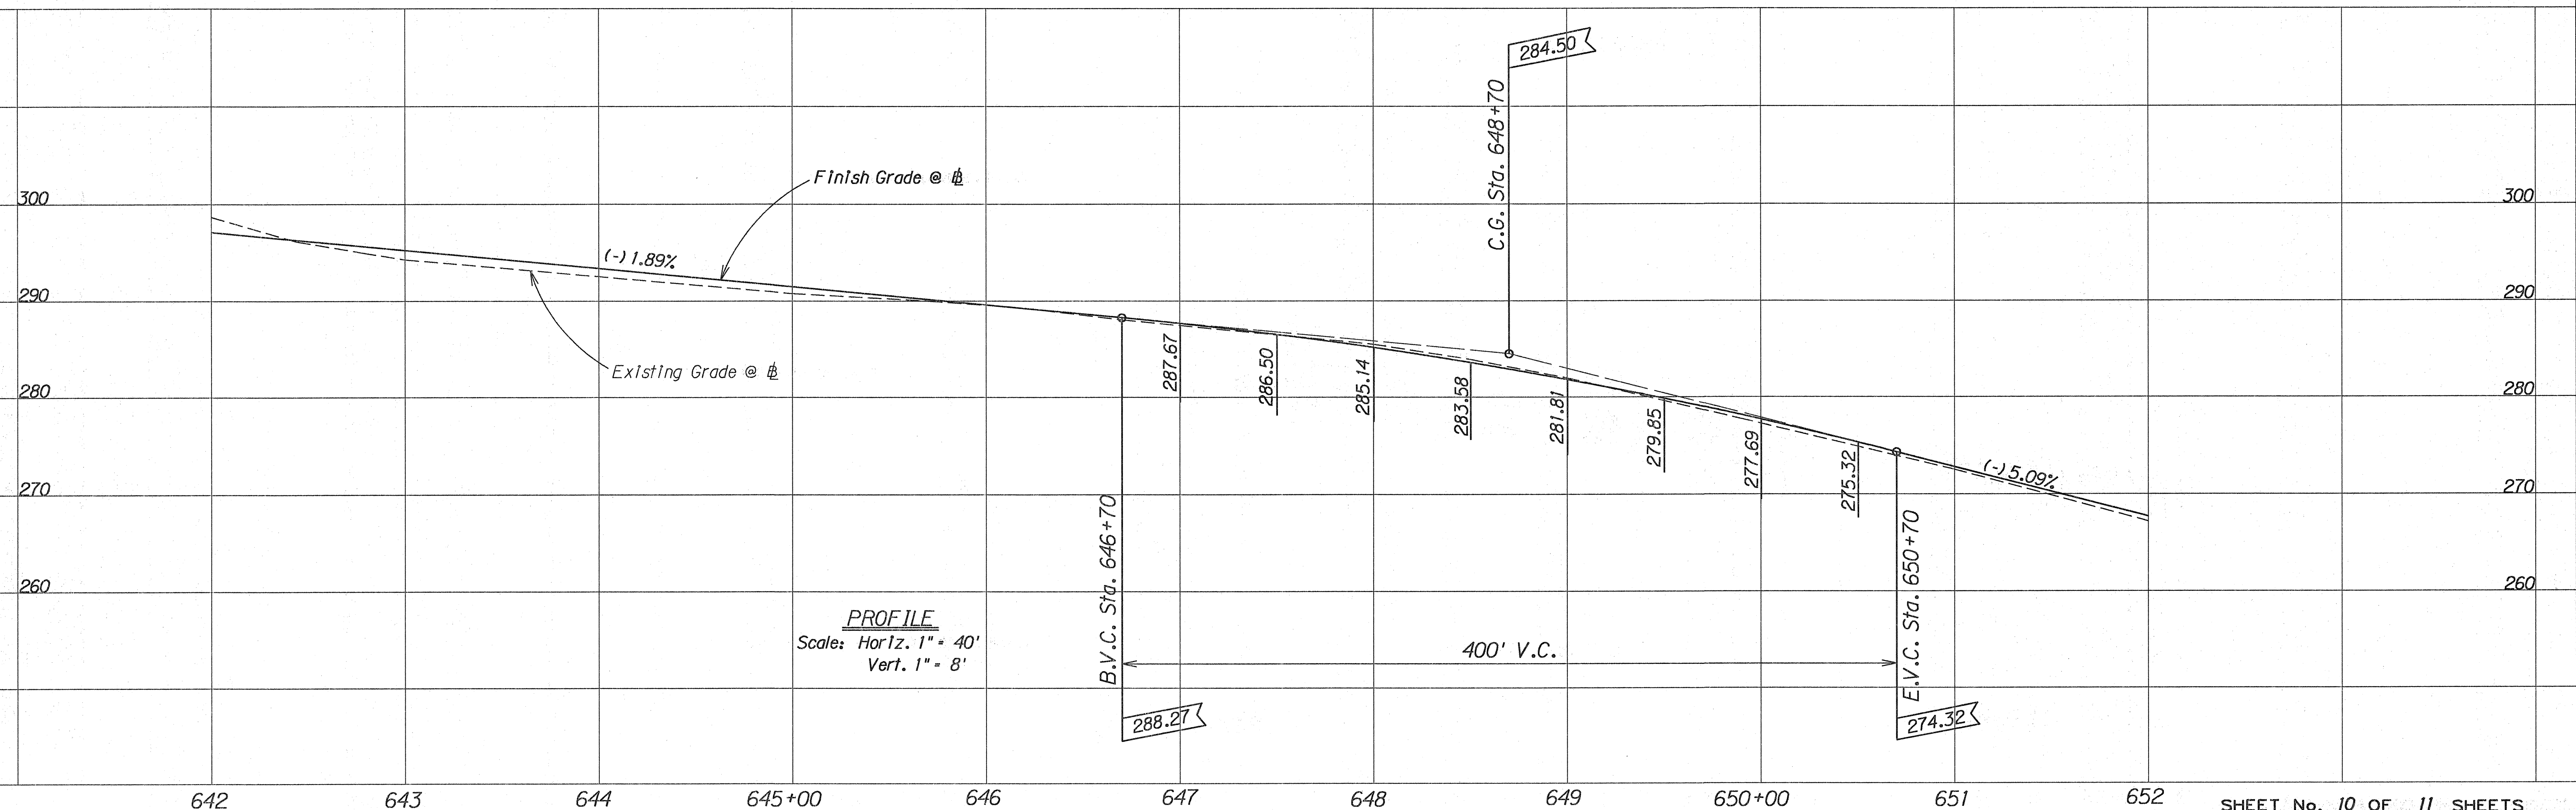


SURVEY PLOTTED BY	DATE
DESIGNED BY	
TRACED BY	
NOTE BOOK	
QUANTITIES BY	
CHECKED BY	
N.	

FED. ROAD DIST. NO.	STATE	FED. AID PROJ. NO.	FISCAL YEAR	SHEET NO.	TOTAL SHEETS
HAWAII	HAW.	F-056-1(31)	1991	17	126

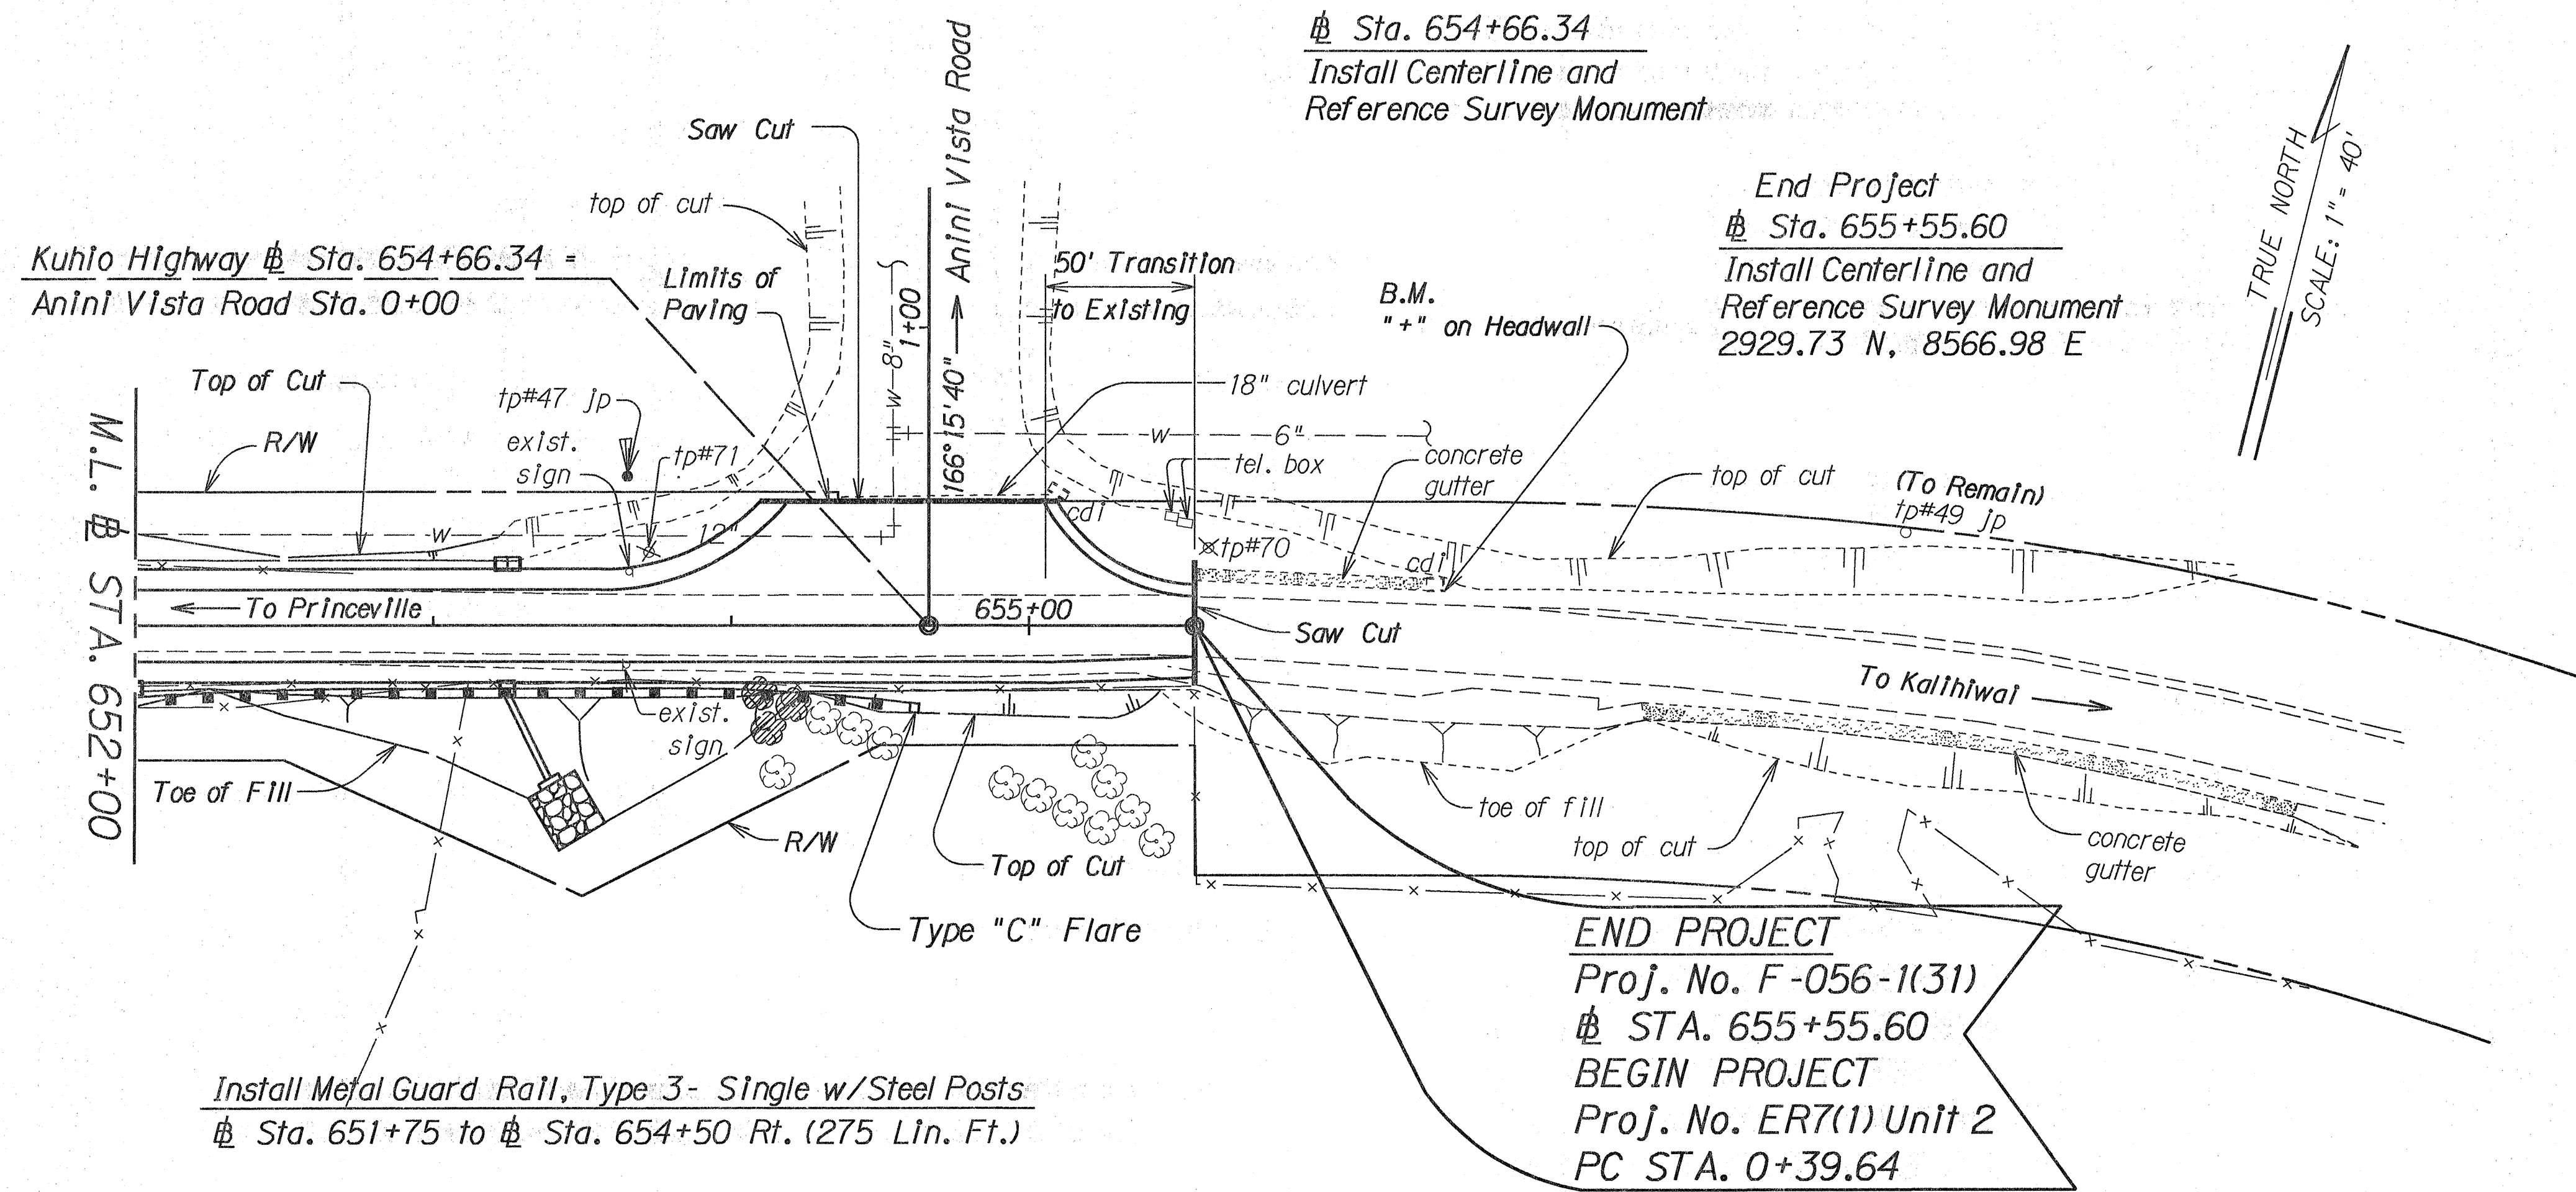

9-18-91	Revise Limits of Paving and Anni Vista Rd. Shoulder Returns
DATE	REVISION

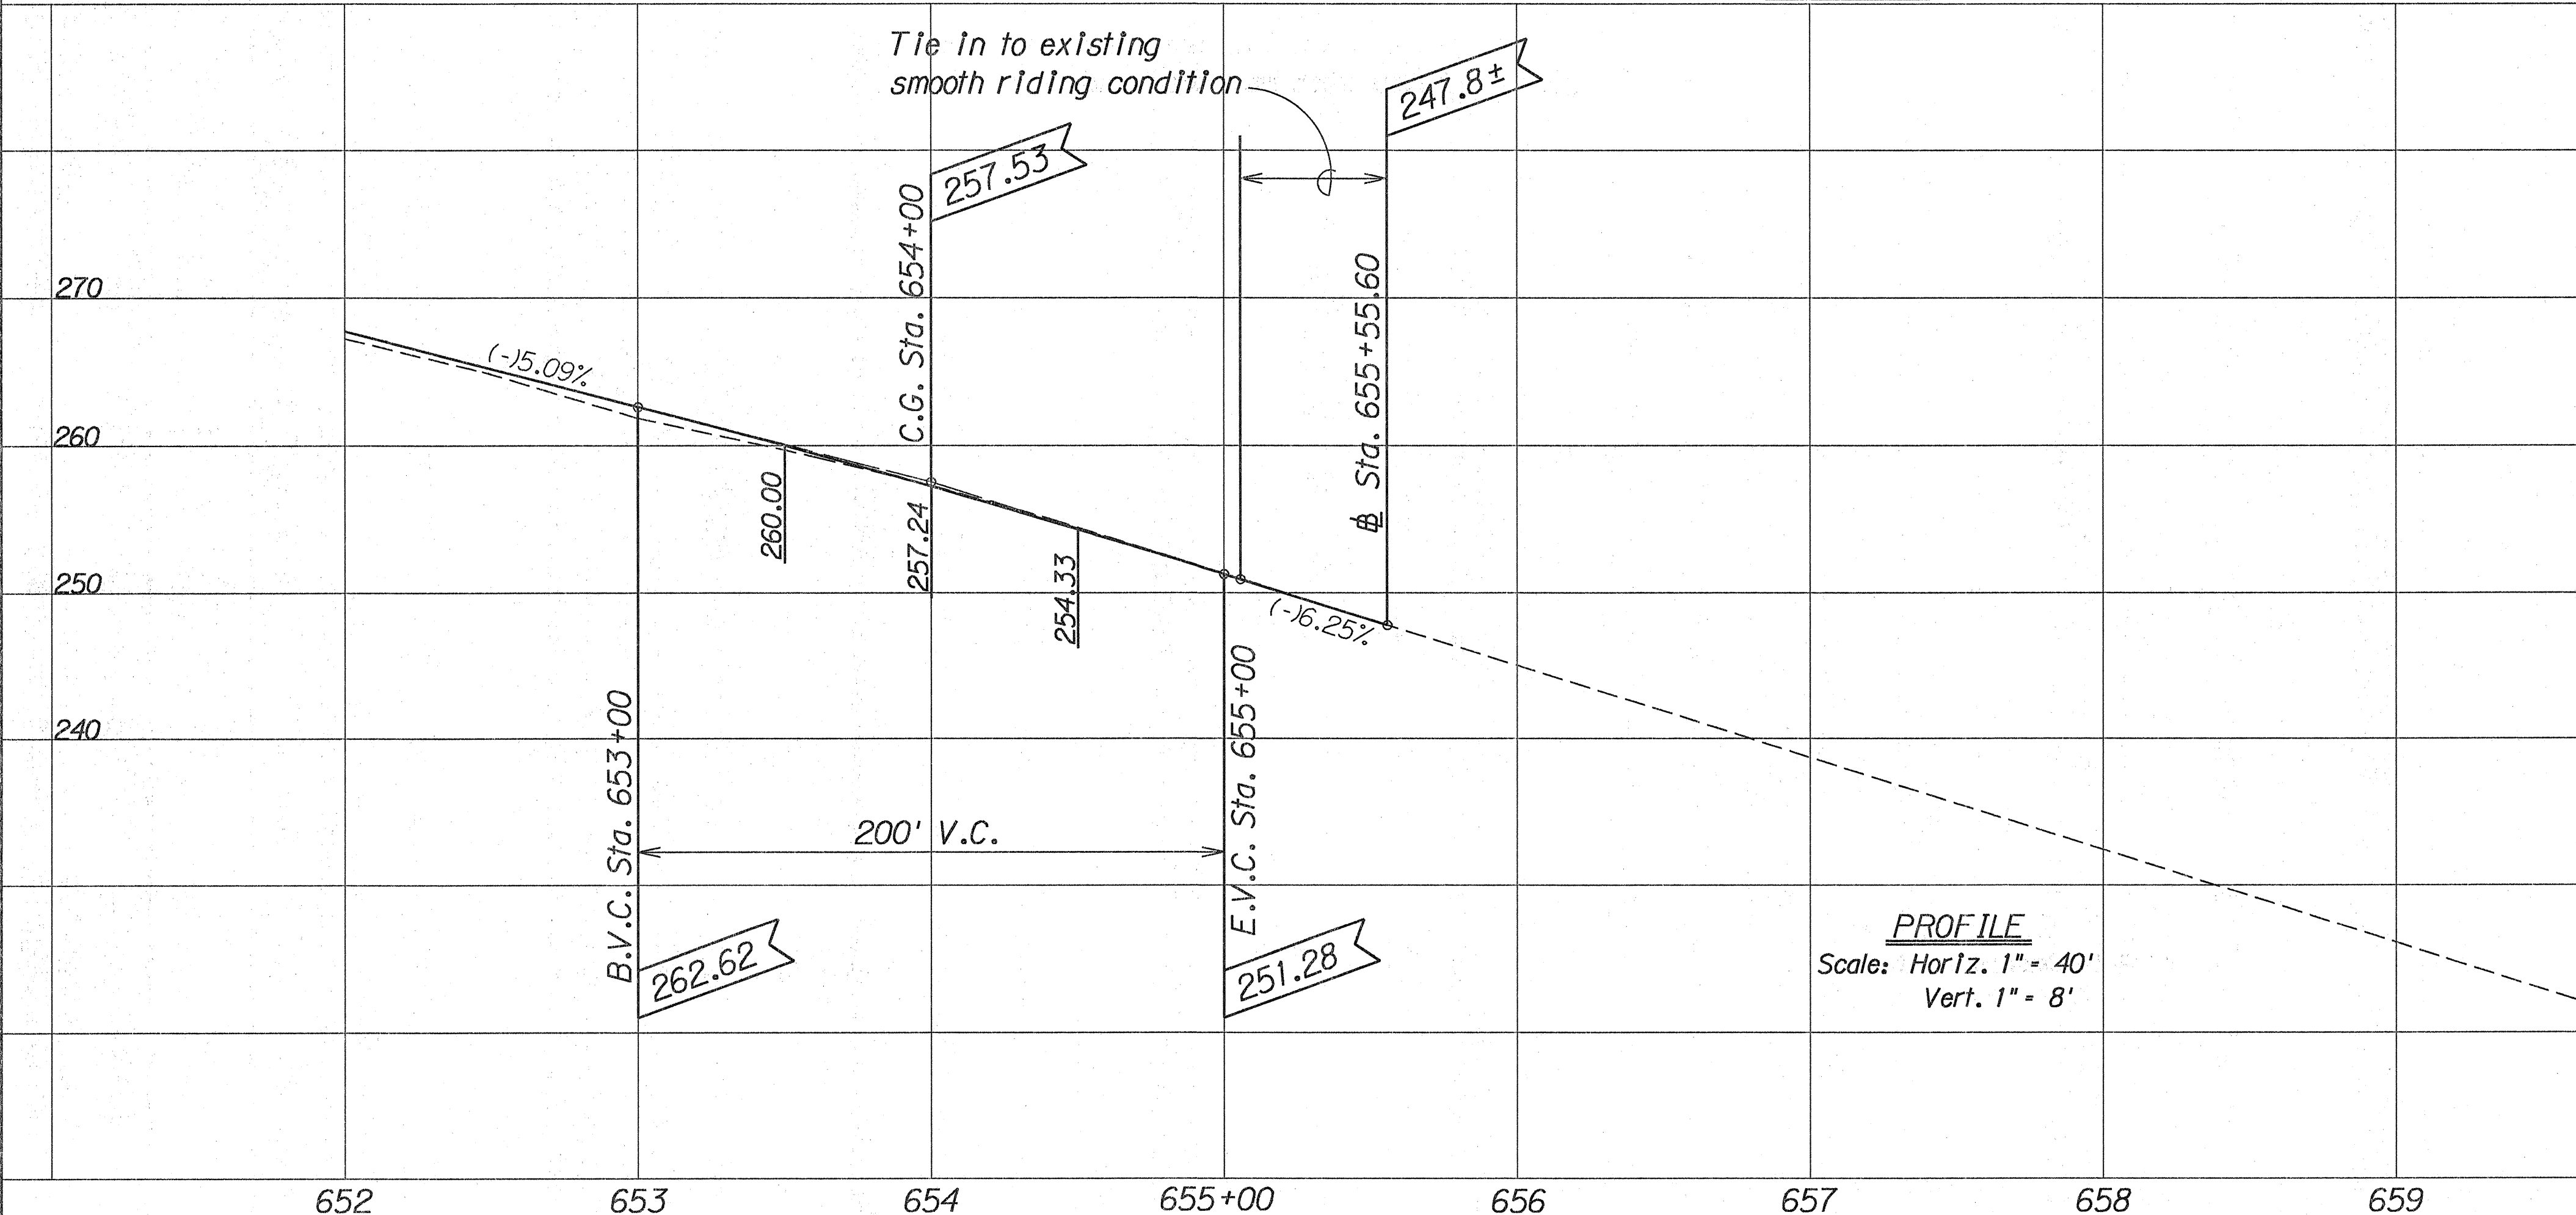

ORIGINAL PLAN	DATE
DESIGNED BY	
TRACED BY	
NOTE BOOK	
QUANTITIES BY	
CHECKED BY	