

INDEX TO DRAWINGS	
SHEET NO.	DESCRIPTION
1	TITLE SHEET
2	STANDARD PLANS SUMMARY
3	GENERAL NOTES & LEGEND
4-6	TYPICAL SECTIONS
7-17	PLAN & PROFILES
18-23	SUPERELEVATION DIAGRAMS
24-29	INTERSECTION DETAILS
30-32	UTILITIES
33-34	MISCELLANEOUS DETAILS
Δ 35-88	DRAINAGE PLANS & DETAILS
89-96	TRAFFIC SIGNING, PAVEMENT MARKING PLANS & DETAILS
97-124	CROSS SECTIONS
Δ 82A & 84A	ADDED SHEETS

STATE OF HAWAII

DEPARTMENT OF TRANSPORTATION

HIGHWAYS DIVISION

'AS-BUILT'

PLANS FOR




KUHIO HIGHWAY

PRINCEVILLE TO KALIHIWAI

FEDERAL AID PROJECT NO. F-056-1(31)

DISTRICT OF HANAIEI

ISLAND OF KAUAI

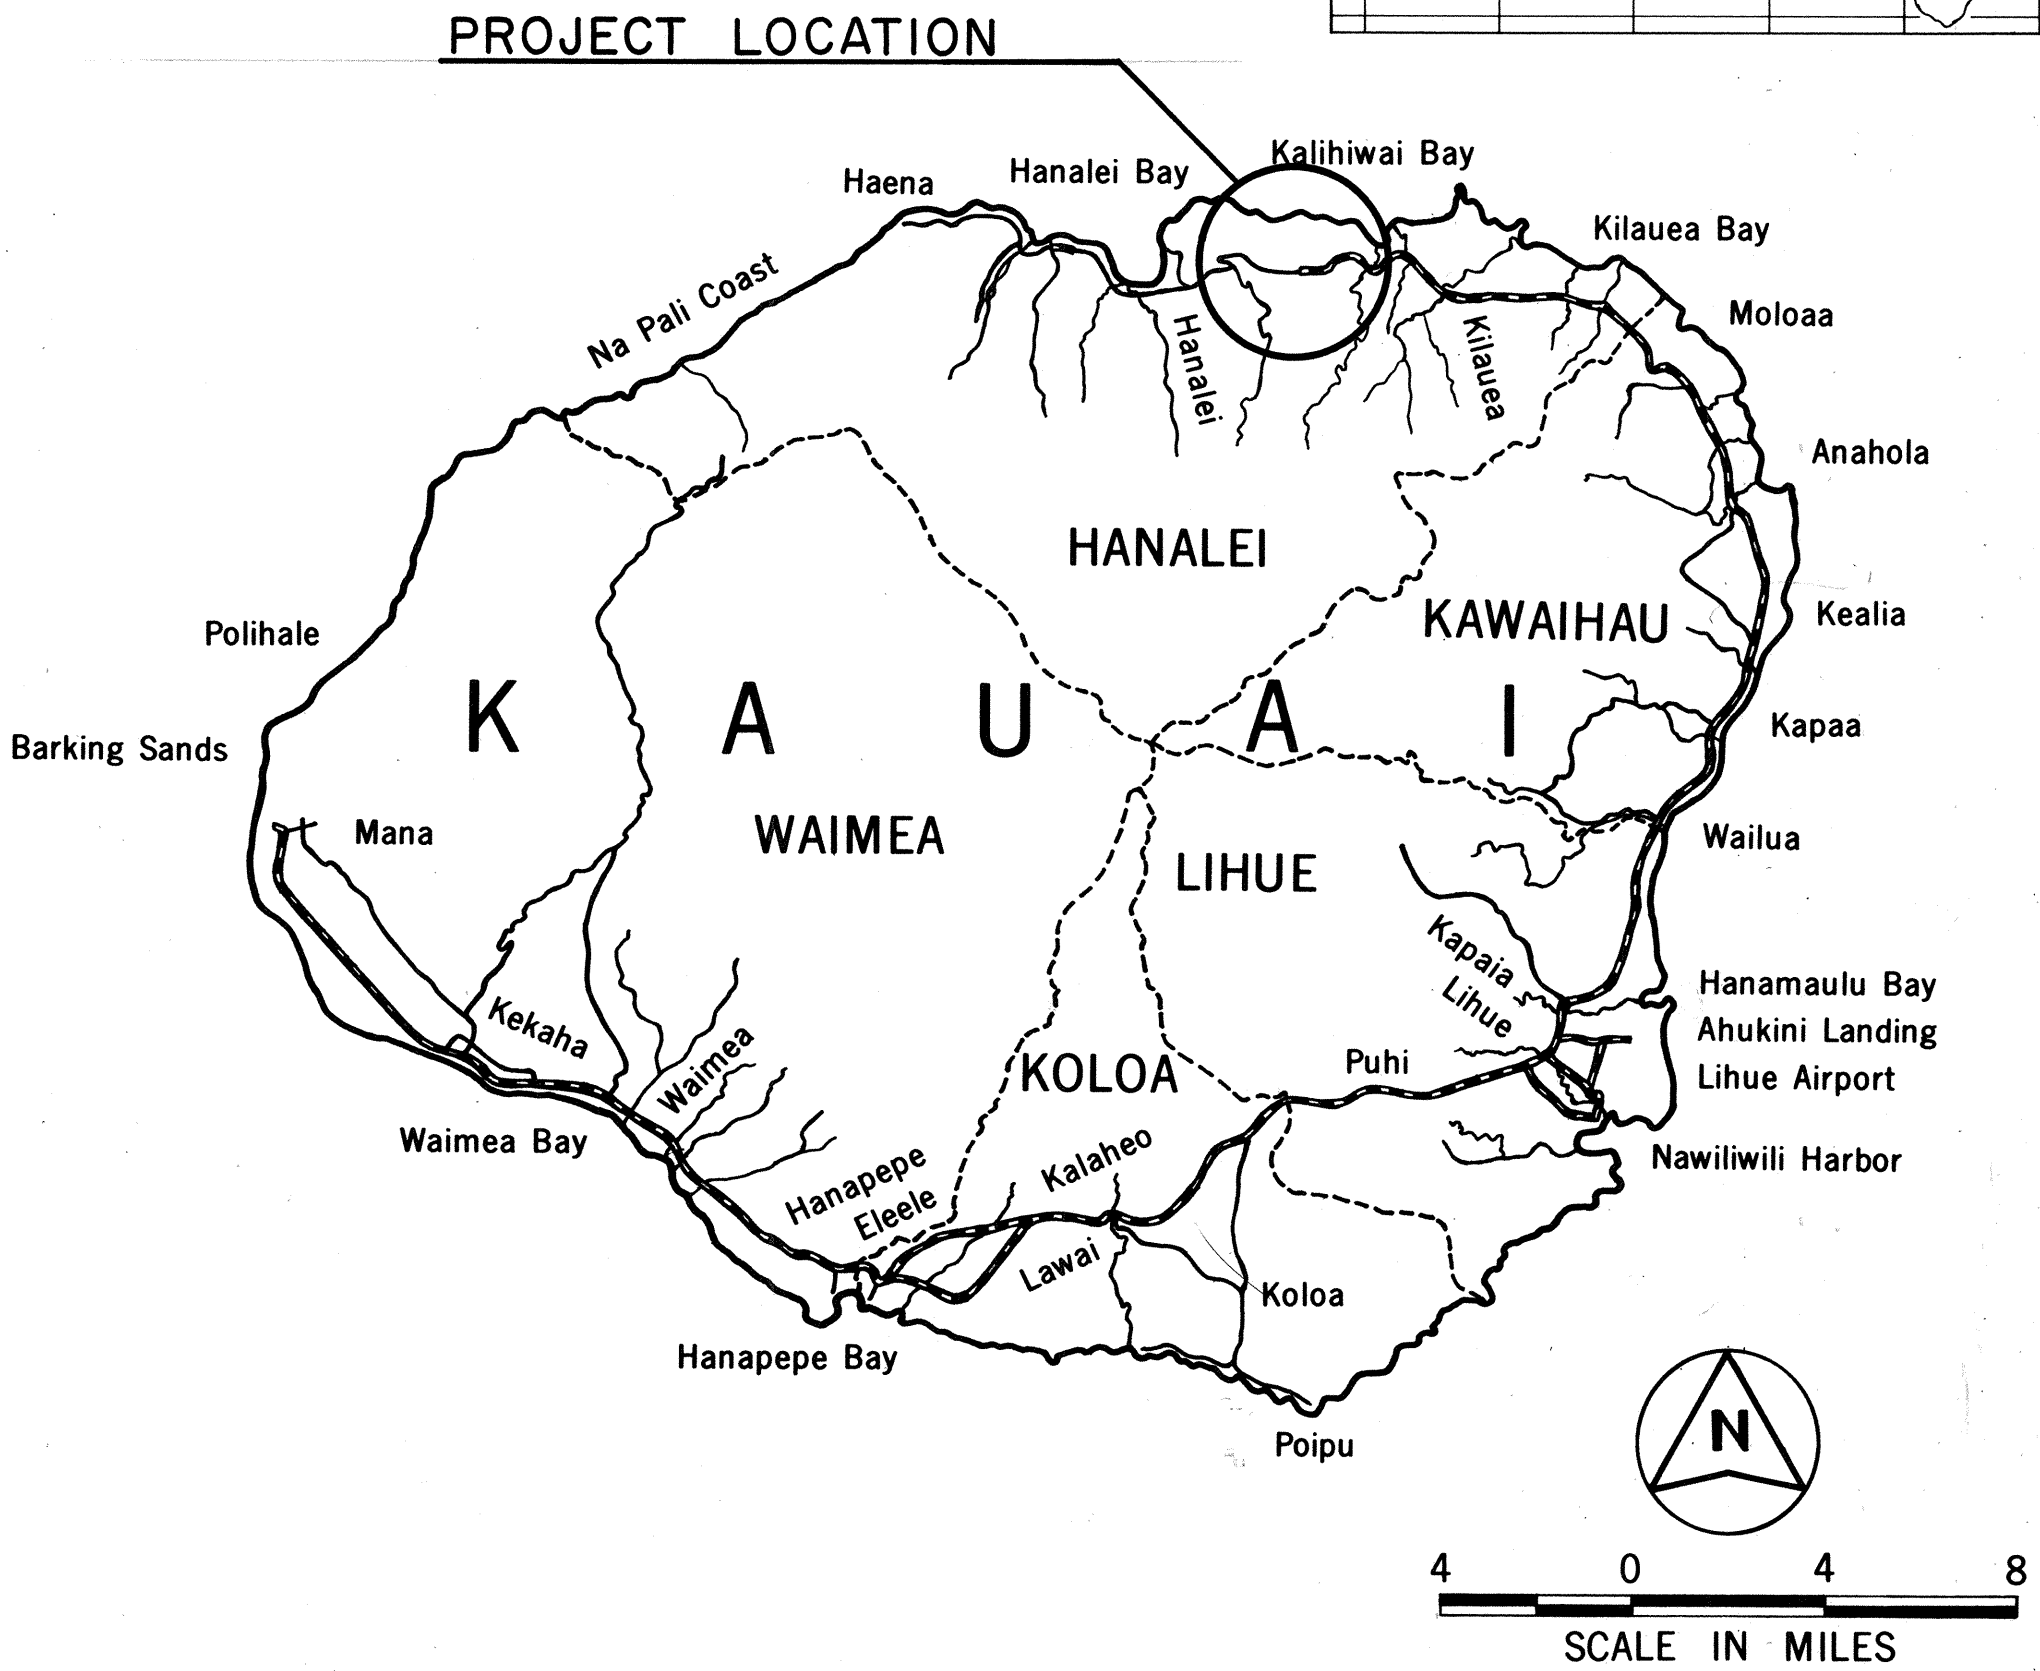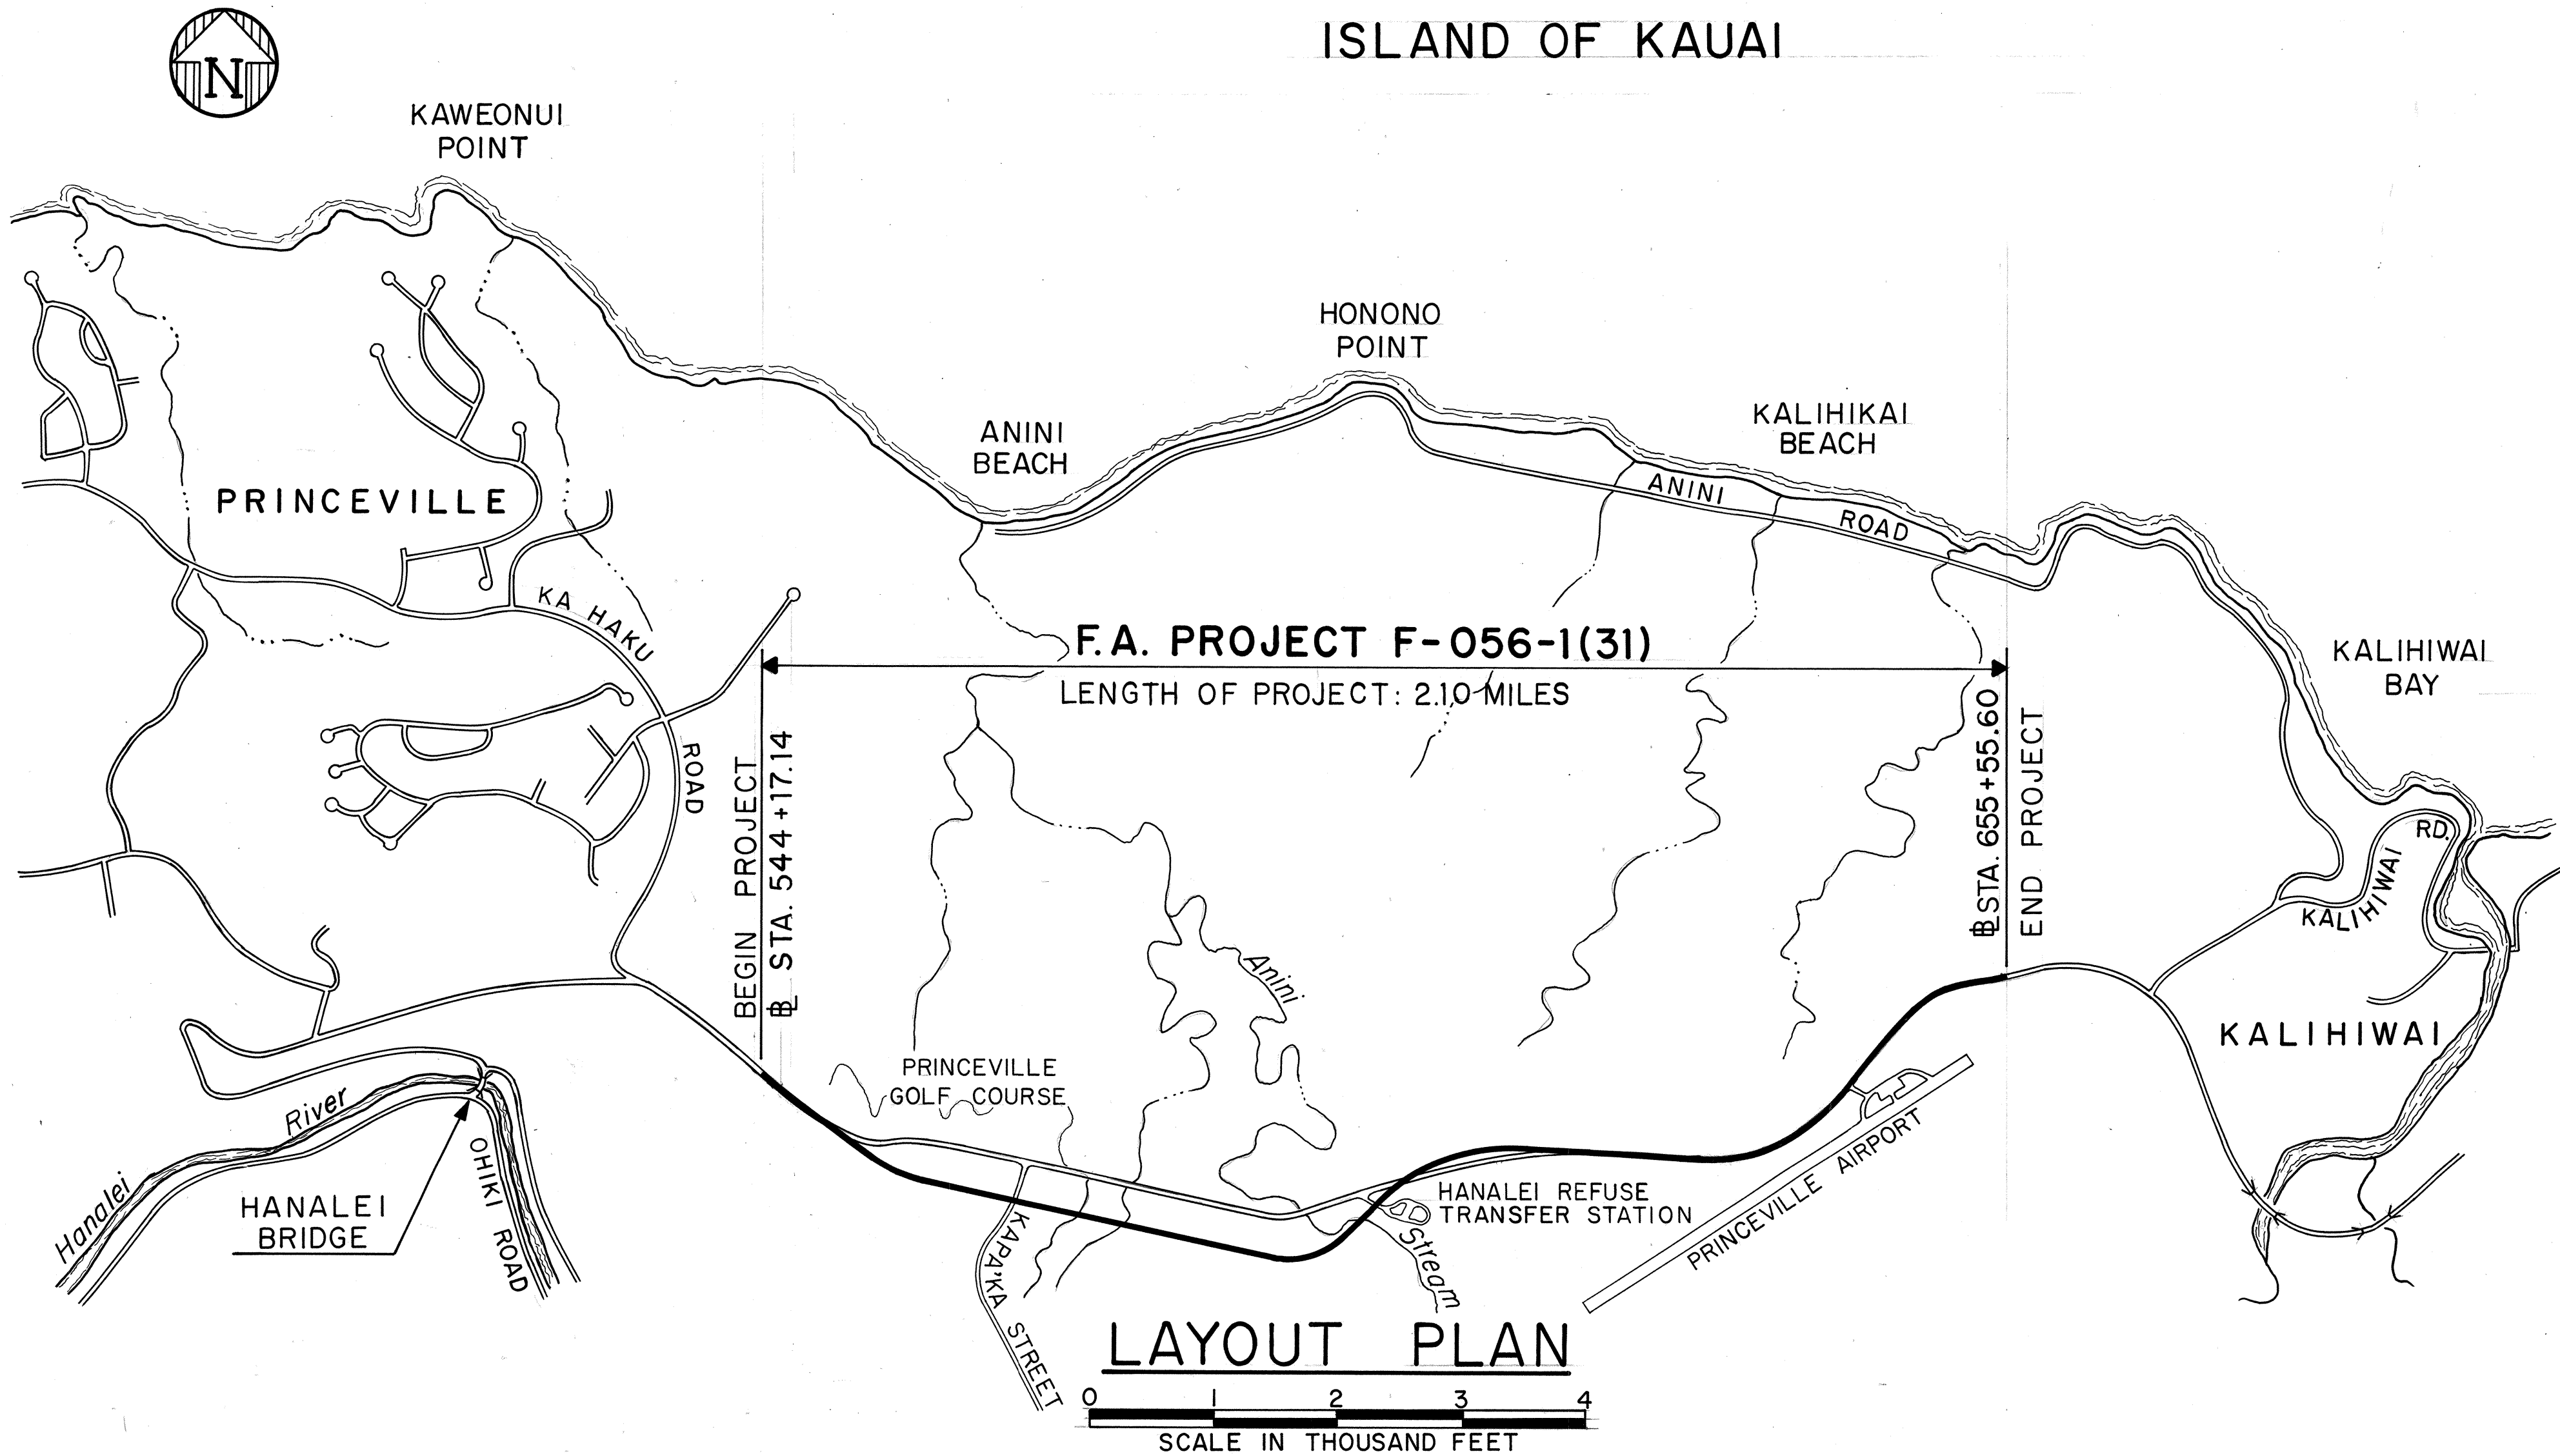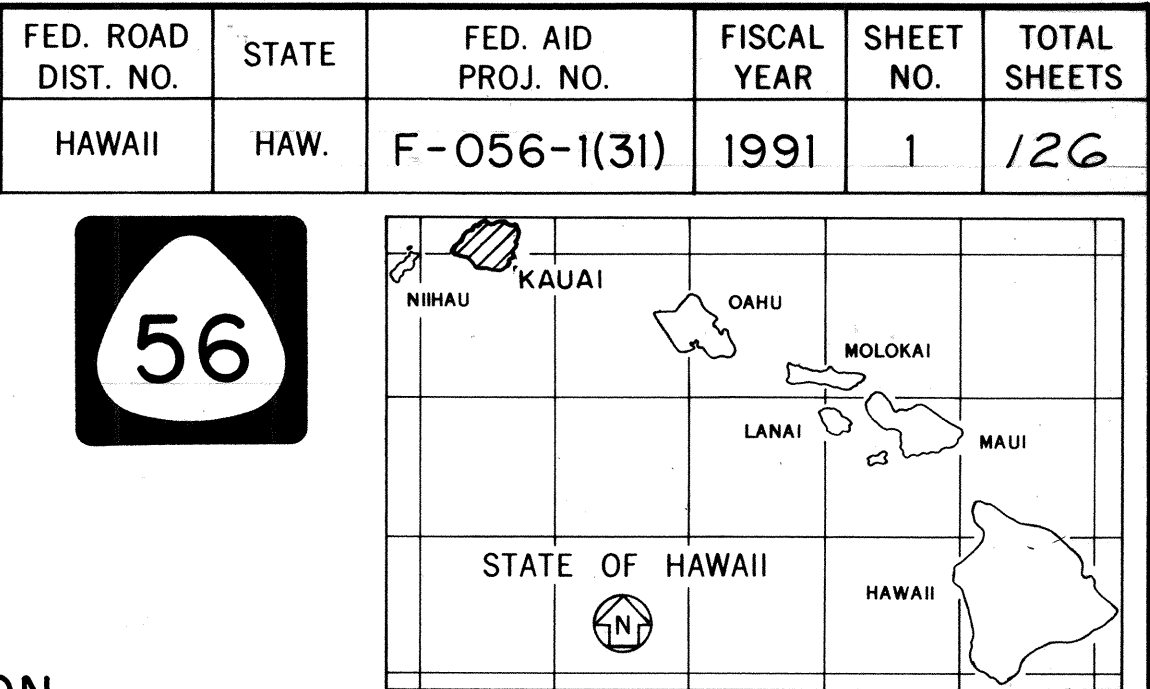

FEDERAL AID PROJECTS PREVIOUSLY CONSTRUCTED OR UNDER CONSTRUCTION
 MILE POST 25.63 TO MILE POST 27.73

DESIGN DESIGNATION	
ADT (1991)	7,900
ADT (2011)	13,700
DHV	1,300
D	55/45
T	4.5 %
K	9.5 %
V	40 M.P.H.

CHANGES MADE DURING CONSTRUCTION HAVE BEEN INCORPORATED ON THESE PLANS EXCEPT CHANGES IN THE ORIGINAL THEORETICAL QUANTITIES. FOR ACTUAL QUANTITIES, REFER TO PROJECT LEDGER AND/OR COMPUTATION BOOK.

4-20-02
 DATE

DEPARTMENT OF TRANSPORTATION
 FEDERAL HIGHWAY ADMINISTRATION
 APPROVED:
 10/29/91
 DATE

DEPARTMENT OF TRANSPORTATION
 STATE OF HAWAII
 APPROVED:
 10/23/91
 DATE

DESIGN UNIT "E"
 DESIGNED BY
 R. TAKAESU
 P. S. & E. BY
 548-7534
 PHONE
 MAR. 1991
 DATE

DD-10-10-2