


FED. ROAD DIST. NO.	STATE	FED. AID PROJ. NO.	FISCAL YEAR	SHEET NO.	TOTAL SHEETS
HAWAII	HAW.	F-056-1(31)	1991	31	126

TRUE NORTH
SCALE: 1" = 20'

P/EP
21/1

P/EP
21/1

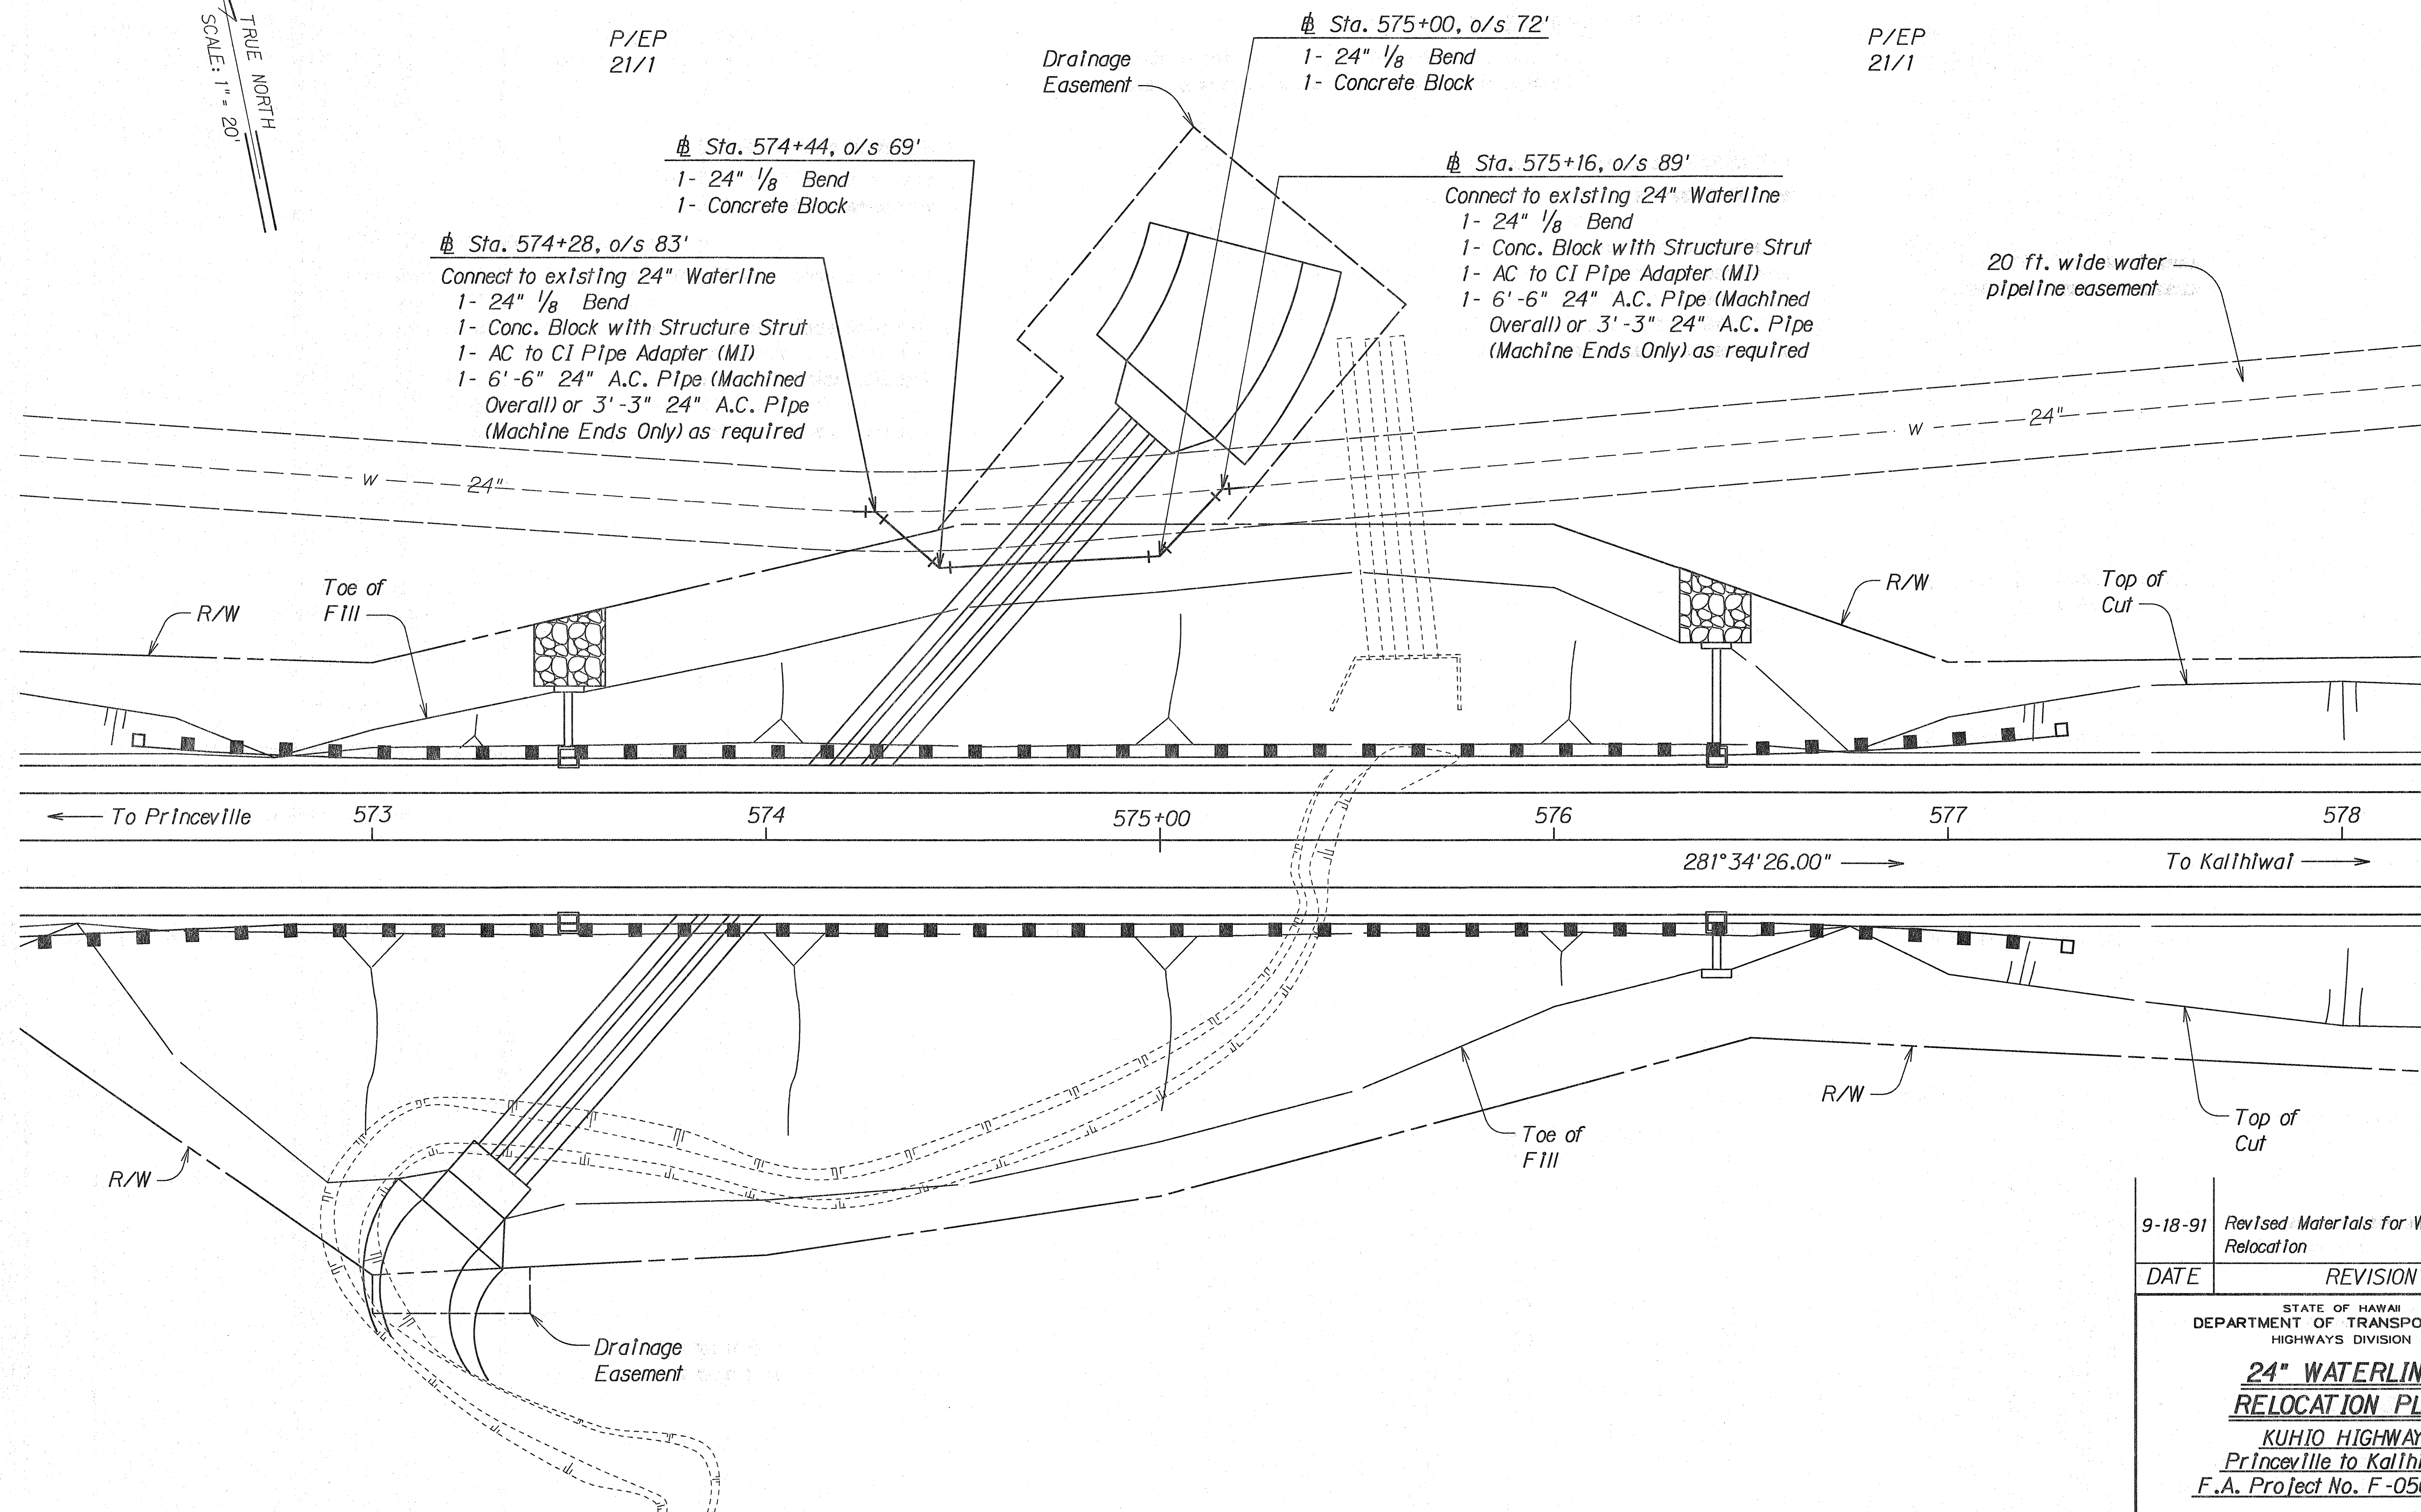

9-18-91 Revised Materials for Waterline Relocation

DATE REVISION

STATE OF HAWAII
DEPARTMENT OF TRANSPORTATION
HIGHWAYS DIVISION


**24" WATERLINE
RELOCATION PLAN**

KUHIO HIGHWAY
Princeville to Kalihwai
F.A. Project No. F-056-1(31)

Scale: 1" = 20' - 0" Date: June, 1991

SHEET No. 1 OF 1 SHEETS

FED. ROAD DIST. NO.	STATE	FED. AID PROJ. NO.	FISCAL YEAR	SHEET NO.	TOTAL SHEETS
HAWAII	HAW.	F-056-1(31)	1991	ADD. 32	126

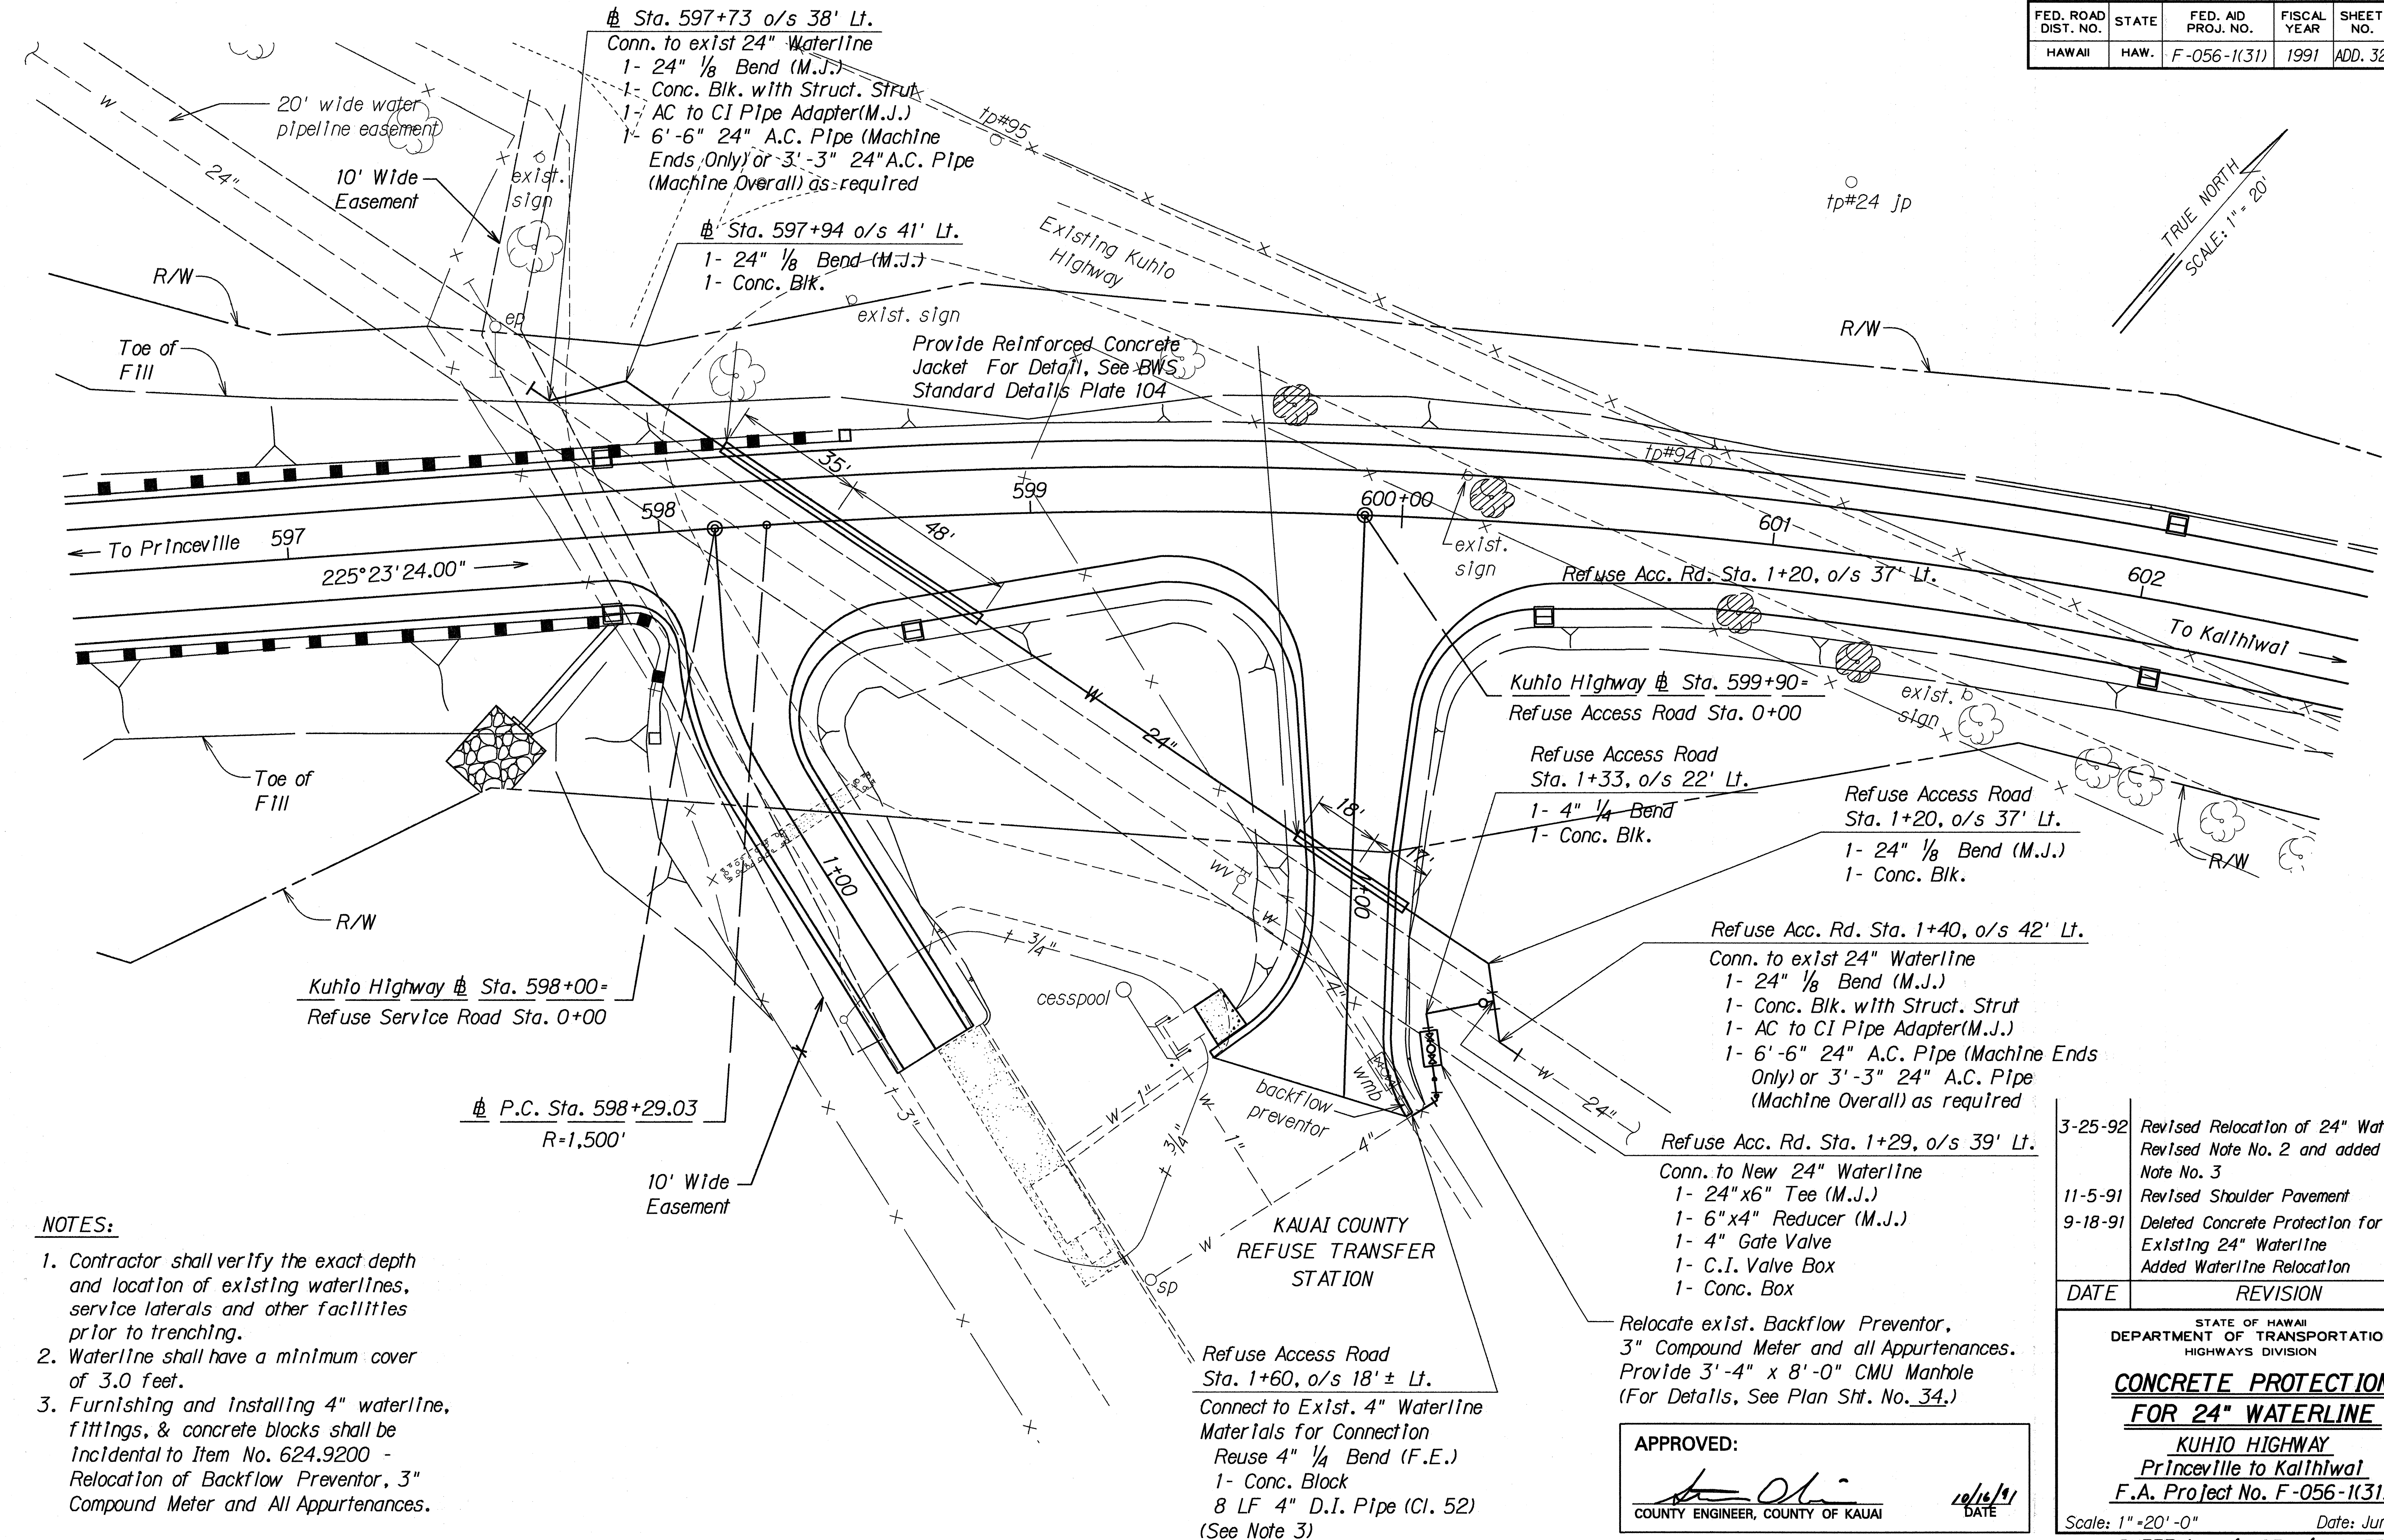

DATE	REVISION
3-25-92	Revised Relocation of 24" Waterline Revised Note No. 2 and added Note No. 3
11-5-91	Revised Shoulder Pavement
9-18-91	Deleted Concrete Protection for Existing 24" Waterline Added Waterline Relocation
DATE	REVISION
STATE OF HAWAII DEPARTMENT OF TRANSPORTATION HIGHWAYS DIVISION CONCRETE PROTECTION FOR 24" WATERLINE KUHIO HIGHWAY Princeville to Kalihwai F.A. Project No. F-056-1(31)	
Scale: 1"=20'-0" Date: June, 1991 SHEET NO. 1 OF 1 SHEETS	

APPROVED:

 COUNTY ENGINEER, COUNTY OF KAUAI
 10/15/91
 DATE