
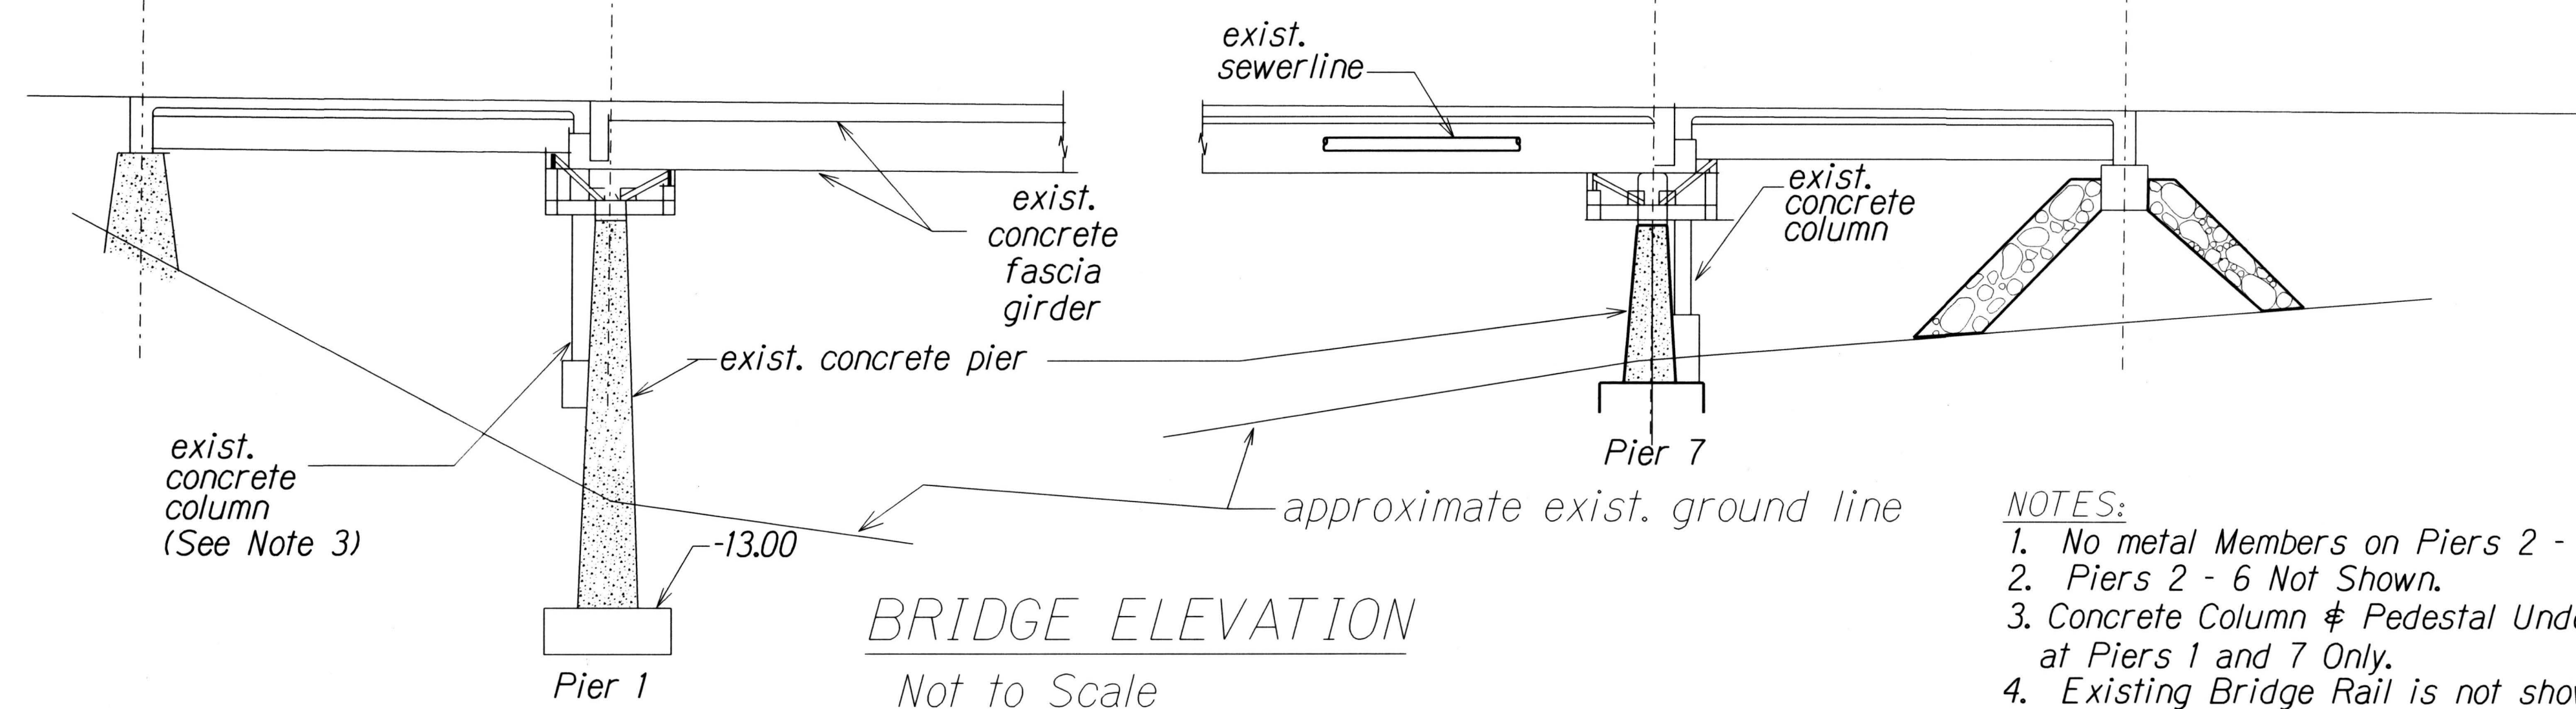


FED. ROAD DIST. NO.	STATE	PROJ. NO.	FISCAL YEAR	SHEET NO.	TOTAL SHEETS
HAWAII	HAW.	56A-01-16M	2017	7	17

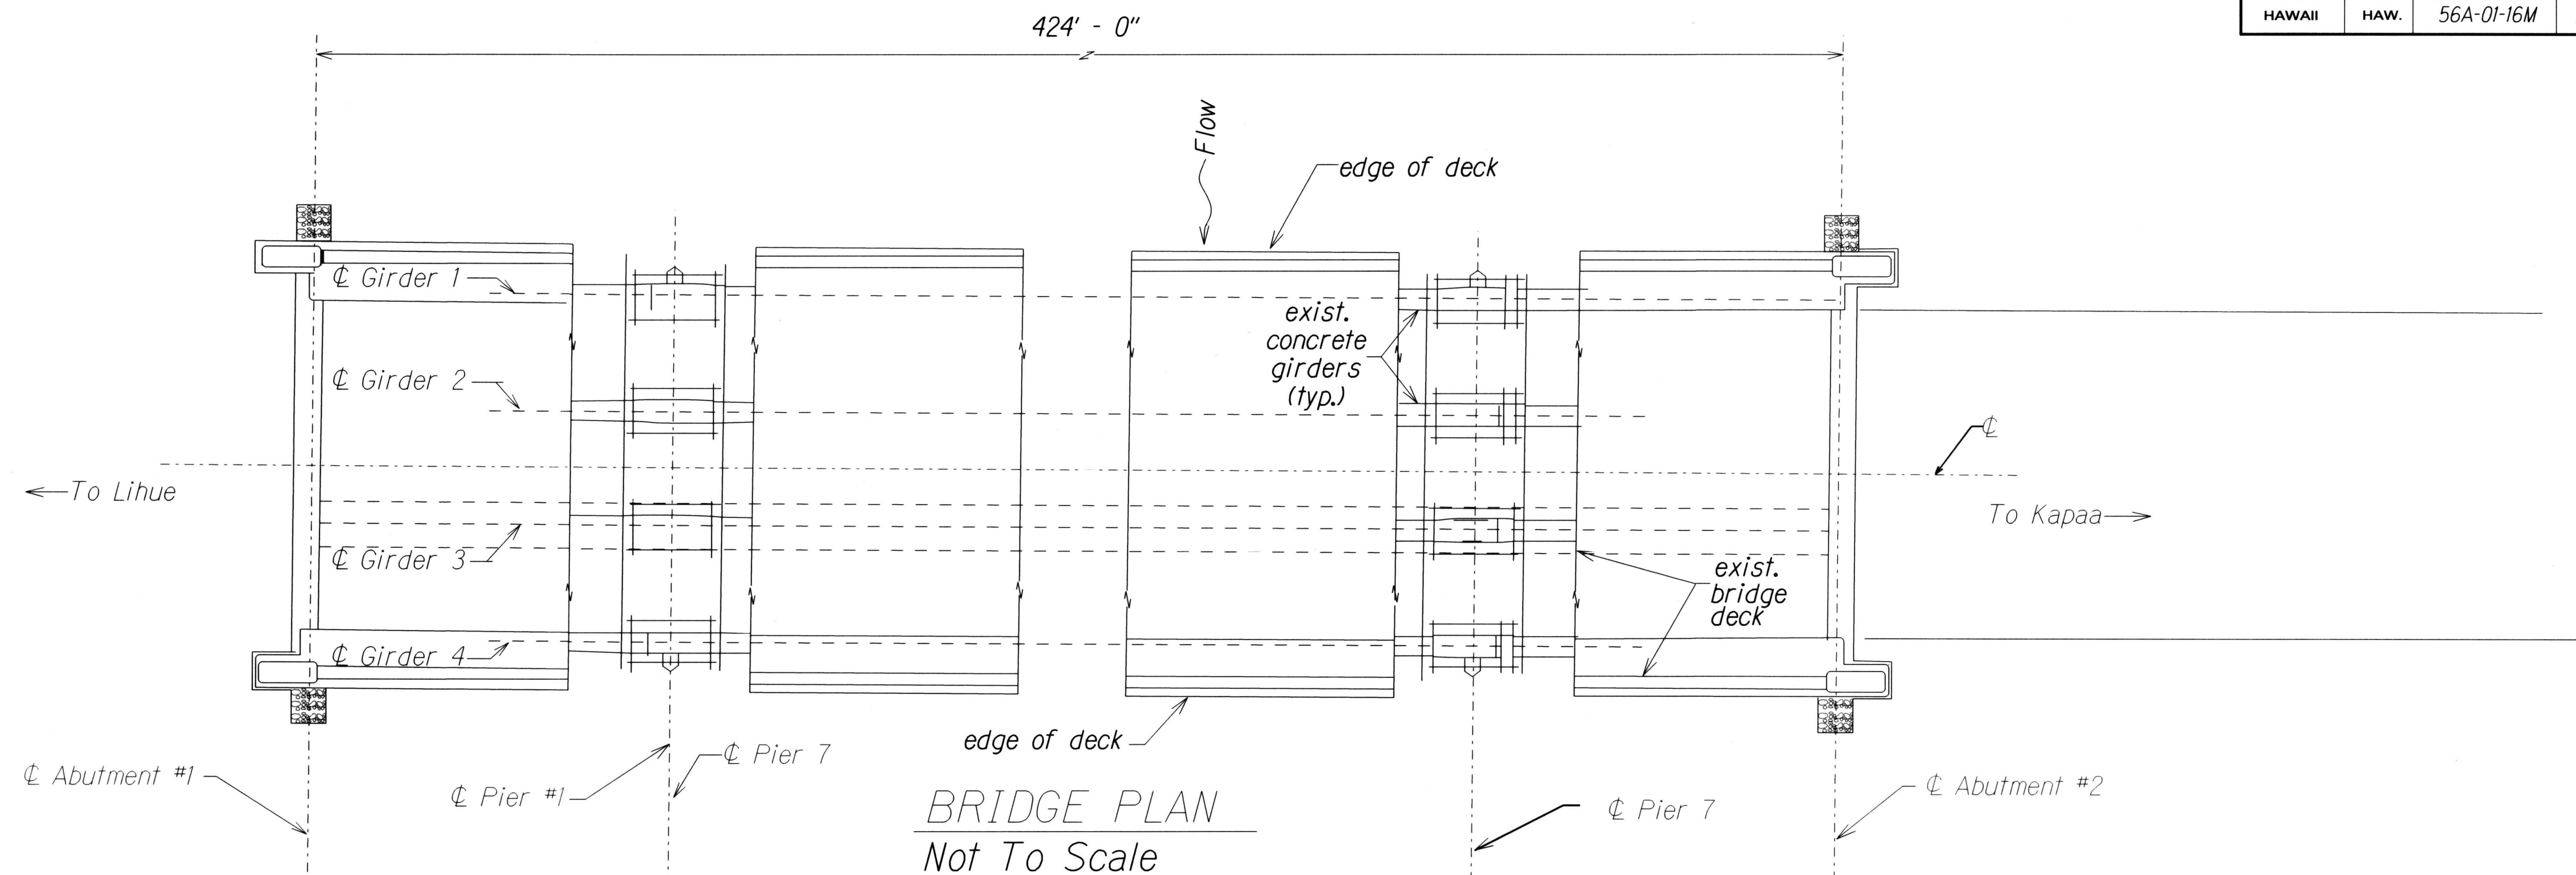

- NOTES:**
1. No metal Members on Piers 2 - 6.
 2. Piers 2 - 6 Not Shown.
 3. Concrete Column & Pedestal Under Each Girder at Piers 1 and 7 Only.
 4. Existing Bridge Rail is not shown.

For Reference Only

SURVEY PLOTTED BY	DATE
DRAWN BY	
NOTED BY	
CHECKED BY	
ORIGINAL PLAN	
NOTE BOOK	
QUANTITIES BY	
CHECKED BY	

STATE OF HAWAII
DEPARTMENT OF TRANSPORTATION
HIGHWAYS DIVISION

BRIDGE PLAN & ELEVATION

KUHIO HIGHWAY
Bearing Repairs at
Wailua River Bridge (Pier 1)
Project No. 56-01-16M

Scale: Not to Scale Date: March 2017

SHEET No. 7 OF 17 SHEETS