GENERAL NOTES

- 1. The scope of work for this project includes reconstructing weakened pavement areas; cold planing; resurfacing; adjusting utility manholes and boxes; installing centerline and reference survey monuments and metal guardrails; removing and installing pavement markings and traffic signs; cleaning culverts and drainage structures; and dressing of shoulders.
- 2. The Contractor is reminded of the requirements of Subsection 105.16 -Subcontracts.
- 3. The Contractor's attention is directed to the following Sections of the Special Provisions: Subsection 107.06 - Contractor Duty Regarding Public Convenience; Subsection 104.11 - Utilities and Services; and Section 645 - Work Zone Traffic Control.
- 4. At the end of each day's work, the Contractor shall remove all equipment and other obstructions to permit free and safe passage of public traffic.
- 5. The existence and location of underground utilities, manholes, monuments and structures as shown on the plans are from the latest available data but the accuracy is not guaranteed. The encountering of other obstacles during the course of work is possible. The Contractor shall be held liable for any damages incurred to the existing facilities and/or improvements as a result of his operations.
- 6. The exact locations and limits or areas to be excavated, reconstructed and cold planed shall be determined in the field by the Engineer.
- 7. All paving works including cold planing, pavement reconstruction, and resurfacing shall be done at night, except for the period from September 15, 2009 to December 31, 2009. During this period, paving works may be done during daytime working hours. Night time working hours are specified in Subsection 107.03 of the Special Provisions.

Daytime operations and working hours are also specified in Subsection 107.03 of the Special Provisions.

- The Contractor shall notify the Engineer in writing, two (2) weeks prior to starting paving operations.
- 9. The Contractor shall remove and dispose of all existing raised pavement markers and traffic tapes prior to the overlaying of Asphalt Concrete. This work shall be considered incidental to Hot Mix Asphalt Pavement. Mix No. IV and will not be paid for separately.
- 10. Smooth riding connections shall be constructed at all limits of resurfacing, including the beginning and end of project, connecting approaches, side streets and driveways as shown on the plans.
- 11. Trimming and dressing of shoulder, sidewalk and bus turnout shall consist of clearing, grubbing, grading, reshaping and compacting the unpaved shoulders with suitable material as shown on the plans and/or as directed by the Engineer. Suitable materials shall include materials from roadway excavation, including topsoil and base material therefrom, and if necessary, additional materials from borrow outside the limits of the right of way. Asphalt concrete removed from cold planing, reconstruction and roadway excavation shall not be used for dressing of shoulder, sidewalk or bus turnout. This work shall be considered incidental to the various contract items.
- 12. Earth swale shall be graded to drain. Graded swales shall be grassed. This work shall be considered incidental to the various contract items.
- 13. Existing drainage system will be functional at all times during construction. The Contractor shall furnish materials, equipment, labor, tools and incidentals necessary to maintain flow. This work shall be considered incidental to various contract items.
- 14. The Contractor shall provide for access to and from all existing driveways, sidewalks and ADA access routes, and side streets and cross streets at all times. This work shall be considered incidental to the various contract items, and will not be paid for separately.

- 16. Prior to his resurfacing operations, the Contractor shall be responsible for locating, preserving and marking all utility \$\phi\$ highway facilities that will require adjustments to the new finished pavement grade. Additionally, the Contractor shall submit to the Engineer a list of all items, including water, drainage, sewer, electrical, telephone and cable utilities to be adjusted to the new finished grade.
- 17. After completion of resurfacing, the Contractor and the Engineer will test for, and determine ponding areas (i.e. low spots within the resurfaced area). It shall be the responsibility of the Contractor to correct and resurface and/or repair all such ponding areas.
- Contractor shall exercise extreme caution to preserve BENCHMARKS (Survey Monuments). Whenever the center of a Survey Monument is less than three (3) feet from the edge of construction, the Contractor shall retain a Licensed Land Surveyor to reference the location of said Survey Monument.

Benchmarks that are disturbed or destroyed shall be restored under a Licensed Land Surveyor's direction. Copies of field notes, descriptions and new values of the new benchmark shall be sent to the Department of Transportation, Highways Division, Cadastral Engineering Section, for review and approval prior to construction.

- 19. All new reference survey monuments shall be set under a Licensed Land Surveyor's direction. Copies of field notes, descriptions and values of the new survey monuments shall be sent to the Department of Transportation, Highways Division, Cadastral Engineering Section, for review and approval prior to construction.
- 20. Any work specified in the contract but not listed separately in the proposal schedule shall be considered incidental to other various contract items and shall not be paid for separately.
- 21. Install new Type II Object Marker on all utility poles and trees that are shown on Plan Sheets 17, 18 and 19. Refer to Standard Plan TE-17 for
- 22. All asphalt concrete materials from cold planing, reconstruction and roadway excavation operations shall become the property of the State. The Contractor shall deliver these materials to the Lihue Airport's baseyard stockpile area. The Contractor shall separate the clean cold-planed material from the cold-planed material mixed with base course. This work shall be considered incidental to the various contract items.
- 23. No material and/or equipment shall be stockpiled or otherwise stored within the highway right-of-way except at locations designated in writing and approved by the Engineer. If use of location is approved by the Engineer, the Contractor shall obtain a permit to use the property within the highway right-of-way from the State Highways Division at telephone no. 241-3000.
- 24. Prior to commencing his operations, the Contractor shall contact the County of Kauai, Department of Water Operations Division (Phone No. 245-5444) and make arrangements for the Department to locate and mark the existing water facilities within the project limits, such as waterlines, valve boxes and manhole frame/covers (including ones that may have been inadvertently paved over on previous resurfacing projects). The tops of the existing valve boxes, manhole frame/covers, etc., shall be adjusted to match the new finished grades noted on the construction plans.
- 25. If adjustment of valve boxes and manhole frame/covers are required, it shall be the Contractor's responsibility to offset and record the location of the valve boxes and manhole frame/covers as marked by the Department of Water for the purposes of adjusting to the new finished grade. The Contractor shall preserve all offset stakes marking the locations of the valve boxes and manhole frame/covers. If offset stakes are damaged or lost, it shall be the Contractor's responsibility to survey and re-stake the locations of the valve boxes and manhole frame/covers.
- 26. Adjusting water meter boxes If necessary, existing service lateral piping shall be adjusted to maintain a spacing of 6 inches from the centerline of the piping in the meter box to the bottom of the meter box cover. In new sidewalk areas, replace the Type "B" meter box and cover with Type "X" meter box and cover. The top of all water meter boxes shall be flush with the new sidewalk surface.

FED. ROAD DIST. NO.	STATE	FED. AID PROJ. NO.	FISCAL YEAR		TOTAL SHEETS
HAWAII	HAW.	ARR-056-1(52)	2009	3	21

- 27. EXCEPTION. No paving work will be done between # P.C. Sta. 596+78.90 and 型 Sta. 606+10. Install new pavement markings and traffic signs within these limits as shown on the plans.
- 28. The Contractor shall physically locate Sandwich Isles Communications (SIC) fiber optic duct lines before driving guardrail posts. All work for toning, probing, hand digging, physically locating and all other means of utility verification for the SIC fiber optic duct lines shall not be paid for separately, but shall be considered incidental to the various contract items. Contractor shall contact SIC Customer Service Center at 524-8400 or toll free at 1-888-995-7274.
- 29. All workers within the State right-of-way who are exposed to either vehicles using the roadway or to construction equipment shall wear high-visibility safety apparel that meets the Performance Class 2 or 3 requirements of ANSI/ISEA 107-2004. "Workers" is defined as people on foot whose duties place them with the State right-of-way, such as, but not limited to construction and maintenance forces, equipment operators, survey crews, utility crews, responders to incidents (e.g., EMT and firemen), and law enforcement personnel directing traffic, investigating accidents, handling lane closures and obstructed roadways.

<u>LEGEND</u>

Cold Planing Areas Reconstruction Areas Resurfacing Limits

Existing Power Pole Existing Electric Manhole • EMH Adjusted Elec. MH Frame/Cover

ுச்சி Existing Electric Pullbox

Existing Telephone Manhole •TMH Adjusted Tel. MH Frame/Cover

Existing Telephone Pullbox —w—12— Existing 12" Water Line

Existing Water Manhole ●_{WMH} Adjusted Water MH Frame/Cover Existing Water Air Valve

Adjusted Water Air Valve Existing Water Valve Box

Adjusted Water Valve Box Existing Water Meter Box Adjusted Water Meter Box

New Type "X" Water Meter Box Existing Traffic Sign

2/13/09

Date

New Traffic Sign

---&ic--- Existing Sandwich Isles Communications (SIC) Fiber Optic Duct Line

__ __ Existing Metal Guardrail

_____ New Metal Guardrail

__ Adjusted and/or Relocated Metal Guardrail

 ϕ_{lh} Existing Fire Hydrant

——S—12— New 12" Sewer Line ○_{Amh} Existing Sewer Manhole

SMH Adjusted Sewer Manhole

•_{SMH} New Sewer Manhole ©_{mon.} Existing Monument

MON. Adjusted Monument

O_{MON}. New Monument

---d--24--- Existing 24" Drain Line osdmh Existing Storm Drain Manhole

*SDMH Adjusted Storm Drain Manhole

□_{Qdi} Existing Grated Drop Inlet

New Grated Drop Inlet

Adjusted/Reconstructed Drain Inlet or Replaced Steel Grate


STATE OF HAWAII DEPARTMENT OF TRANSPORTATION HIGHWAYS DIVISION

GENERAL NOTES AND LEGEND

KUHIO HIGHWAY RESURFACING Kawaihau Road to Kapaa Bridge Federal-Aid Project No. ARR-056-1(52)

Date: March 2009

SHEET No. 1 OF 1 SHEETS

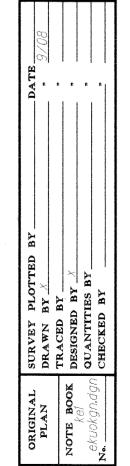

15. All saw cutting work shall be considered incidental to Hot Mix Asphalt Pavement, Mix No. IV and will not be paid for separately.

APPROVED:

Drue Jany for Manager \$ Chief Engineer Department of Water