
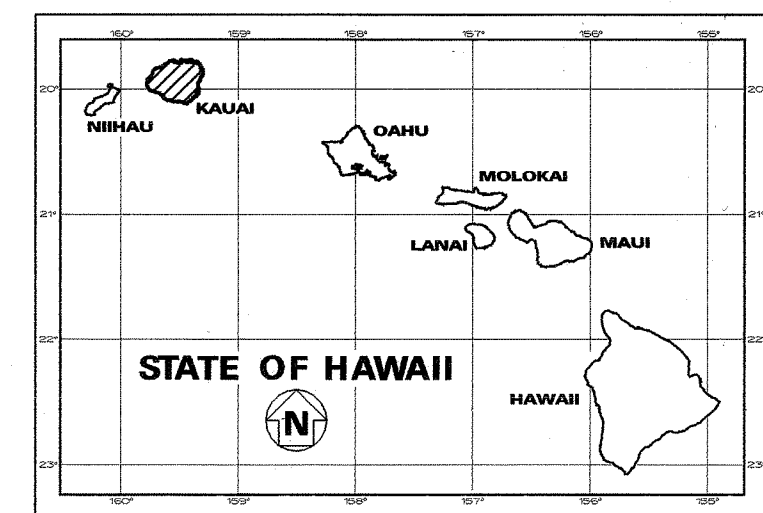


INDEX TO DRAWINGS	
SHEET NO.	DESCRIPTION
1	TITLE SHEET
2	STANDARD PLANS SUMMARY
3	GENERAL NOTES & LEGEND
4 - 5	WATER POLLUTION AND EROSION CONTROL NOTES
6 - 9	TYPICAL SECTIONS
10	GUARDRAIL DETAILS AND NOTES
11	STRONG POST W-BEAM GUARDRAIL
12	FLEAT-350 TERMINAL END
13 - 15	ROADWAY PLAN
16	PAVEMENT MARKING LEGEND, DETAILS AND NOTES
17 - 19	PAVEMENT MARKING AND TRAFFIC SIGNING PLAN
20	LOW SPEED UNDIVIDED HIGHWAY WORK ZONE SIGNING PLAN, DETAILS & NOTES
21	HIGH SPEED UNDIVIDED HIGHWAY WORK ZONE SIGNING PLAN, DETAILS & NOTES


STATE OF HAWAII
DEPARTMENT OF TRANSPORTATION
HIGHWAYS DIVISION
HONOLULU, HAWAII
"AS-BUILT" PLANS FOR
**KUHIO HIGHWAY RESURFACING
KAWAIHAU ROAD TO KAPAA BRIDGE**
FEDERAL-AID PROJECT NO. ARR-056-1(52)

DISTRICT OF KAWAIHAU
ISLAND OF KAUAI

FED. ROAD DIST. NO.	STATE	FED. AID PROJ. NO.	FISCAL YEAR	SHEET NO.	TOTAL SHEETS
HAWAII	HAW.	ARR-056-1(52)	2009	1	21

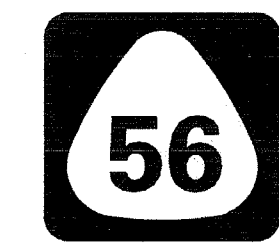

PROJECT LOCATION

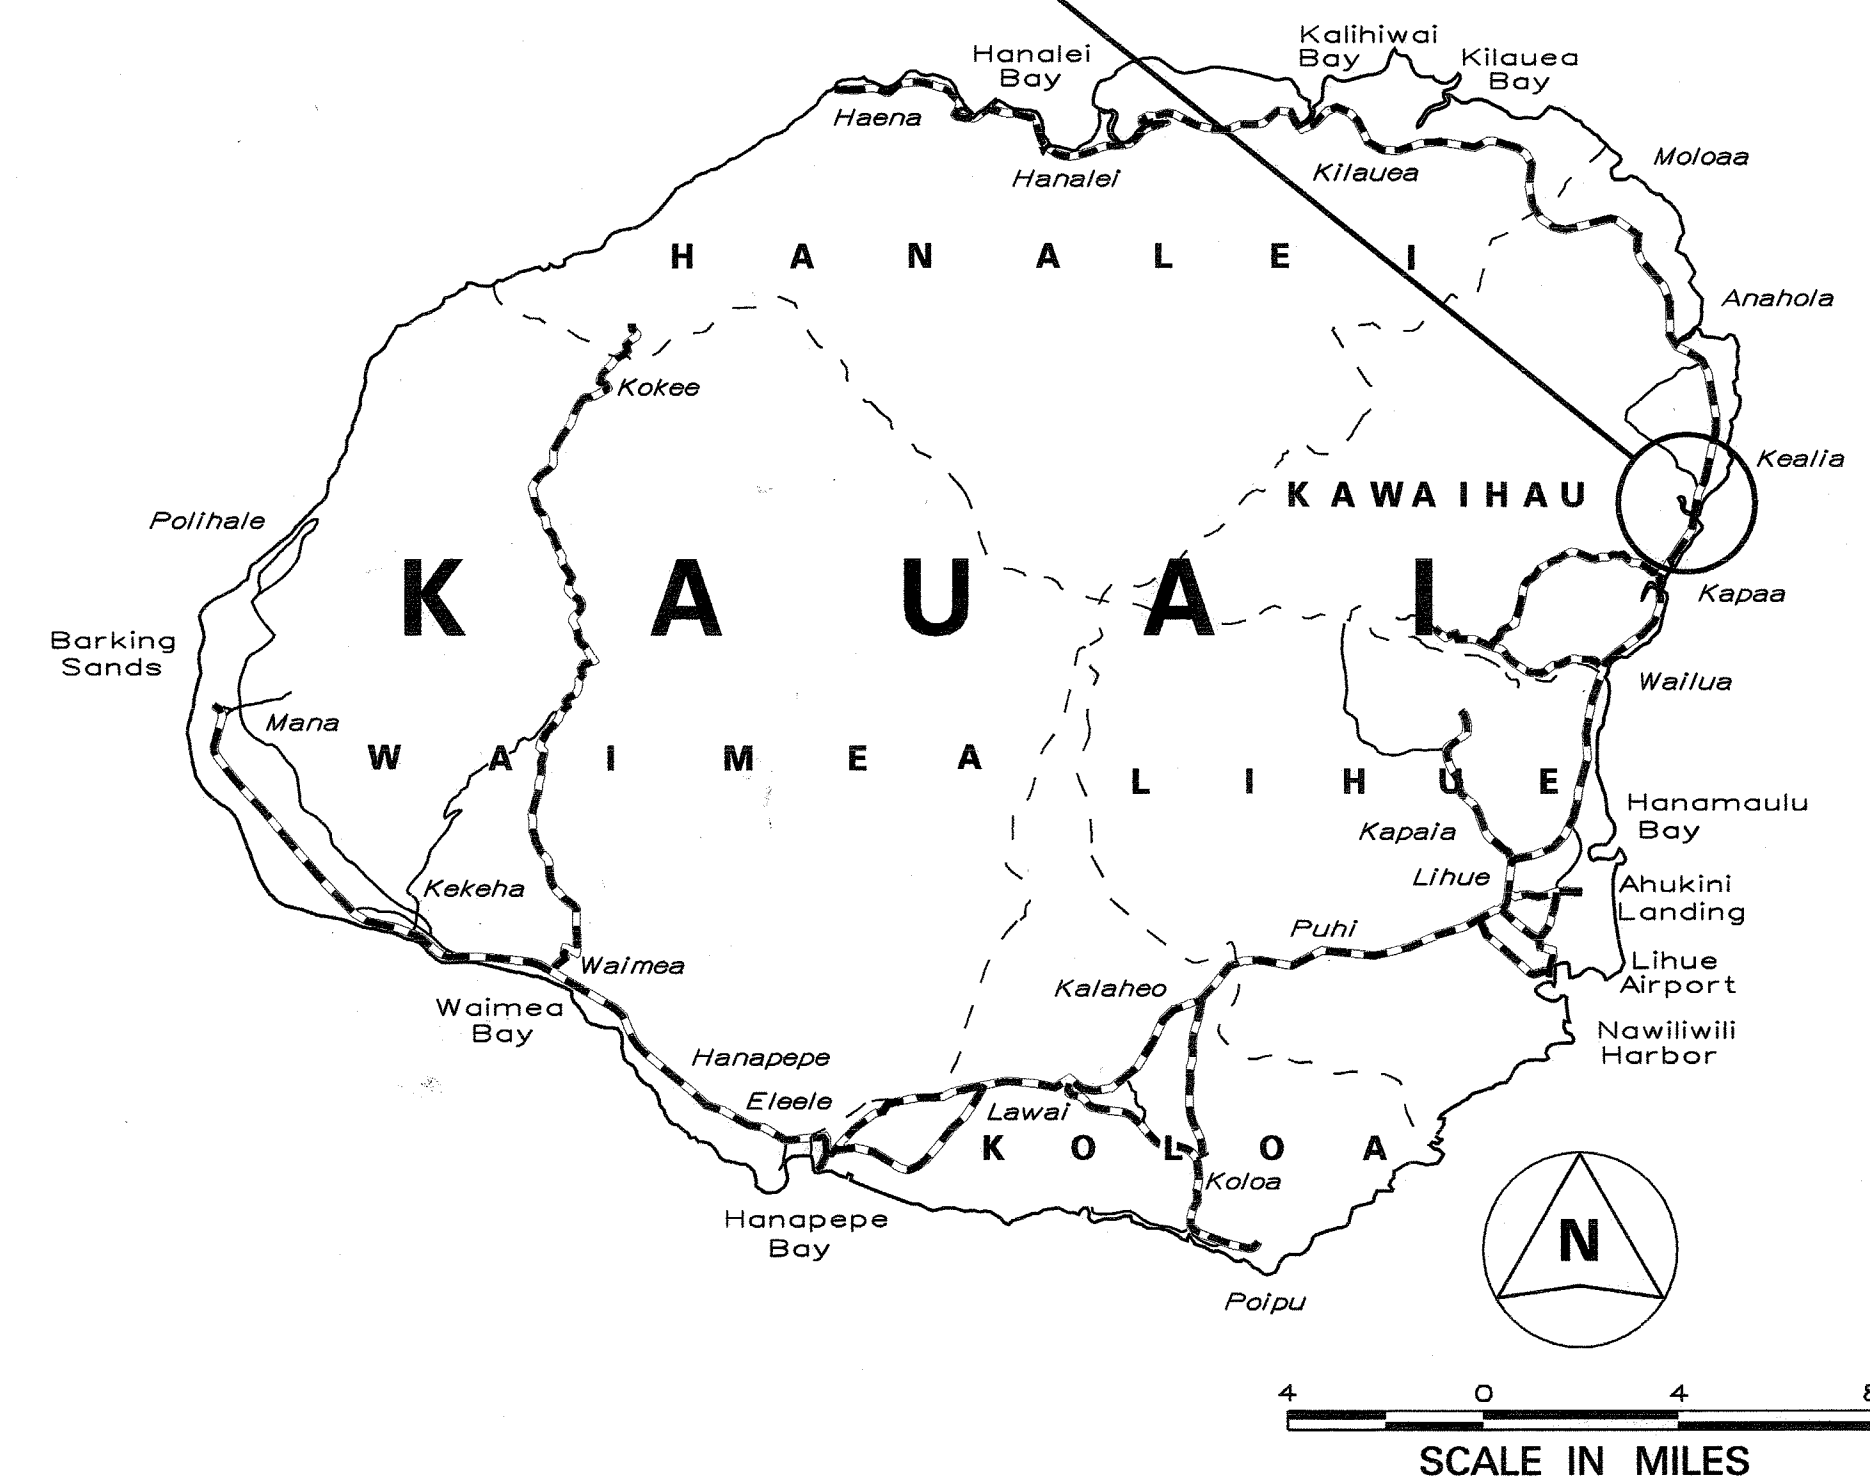


----- FEDERAL AID PROJECTS PREVIOUSLY CONSTRUCTED OR UNDER CONSTRUCTION

MILE POST 9.00 TO MILE POST 9.92


DESIGN DESIGNATION

ADT (2009).....	23,300
ADT (2019).....	29,700
DHV	2,500
D	55/45
T	2.5 %
V	25 - 50 M.P.H.

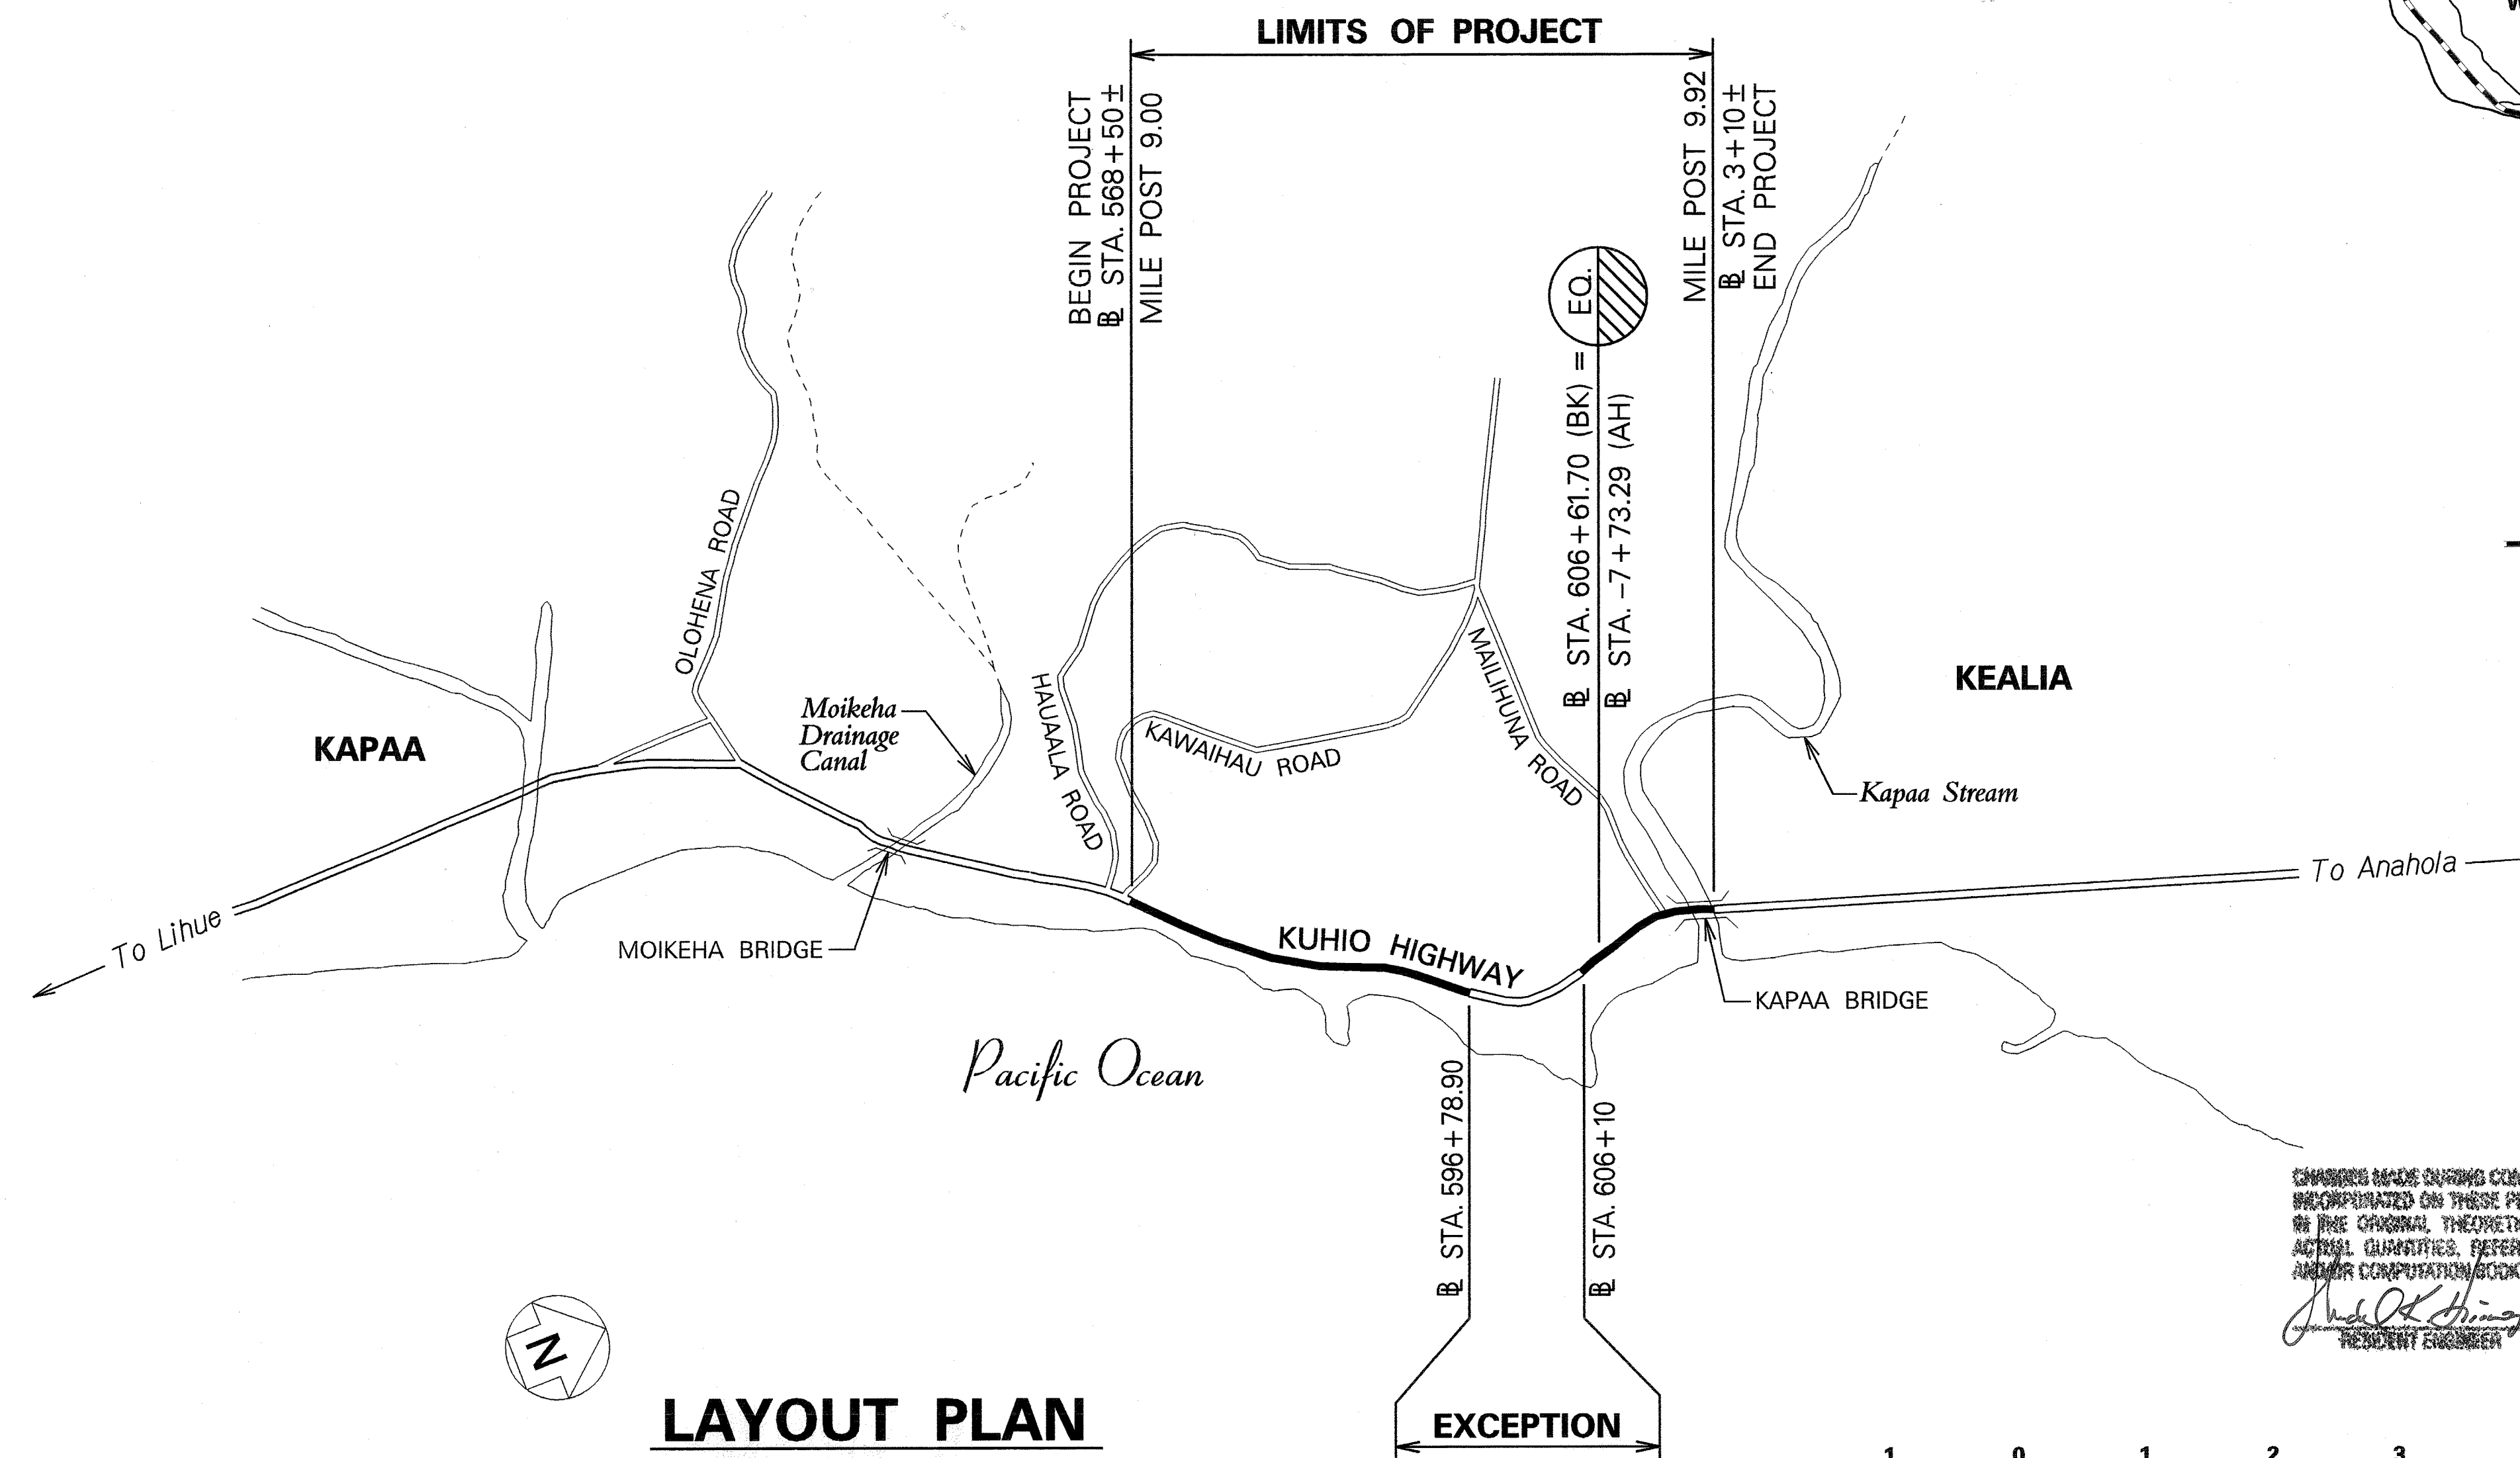

LAYOUT PLAN

GROSS LENGTH OF PROJECT.....0.92 MILE
NET LENGTH OF PROJECT.....0.74 MILE

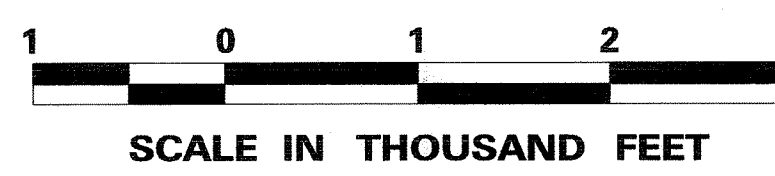

CHANGES MADE DURING CONSTRUCTION HAVE BEEN INCORPORATED ON THESE PLANS EXCEPT CHANGES IN THE ORIGINAL THEORETICAL QUANTITIES. FOR ACTUAL QUANTITIES, REFER TO PROJECT LEADER AND/OR COMPUTATION BOOK.
12/13/10
RESIDENT ENGINEER

DEPARTMENT OF TRANSPORTATION
STATE OF HAWAII
APPROVED: *[Signature]* 3-10-09
DIR. OF TRANSPORTATION DATE

Hwy-K
DESIGNED BY

Hwy-KE
MANAGED BY

241-3000
PHONE

MAR. 2009
DATE