



FED. ROAD DIST. NO.	STATE	PROJ. NO.	FISCAL YEAR	SHEET NO.	TOTAL SHEETS
HAWAII	HAW.	56C-02-08M	2009	10	14

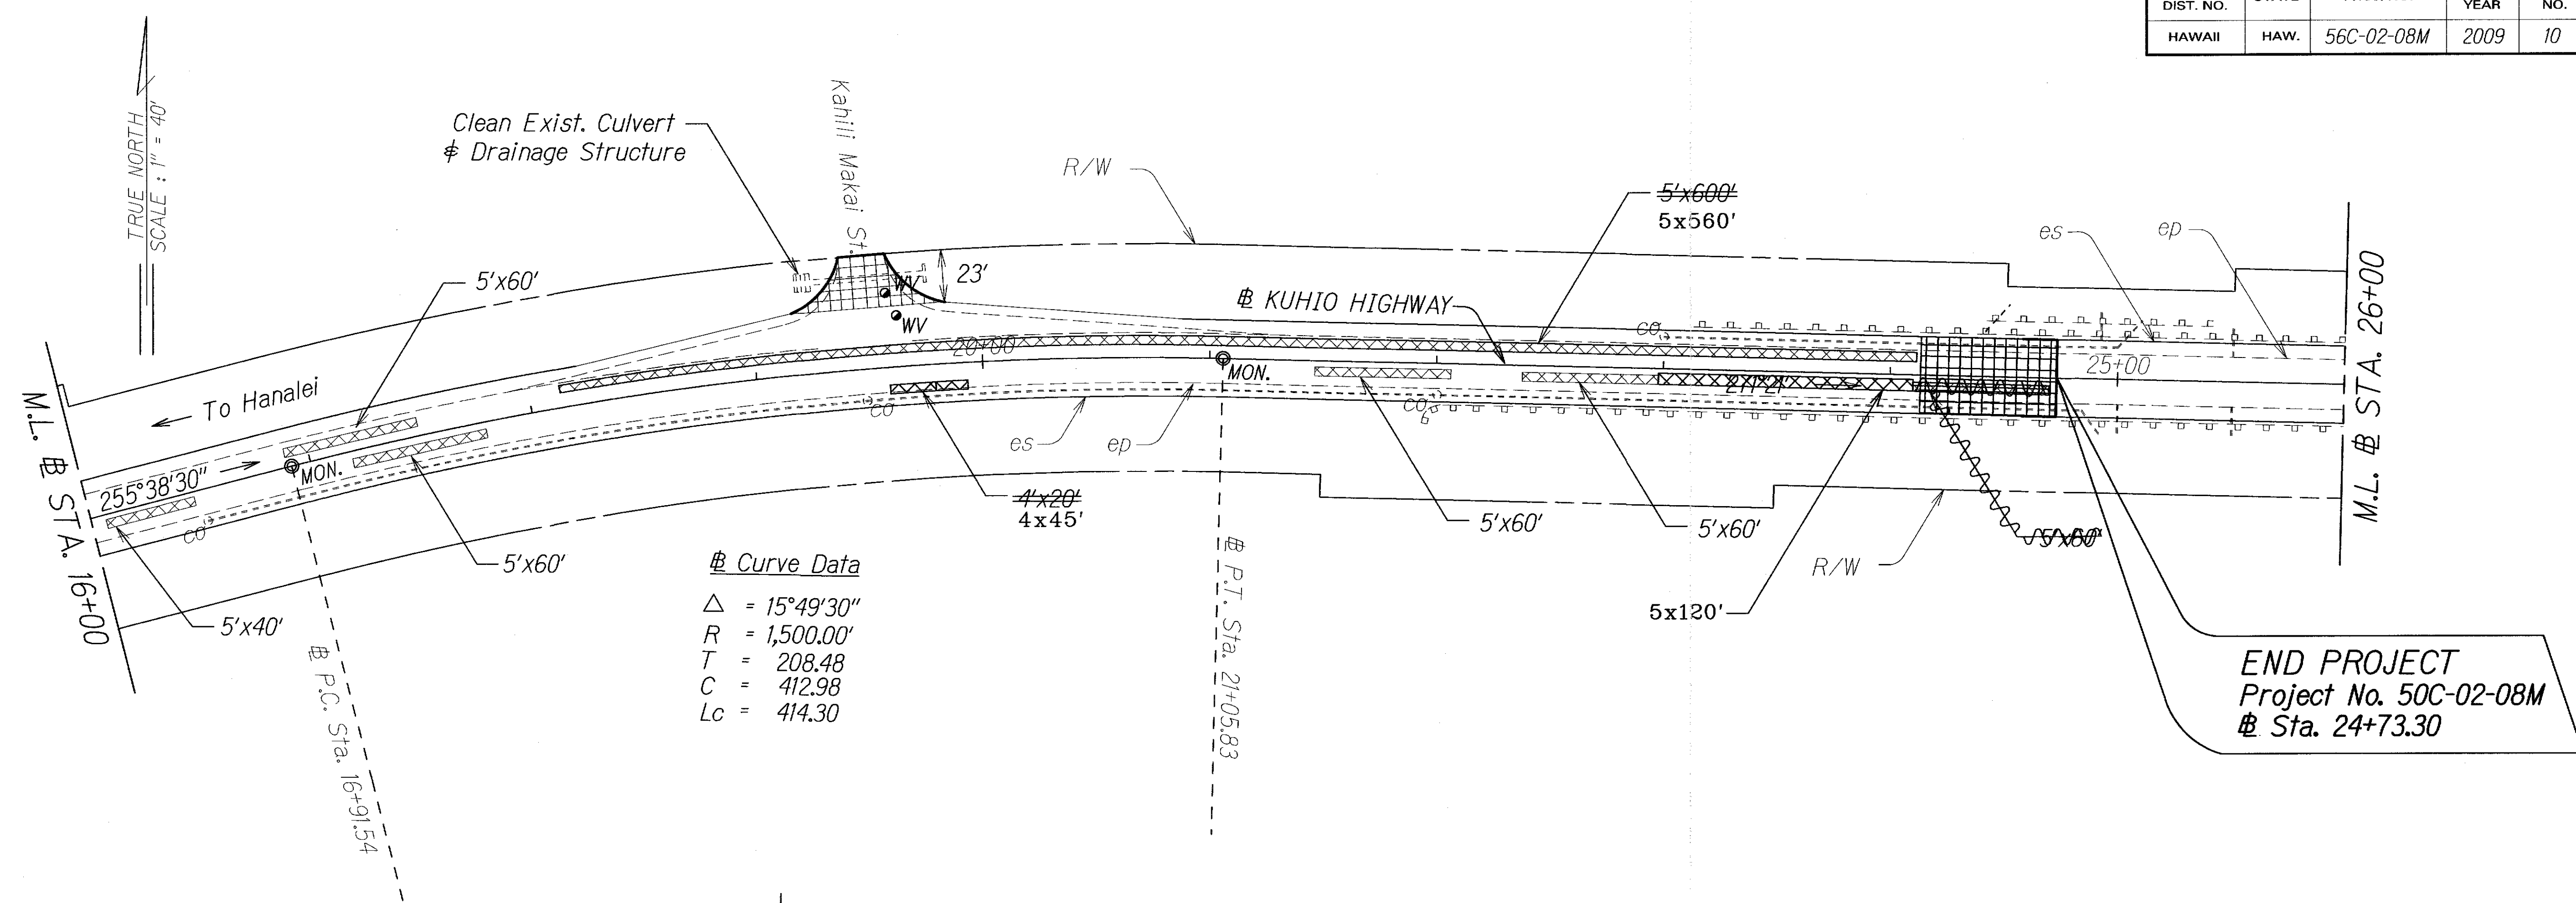

Curve Data
 $\Delta = 15^{\circ}49'30''$
 $R = 1,500.00'$
 $T = 208.48$
 $C = 412.98$
 $Lc = 414.30$

Curve Data
 $\Delta = 4^{\circ}18'30''$
 $R = 8,000.00'$
 $T = 3000.92$
 $C = 601.42$
 $Lc = 601.56$

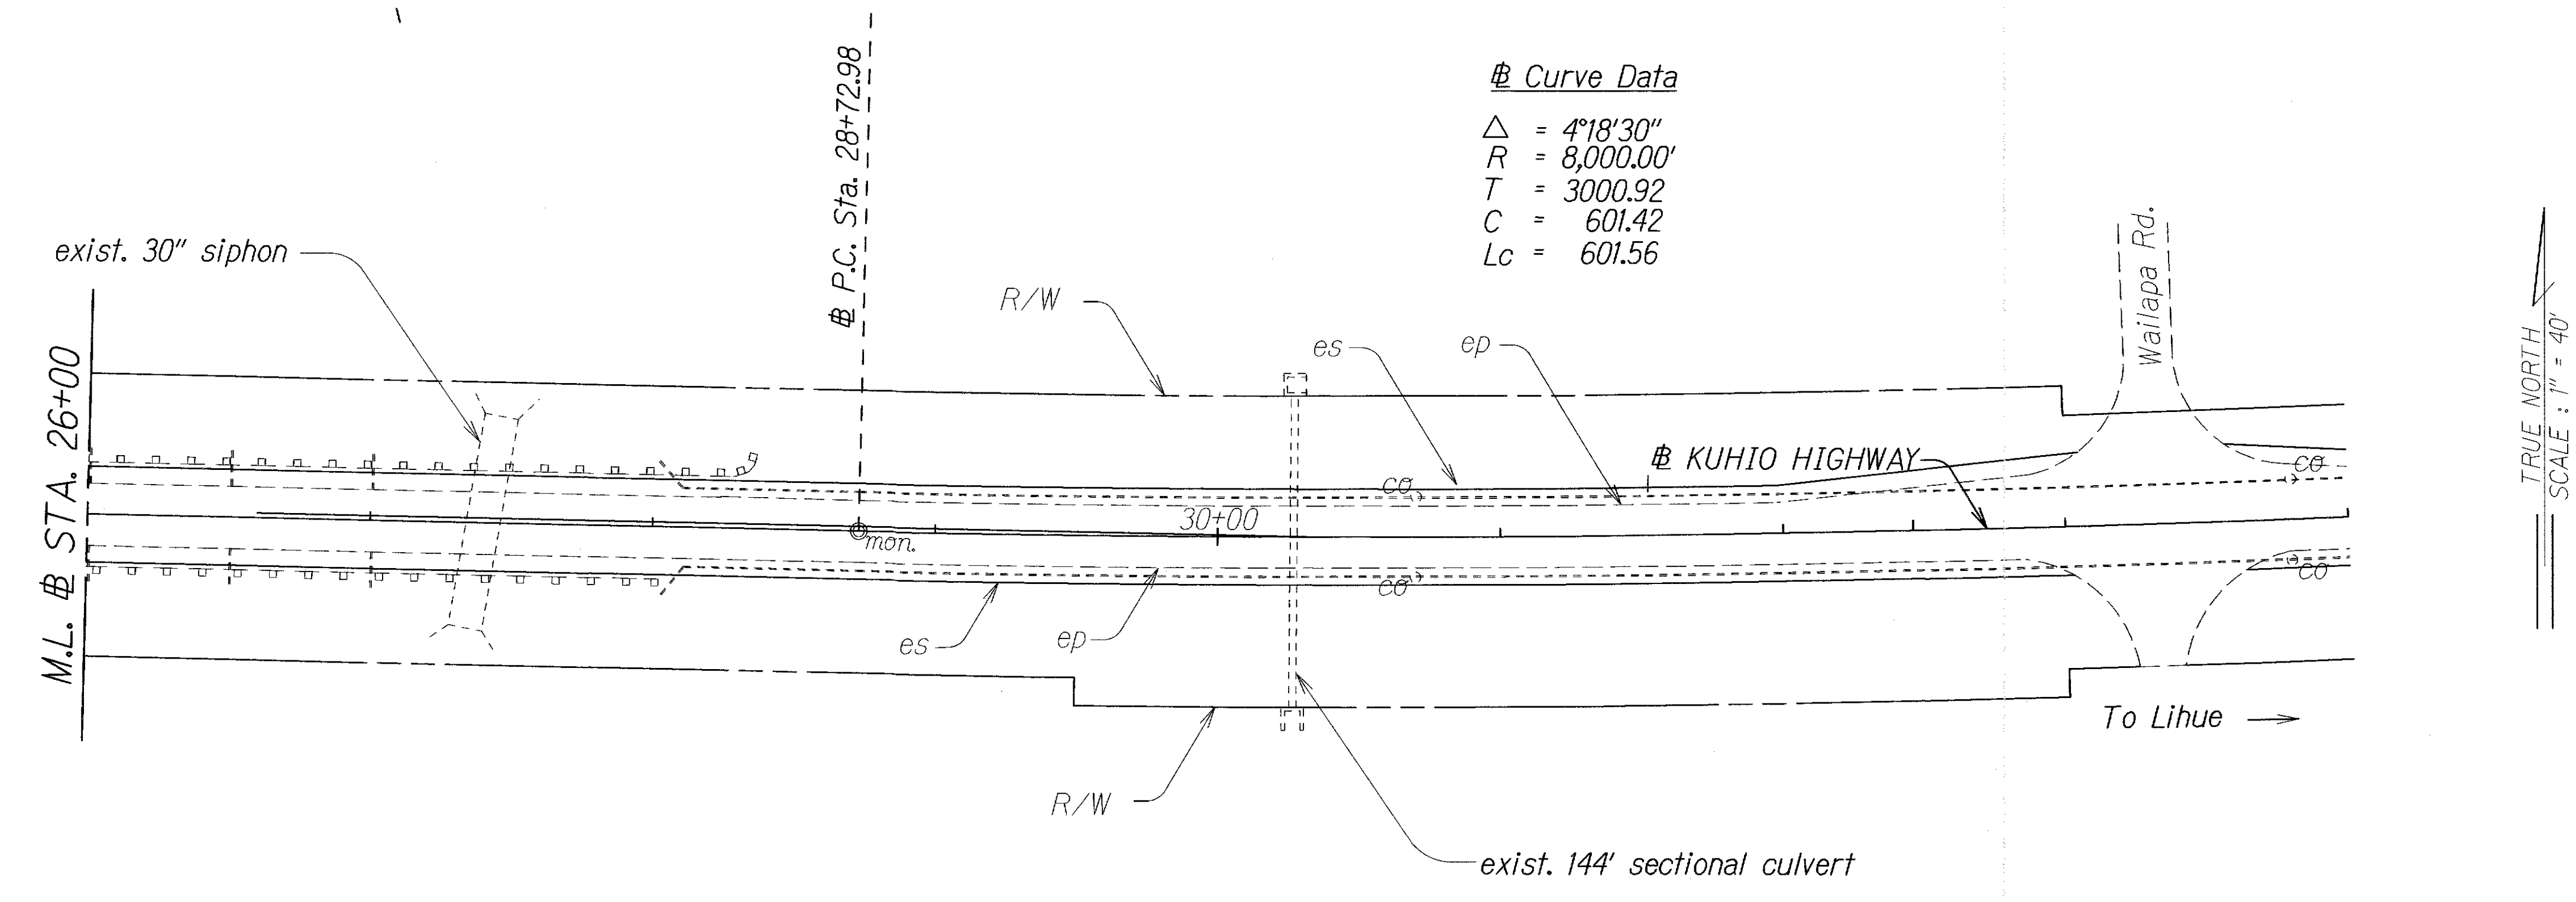

LEGEND FOR AS-BUILT POSTINGS

	Squiggly line for as-built deletion
	Double line for as-built deletion
Roadway	Text for as-built posting

STATE OF HAWAII
DEPARTMENT OF TRANSPORTATION
HIGHWAYS DIVISION

ROADWAY PLAN

KUHIO HIGHWAY RESURFACING
Kilauea to Wailapa
Project No. 56C-02-08M

Scale: 1" = 40' Date: May 2009

SHEET No. 2 OF 2 SHEETS

APPROVED: _____
Manager & Chief Engineer Date
Department of Water

"AS-BUILT"

ORIGINAL PLAN	SURVEY PLOTTED BY	DATE
DRAWN BY		5/09
TRACED BY		
NOTED BY		
CHECKED BY		
QUANTITIES BY		
CHECKED BY		