

INDEX TO DRAWINGS	
SHEET NO.	DESCRIPTION
1	TITLE SHEET
2	STANDARD PLANS SUMMARY
3	GENERAL NOTES & LEGEND
4 - 5	WATER POLLUTION AND EROSION CONTROL NOTES
6 - 8	TYPICAL SECTIONS
9 - 10	PORTABLE CONCRETE BARRIER
11	GUARDRAIL DETAILS AND NOTES
12	STRONG POST W-BEAM GUARDRAIL
13	FLEAT-350 TERMINAL END
14	GENERAL ROADWAY IMPROVEMENTS LAYOUT
15 - 19	ROADWAY PLAN
20	PAVEMENT MARKING LEGEND, DETAILS AND NOTES
21	PAVEMENT MARKING AND TRAFFIC SIGNING PLAN
22	STRIPING LAYOUT AT INTERSECTIONS
23	HIGH SPEED UNDIVIDED HIGHWAY WORK ZONE SIGNING PLAN, DETAILS & NOTES
24	TRAFFIC CONTROL PLAN WITHIN COUNTY RIGHT-OF-WAY
25 - 26	CROSS-SECTIONS

STATE OF HAWAII

DEPARTMENT OF TRANSPORTATION

HIGHWAYS DIVISION

HONOLULU, HAWAII

"AS-BUILT"

PLANS FOR

KUHIO HIGHWAY


INTERSECTION IMPROVEMENTS

AT WAIKALUA STREET AND NORTH WAIKALUA STREET

PROJECT NO. 56C-01-09

DISTRICT OF HANAIEI

ISLAND OF KAUAI


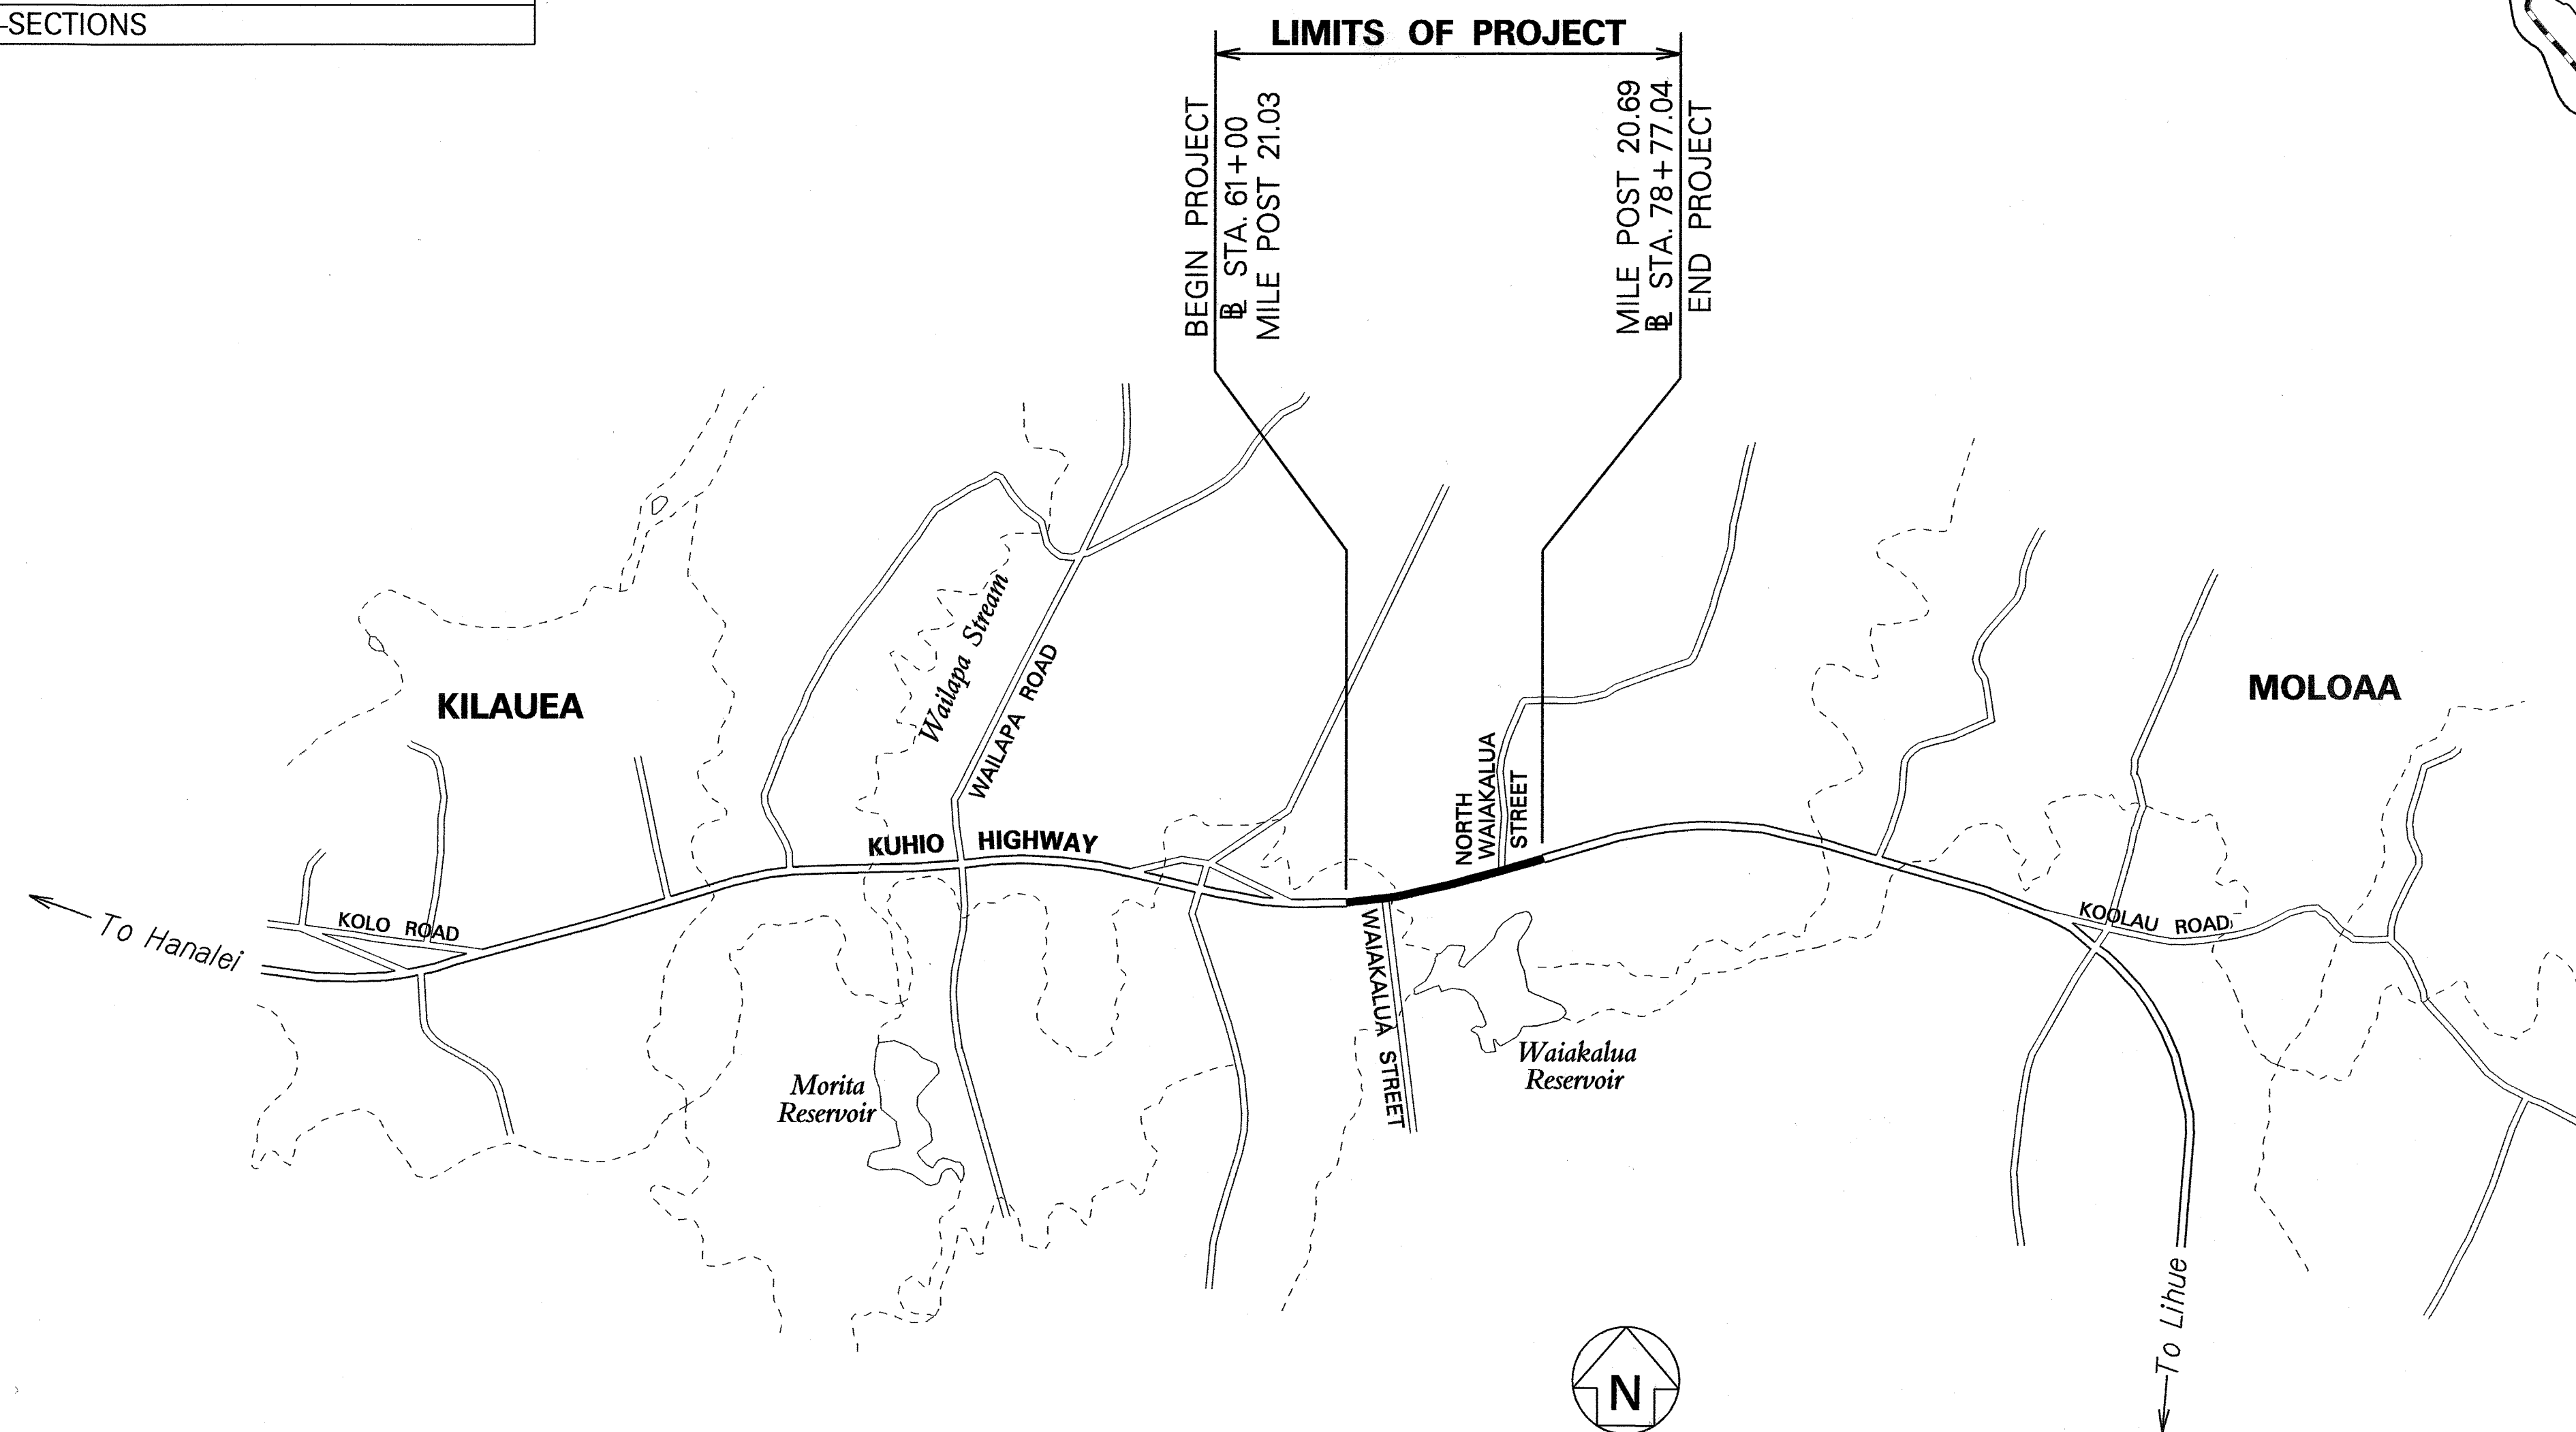


LAYOUT PLAN

GROSS LENGTH OF PROJECT..... 0.34 MILE

NET LENGTH OF PROJECT..... 0.34 MILE

FED. ROAD DIST. NO.	STATE	PROJ. NO.	FISCAL YEAR	SHEET NO.	TOTAL SHEETS
HAWAII	HAW.	56C-01-09	2009	1	26

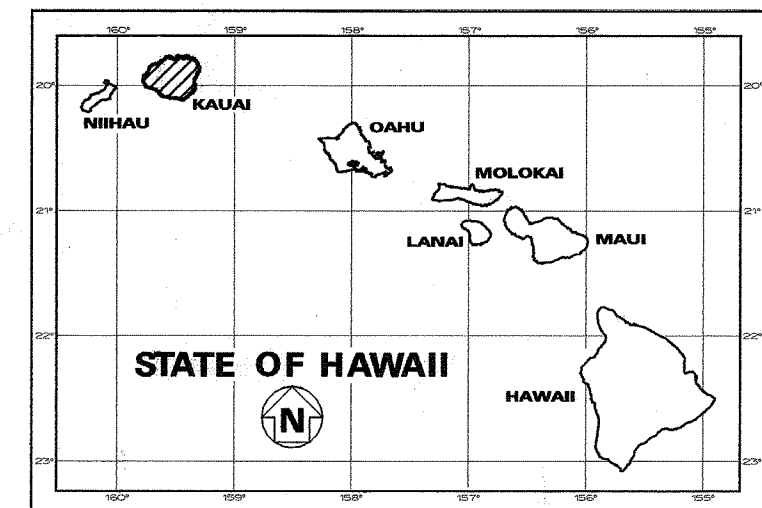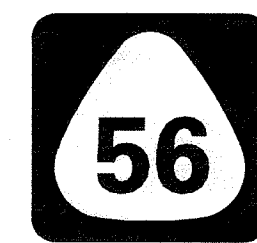

PROJECT LOCATION



----- FEDERAL AID PROJECTS PREVIOUSLY CONSTRUCTED OR UNDER CONSTRUCTION

MILE POST 20.69 TO MILE POST 21.03

CHANGES MADE DURING CONSTRUCTION HAVE BEEN INCORPORATED ON THESE PLANS EXCEPT CHANGES IN THE ORIGINAL THEORETICAL QUANTITIES. FOR ACTUAL QUANTITIES, REFER TO PROJECT LOGS AND/OR CONSTRUCTION BOOK.

William H. Keli 5/13
PROJECT ENGINEER

DEPARTMENT OF TRANSPORTATION

STATE OF HAWAII

APPROVED:

for [Signature] 4-17-09
DIR. OF TRANSPORTATION DATE

DESIGNED BY

HWY-K

MANAGED BY

HWY-KE

PHONE

241-3000

DATE

APRIL 2009