

INDEX TO DRAWINGS	
SHEET NO.	DESCRIPTION
1	TITLE SHEET
2	STANDARD PLANS SUMMARY
3	GENERAL NOTES & LEGEND
4 - 5	WATER POLLUTION AND EROSION CONTROL NOTES
6	PAVEMENT MARKING LEGEND, DETAILS AND NOTES
7 - 11	PAVEMENT MARKING PLAN

STATE OF HAWAII

DEPARTMENT OF TRANSPORTATION

HIGHWAYS DIVISION

HONOLULU, HAWAII

PLANS FOR

KUHIO HIGHWAY PAVEMENT MARKING


KAHILIOLO ROAD TO HO'OKUI ROAD

PROJECT NO. 56CD-01-09M


DISTRICT OF HANAIEI

ISLAND OF KAUAI

FED. ROAD DIST. NO.	STATE	PROJ. NO.	FISCAL YEAR	SHEET NO.	TOTAL SHEETS
HAWAII	HAW.	56CD-01-09M	2009	1	11

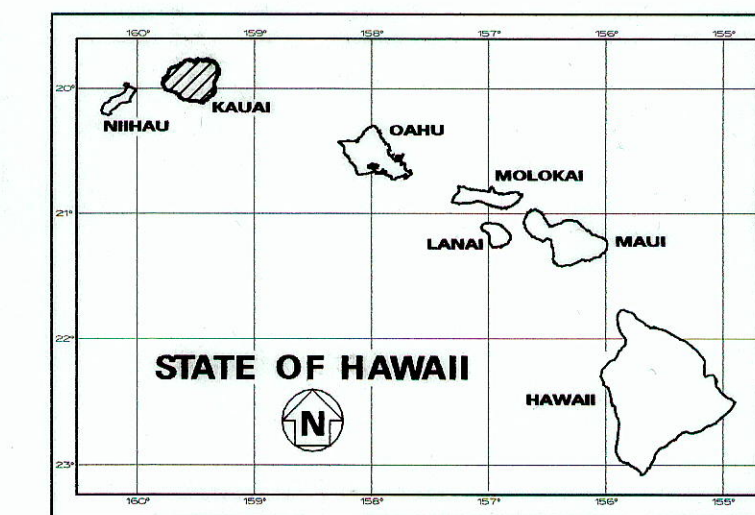


PROJECT LOCATION

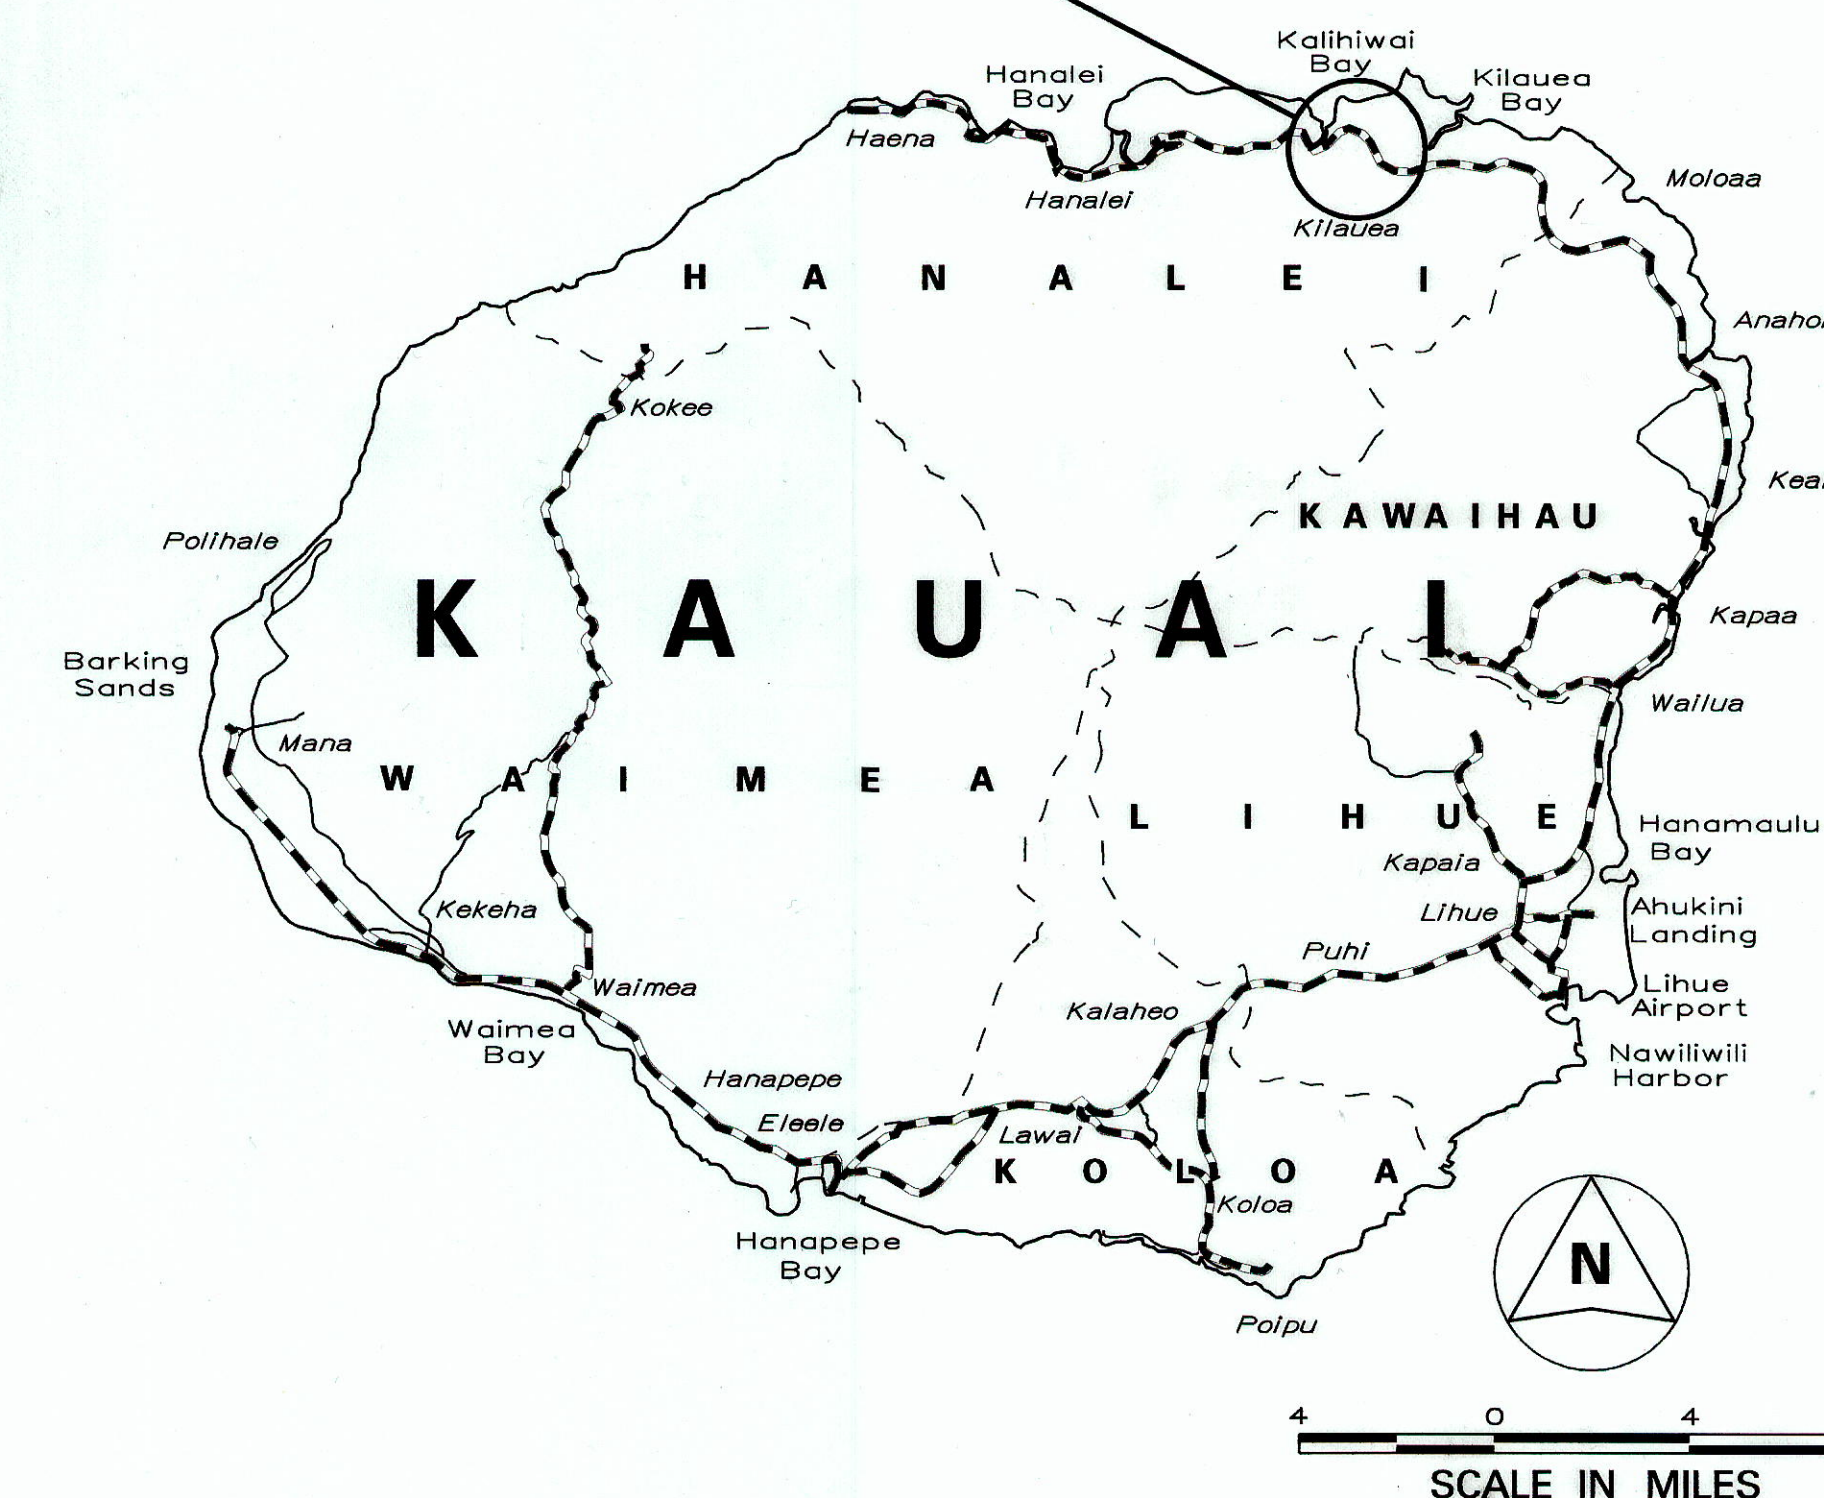


----- FEDERAL AID PROJECTS PREVIOUSLY CONSTRUCTED OR UNDER CONSTRUCTION

MILE POST 22.86 TO MILE POST 24.28

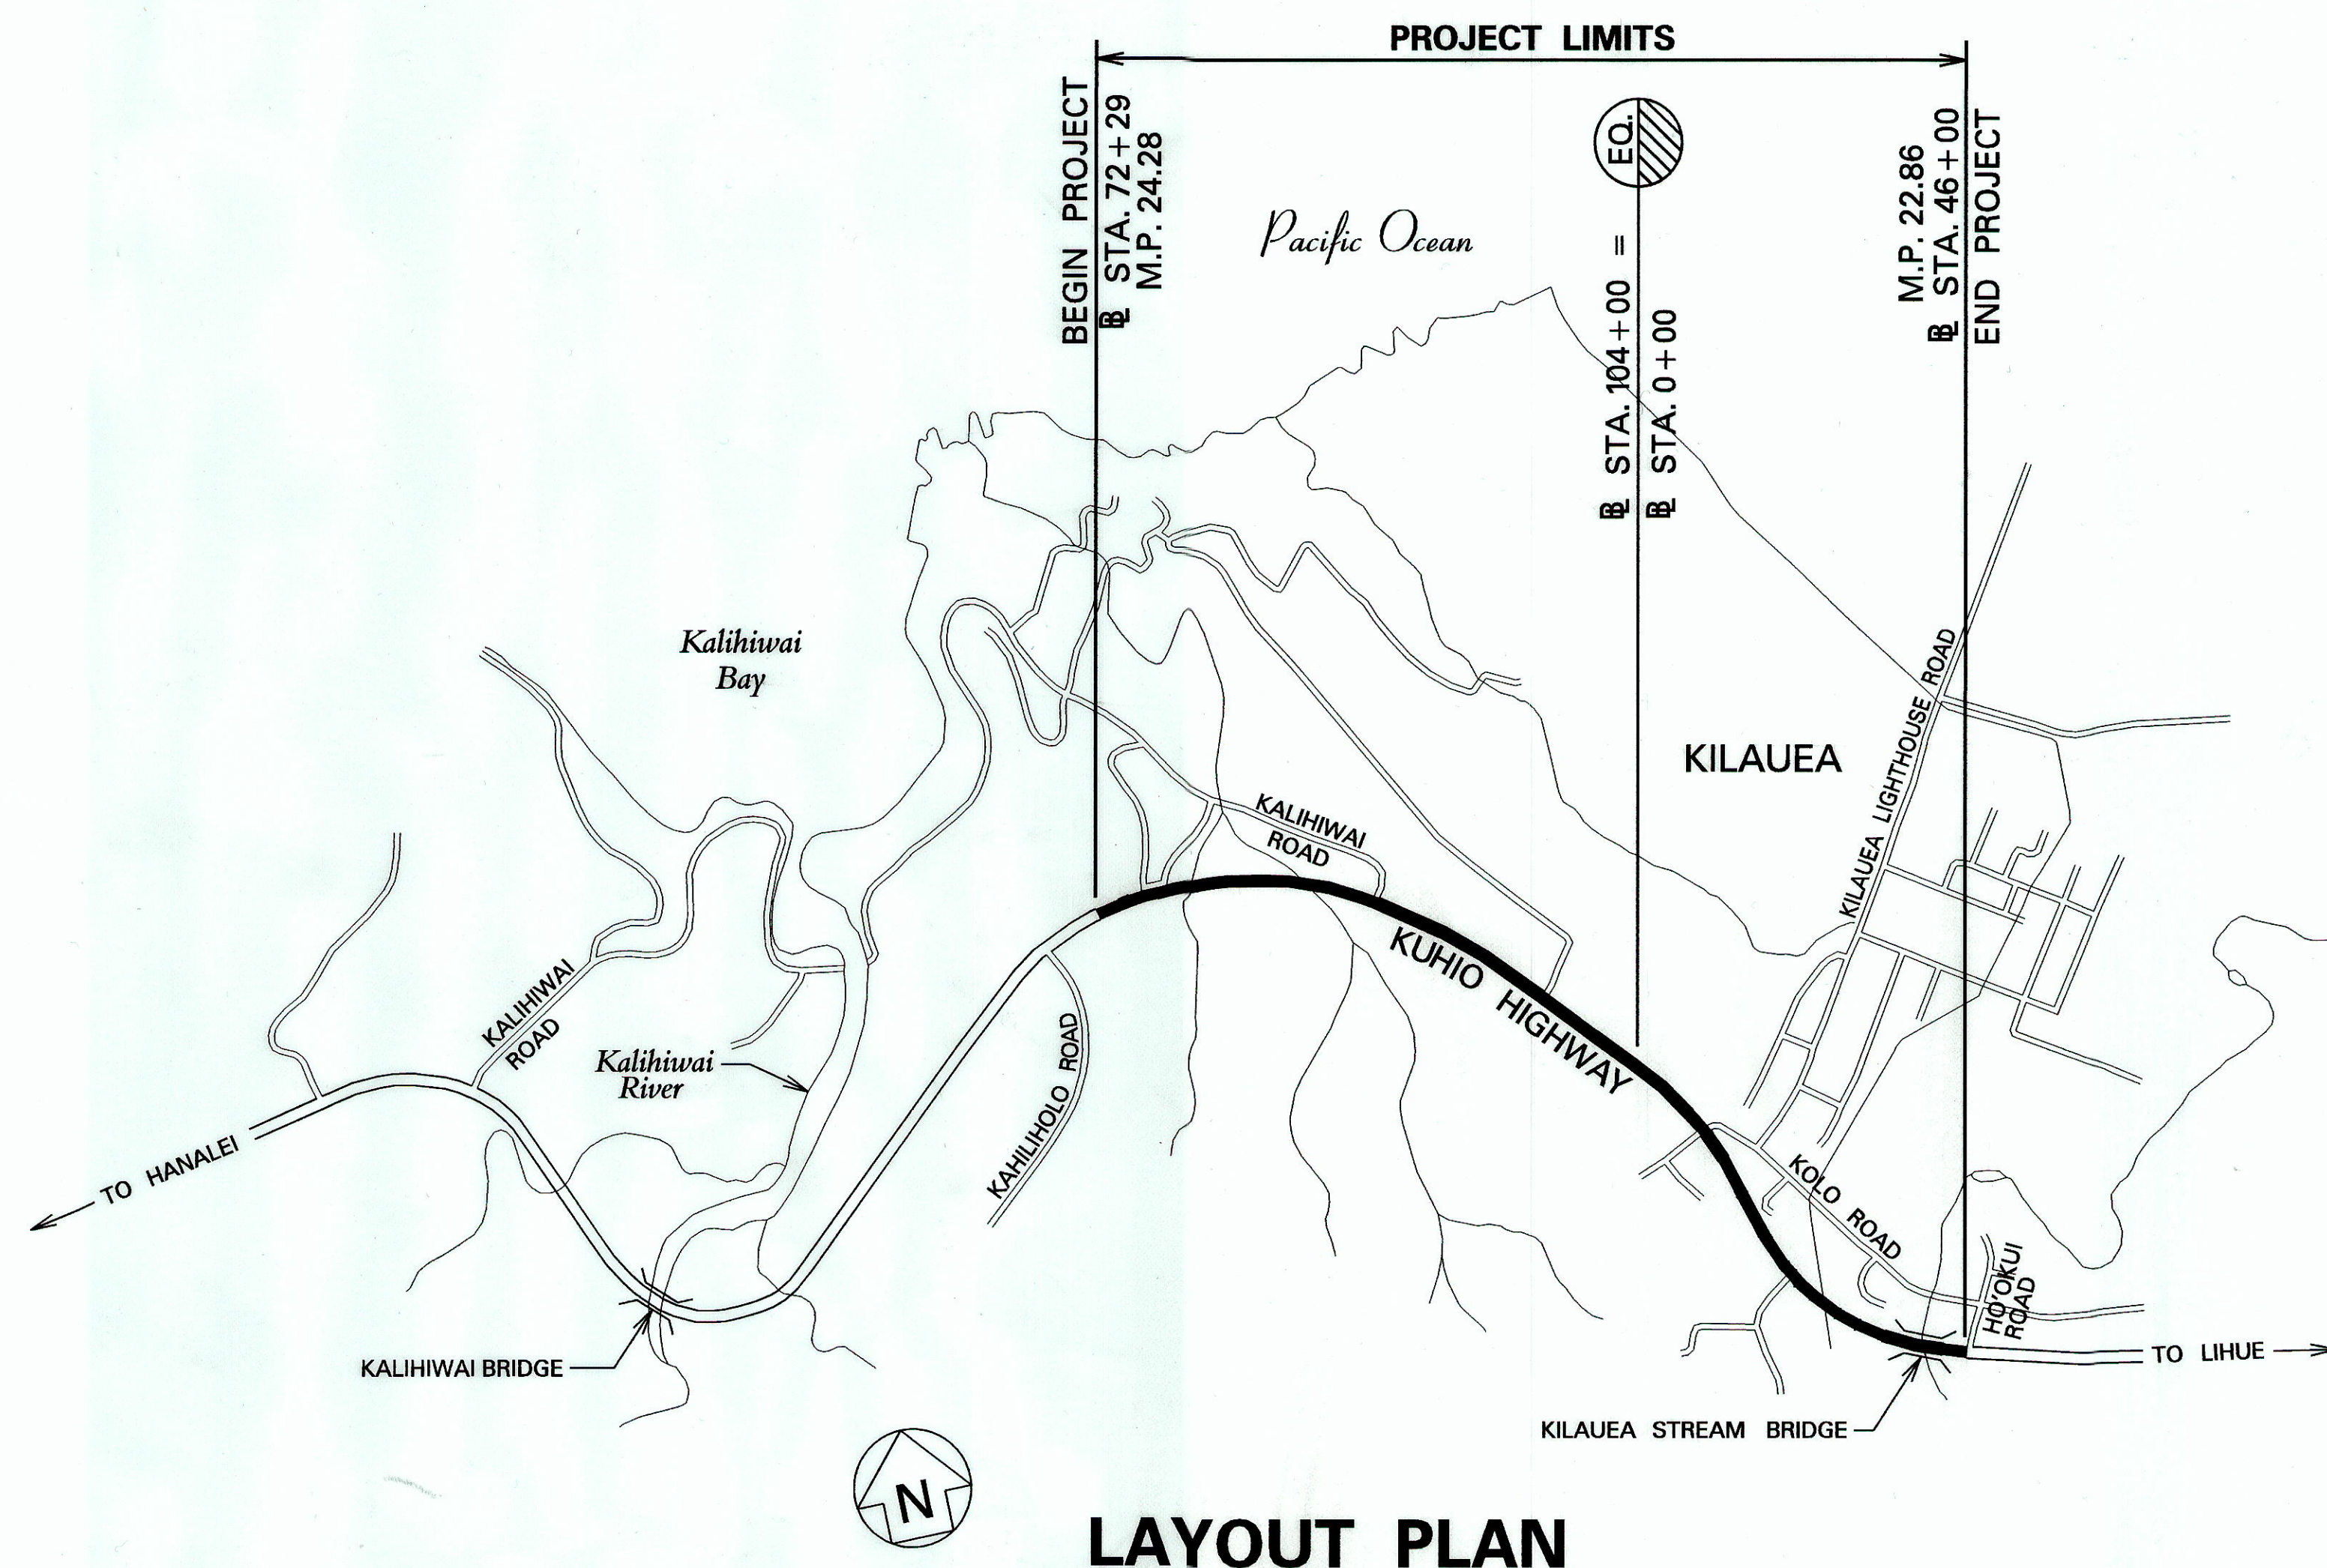

LAYOUT PLAN

GROSS LENGTH OF PROJECT.....1.42 MILES
NET LENGTH OF PROJECT.....1.42 MILES

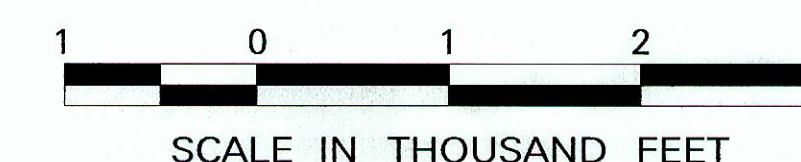

CHANGES MADE DURING CONSTRUCTION HAVE BEEN INCORPORATED ON THESE PLANS EXCEPT CHANGES IN THE ORIGINAL THEORETICAL QUANTITIES. FOR ACTUAL QUANTITIES, REFER TO PROJECT LEDGER AND/OR COMPUTATION BOOK.

[Signature] 4/10/09
RESIDENT ENGINEER DATE

DEPARTMENT OF TRANSPORTATION STATE OF HAWAII	
APPROVED:	
<i>[Signature]</i> DIR. OF TRANSPORTATION	4-30-09 DATE

DESIGNED BY
MANAGED BY
PHONE
DATE