


FED. ROAD DIST. NO.	STATE	FED-AID PROJ. NO.	FISCAL YEAR	SHEET NO.	TOTAL SHEETS
HAWAII	HAW.	HSIP-056-1(53)	2010	9	18

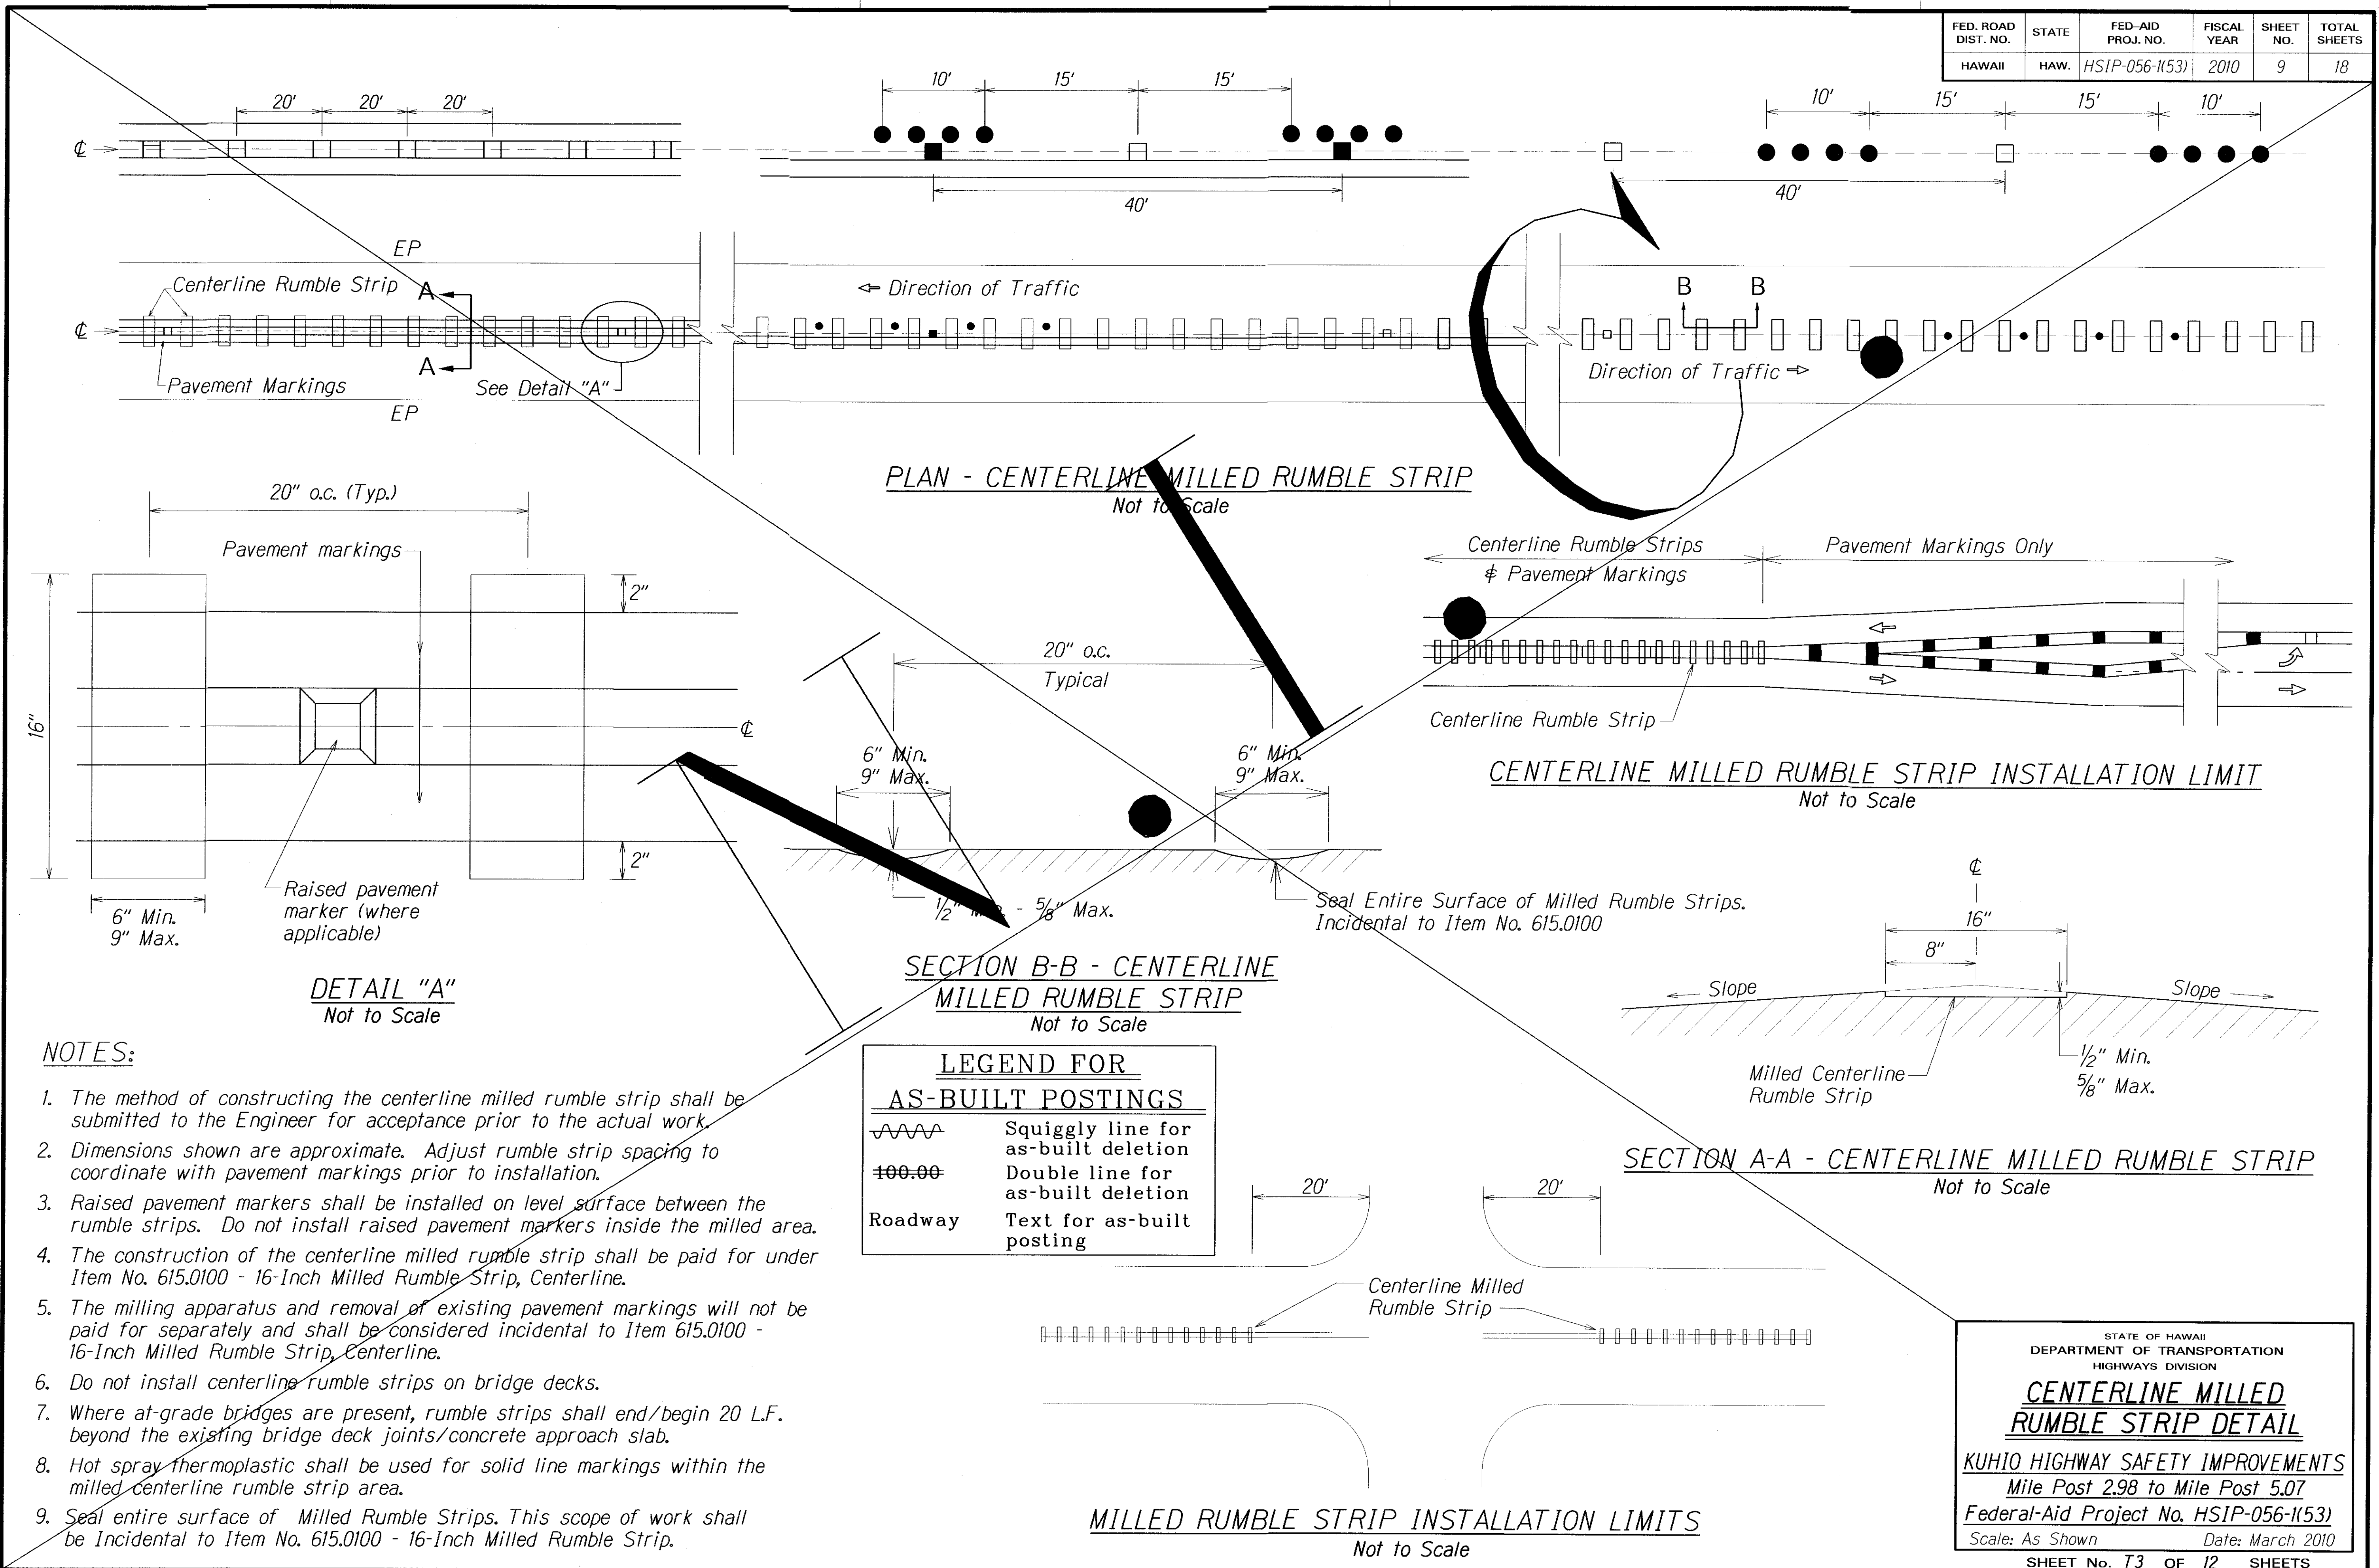

ORIGINAL PLAN	SURVEY PLOTTED BY	DATE
NOTE BOOK	DESIGNED BY	
	QUANTITIES BY	
	CHECKED BY	

- NOTES:**
1. The method of constructing the centerline milled rumble strip shall be submitted to the Engineer for acceptance prior to the actual work.
 2. Dimensions shown are approximate. Adjust rumble strip spacing to coordinate with pavement markings prior to installation.
 3. Raised pavement markers shall be installed on level surface between the rumble strips. Do not install raised pavement markers inside the milled area.
 4. The construction of the centerline milled rumble strip shall be paid for under Item No. 615.0100 - 16-Inch Milled Rumble Strip, Centerline.
 5. The milling apparatus and removal of existing pavement markings will not be paid for separately and shall be considered incidental to Item 615.0100 - 16-Inch Milled Rumble Strip, Centerline.
 6. Do not install centerline rumble strips on bridge decks.
 7. Where at-grade bridges are present, rumble strips shall end/begin 20 L.F. beyond the existing bridge deck joints/concrete approach slab.
 8. Hot spray thermoplastic shall be used for solid line markings within the milled centerline rumble strip area.
 9. Seal entire surface of Milled Rumble Strips. This scope of work shall be Incidental to Item No. 615.0100 - 16-Inch Milled Rumble Strip.

LEGEND FOR AS-BUILT POSTINGS

	Squiggly line for as-built deletion
	Double line for as-built deletion
Roadway	Text for as-built posting

STATE OF HAWAII
DEPARTMENT OF TRANSPORTATION
HIGHWAYS DIVISION

CENTERLINE MILLED RUMBLE STRIP DETAIL

KUHIO HIGHWAY SAFETY IMPROVEMENTS
Mile Post 2.98 to Mile Post 5.07
Federal-Aid Project No. HSIP-056-1(53)

Scale: As Shown Date: March 2010

SHEET No. T3 OF 12 SHEETS

"AS-BUILT"