

INDEX TO DRAWINGS	
SHEET NO.	DESCRIPTION
1	TITLE SHEET
2	STANDARD PLANS SUMMARY
3	GENERAL NOTES & LEGEND
4 - 5	WATER POLLUTION AND EROSION CONTROL NOTES
6	TYPICAL SECTION
7	PAVEMENT MARKING, NOTES, LEGEND, AND SIGN DETAILS
8	RUMBLE STRIP SIGN DETAILS & NOTES
9	CENTERLINE MILLED RUMBLE STRIP DETAIL
10 - 17	PAVEMENT MARKING AND TRAFFIC SIGNING PLAN
18	LOW SPEED UNDIVIDED HIGHWAY WORK ZONE SIGNING PLAN, NOTES & DETAILS

STATE OF HAWAII

DEPARTMENT OF TRANSPORTATION

HIGHWAYS DIVISION

HONOLULU, HAWAII

PLANS FOR

KUHIO HIGHWAY SAFETY IMPROVEMENTS




MILE POST 2.98 TO MILE POST 5.07

FEDERAL-AID PROJECT NO. HSIP-056-1(53)

DISTRICT OF LIHUE

ISLAND OF KAUAI

FED. ROAD DIST. NO.	STATE	FED-AID PROJ. NO.	FISCAL YEAR	SHEET NO.	TOTAL SHEETS
HAWAII	HAW.	HSIP-056-1(53)	2010	1	18

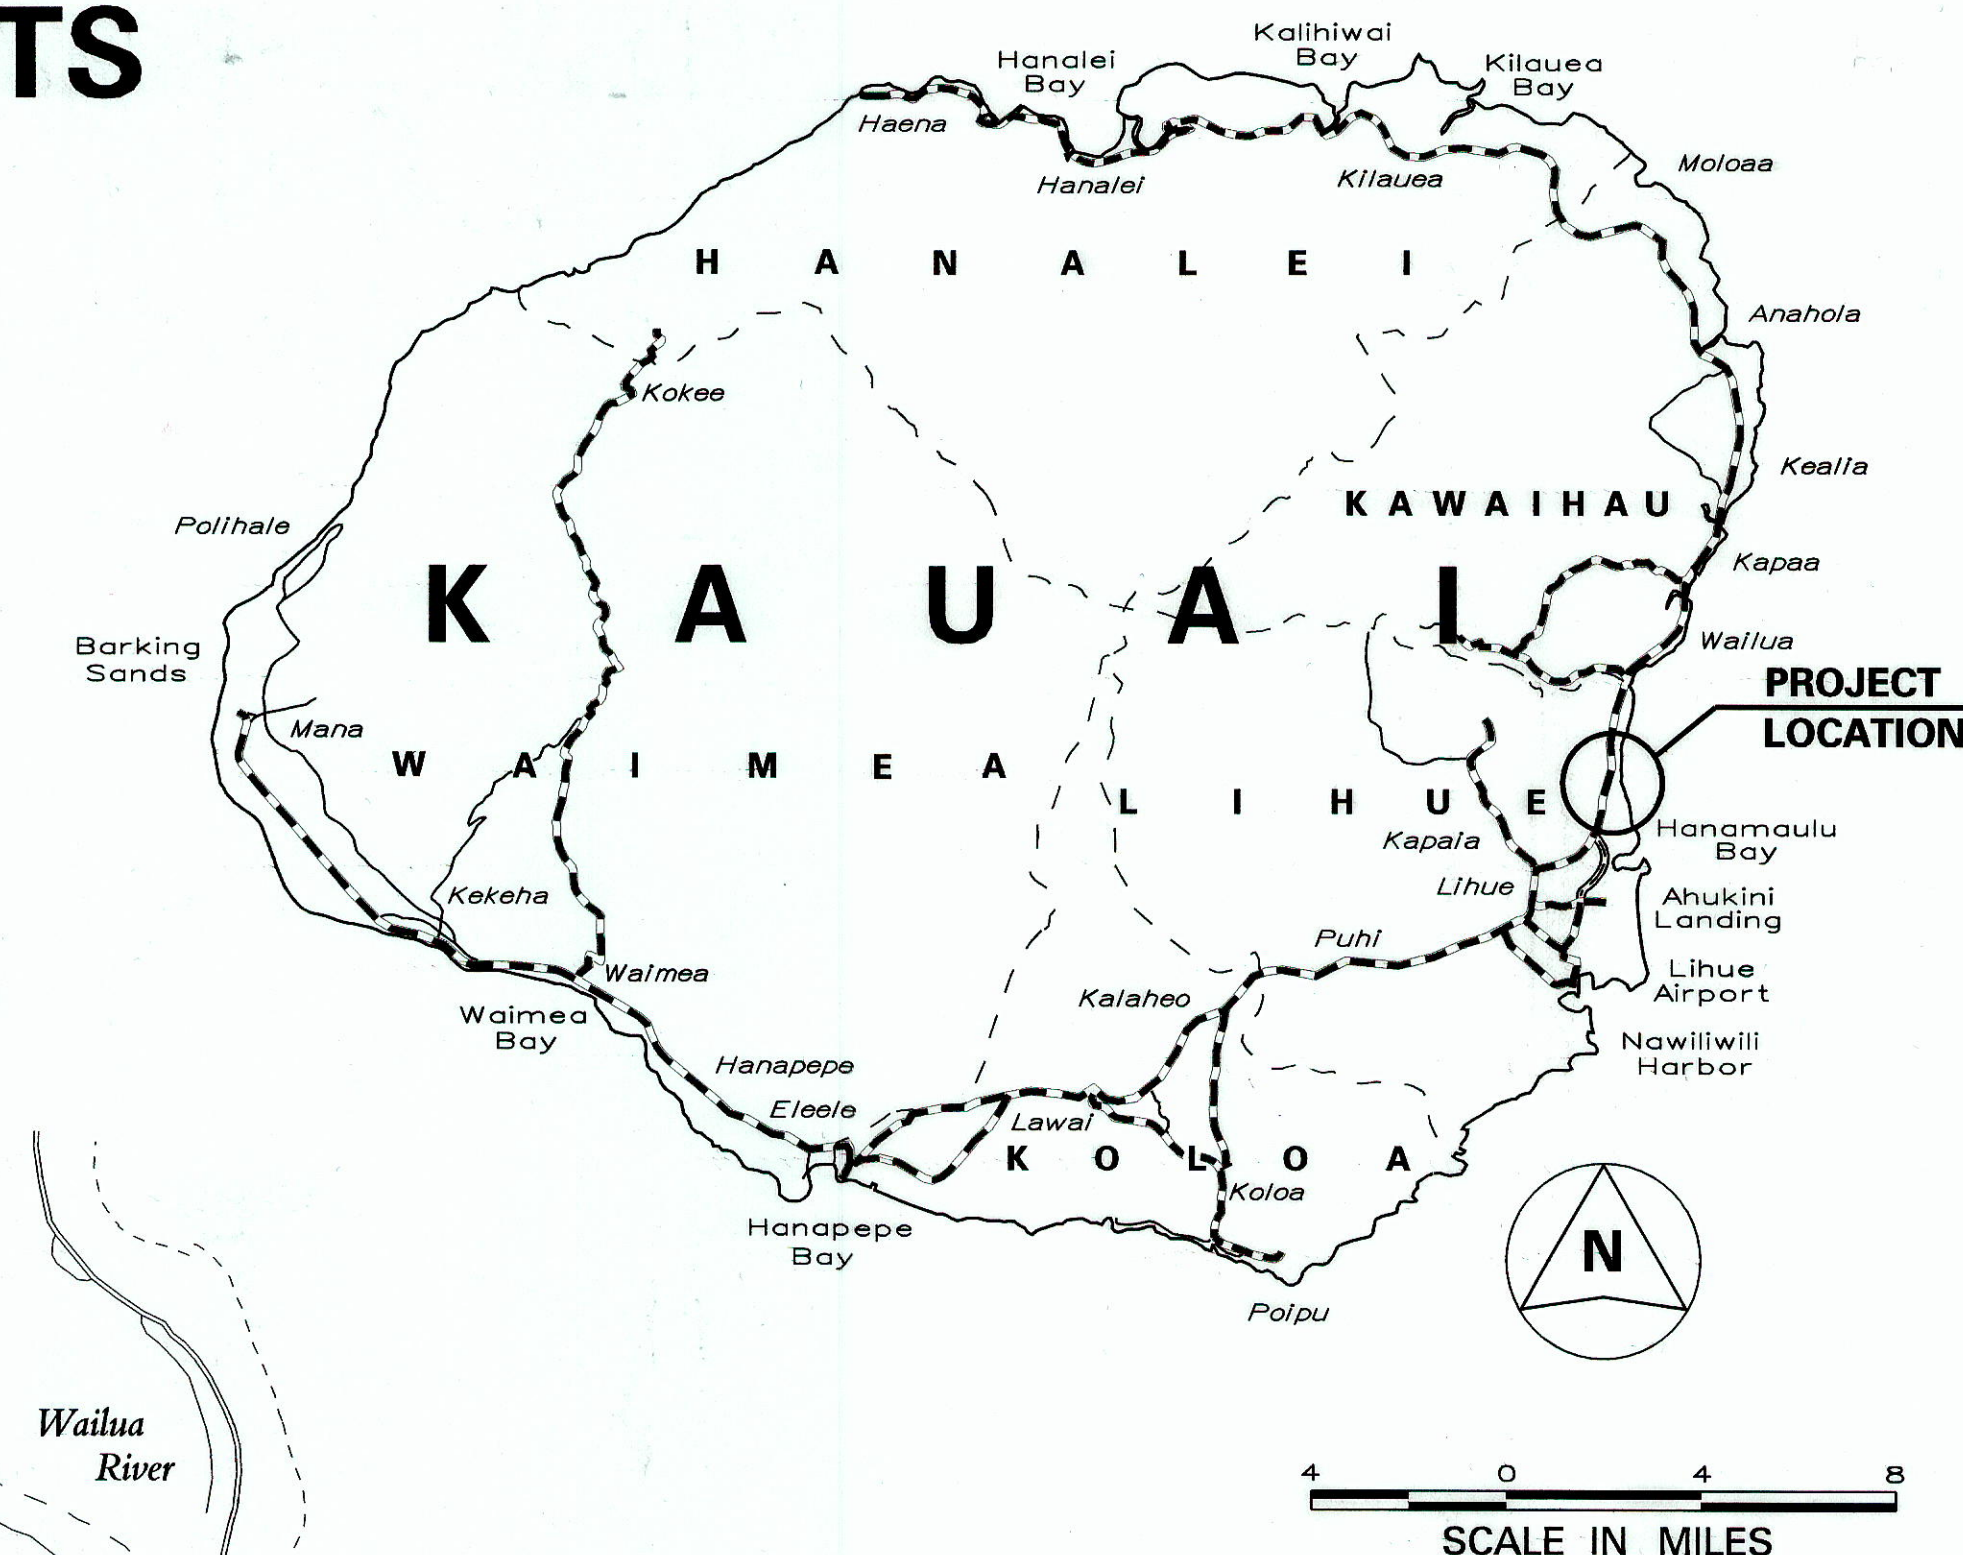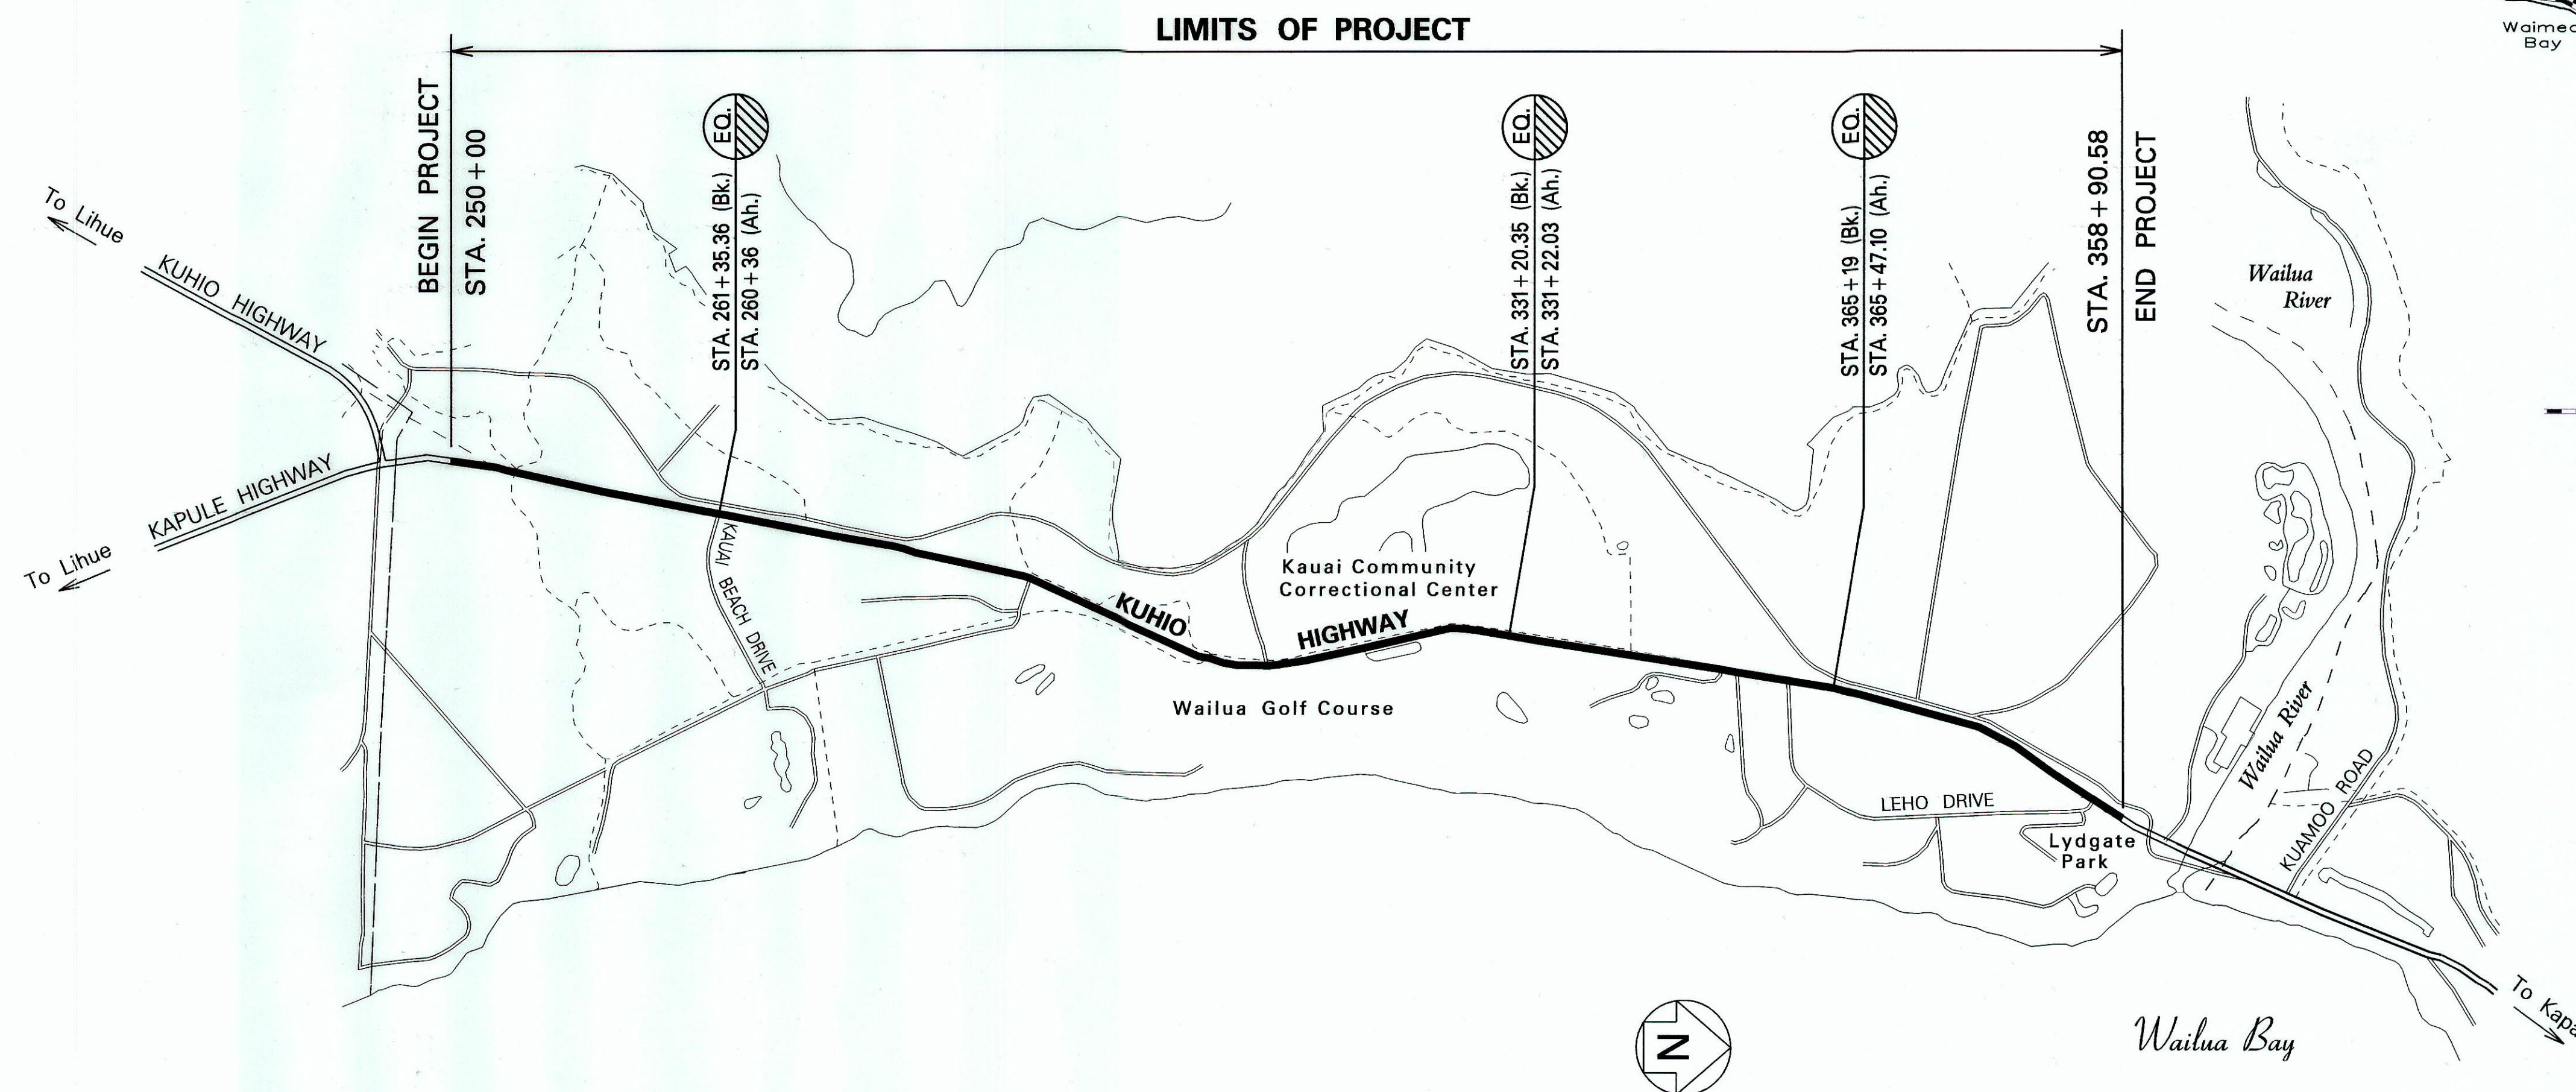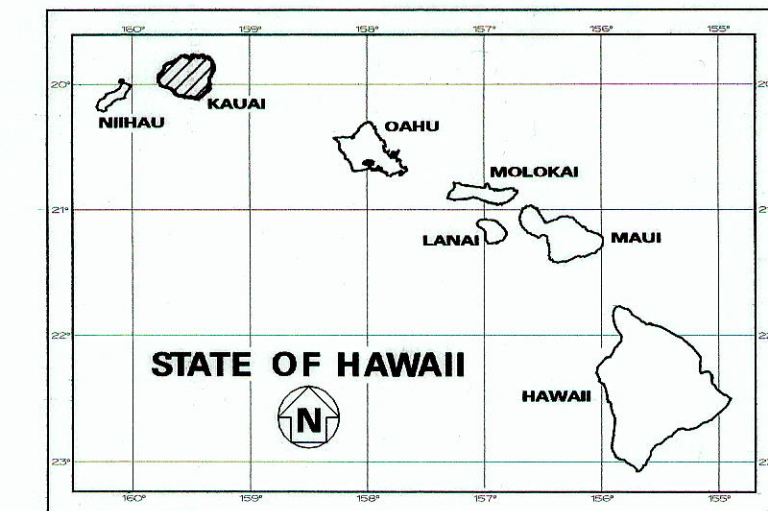

----- FEDERAL AID PROJECTS PREVIOUSLY CONSTRUCTED OR UNDER CONSTRUCTION

MILE POST 2.98 TO MILE POST 5.07

DESIGN DESIGNATION

ADT (2010)	34,390
ADT (2030)	42,720
DHV	3,420
D	60/40
T	2.0 %
V	40 M.P.H.

CHANGES MADE DURING CONSTRUCTION HAVE BEEN INCORPORATED ON THESE PLANS EXCEPT CHANGES IN THE ORIGINAL THEORETICAL QUANTITIES. FOR ACTUAL QUANTITIES, REFER TO PROJECT LEGGER AND/OR COMPUTATION BOOK.

[Signature] 10/15/2015
RESIDENT ENGINEER DATE

DEPARTMENT OF TRANSPORTATION STATE OF HAWAII	
APPROVED:	
<i>[Signature]</i>	7/13/10
DIR. OF TRANSPORTATION	DATE

DESIGNED BY
HWY-K

MANAGED BY
HWY-KE

PHONE
241-3000

DATE
JULY 2010

LAYOUT PLAN

GROSS LENGTH OF PROJECT..... 2.09 MILE
NET LENGTH OF PROJECT..... 2.09 MILE