
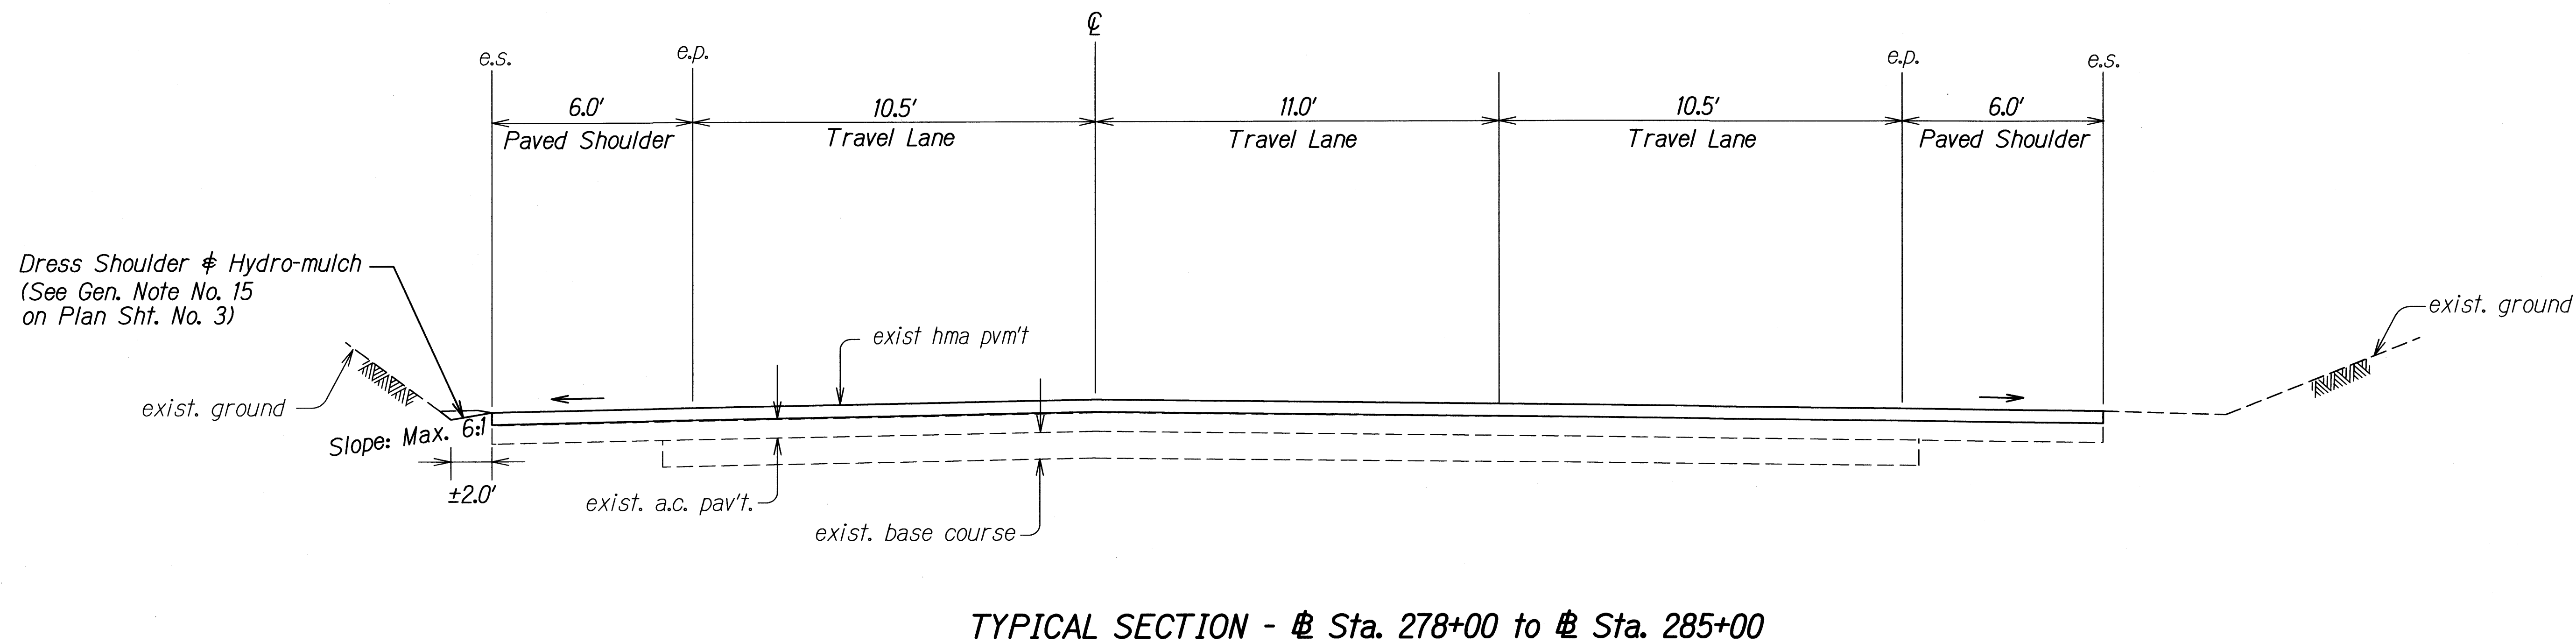


FED. ROAD DIST. NO.	STATE	PROJ. NO.	SHEET NO.	TOTAL SHEETS
HAWAII	HAW.	HSIP-056-1(53)	2010	6

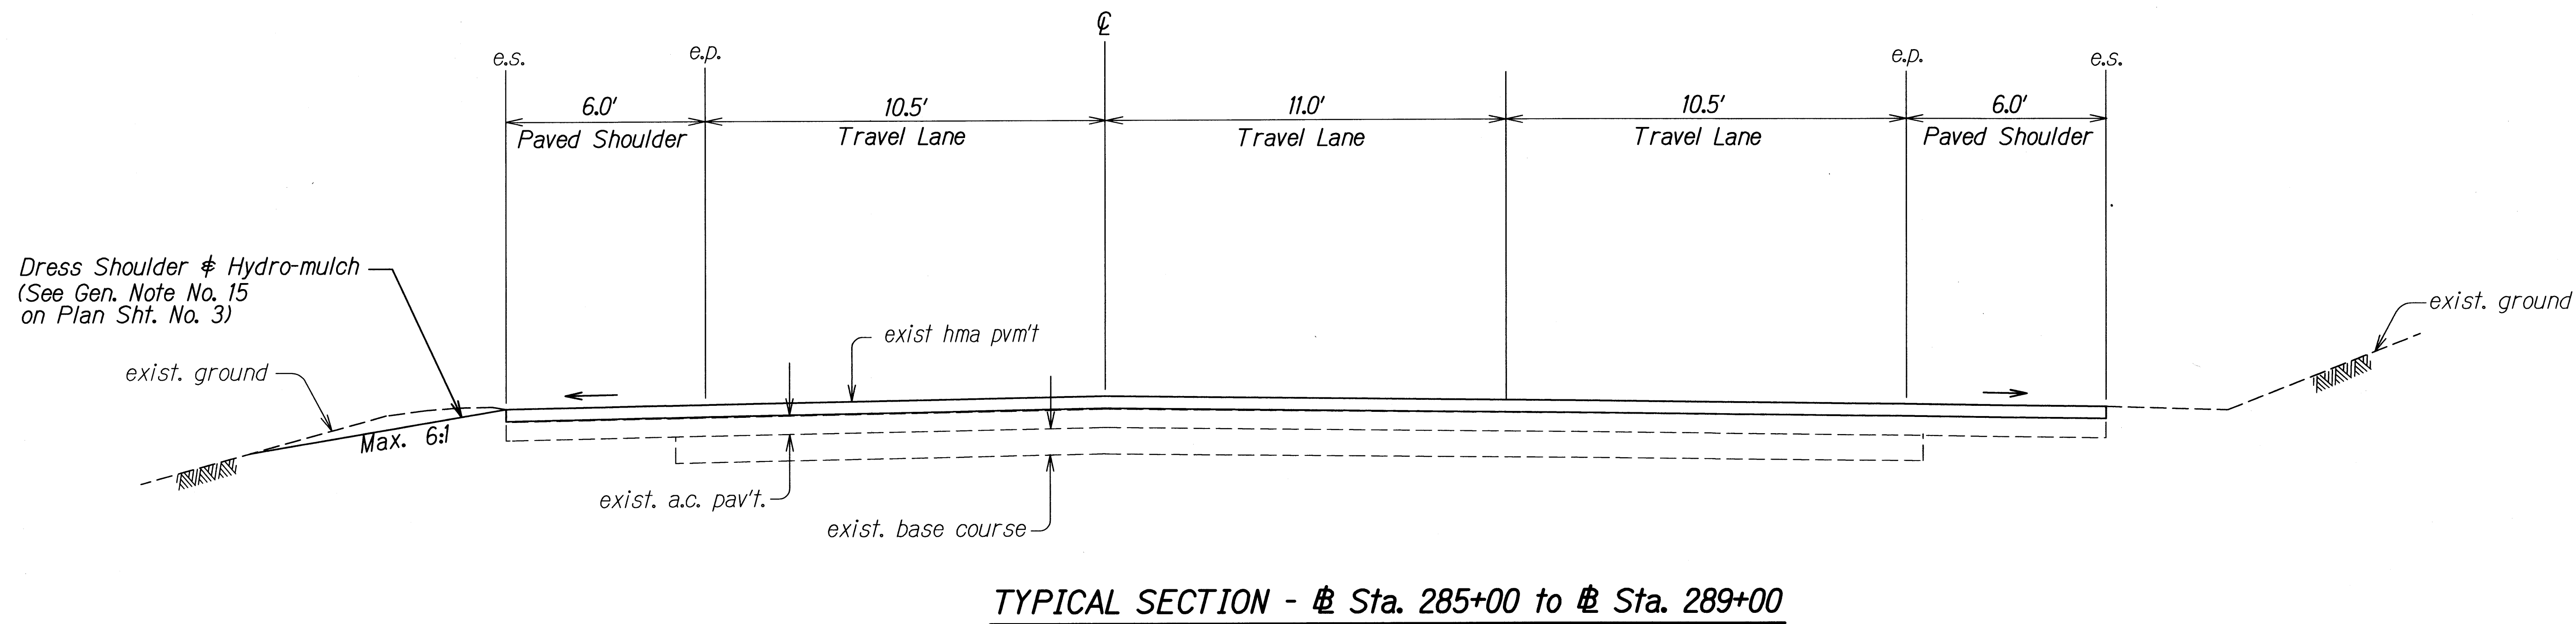

ORIGINAL PLAN	SURVEY PLOTTED BY	DATE
NOTE BOOK	DRAWN BY	9/2/09
DESIGNED BY	CHECKED BY	
CHECKED BY		

STATE OF HAWAII
DEPARTMENT OF TRANSPORTATION
HIGHWAYS DIVISION

TYPICAL SECTIONS

KUHIO HIGHWAY SAFETY IMPROVEMENTS
Mile Post 2.98 to Mile Post 5.07
Federal-Aid Project No. HSIP-056-1(53)

Not to Scale
Date: March 2010

SHEET No. 1 OF 1 SHEETS