


FED. ROAD DIST. NO.	STATE	PROJ. NO.	FISCAL YEAR	SHEET NO.	TOTAL SHEETS
HAWAII	HAW.	56A-01-12M	2012	19	22

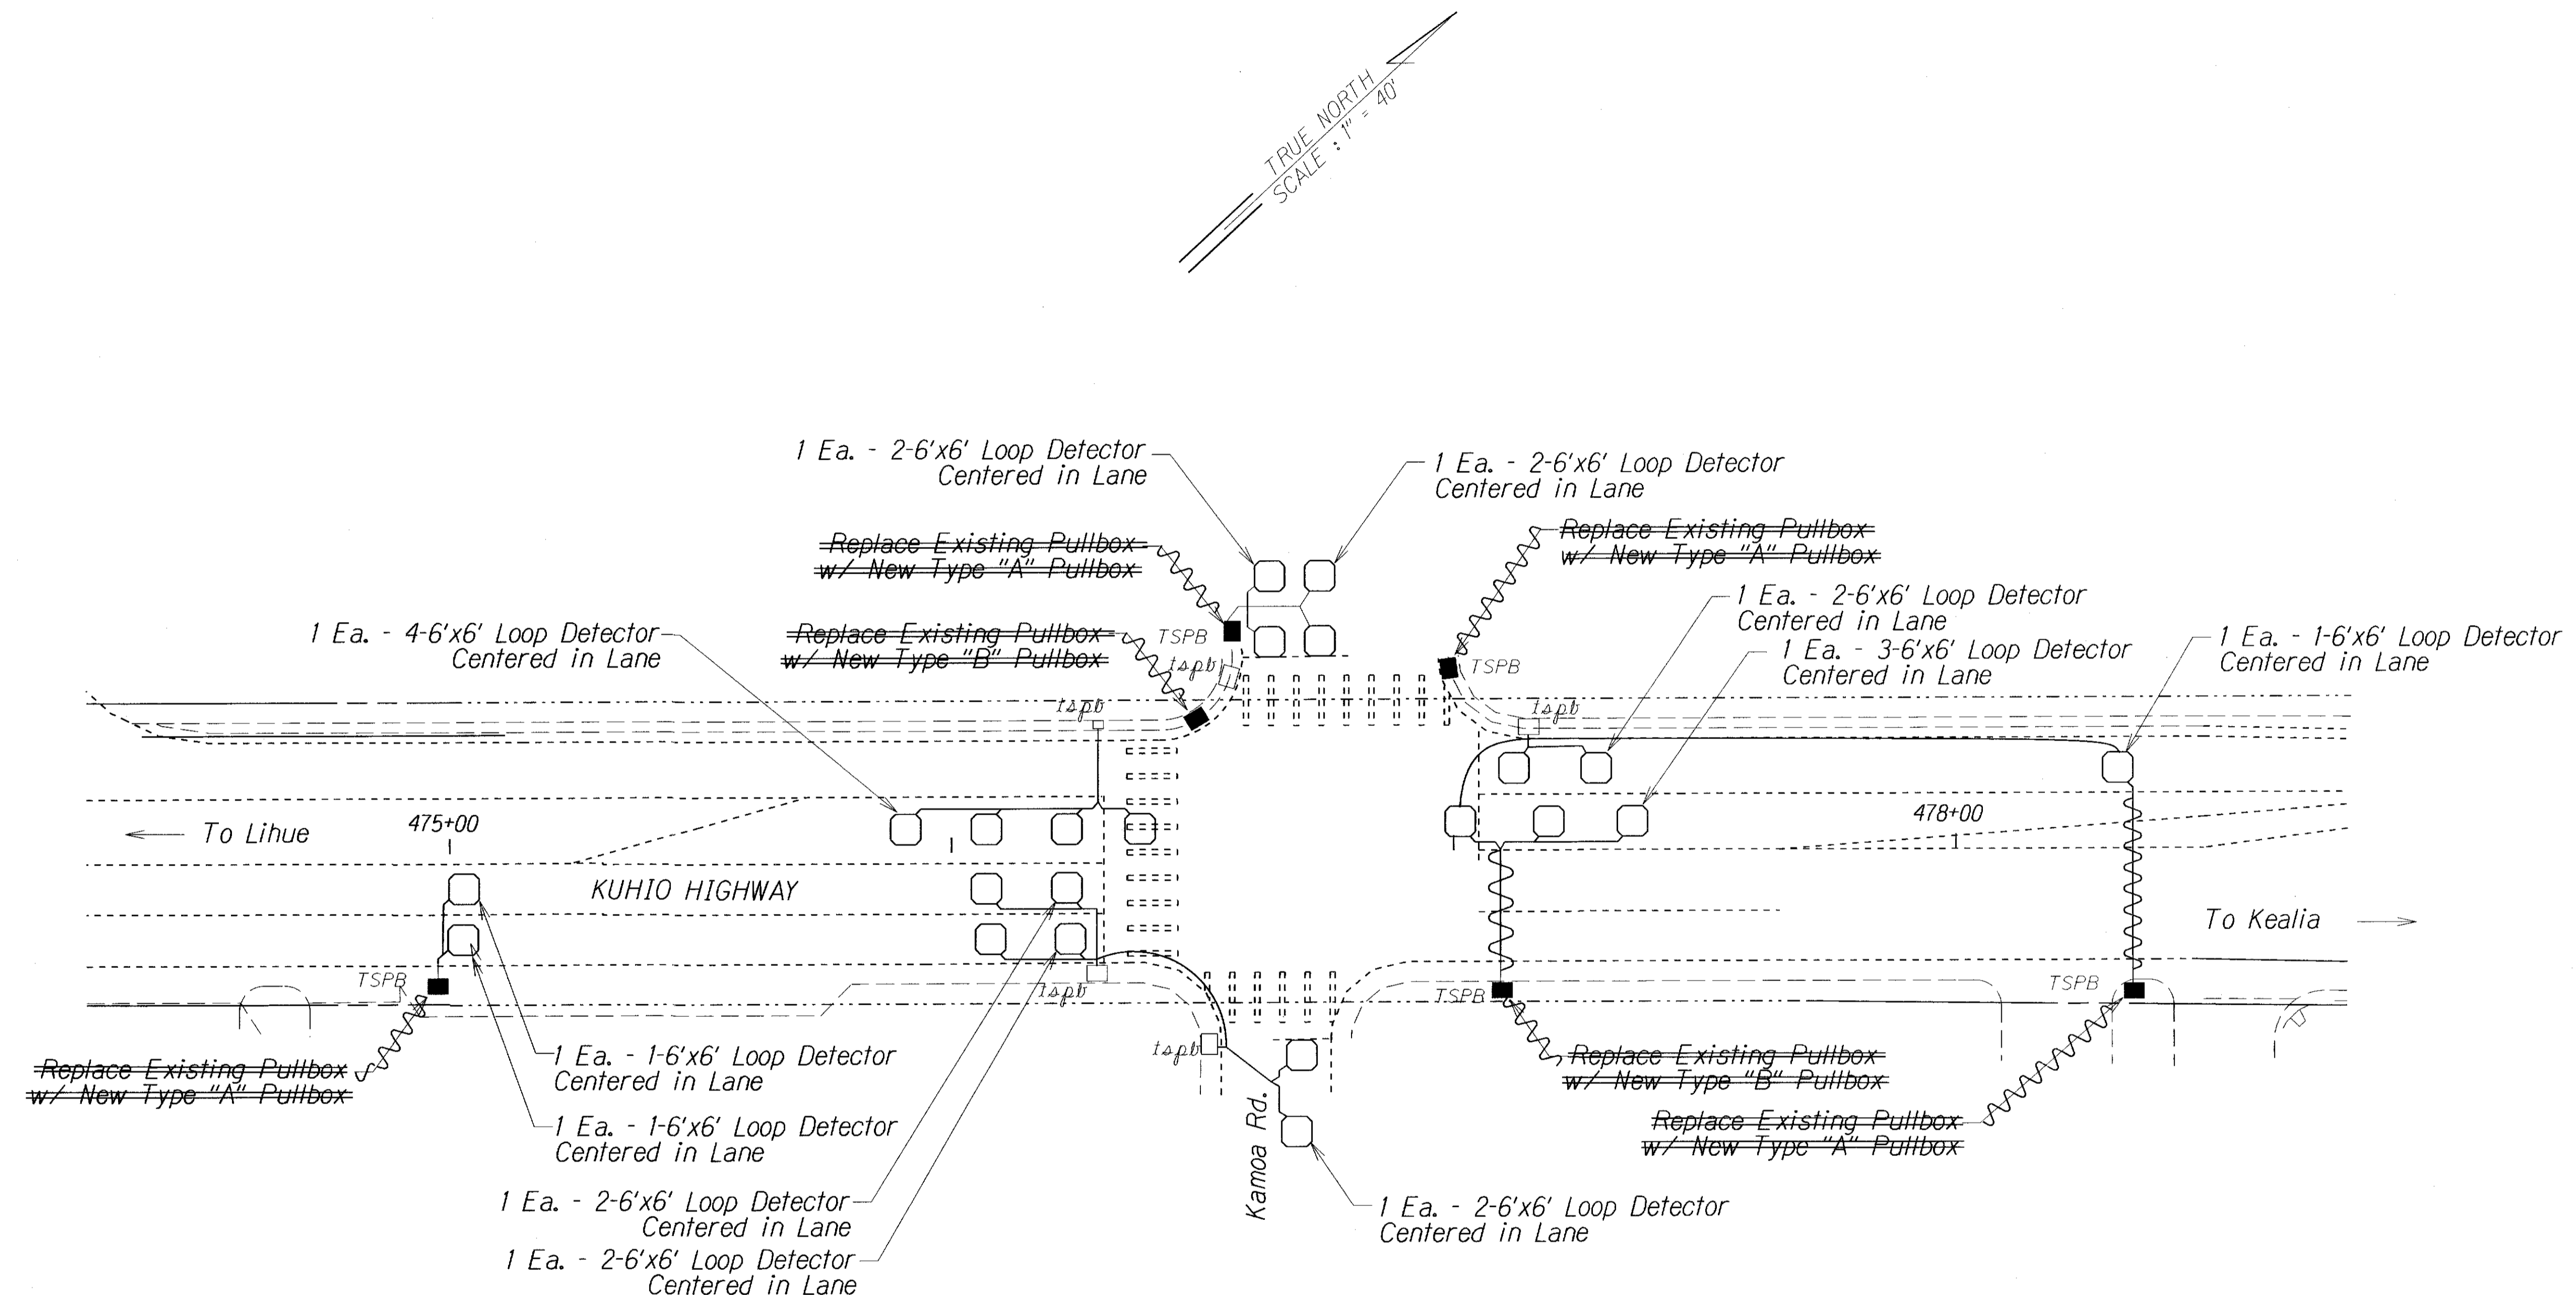

Notes:


1. Refer to HDOT Standard Plan TE-34 & TE-35 for loop detector details.
2. Install loop detectors prior to resurfacing works.
3. New traffic signal pullbox (TSPB) to follow elevation and location of existing pullbox. Refer to HDOT Standard Plan for Type "A" & Type "B" traffic pullboxes details.
4. Install new cable/conduit from sensor loop to traffic signal pullbox. Existing conduit between traffic signal pullbox shall remain.

LEGEND FOR AS-BUILT POSTINGS	
	Squiggly line for as-built deletion
	Double line for as-built deletion
Roadway	Text for as-built posting

STATE OF HAWAII DEPARTMENT OF TRANSPORTATION HIGHWAYS DIVISION	
LOOP DETECTOR PLAN	
KUHIO HIGHWAY RESURFACING Temporary Kapaa Bypass Rd. to Waikaea Br. Project No. 56A-01-12M	
Scale: 1" = 20'	Date: May 2012
SHEET No. 1 OF 3 SHEETS	

"AS-BUILT"

FED. ROAD DIST. NO.	STATE	PROJ. NO.	FISCAL YEAR	SHEET NO.	TOTAL SHEETS
HAWAII	HAW.	56A-01-12M	2012	20	22

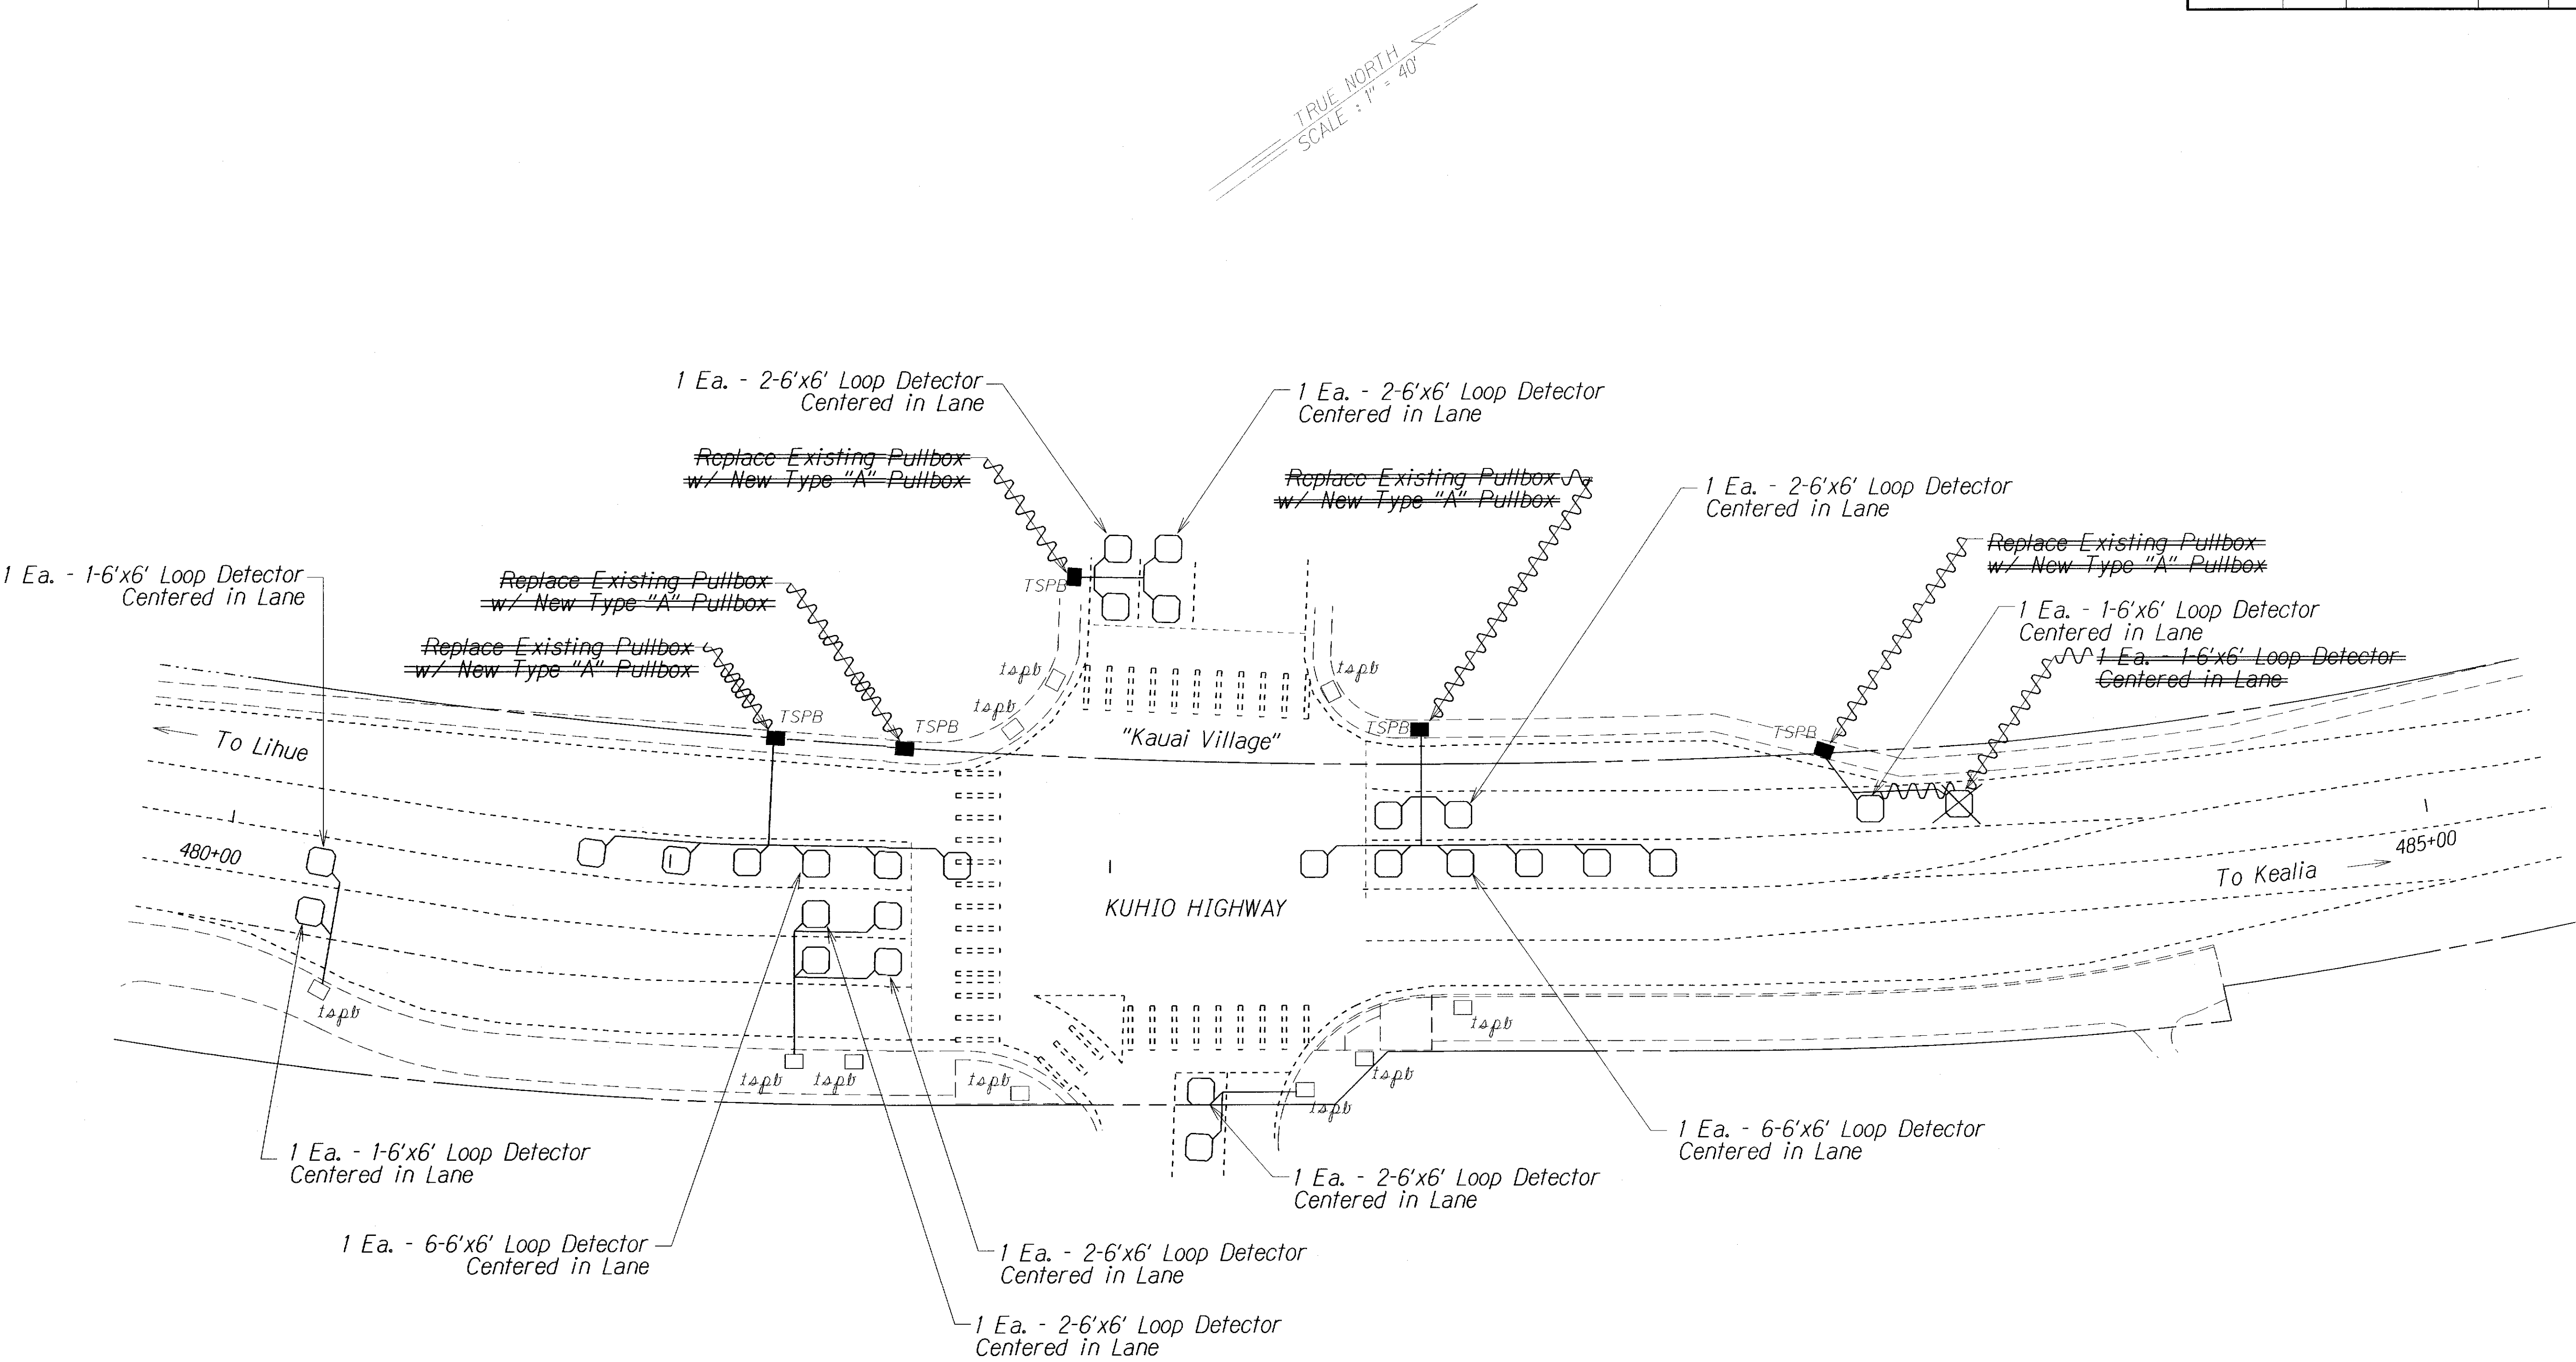

ORIGINAL PLAN	SURVEY PLOTTED BY	DATE
NOTE BOOK	DESIGNED BY	
QUANTITIES BY	CHECKED BY	

LEGEND FOR AS-BUILT POSTINGS	
	Squiggly line for as-built deletion
	Double line for as-built deletion
Roadway	Text for as-built posting

- Notes:
1. Refer to HDOT Standard Plan TE-34 & TE-35 for loop detector details.
 2. Install loop detectors prior to resurfacing works.
 3. New traffic signal pullbox (TSPB) to follow elevation and location of existing pullbox. Refer to HDOT Standard Plan for Type "A" traffic pullbox details.
 4. Install new cable/conduit from sensor loop to traffic signal pullbox. Existing conduit between traffic signal pullbox shall remain.


STATE OF HAWAII
DEPARTMENT OF TRANSPORTATION
HIGHWAYS DIVISION

LOOP DETECTOR PLAN
KUHIO HIGHWAY RESURFACING
Temporary Kapaa Bypass Rd. to Waikaea Br.
Project No. 56A-01-12M
Scale: 1" = 20'
Date: May 2012

SHEET No. 2 OF 3 SHEETS

"AS-BUILT"

FED. ROAD DIST. NO.	STATE	PROJ. NO.	FISCAL YEAR	SHEET NO.	TOTAL SHEETS
HAWAII	HAW.	56A-01-12M	2012	21	22

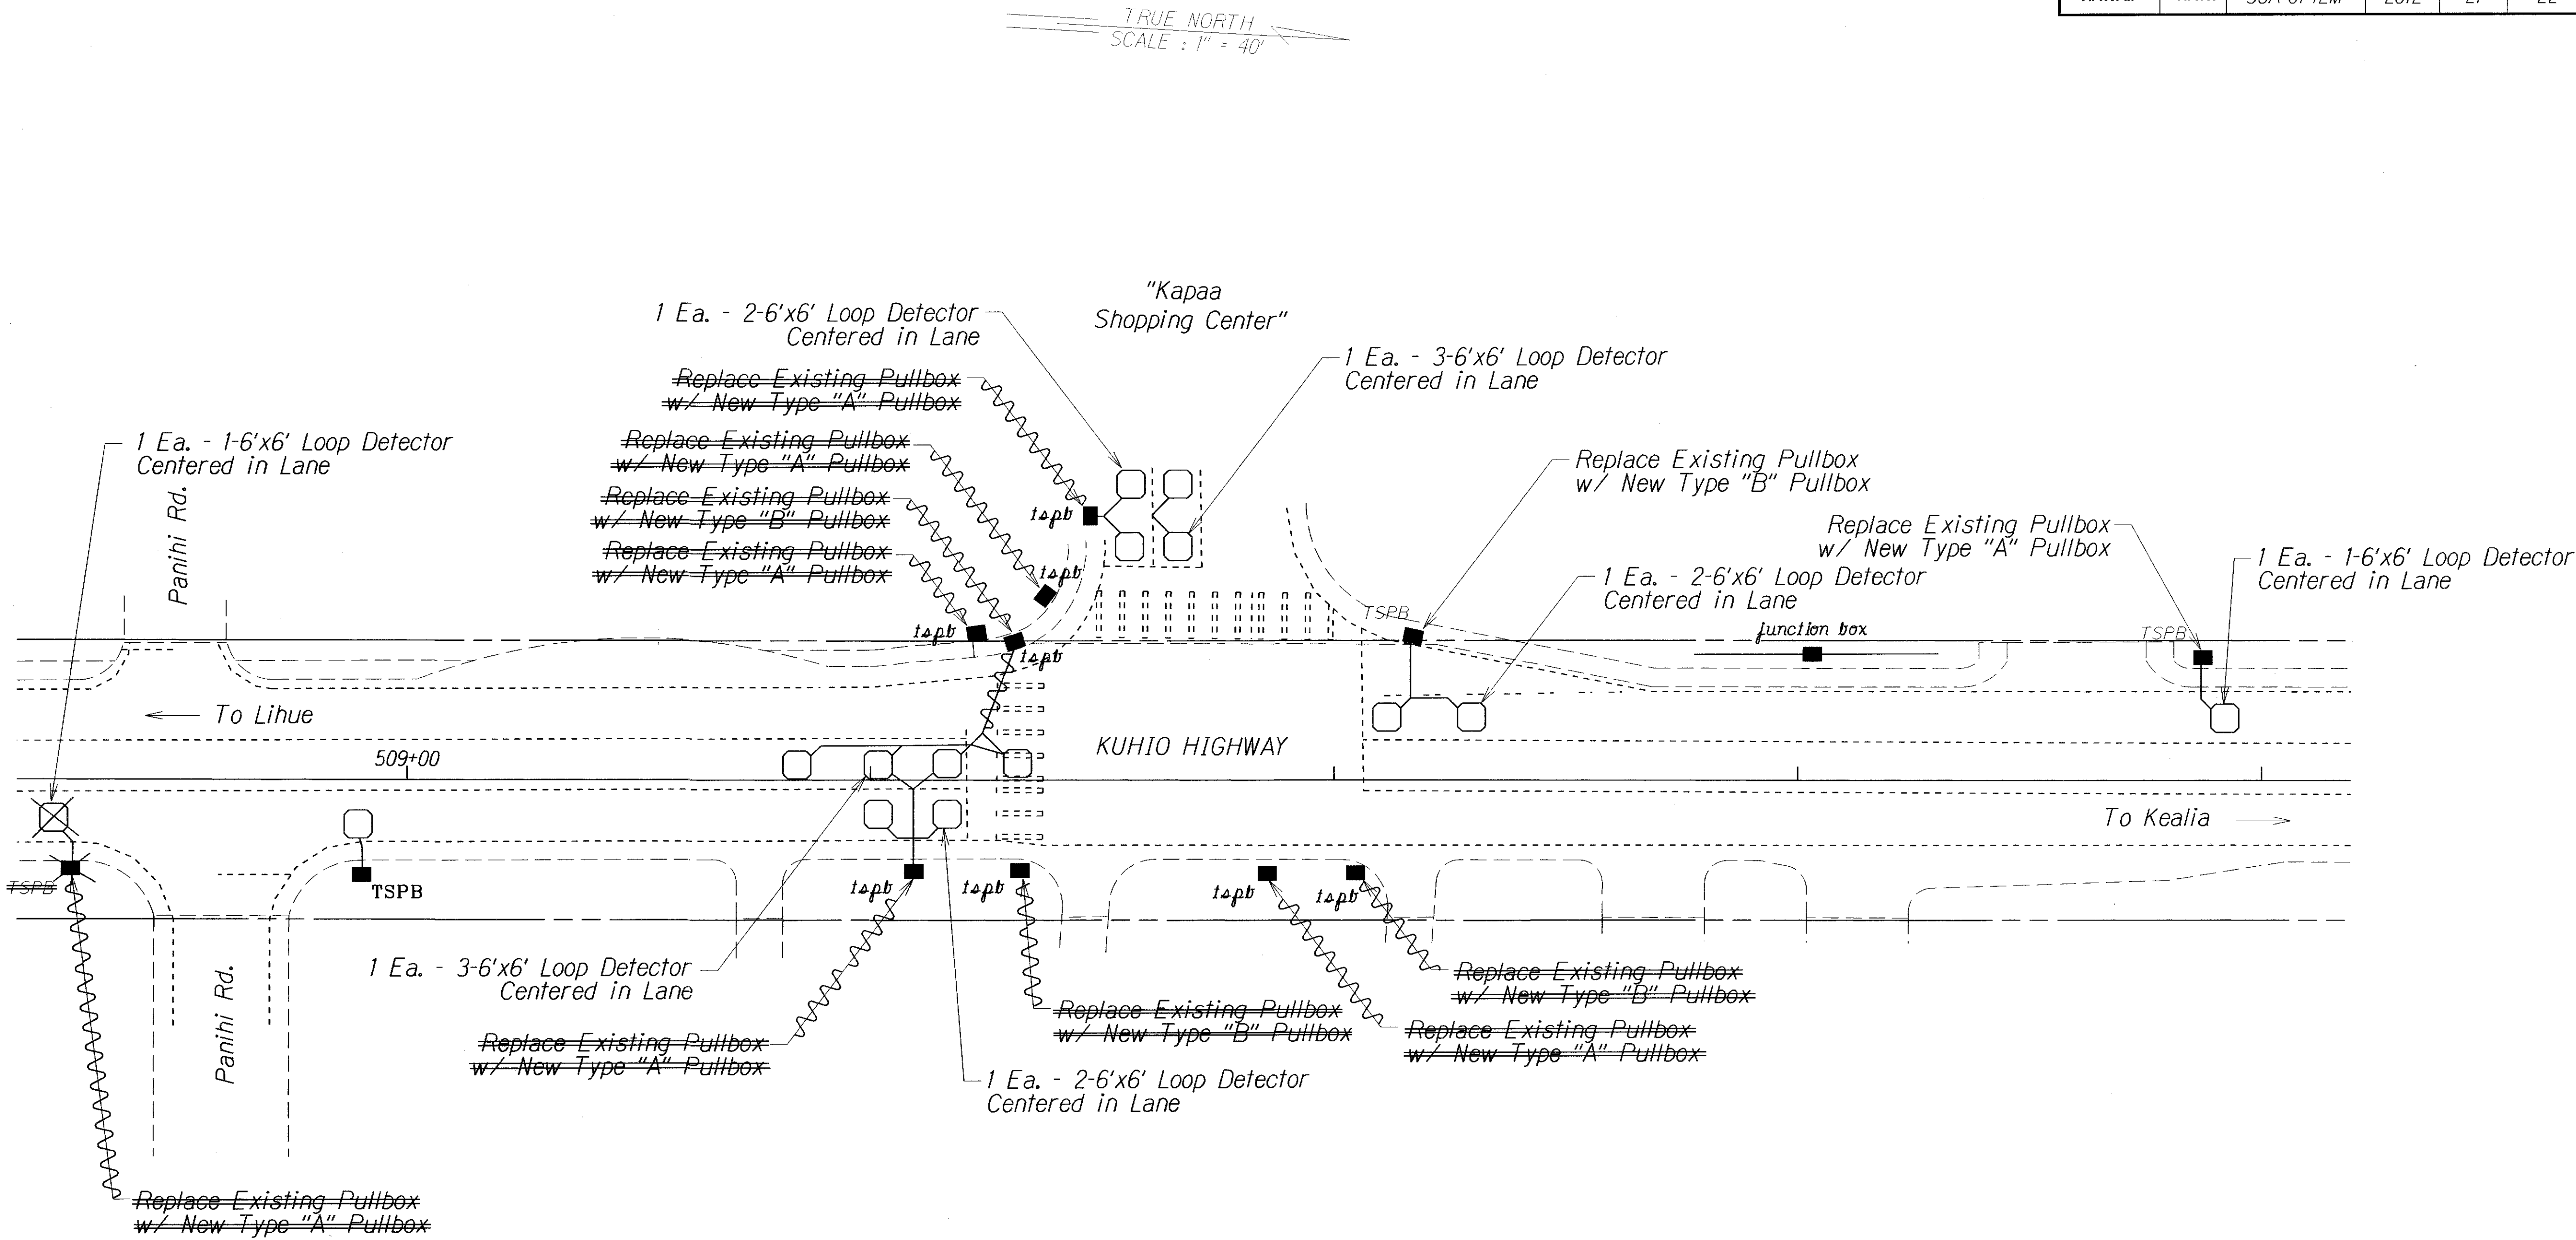

ORIGINAL PLAN	SURVEY PLOTTED BY	DATE
NOTE BOOK	DESIGNED BY	
	QUANTITIES BY	
	CHECKED BY	

LEGEND FOR AS-BUILT POSTINGS	
	Squiggly line for as-built deletion
	Double line for as-built deletion
Roadway	Text for as-built posting

- Notes:
1. Refer to HDOT Standard Plan TE-34 & TE-35 for loop detector details.
 2. Install loop detectors prior to resurfacing works.
 3. New traffic signal pullbox (TSPB) to follow elevation and location of existing pullbox. Refer to HDOT Standard Plan for Type "A" & Type "B" traffic pullboxes details.
 4. Install new cable/conduit from sensor loop to traffic signal pullbox. Existing conduit between traffic signal pullbox shall remain.

STATE OF HAWAII
DEPARTMENT OF TRANSPORTATION
HIGHWAYS DIVISION

LOOP DETECTOR PLAN
KUHIO HIGHWAY RESURFACING
Temporary Kapaa Bypass Rd. to Waikaea Br.
Project No. 56A-01-12M
Scale: 1" = 20'
Date: May 2012

SHEET No. 3 OF 3 SHEETS