INDEX TO DRAWINGS	
SHEET NO.	DESCRIPTION
1	TITLE SHEET
2	STANDARD PLANS SUMMARY
3	GENERAL NOTES & LEGEND
4 – 5	WATER POLLUTION AND EROSION CONTROL NOTES
6 – 8	TYPICAL SECTIONS
9 – 12	ROADWAY PLAN
13	PAVEMENT MARKING, NOTES, LEGEND, AND SIGN DETAILS
14 – 17	PAVEMENT MARKING AND TRAFFIC SIGNING PLAN
18	SIGN DETAILS
19 - 21	LOOP DETECTOR PLAN
22	LOW SPEED UNDIVIDED HIGHWAY WORK ZONE SIGNING PLAN, NOTES & DETAILS

May 2012 DATE

HWY-KE MANAGED BY STATE OF HAWAII

DEPARTMENT OF TRANSPORTATION


HIGHWAYS DIVISION

AS-BUILT, HONOLULU, HAWAII

PLANS FOR


All HAW. 56A-01-12M 2012 1 22



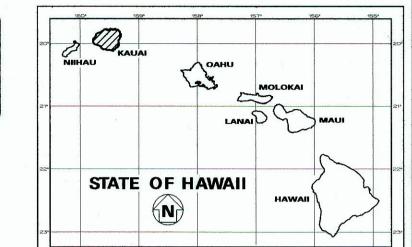

KUHIO HIGHWAY RESURFACING
TEMPORARY KAPAA BYPASS RD. TO WAIKAEA BR.
PROJECT NO. 56A-01-12M

DISTRICT OF KAWAIHAU ISLAND OF KAUAI

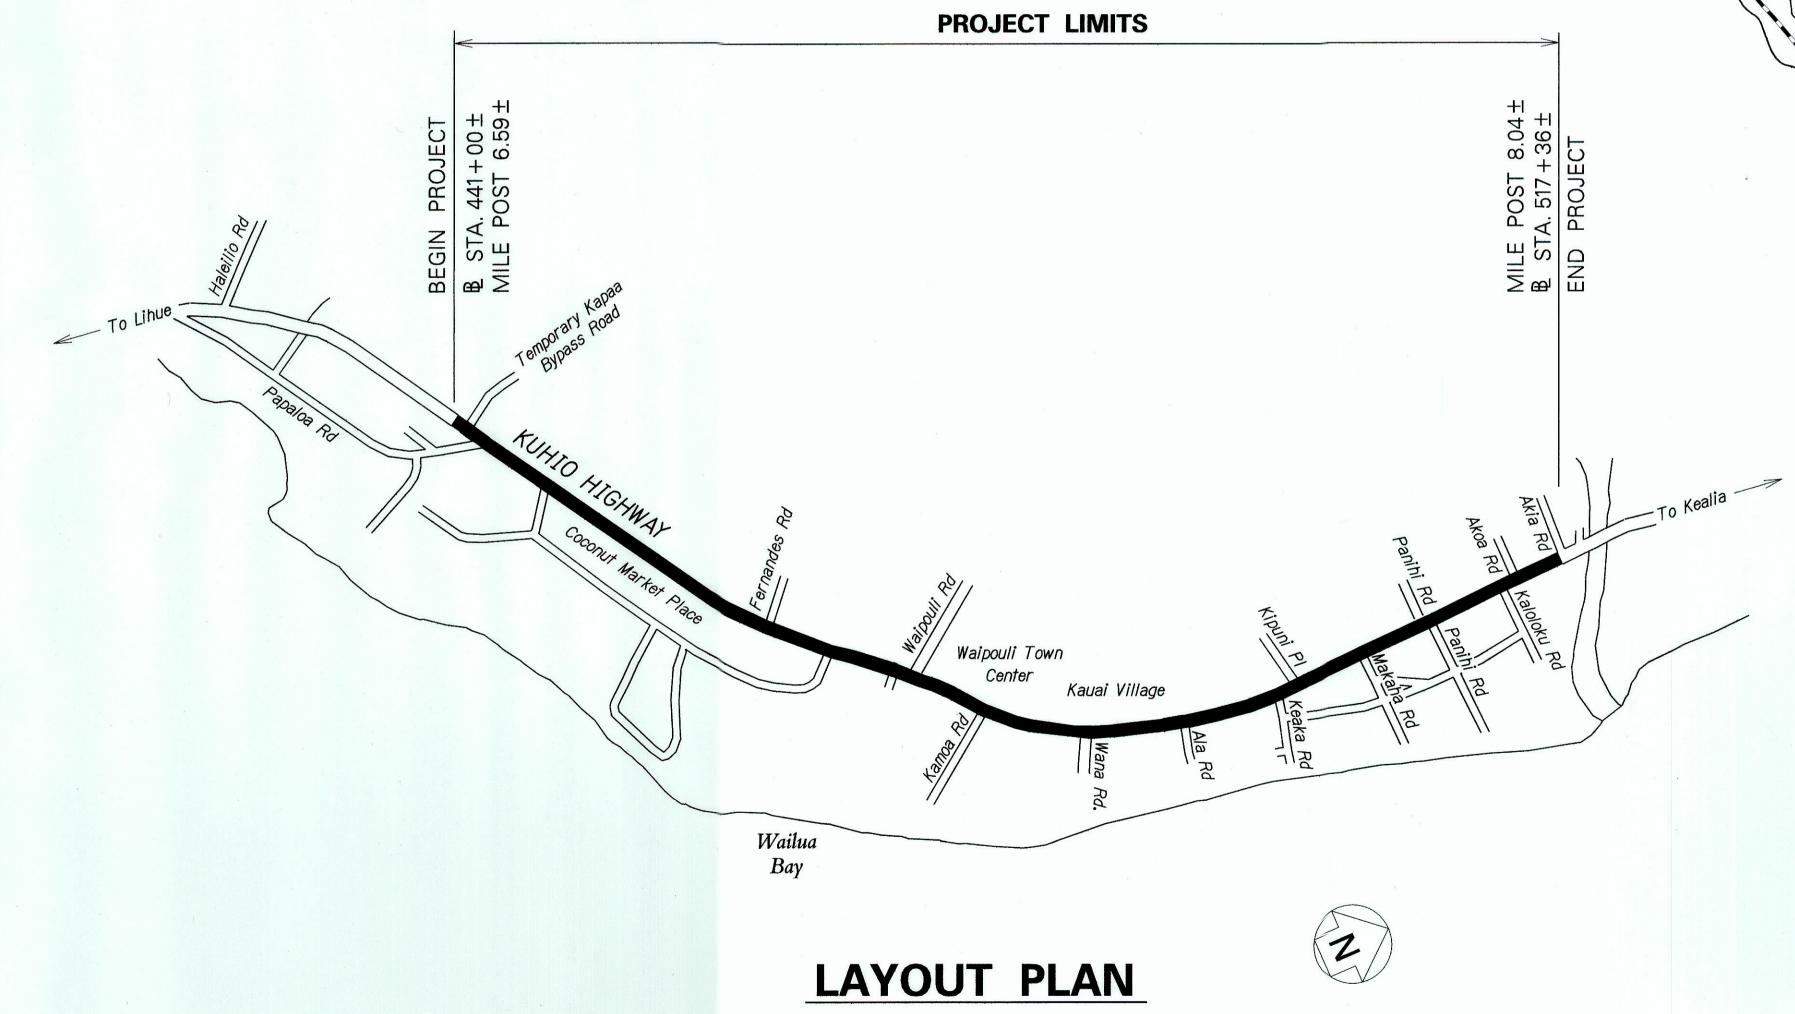

GROSS LENGTH OF PROJECT..... 2.05 MILE

NET LENGTH OF PROJECT..... 2.05 MILE

Barking Sands

Mana

K A WA I HA U

Kapaa PROJECT LOCATION

Wailua Bay

Walinea Walinea Walinea Kalaheo

Walinea Bay

Walinea Kalaheo

Walinea Kalaheo

Nawiliwili Harbor

Rawai Kalaheo

Nawiliwili Harbor

SCALE IN MILES

FEDERAL AID PROJECTS PREVIOUSLY CONSTRUCTED OR UNDER CONSTRUCTION

MILE POST 6.59 TO MILE POST 8.04

CHANGES MADE DURING CONSTRUCTION HAVE BEEN INCORPORATED ON THESE PLANS EXCEPT CHANGES IN THE ORIGINAL THEORETICAL QUANTITIES. FOR ACTUAL QUANTITIES, REFER TO PROJECT LEDGER AND/OR COMPUTATION BOOK.

DEPARTMENT OF TRANSPORTATION STATE OF HAWAII

APPROVED:

Sur G. Yaluth

5/08/12 DATE