

**STATE OF HAWAII
DEPARTMENT OF TRANSPORTATION
HIGHWAYS DIVISION**

ADDENDUM NO. 3

FOR

KUHIO HIGHWAY INTERSECTION IMPROVEMENTS

**KAUAI CORRECTIONAL COMMUNITY CENTER
AND WAILUA GOLF COURSE**

PROJECT NO. 56A-01-10

DISTRICT OF LIHUE

ISLAND OF KAUAI

2012

Amend the Bid Documents as follows:

A. PRE-PROPOSAL MEETING

Add attached Figure 1 missing from Addendum No. 2

Please acknowledge receipt of this Addendum No. 2 by recording the date of its receipt in the space provided on page P-4 of the Proposal.



GLENN M. OKIMOTO, Ph.D.
Director of Transportation

DIST. NO.	STATE	PROJ. NO.	FISCAL YEAR	SHEET NO.	TOTAL SHEETS
HAWAII	HAW.	56A-01-10	1980	6	23


SUMMARY OF PAVEMENT MARKINGS						
Location	PSM Arrow	Striping L ⁺ Yellow White	Raised Markers E ⁺ Type "C" Type "D" Type "H" Type "J"			
Road E		822 566		25	104	5640
Paved Island		1613 1000	1013	48	25	
Storage Lane		288 288	57	7		
Edge of Pavement		4132 152				
Approach		100 198		7		
Total	E	3018 1994	4570	442	6570	68

**Figure No. 1
Project Limits Map
Project No. 56A-01-10**

True North
Scale: 1"=50'

Project Limits

Sta 315+00 to Sta 334+00
Install Pavement Markers, Turn Arrows
and Strip Roadway as shown

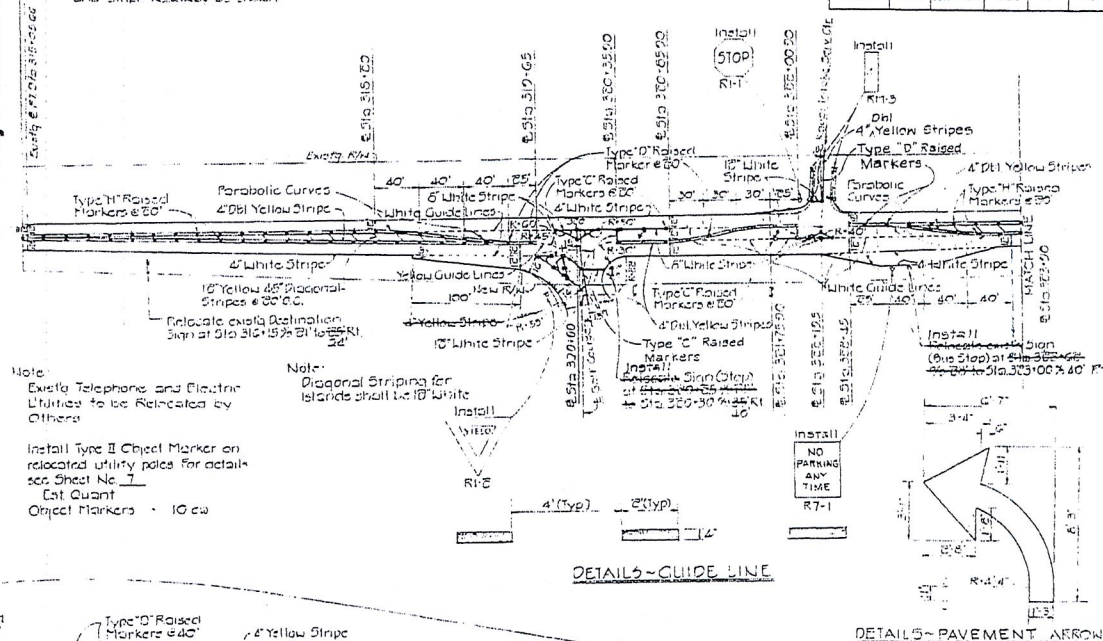


Note:
Existing Telephone and Electric
Utilities to be Relocated by
Others
Install Type II Object Marker on
relocated utility poles for details
see Sheet No. 7
Est. Quant.
Object Markers - 10 ea

Note:
Diagonal Striping for
Islands shall be 18\"/>

DETAILS-GUIDE LINE

DETAILS-PAVEMENT ARROW

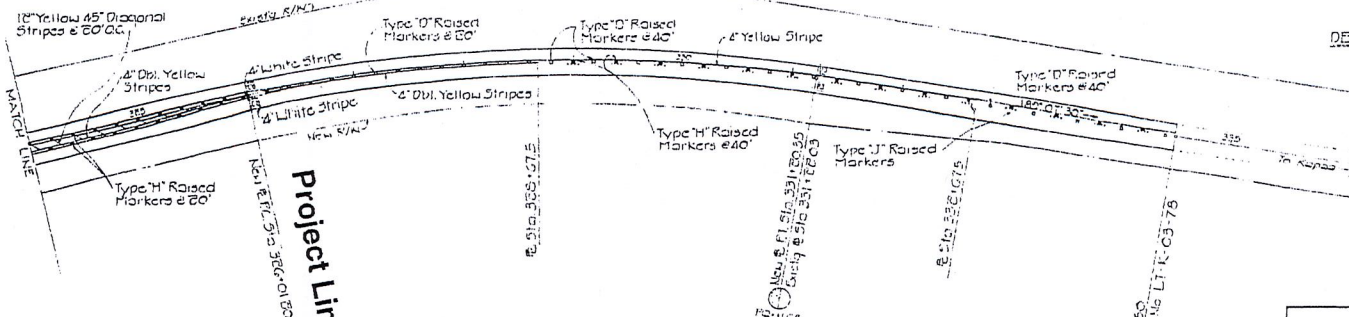

Project Limits

DESIGNED BY	DATE
CHECKED BY	DATE
APPROVED BY	DATE
NOTED BY	DATE
BY	DATE

STATE OF HAWAII
DEPARTMENT OF TRANSPORTATION
HIGHWAYS DIVISION
KAWAULAI ROAD - SAFETY IMPROVEMENT
VICINITY OF WAIHAGOLF COURSE
PROJ. NO. 56A-01-10
PAVEMENT MARKERS & STRIPING
Scale: As shown July 1975
SHEET No. 6 OF 23 SHEETS