
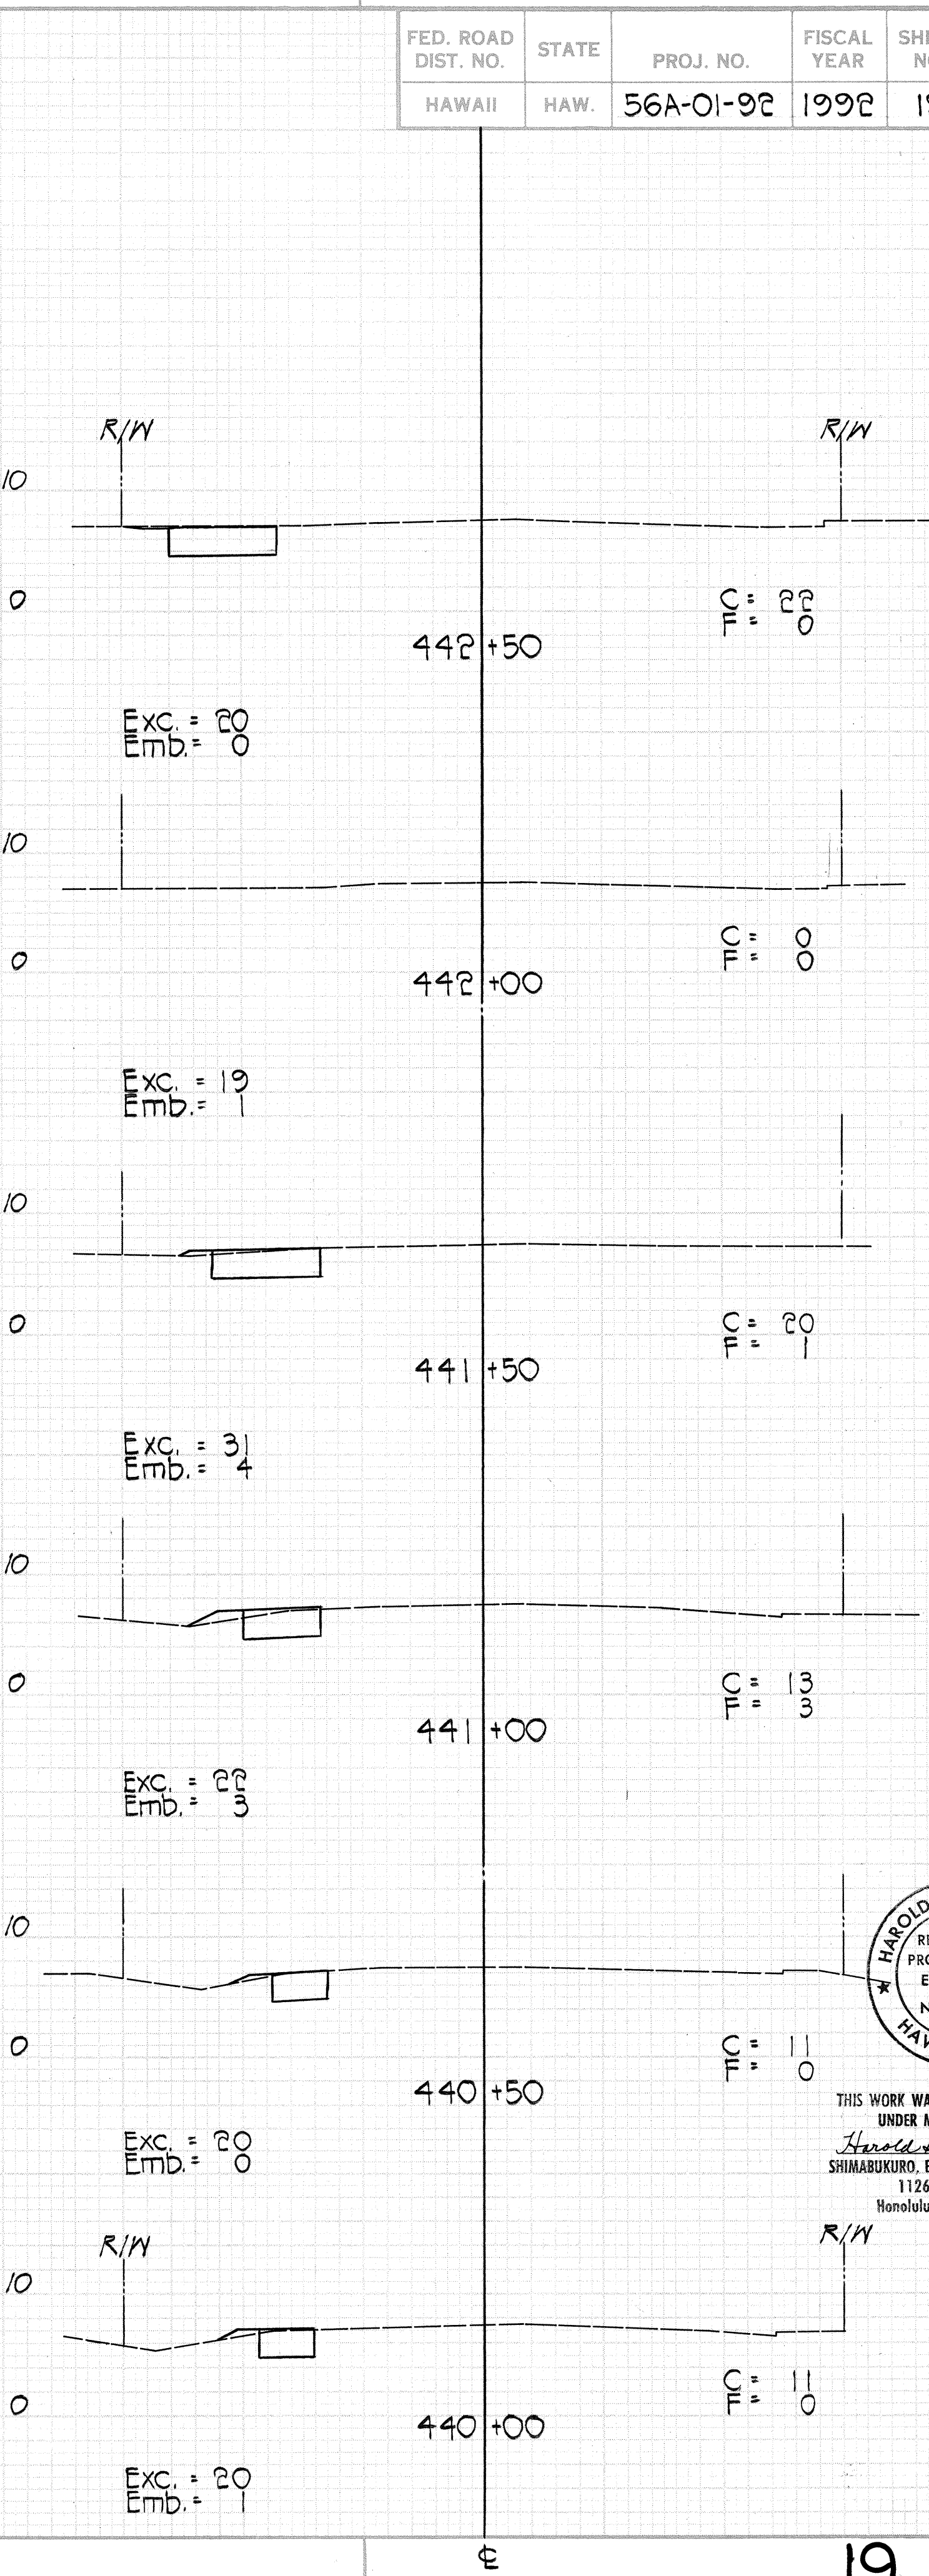
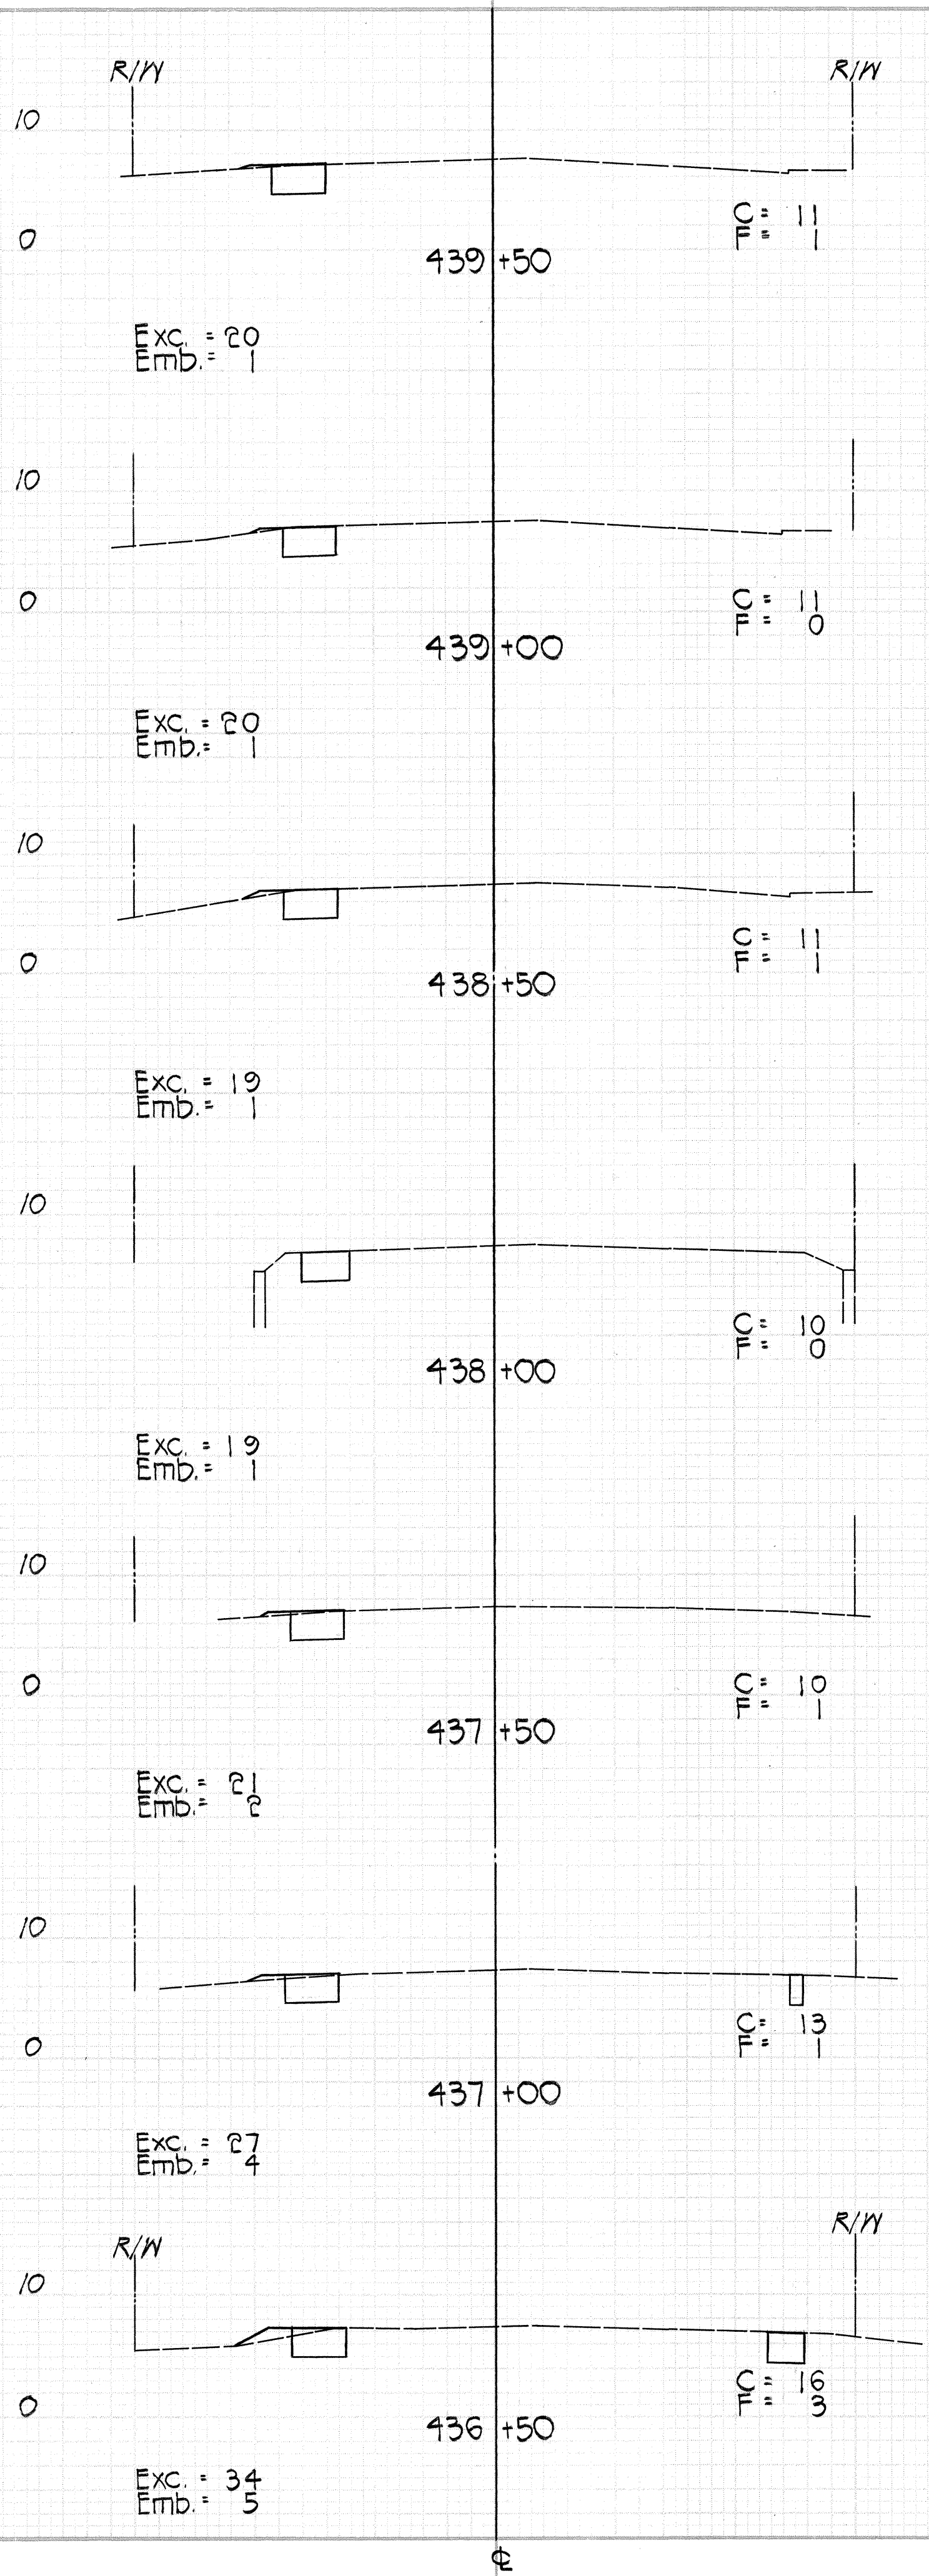
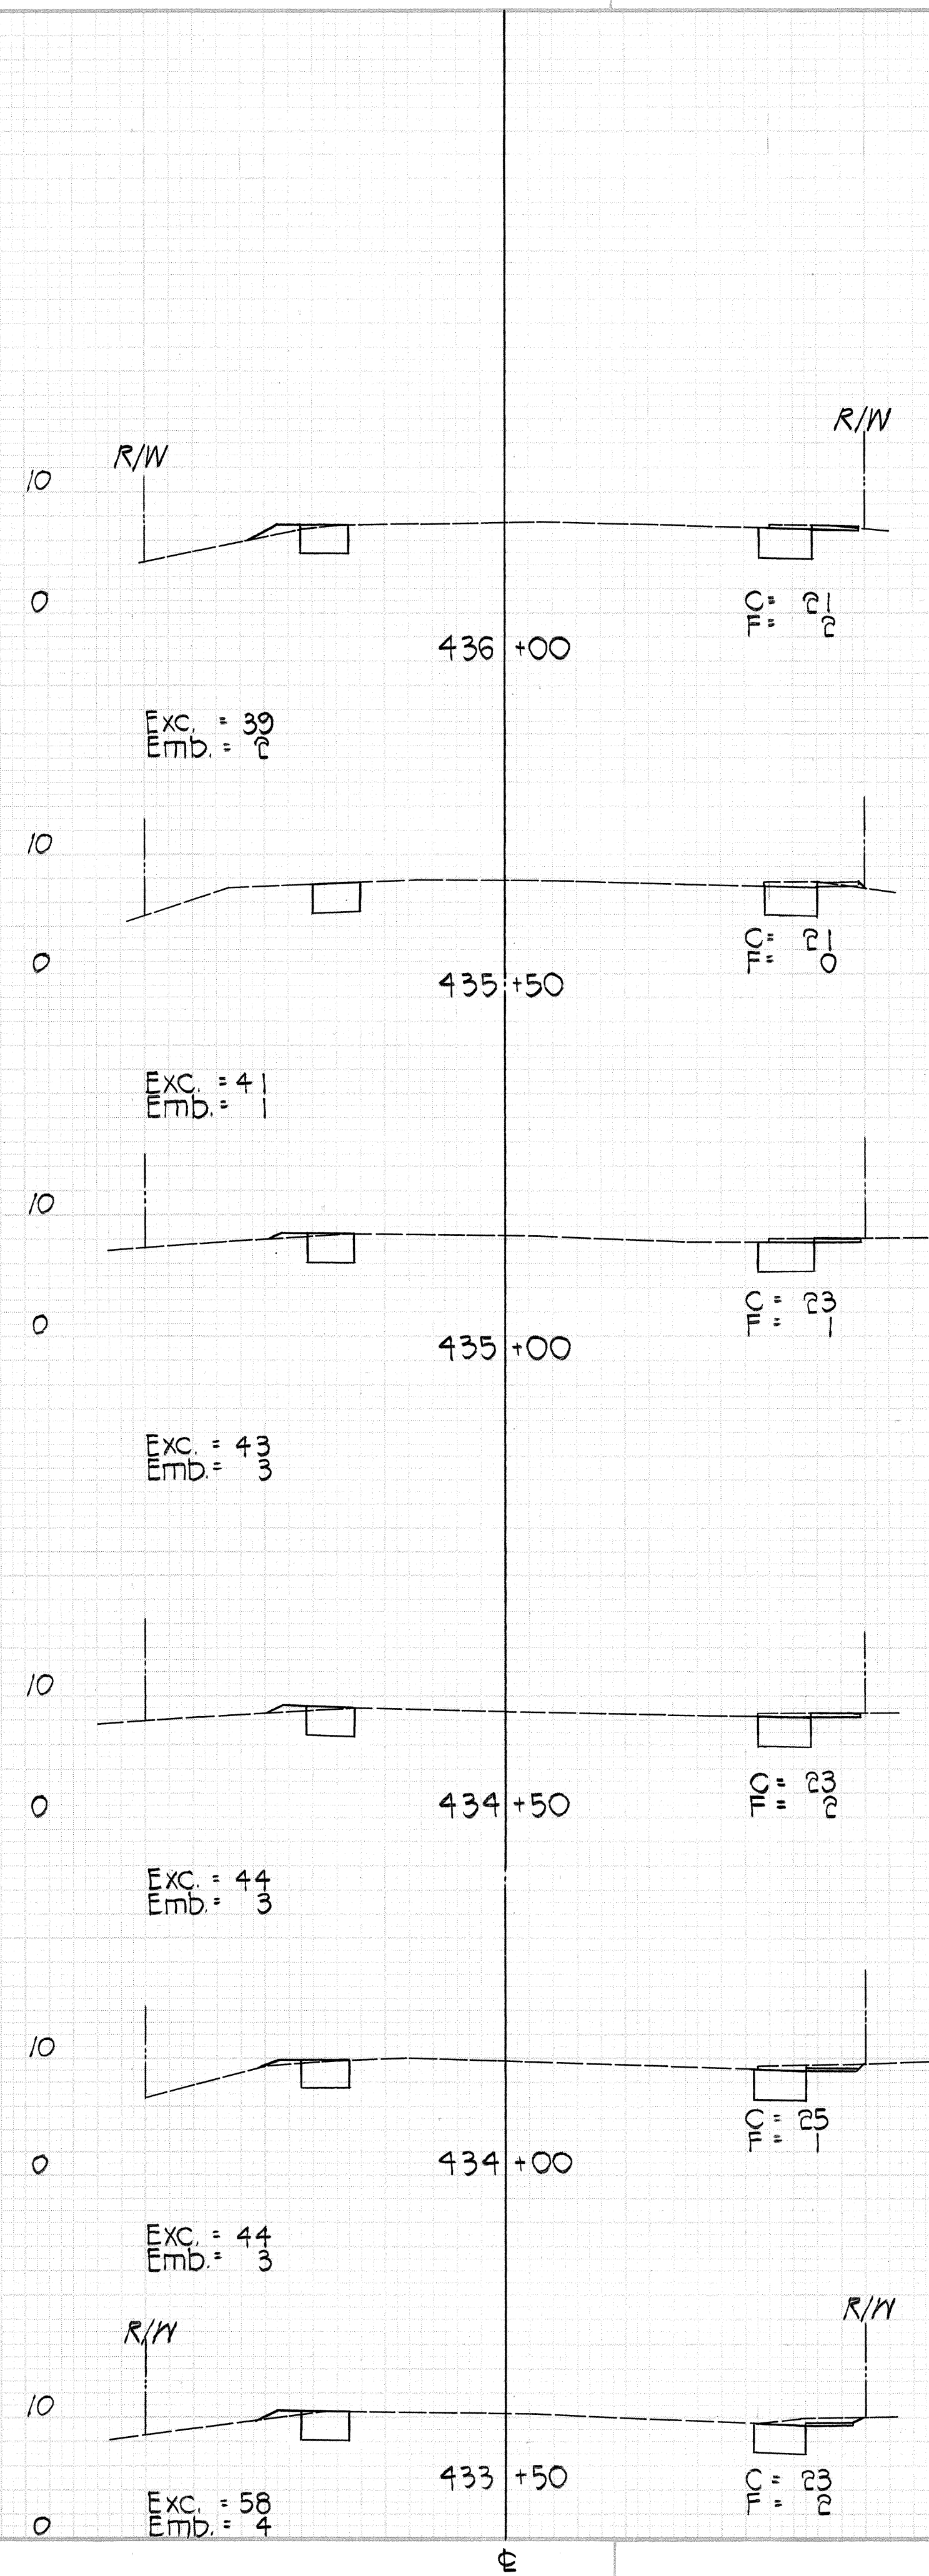


84732

DATE	BY	FINAL SURVEY	SURVEYED	PLOTTED	NOTE BOOK	AREAS CHECKED

DATE	BY	ORIGINAL SURVEY	SURVEYED	PLOTTED	NOTE BOOK	AREAS CHECKED

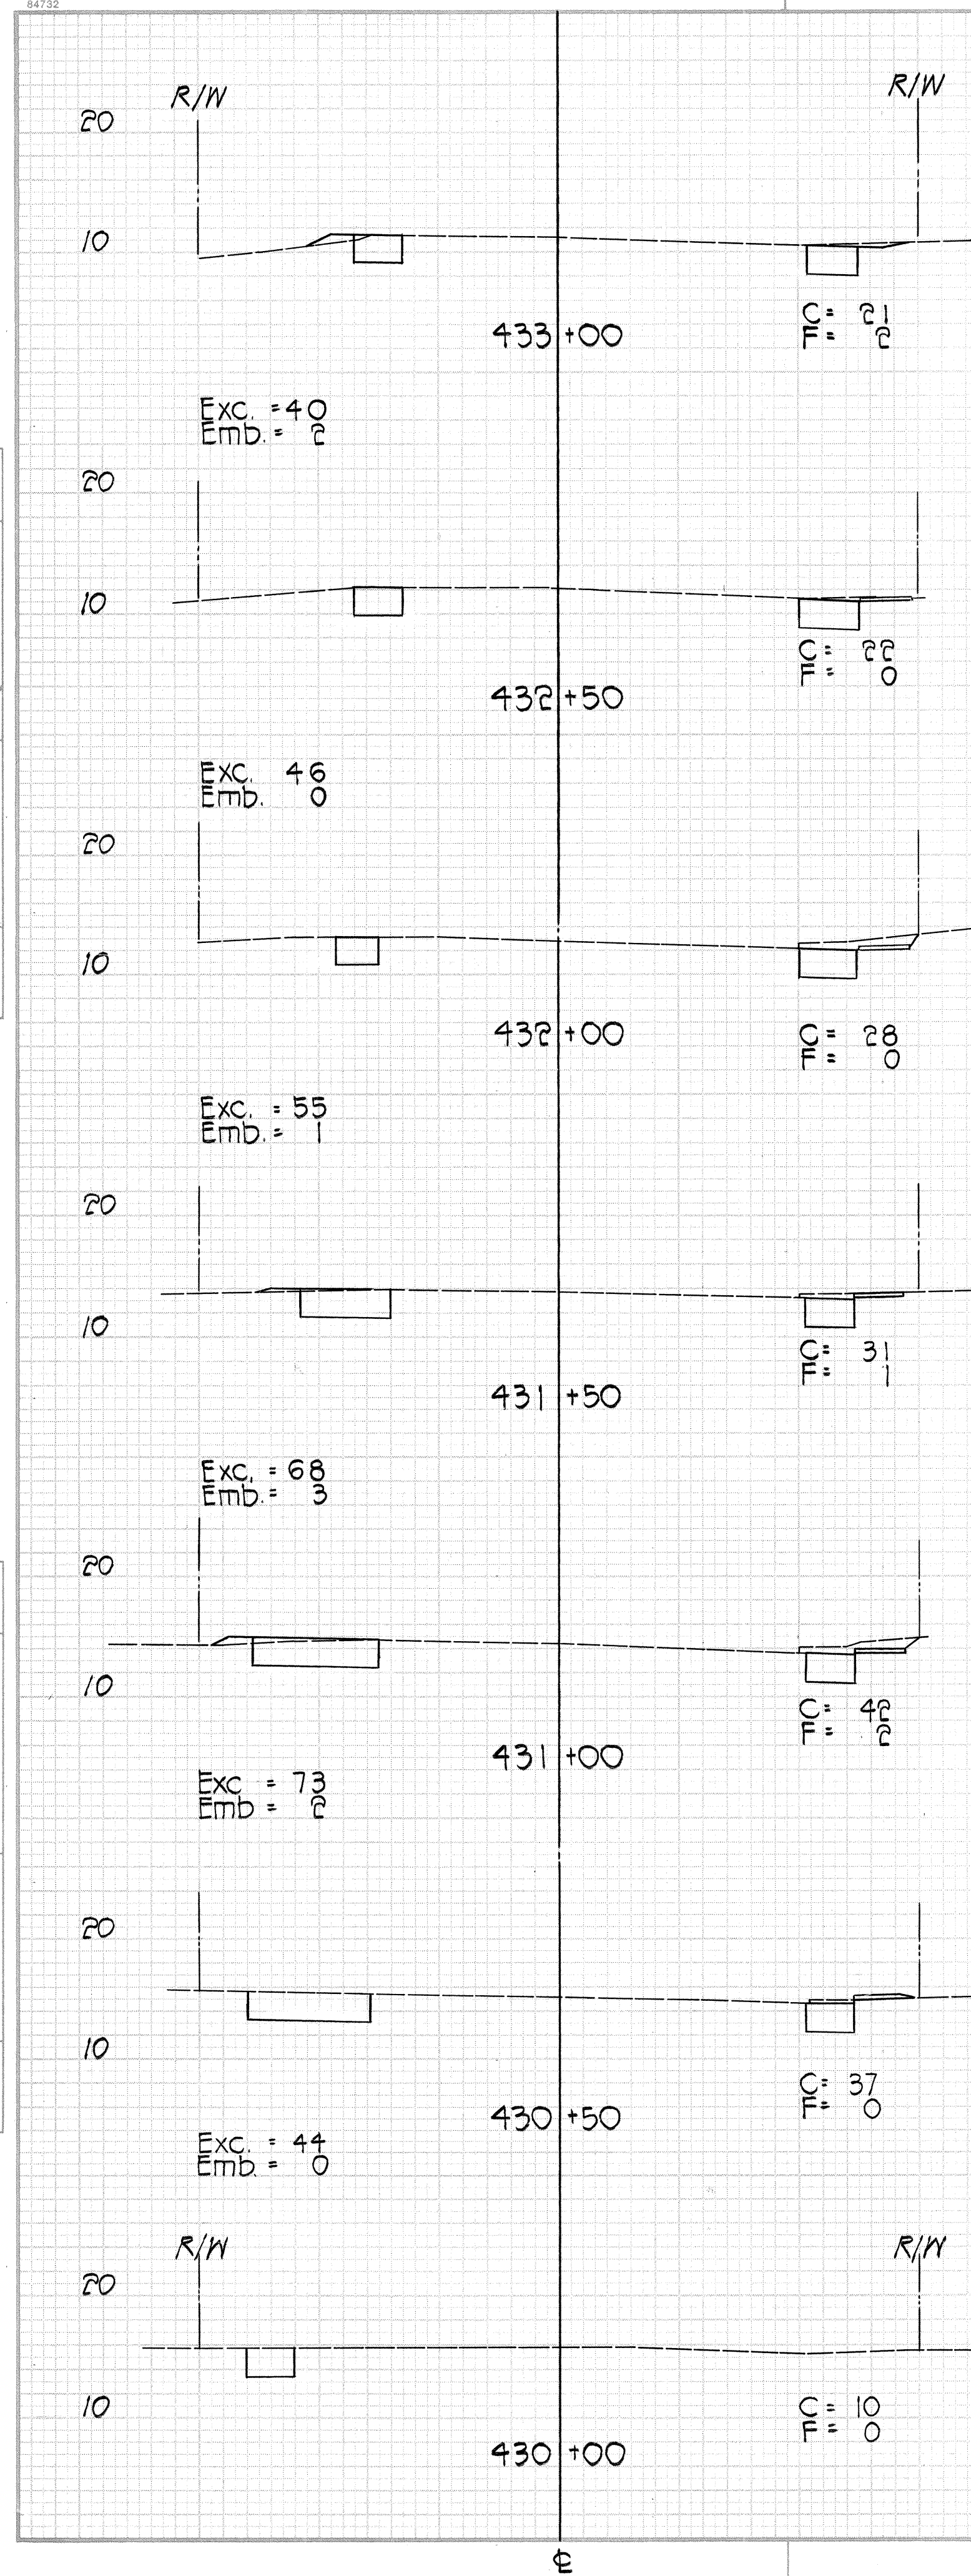


FED. ROAD DIST. NO.	STATE	PROJ. NO.	FISCAL YEAR	SHEET NO.	TOTAL SHEETS
HAWAII	HAW.	56A-01-92	1992	19	22

HAROLD I. YOSHIZAKI
REGISTERED PROFESSIONAL ENGINEER
No. 2091-C
HAWAII, U.S.A.

THIS WORK WAS PREPARED BY ME OR UNDER MY SUPERVISION.
Harold I. Yoshizaki
SHIMABUKURO, ENDO & YOSHIZAKI, INC.
1126 12th Avenue
Honolulu, Hawaii 96816

FED. ROAD DIST. NO.	STATE	PROJ. NO.	FISCAL YEAR	SHEET NO.	TOTAL SHEETS
HAWAII	HAW.	56A-01-92	1992	20	22

ORIGINAL SURVEY	SURVEYED	BY	DATE
	PLOTTED		
NOTE BOOK	TEMPLATE		
	AREAS		
NO	AREAS CHECKED		


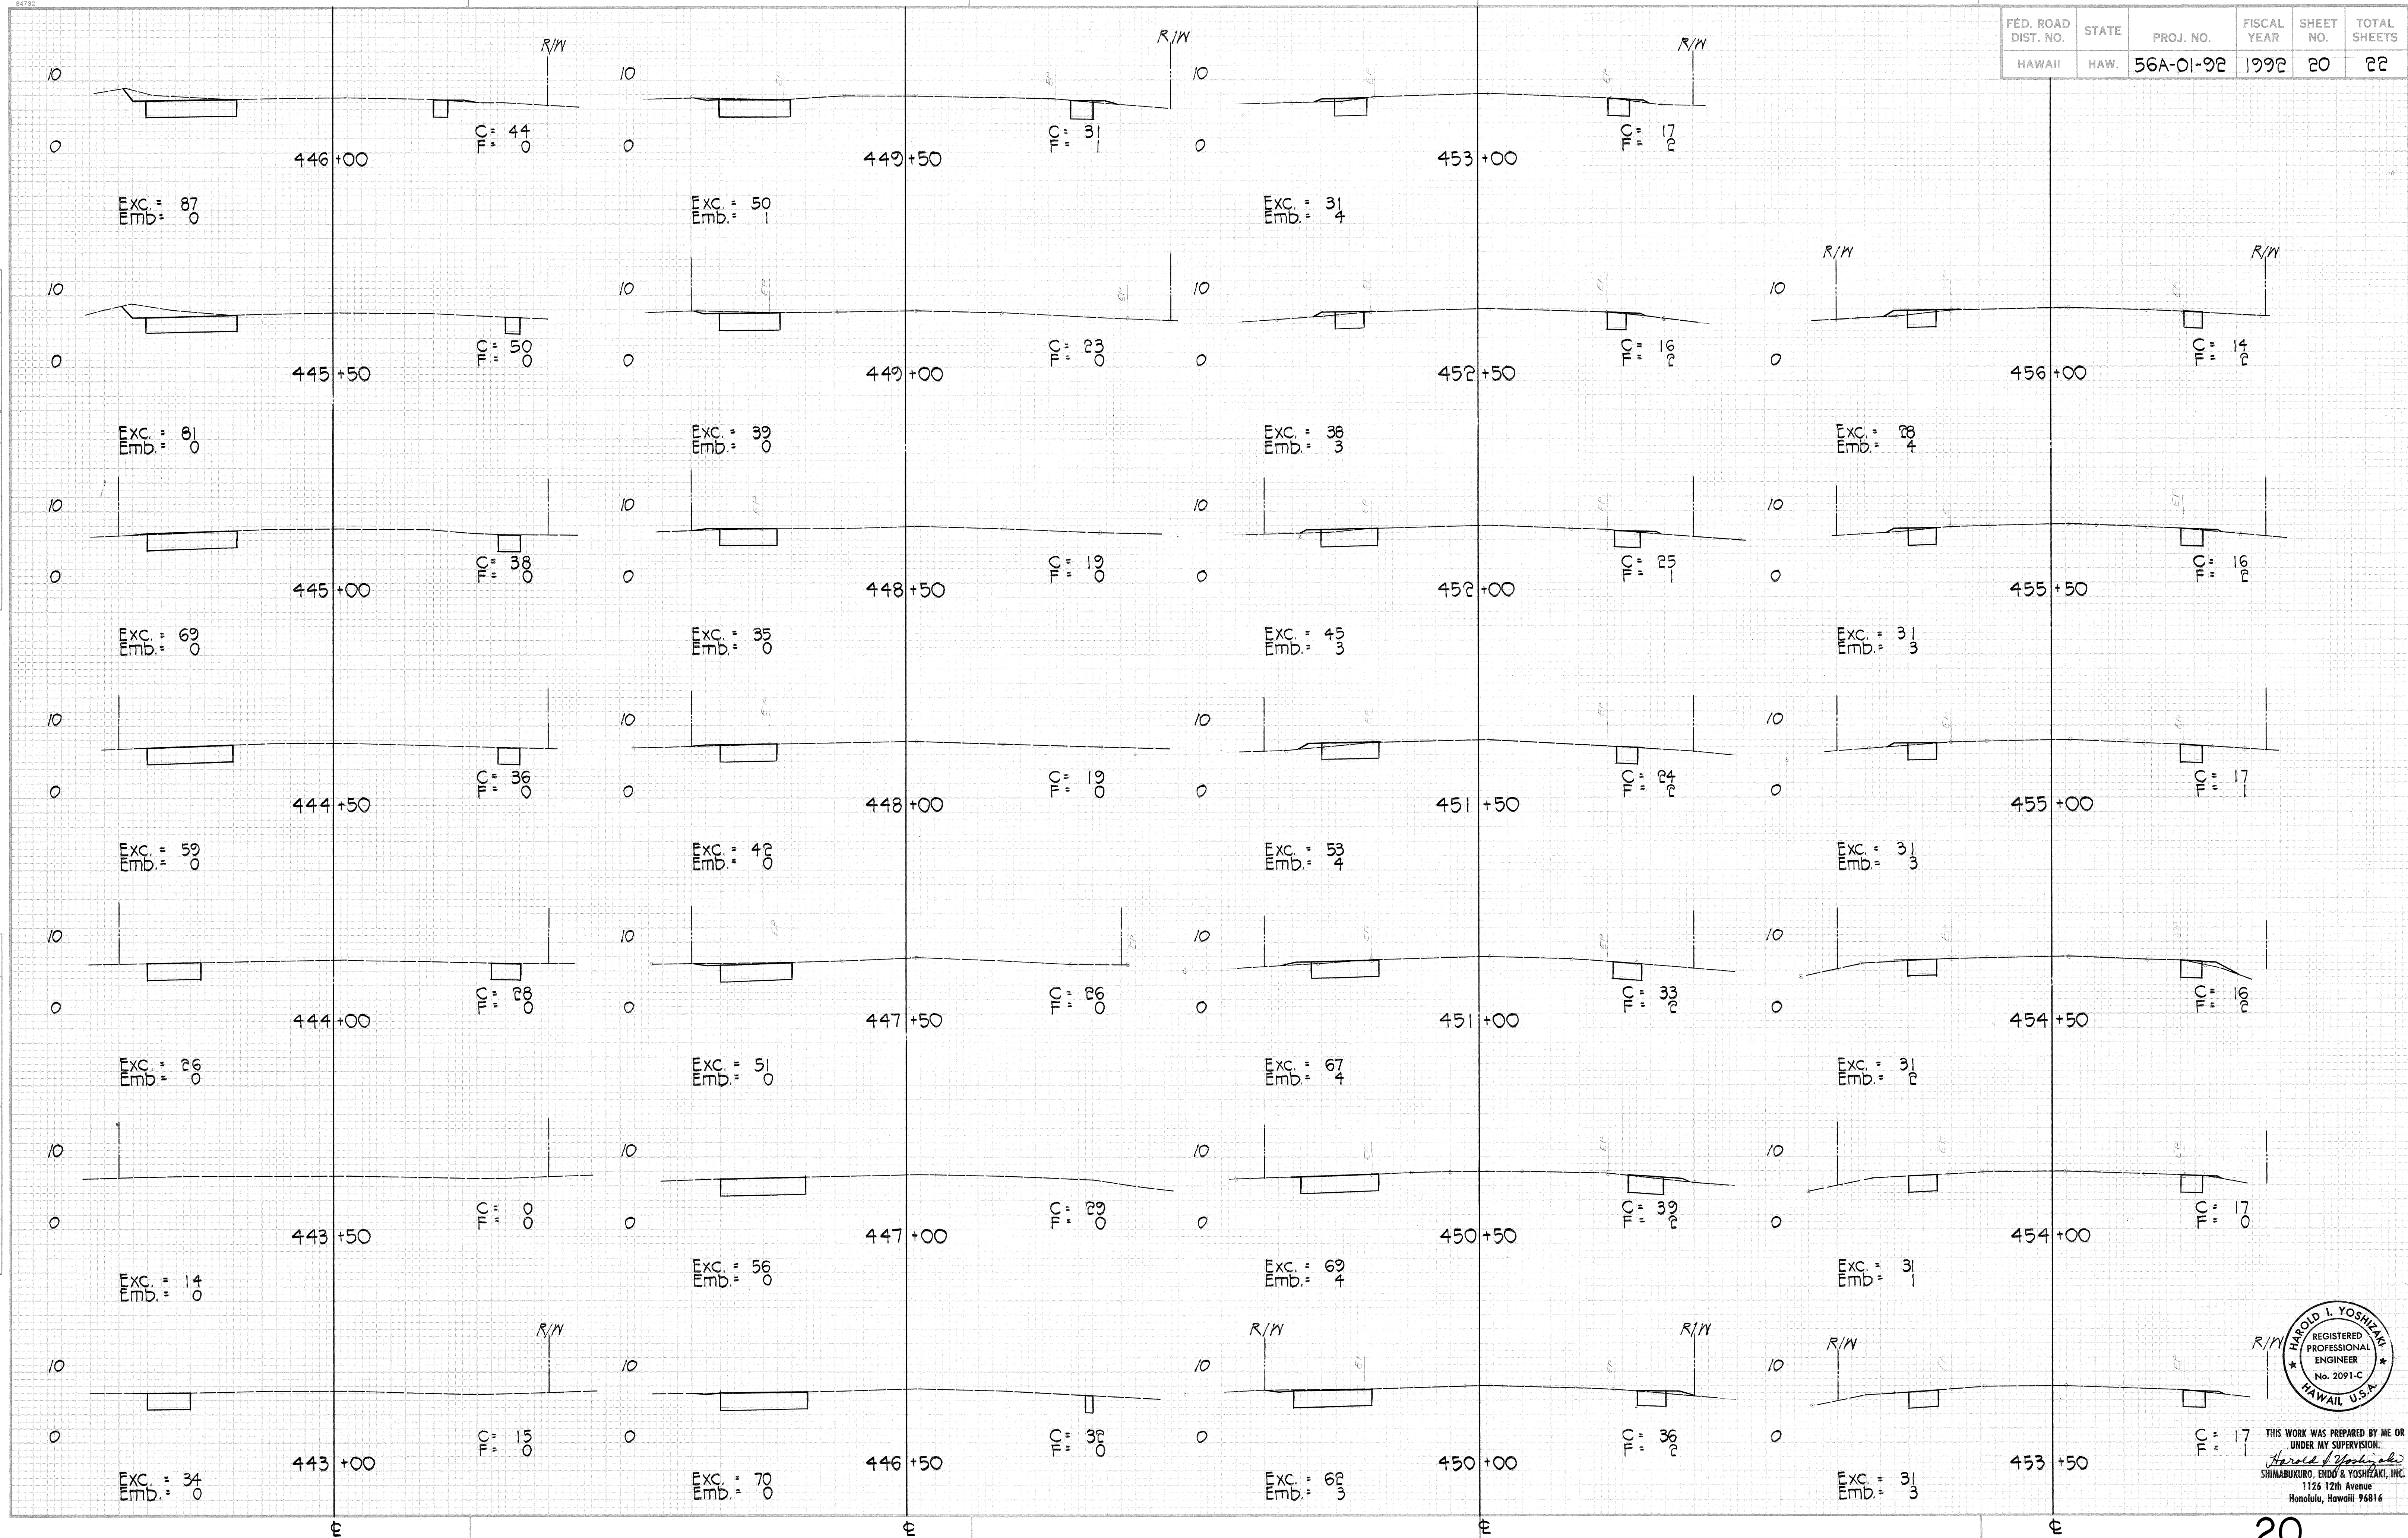


94732

FED. ROAD DIST. NO.	STATE	PROJ. NO.	FISCAL YEAR	SHEET NO.	TOTAL SHEETS
HAWAII	HAW.	56A-01-92	1992	21	22

FINAL SURVEY	DATE	BY
SURVEY		
PLOTTED		
TEMPLATE		
NO. AREAS CHECKED		

ORIGINAL SURVEY	DATE	BY
SURVEY		
PLOTTED		
TEMPLATE		
NO. AREAS CHECKED		

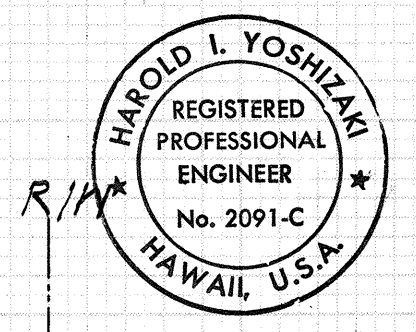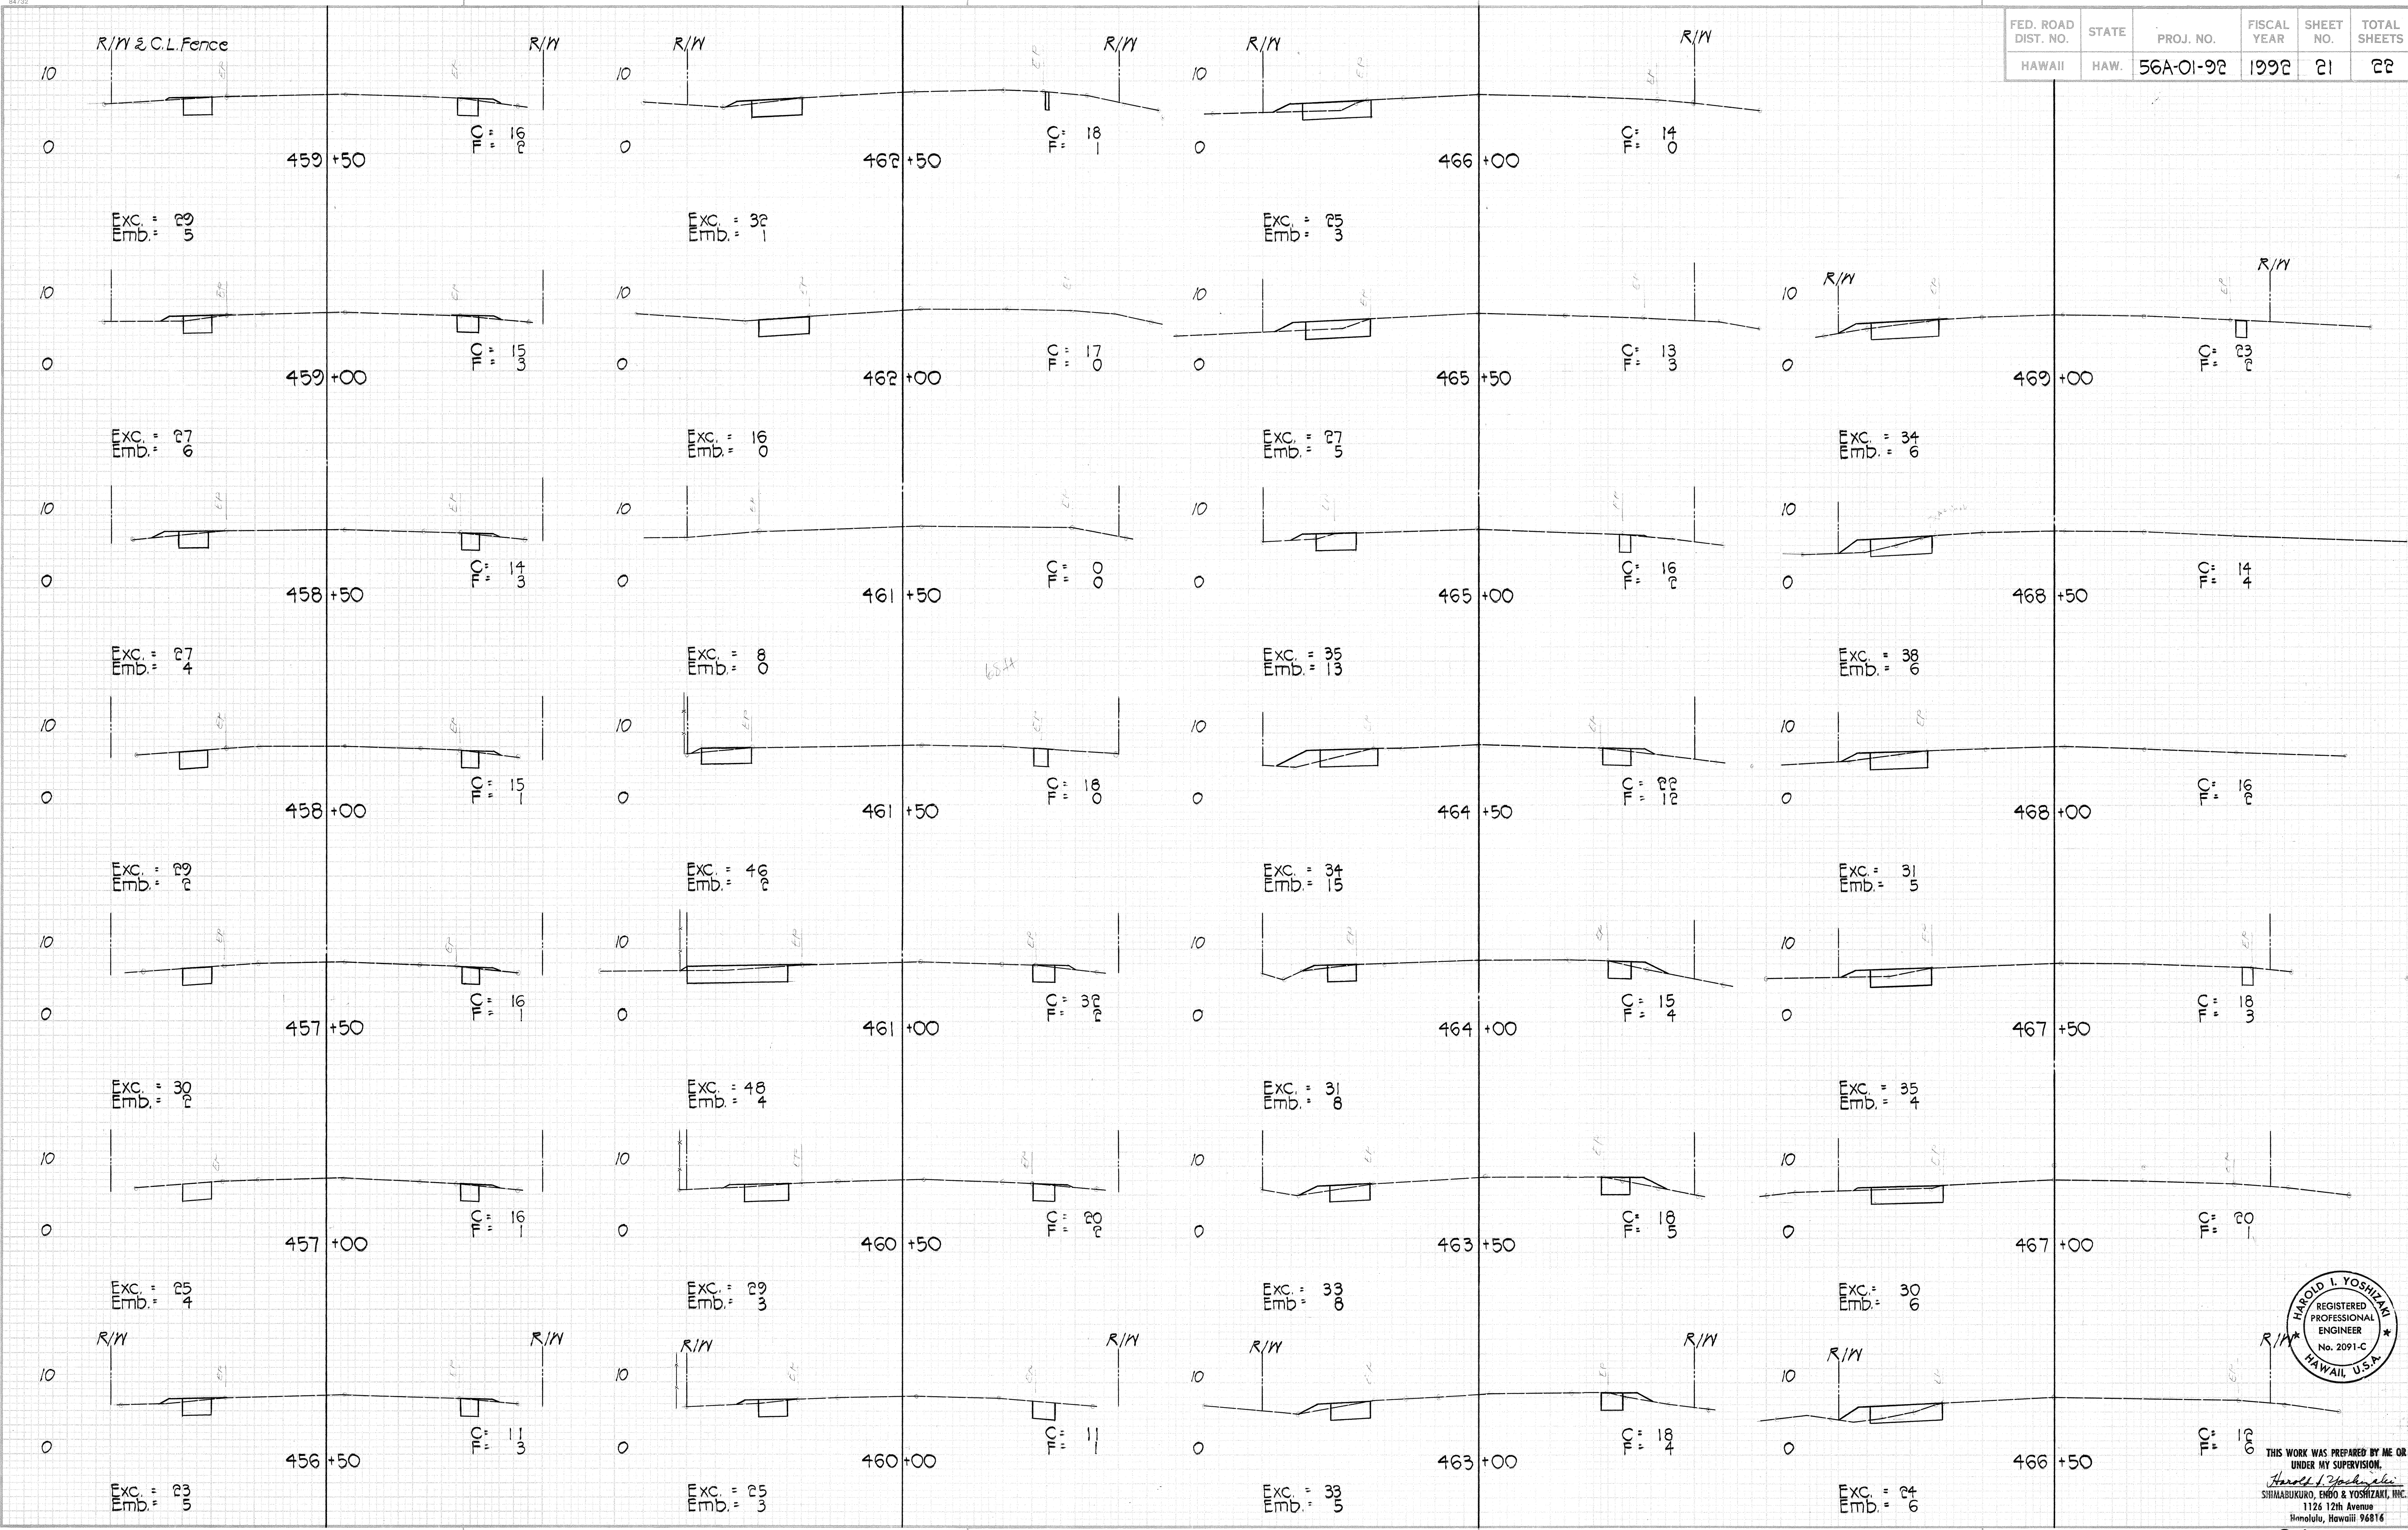

THIS WORK WAS PREPARED BY ME OR UNDER MY SUPERVISION.
Harold I. Yoshizaki
SHIMABUKURO, ENDO & YOSHIKAZU, INC.
1126 12th Avenue
Honolulu, Hawaii 96816

