



INDEX TO DRAWINGS	
SHEET NO.	DESCRIPTION
1	TITLE SHEET
2	STANDARD PLANS SUMMARY
3	NOTES
4-5	TYPICAL ROAD SECTIONS
6-8	PAVEMENT STRIPING/MARKING & SIGNING PLAN
9-10	TRAFFIC SIGNAL PLAN & DETAILS
11-12	UHELEKAWAWA BRIDGE SITE PLAN & MISCELLANEOUS DETAILS
13-18	UHELEKAWAWA BRIDGE - STRUCT- URAL & MISC. DETAILS
19-22	ROADWAY CROSS SECTIONS

STATE OF HAWAII  
DEPARTMENT OF TRANSPORTATION  
HIGHWAYS DIVISION  
HONOLULU, HAWAII  
"AS-BUILT"  
PLANS FOR

KUHIO HIGHWAY IMPROVEMENTS, LIHUE TO KEALIA  
HALEILIO ROAD TO UHELEKAWAWA BRIDGE  
PROJECT NO. 56A-01-92


DISTRICT OF KAWAIIHAU  
ISLAND OF KAUAI

FED. ROAD DIST. NO.	STATE	PROJ. NO.	FISCAL YEAR	SHEET NO.	TOTAL SHEETS
HAWAII	HAW.	56A-01-92	1992	1	22

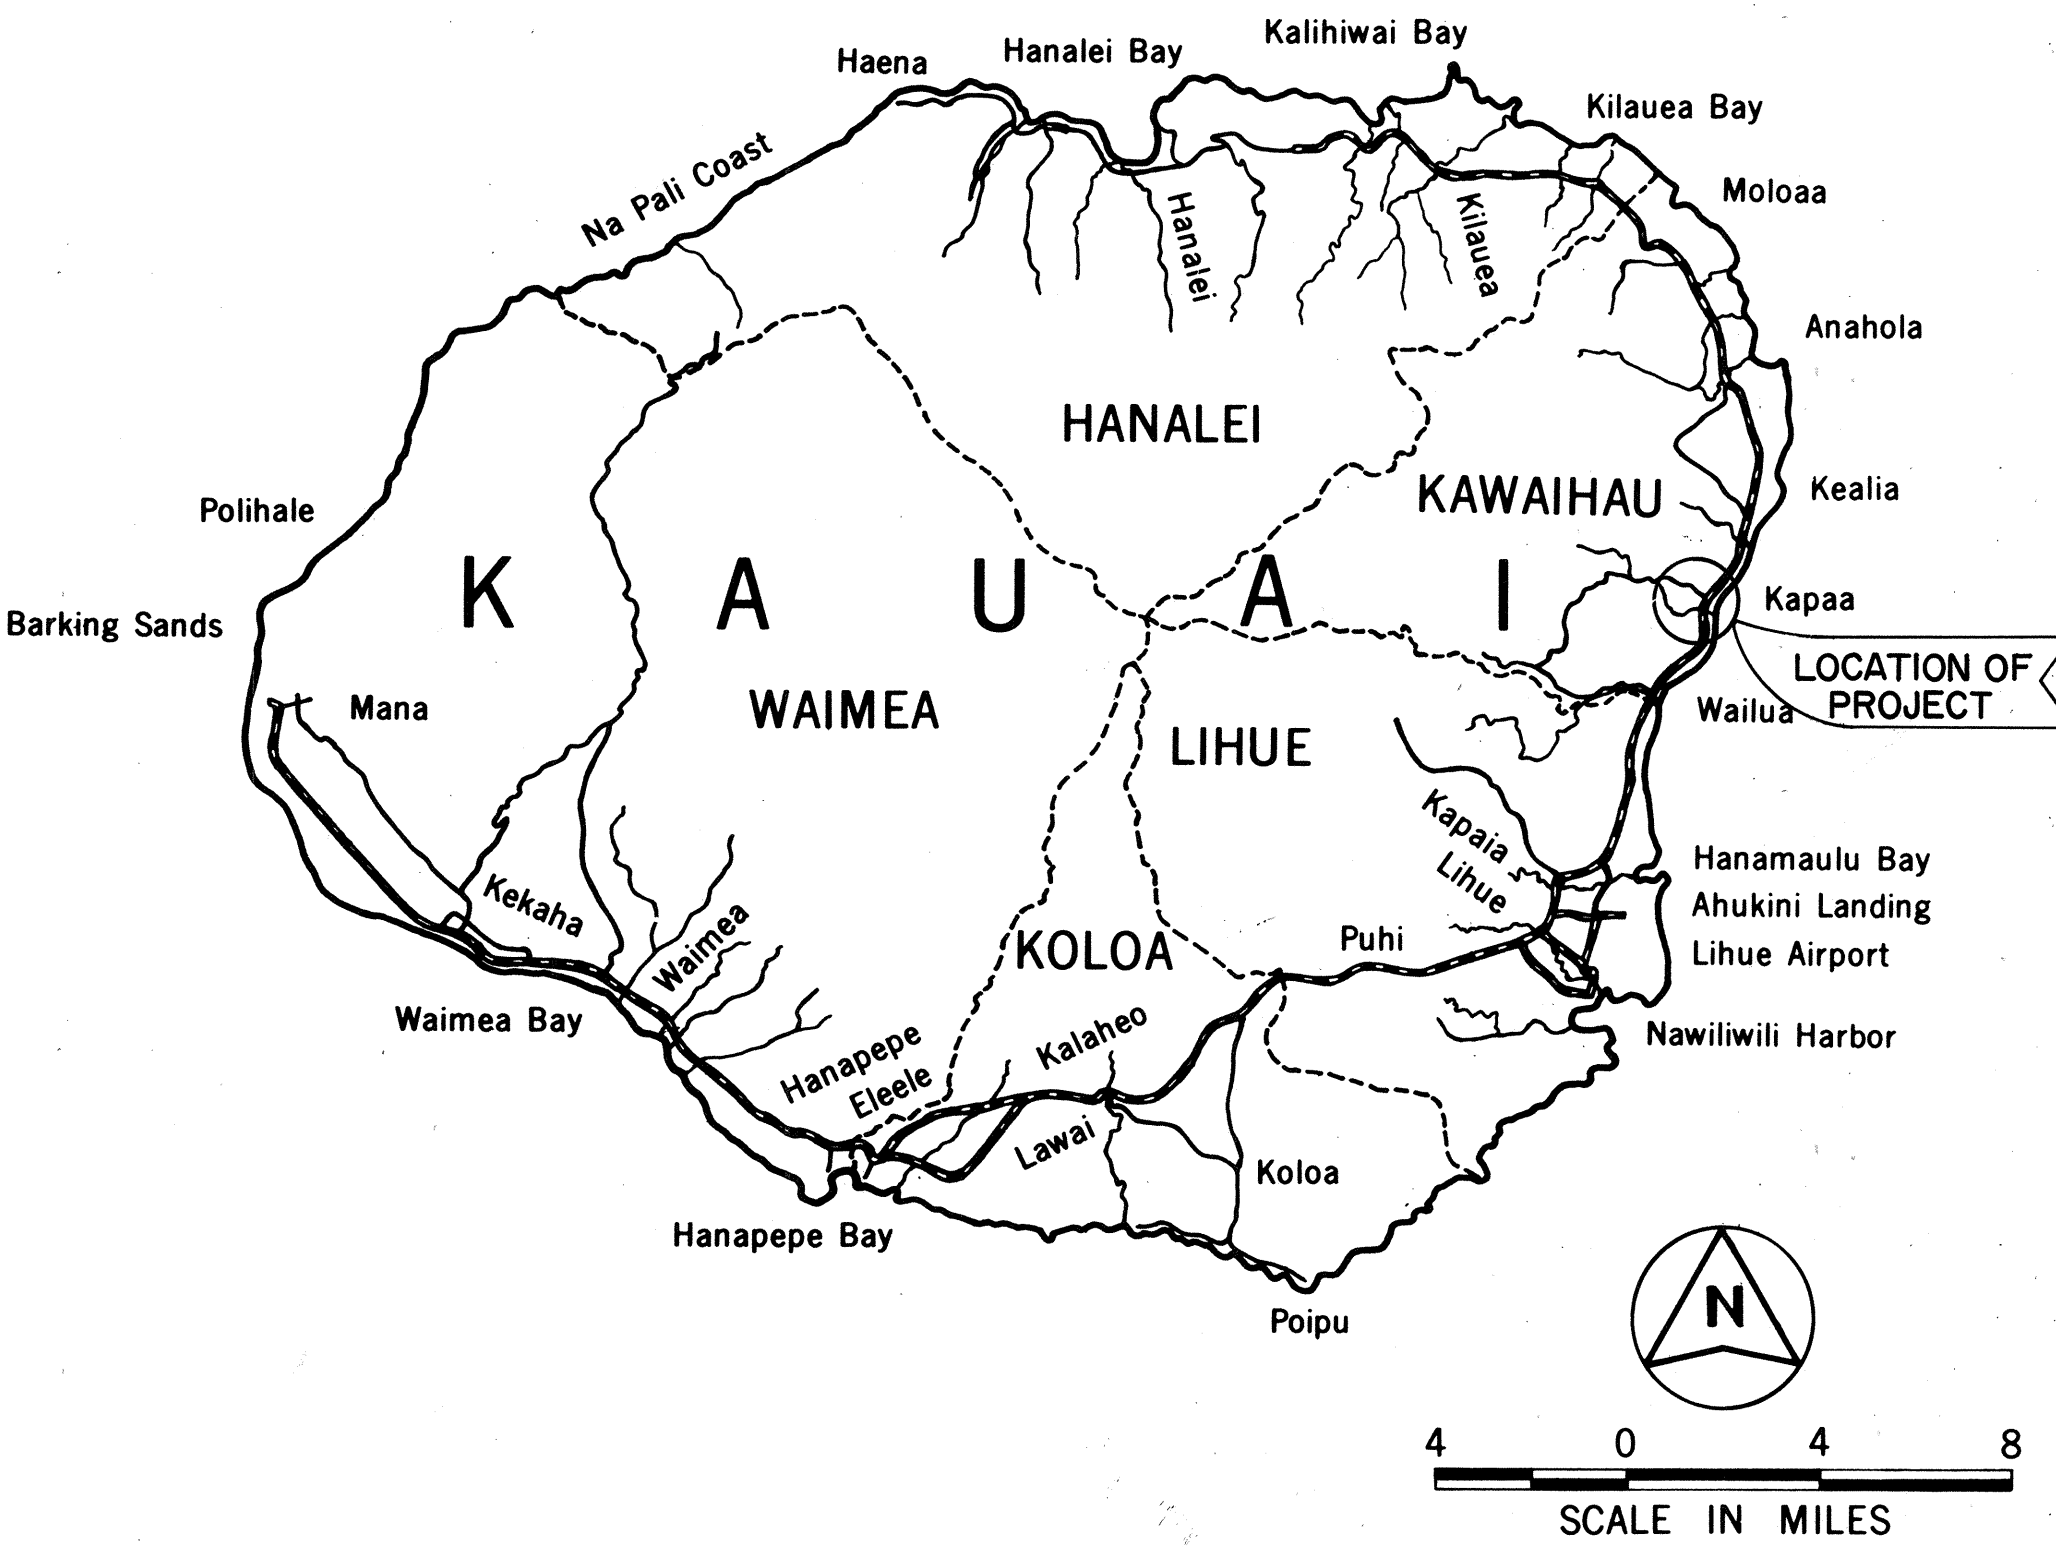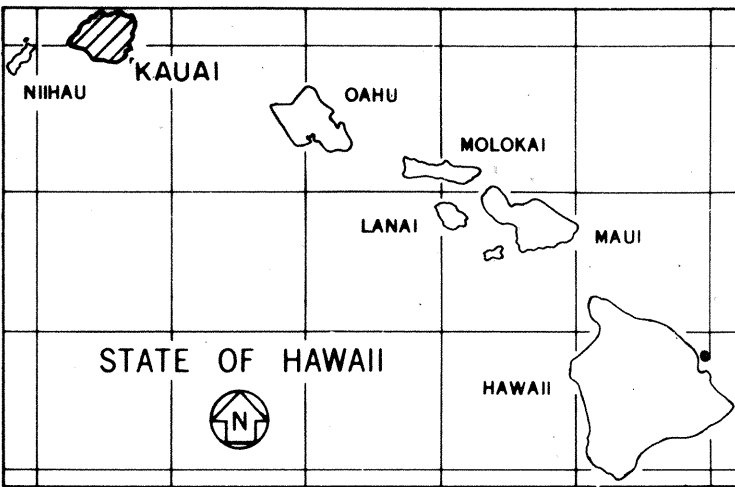


FEDERAL AID PROJECTS PREVIOUSLY CONSTRUCTED  
OR UNDER CONSTRUCTION  
MILE POST 6.37 TO MILE POST 7.39

CHANGES MADE DURING CONSTRUCTION HAVE  
BEEN INCORPORATED ON THES PLANS IN RED.  
*Resident Engineer Signature* 6/13/96  
RESIDENT ENGINEER DATE

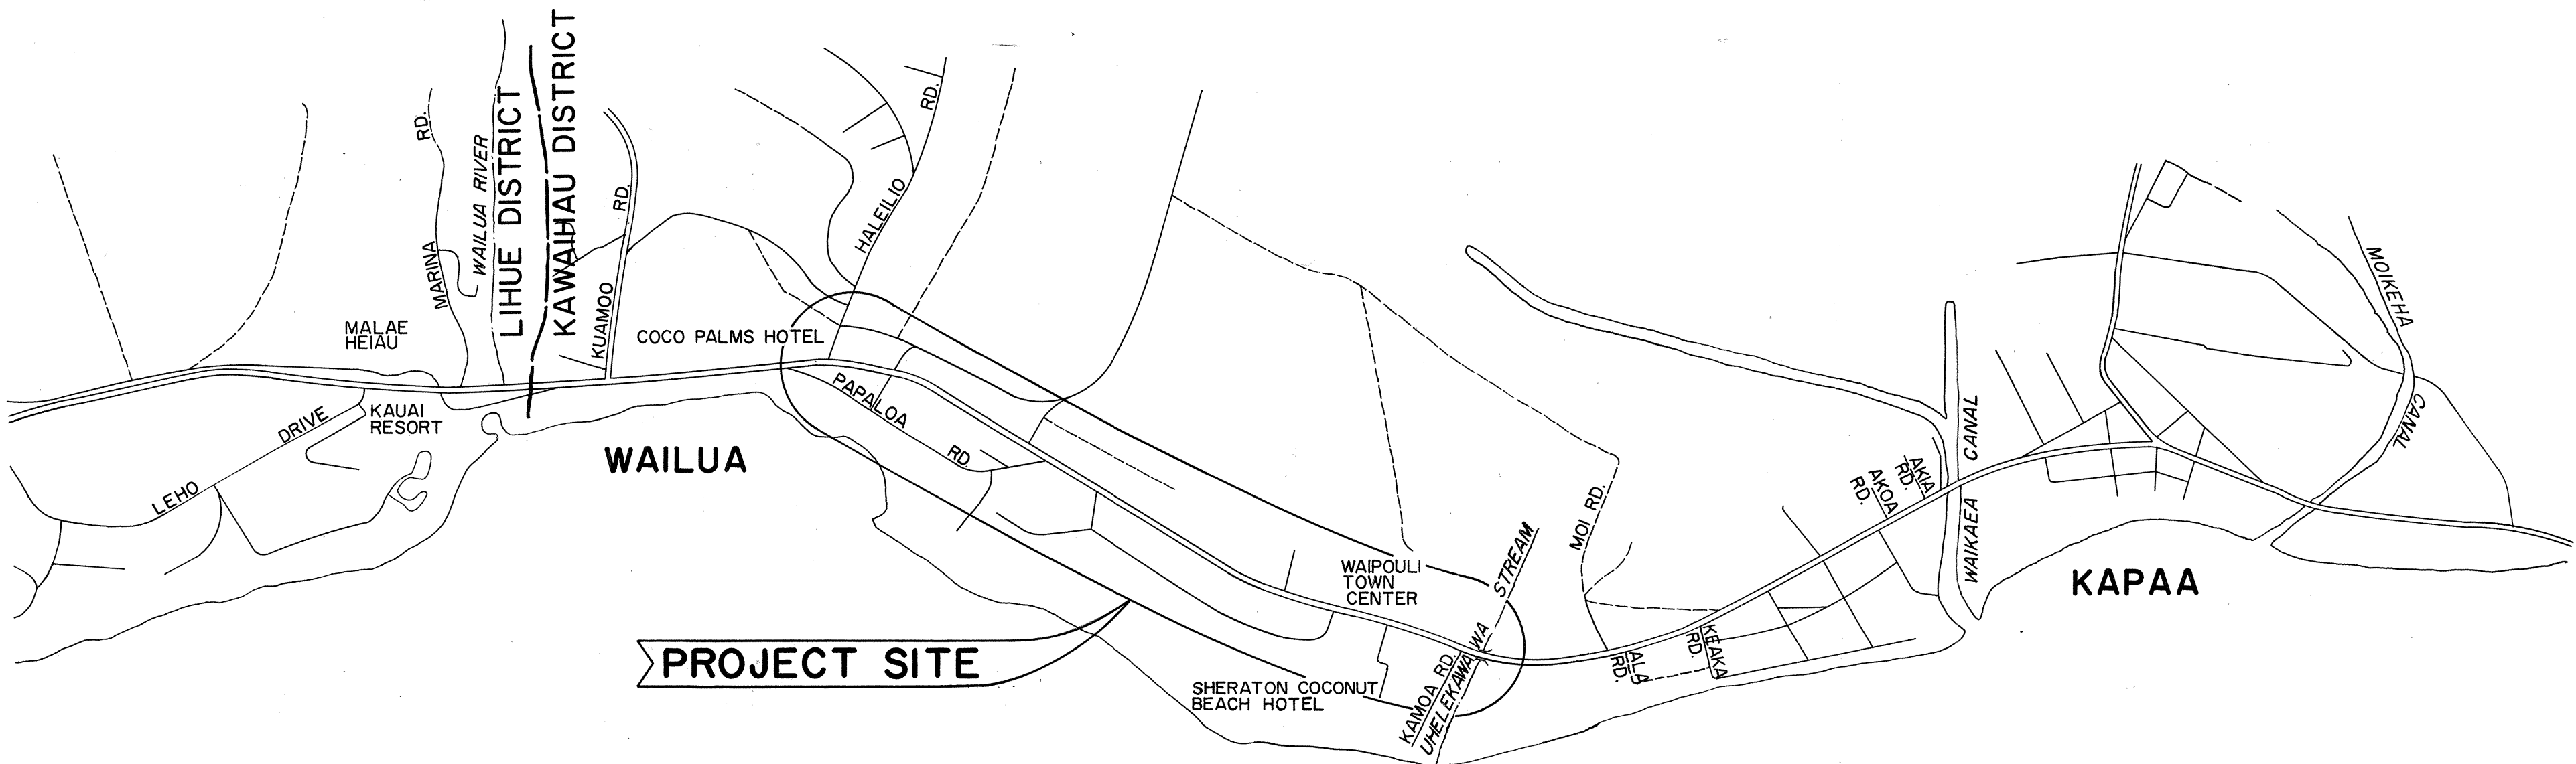

LAYOUT PLAN  
TMK: 4-3-01,02,05,06 & 07

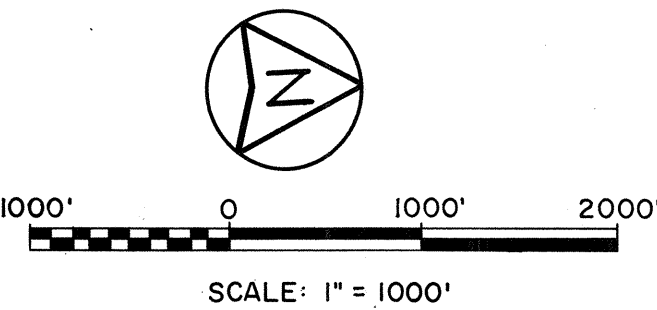

DEPARTMENT OF TRANSPORTATION STATE OF HAWAII	
APPROVED:	DATE
<i>Signature</i>	5/12/92
FOR DIR. OF TRANSPORTATION	DATE

"AS-BUILT"