



FED. ROAD DIST. NO.	STATE	PROJ. NO.	FISCAL YEAR	SHEET NO.	TOTAL SHEETS
HAWAII	HAW.	STP-056-1(057)	2015	17	24

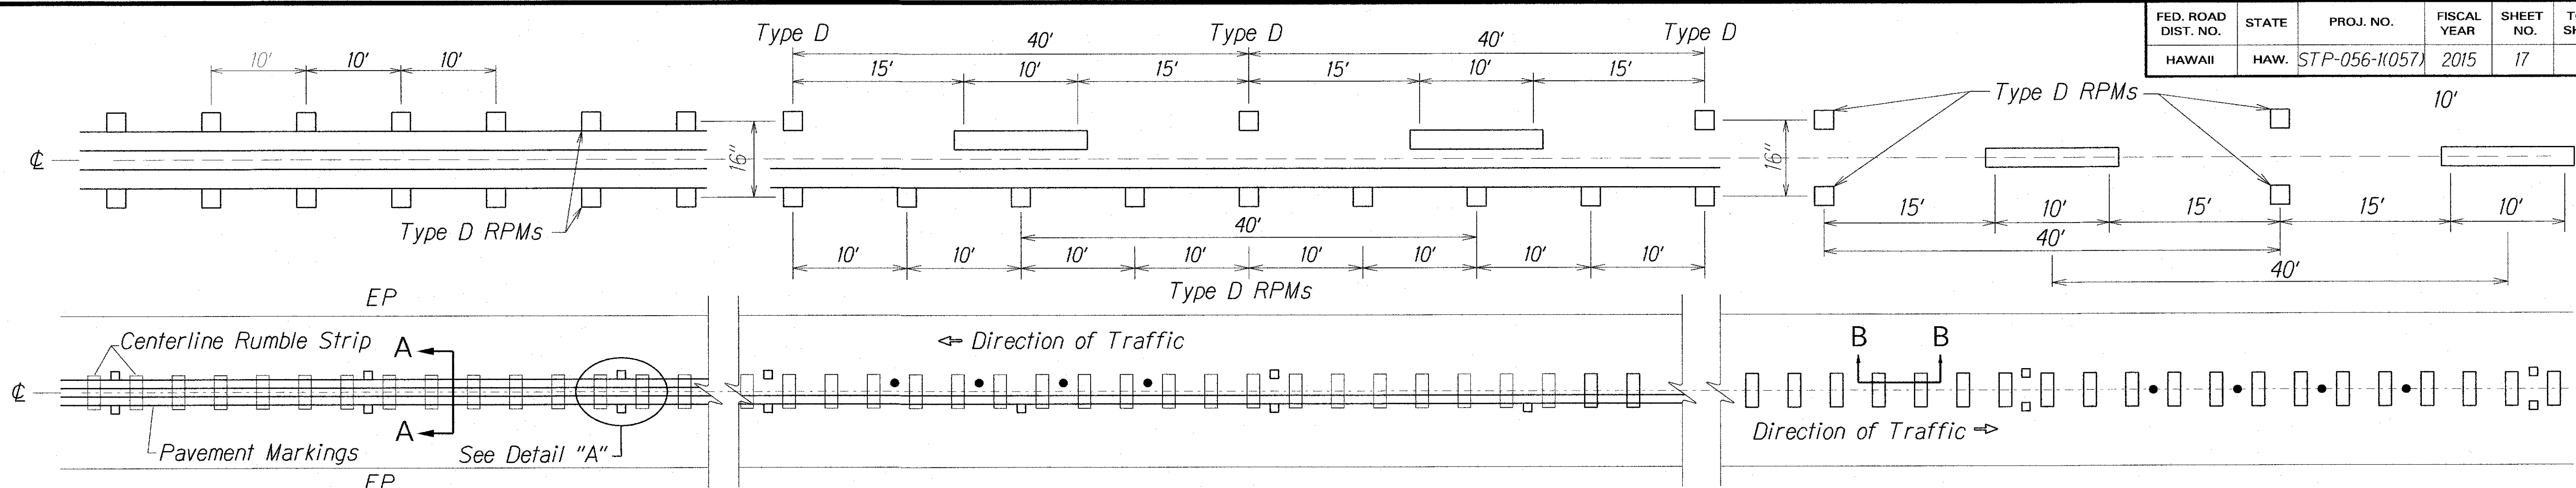


PLAN - CENTERLINE MILLED RUMBLE STRIP
Not to Scale

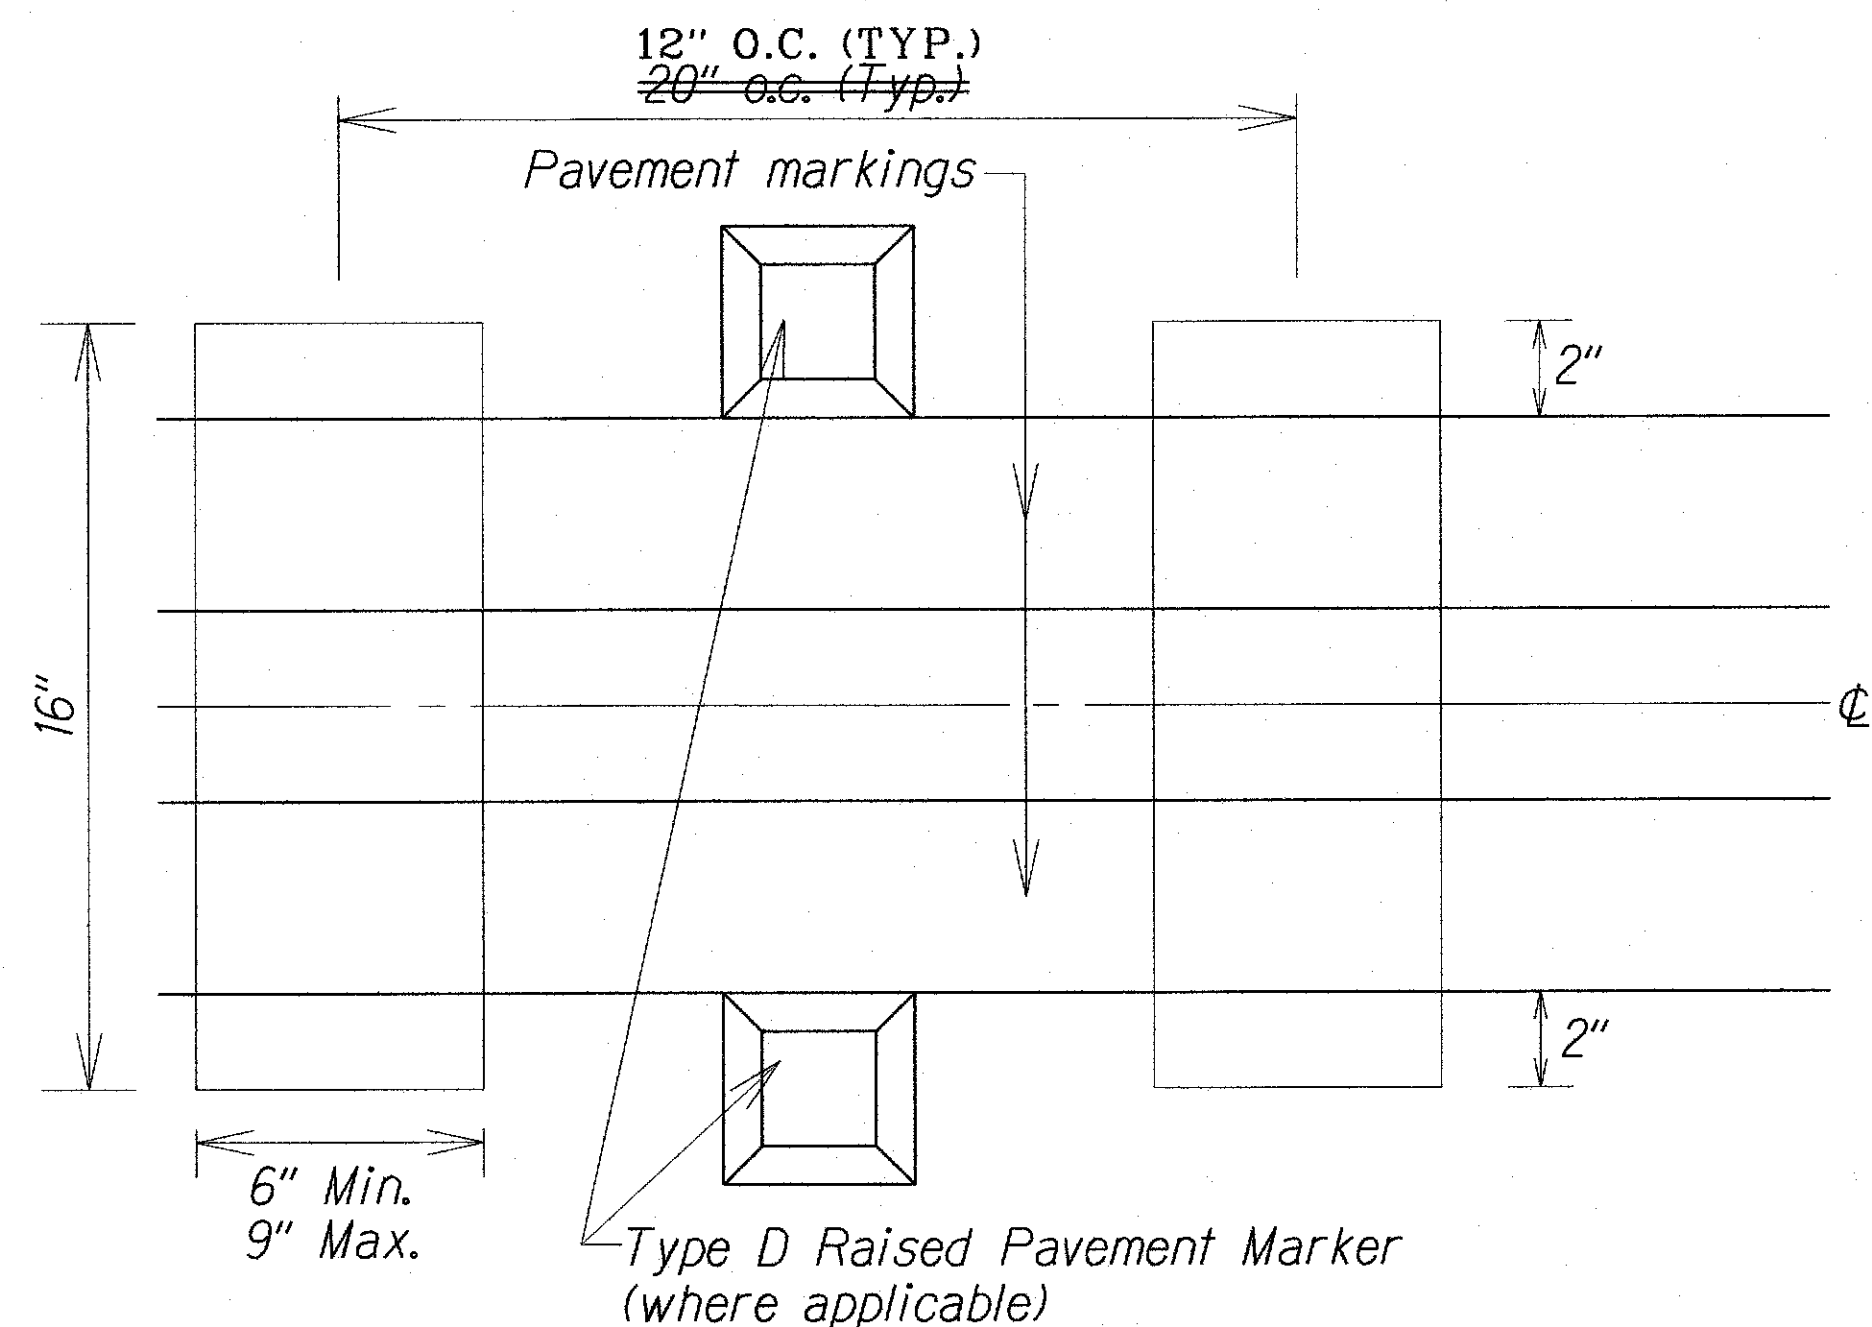


DETAIL "A"
Not to Scale

NOTES:

- The method of constructing the centerline milled rumble strip shall be submitted to the Engineer for acceptance prior to the actual work.
- Dimensions shown are approximate. Adjust rumble strip spacing to coordinate with pavement markings prior to installation.
- Raised pavement markers shall be installed on level surface between the rumble strips. Do not install raised pavement markers inside the milled area.
- The construction of the centerline milled rumble strip shall be paid for under Item No. 615.0100 - 16-Inch Milled Rumble Strip, Centerline.
- The milling apparatus and removal of existing pavement markings will not be paid for separately and shall be considered incidental to Item 615.0100 - 16-Inch Milled Rumble Strip, Centerline.
- Do not install centerline rumble strips on bridge decks.
- Where at-grade bridges are present, rumble strips shall end/begin 20 L.F. beyond the existing bridge deck joints/concrete approach slab.
- Hot spray thermoplastic shall be used for solid line markings within the milled centerline rumble strip area.
- Seal entire surface of Milled Rumble Strips by applying/coating emulsified asphalt. This scope of work shall be incidental to Item No. 615.0100 - 16-Inch Milled Rumble Strip.

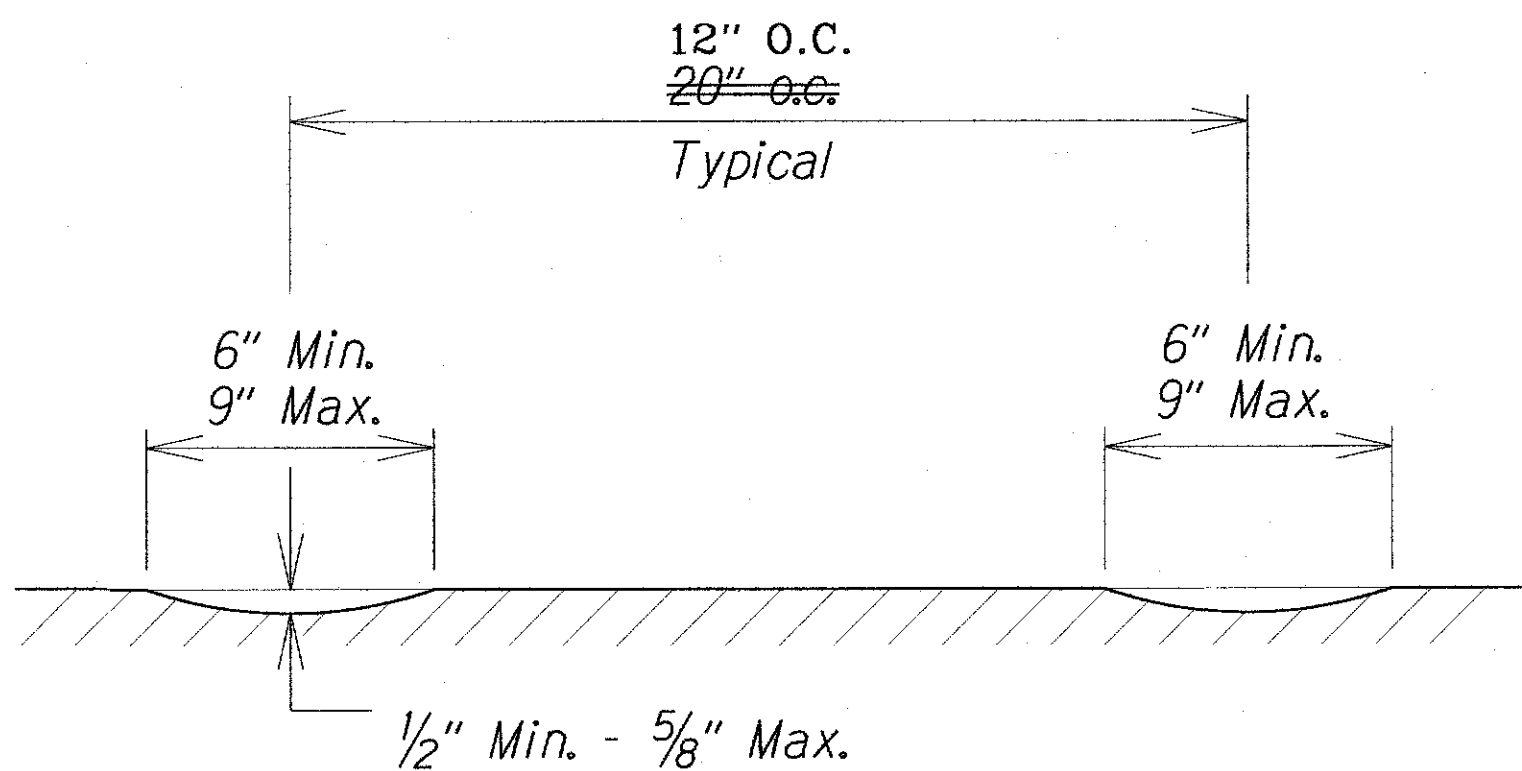


SECTION B-B - CENTERLINE MILLED RUMBLE STRIP
Not to Scale

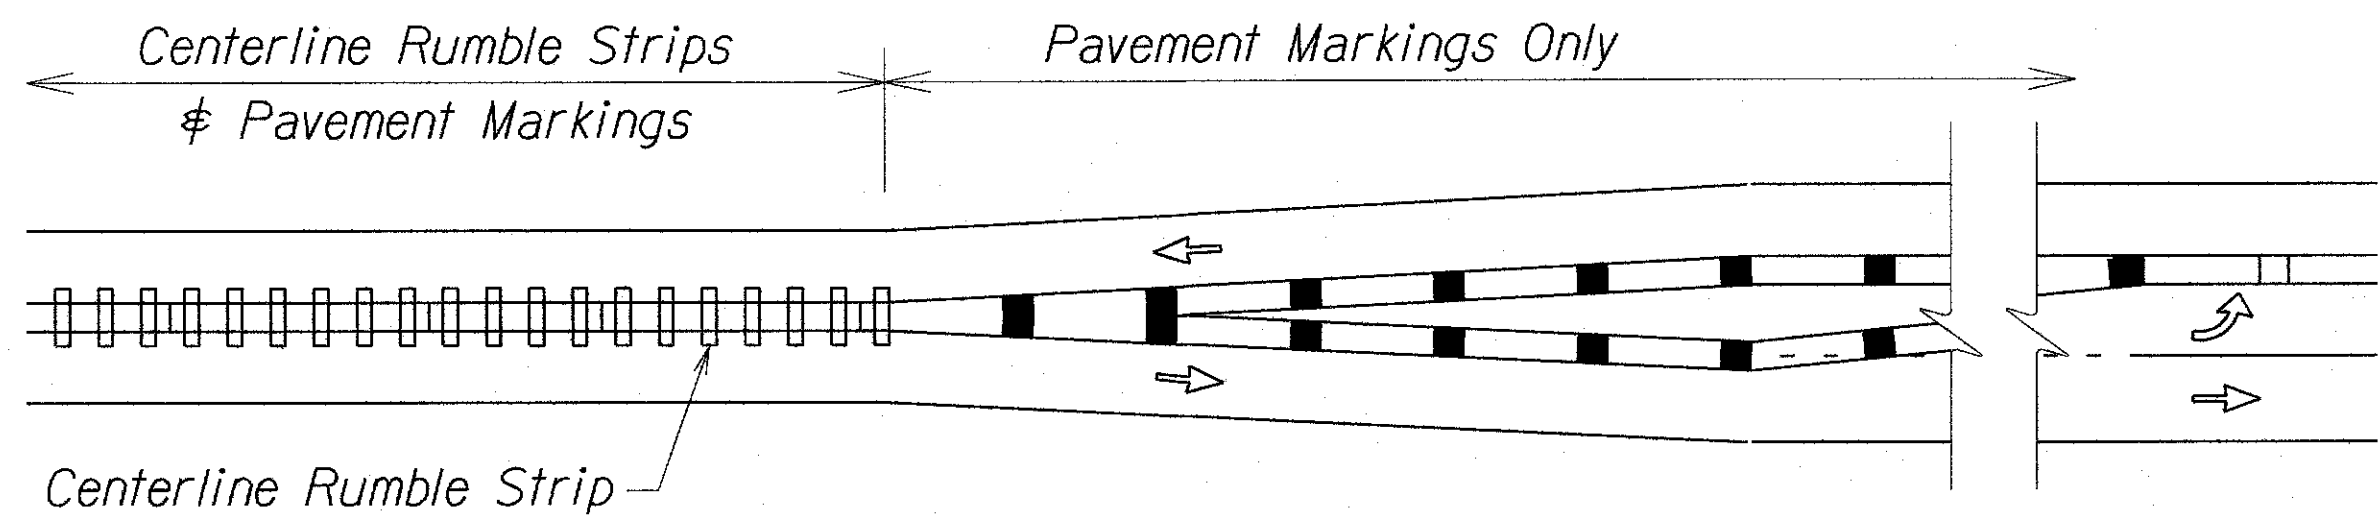


CENTERLINE MILLED RUMBLE STRIP INSTALLATION LIMIT
Not to Scale

LEGEND FOR AS-BUILT POSTINGS	
	Squiggly line for as-built deletion
	Double line for as-built deletion
	Text for as-built posting

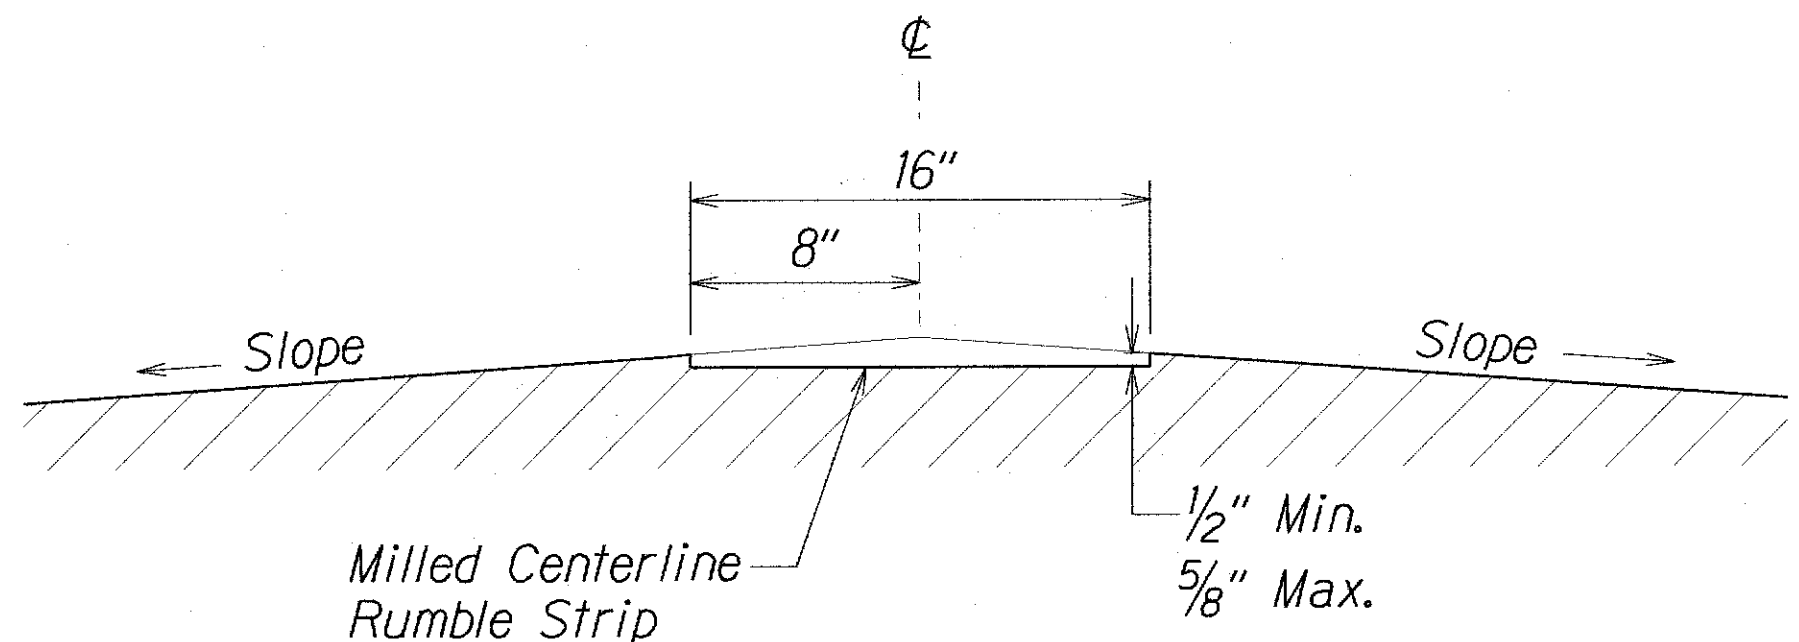

SECTION A-A - CENTERLINE MILLED RUMBLE STRIP
Not to Scale

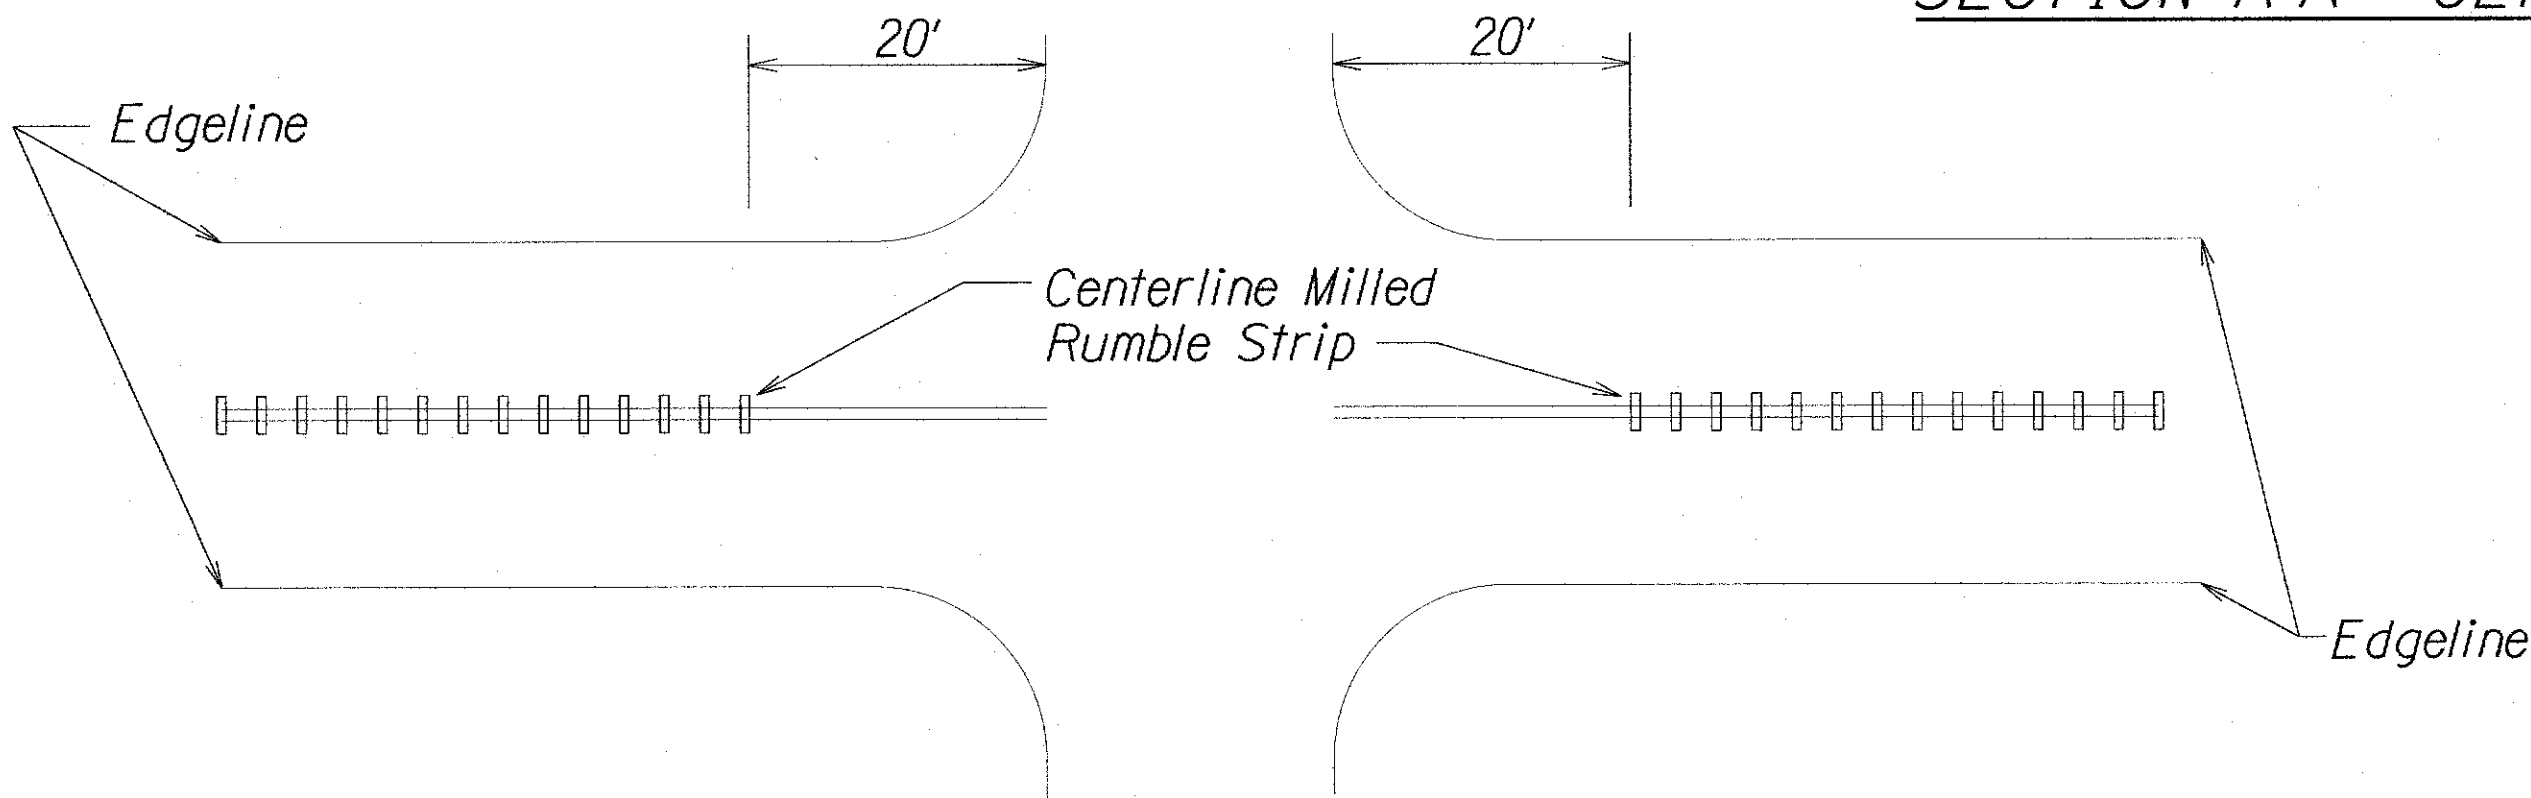

MILLED RUMBLE STRIP INSTALLATION LIMITS
Not to Scale

STATE OF HAWAII DEPARTMENT OF TRANSPORTATION HIGHWAYS DIVISION	
CENTERLINE MILLED RUMBLE STRIP DETAIL	
KUHIO HIGHWAY RESURFACING	
Vic. of South Koolau Road to Kapuna Road	
Mile Post 16.88 to Mile Post 18.95	
Federal-Aid Project No. STP-056-1(057)	
Scale: As Shown	Date: Oct. 2014
SHEET No. T2 OF 8 SHEETS	