



FED. ROAD DIST. NO.	STATE	FED-AID PROJ. NO.	FISCAL YEAR	SHEET NO.	TOTAL SHEETS
HAWAII	HAW.	STP-056-1(057)	2015	10	24

BEGIN PROJECT
FAP No. STP-056-1(057)
@ Sta. 64+58.25±

TRUE NORTH
SCALE: 1" = 40'

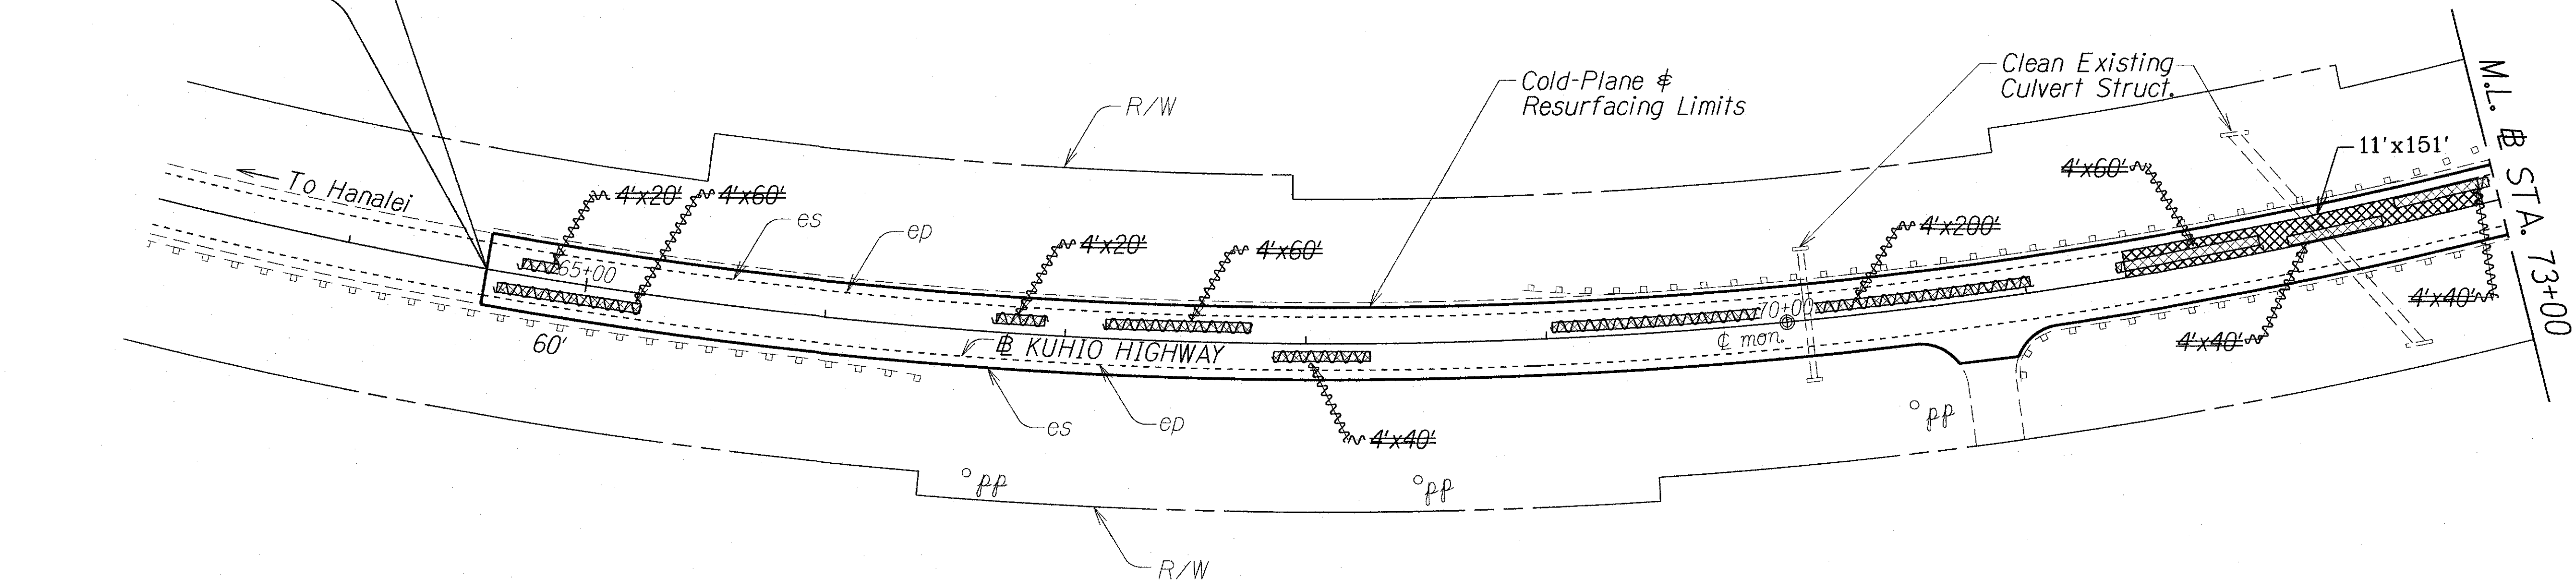

TRUE NORTH
SCALE: 1" = 40'

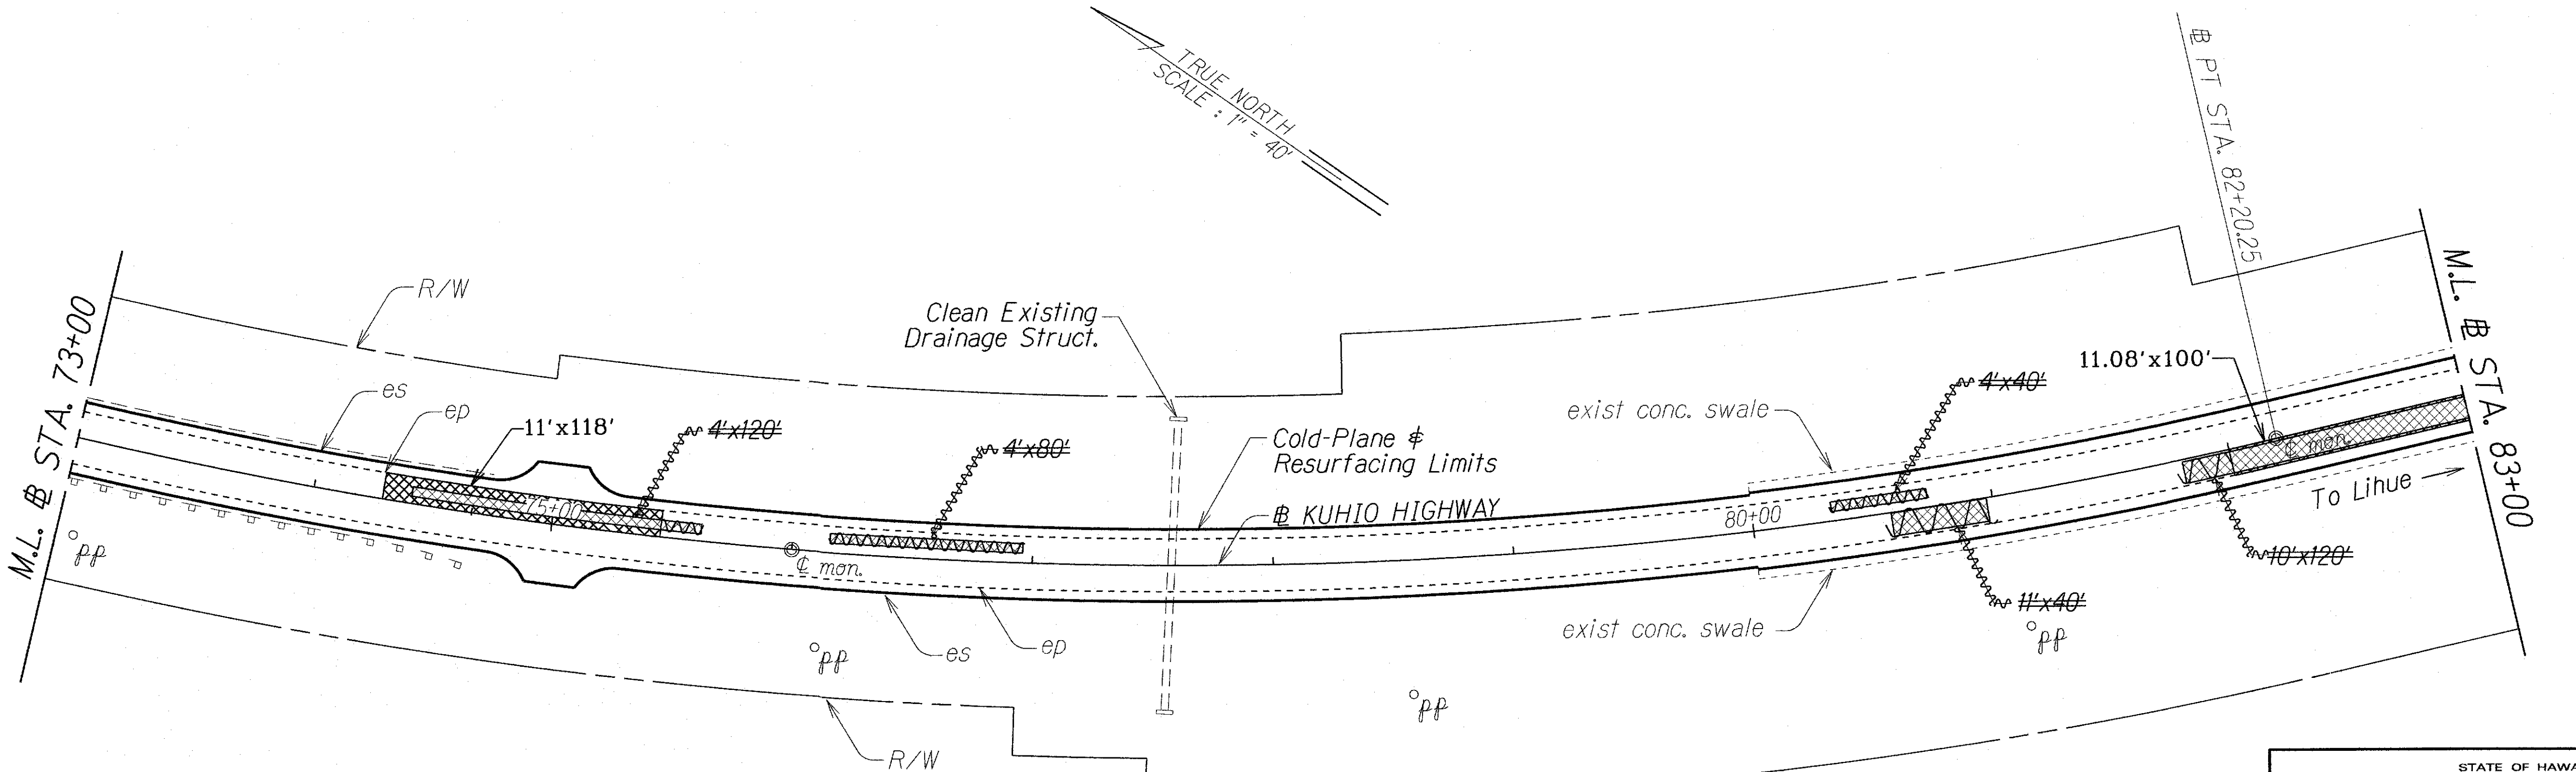

LEGEND FOR AS-BUILT POSTINGS	
	Squiggly line for as-built deletion
	Double line for as-built deletion
Roadway	Text for as-built posting

STATE OF HAWAII
DEPARTMENT OF TRANSPORTATION
HIGHWAYS DIVISION

ROADWAY PLAN



KUHIO HIGHWAY RESURFACING
Vic. of South Koolau Road to Kapuna Road
Mile Post 16.88 to Mile Post 18.95
Federal-Aid Project No. STP-056-1(057)
Scale: 1" = 40' Date: Oct. 2014

SHEET No. 1 OF 6 SHEETS

ORIGINAL PLAN	SURVEY PLOTTED BY	DATE
NOTE BOOK	DESIGNED BY	
	QUANTITIES BY	
	CHECKED BY	

"AS-BUILT"

FED. ROAD DIST. NO.	STATE	FED-AID PROJ. NO.	FISCAL YEAR	SHEET NO.	TOTAL SHEETS
HAWAII	HAW.	STP-056-1(057)	2015	11	24

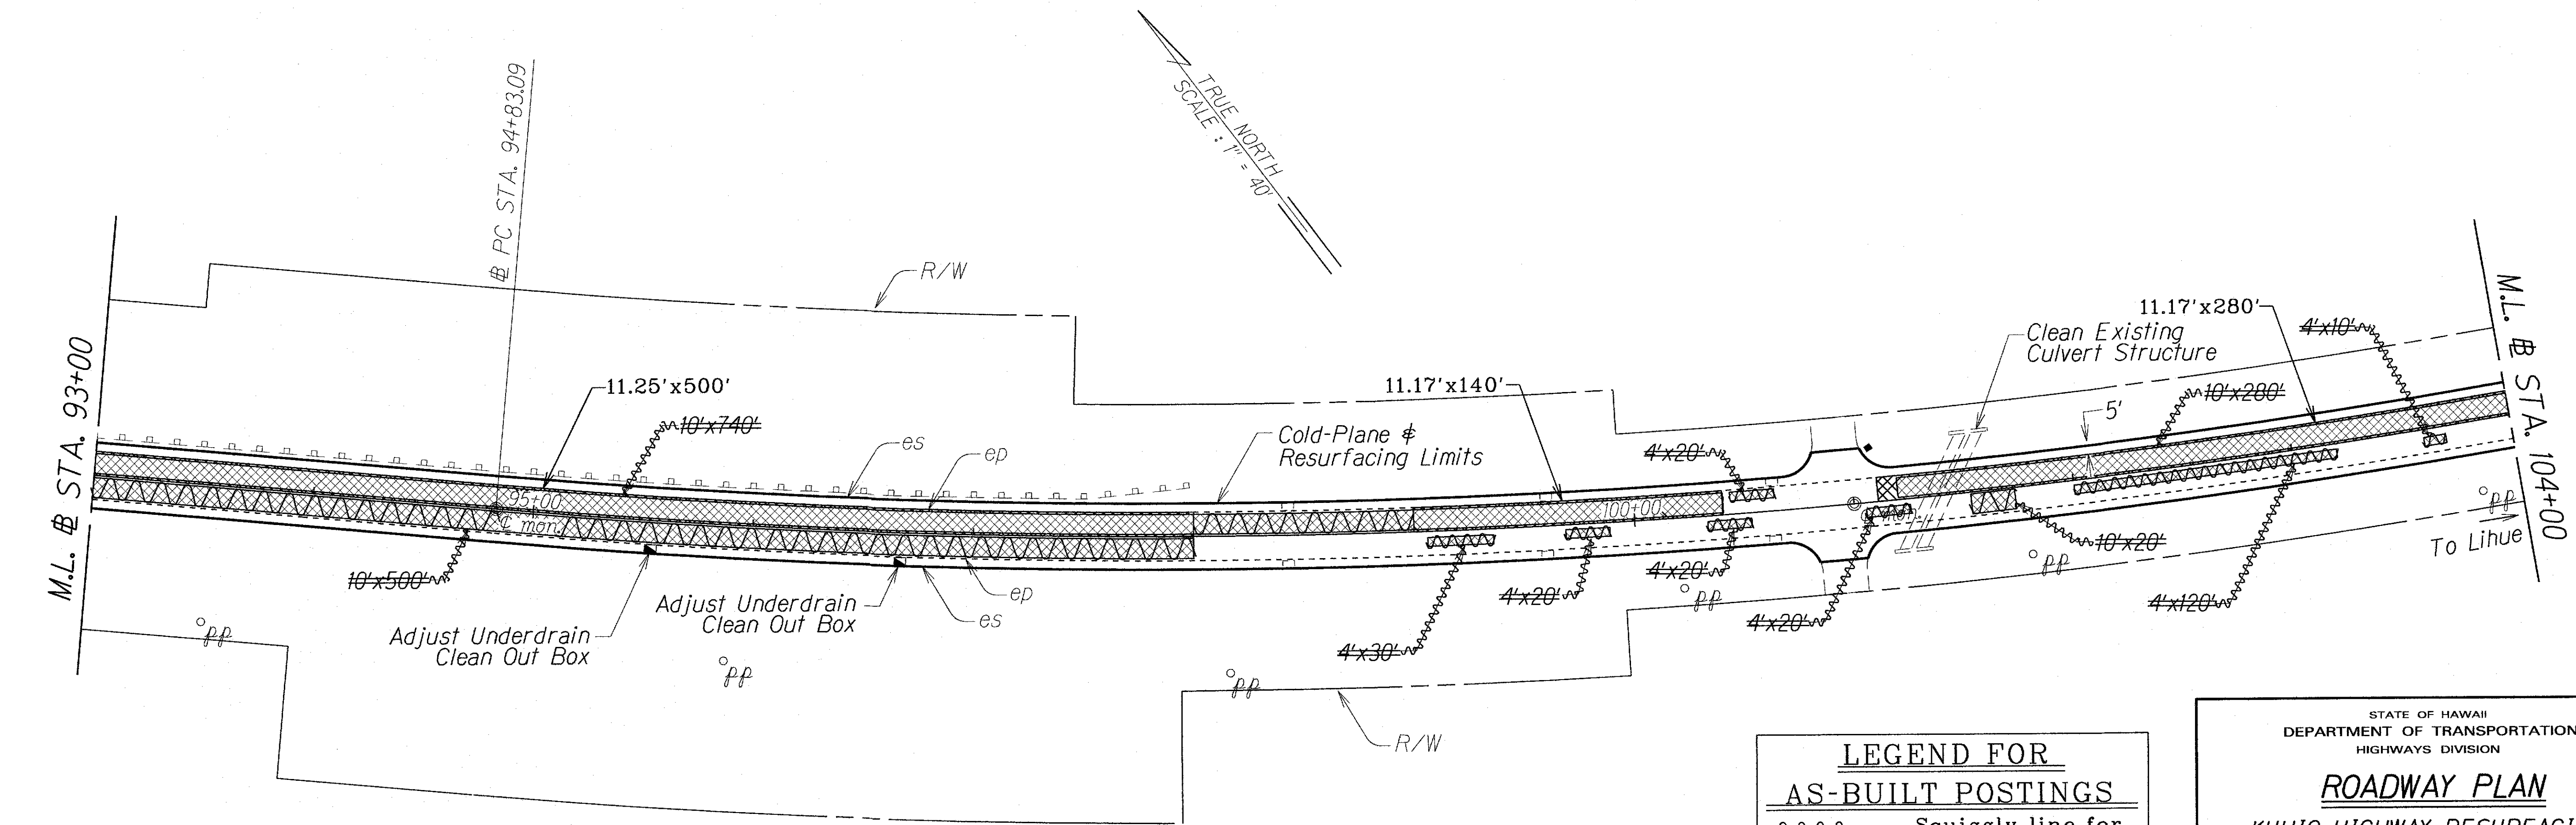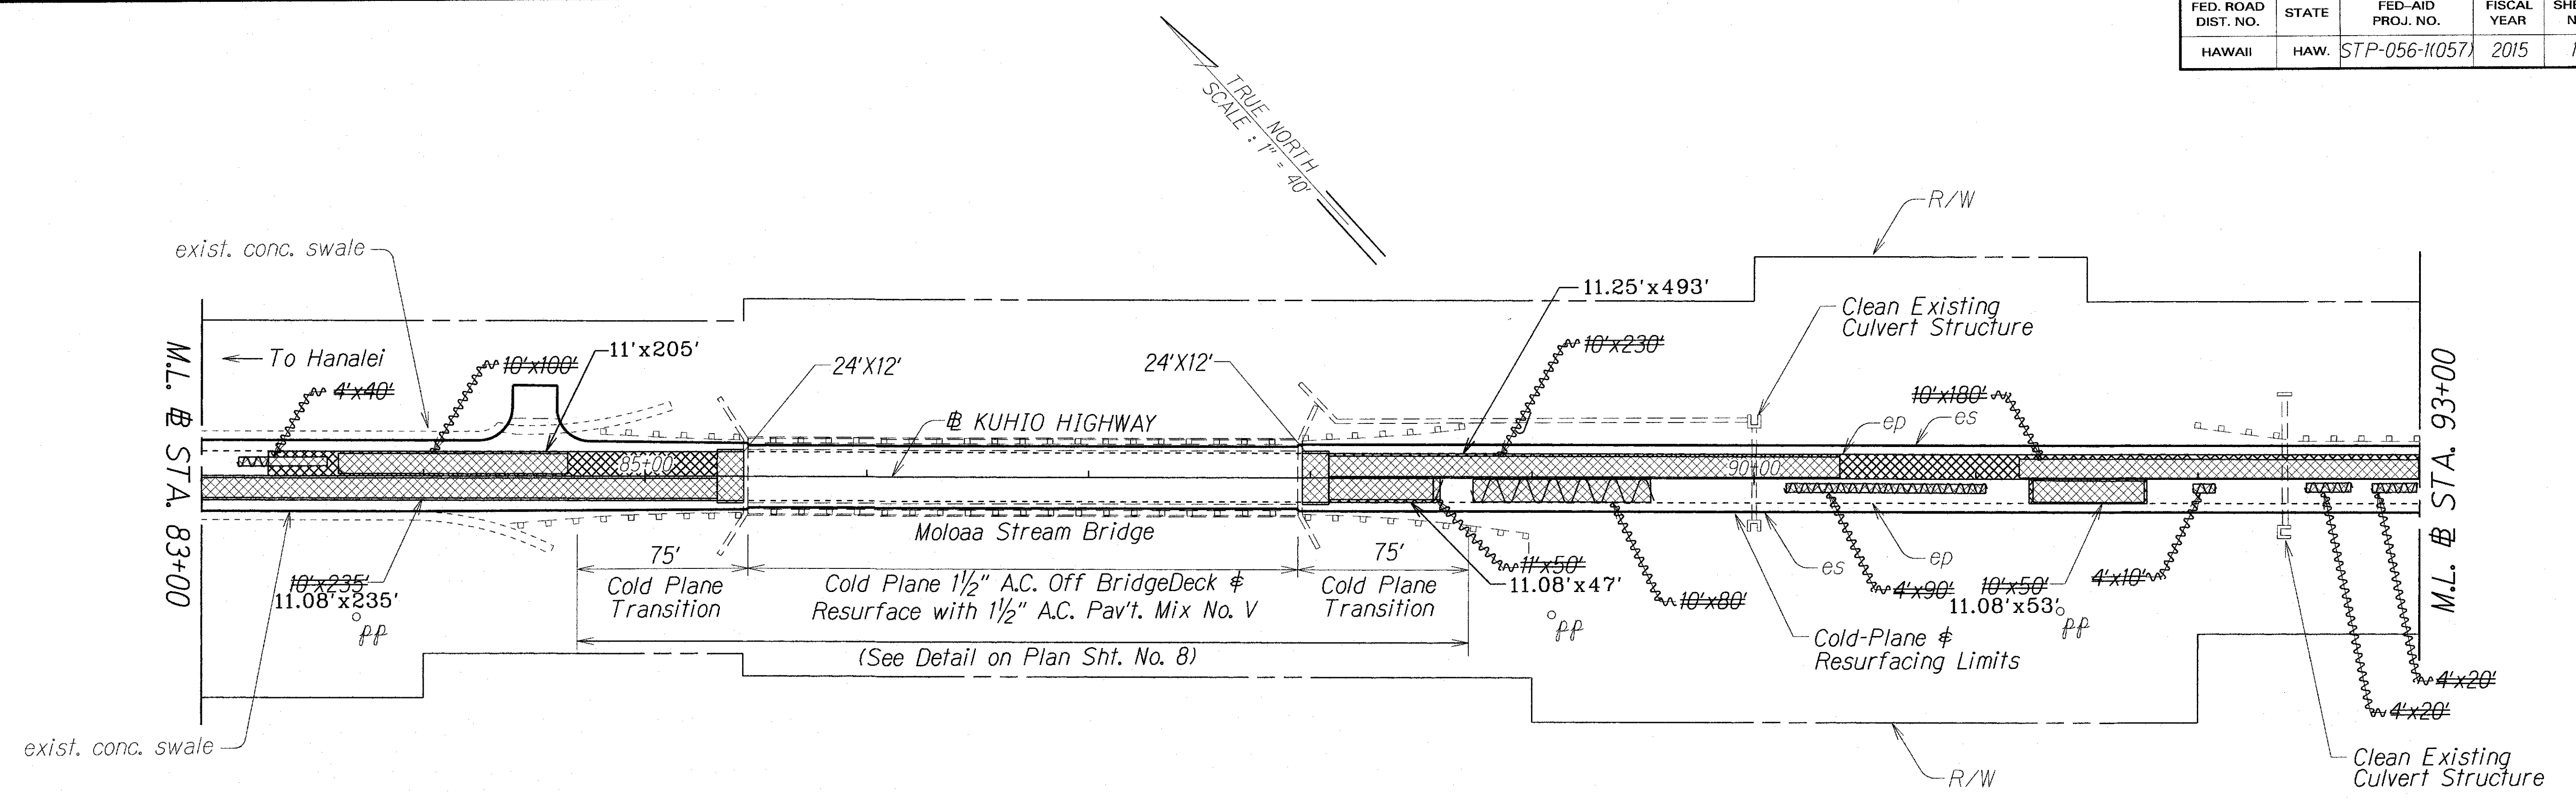



ORIGINAL PLAN	SURVEY PLOTTED BY	DATE
NOTE BOOK	DESIGNED BY	
QUANTITIES BY	CHECKED BY	
N.		

LEGEND FOR AS-BUILT POSTINGS	
	Squiggly line for as-built deletion
	Double line for as-built deletion
Roadway	Text for as-built posting

STATE OF HAWAII
DEPARTMENT OF TRANSPORTATION
HIGHWAYS DIVISION
ROADWAY PLAN
KUHIO HIGHWAY RESURFACING
Vic. of South Koolau Road to Kapuna Road
Mile Post 16.88 to Mile Post 18.95
Federal-Aid Project No. STP-056-1(057)
Scale: 1" = 40' Date: Oct. 2014
SHEET No. 2 OF 6 SHEETS

"AS-BUILT"

FED. ROAD DIST. NO.	STATE	FED-AID PROJ. NO.	FISCAL YEAR	SHEET NO.	TOTAL SHEETS
HAWAII	HAW.	STP-056-11057	2015	14	24

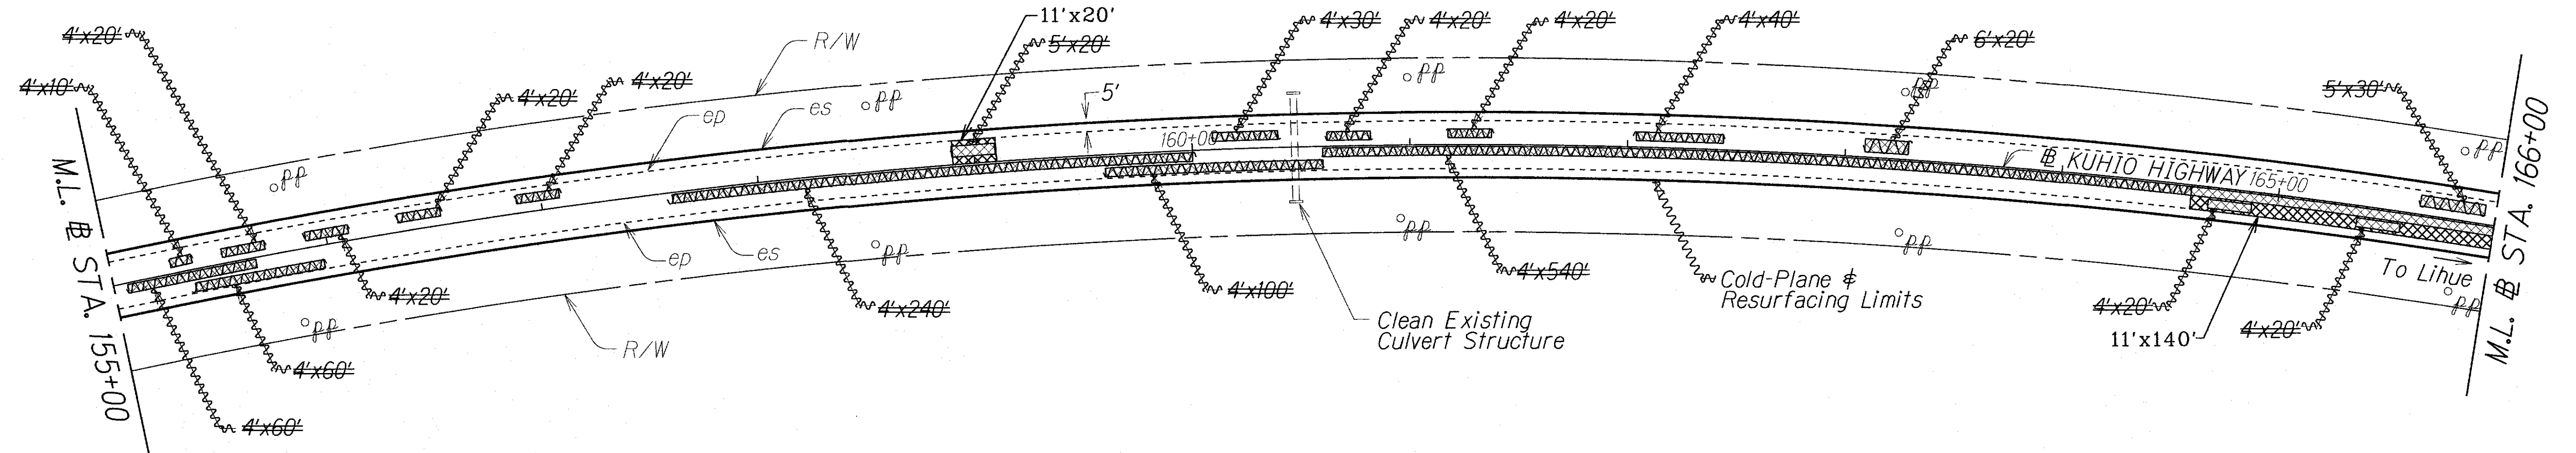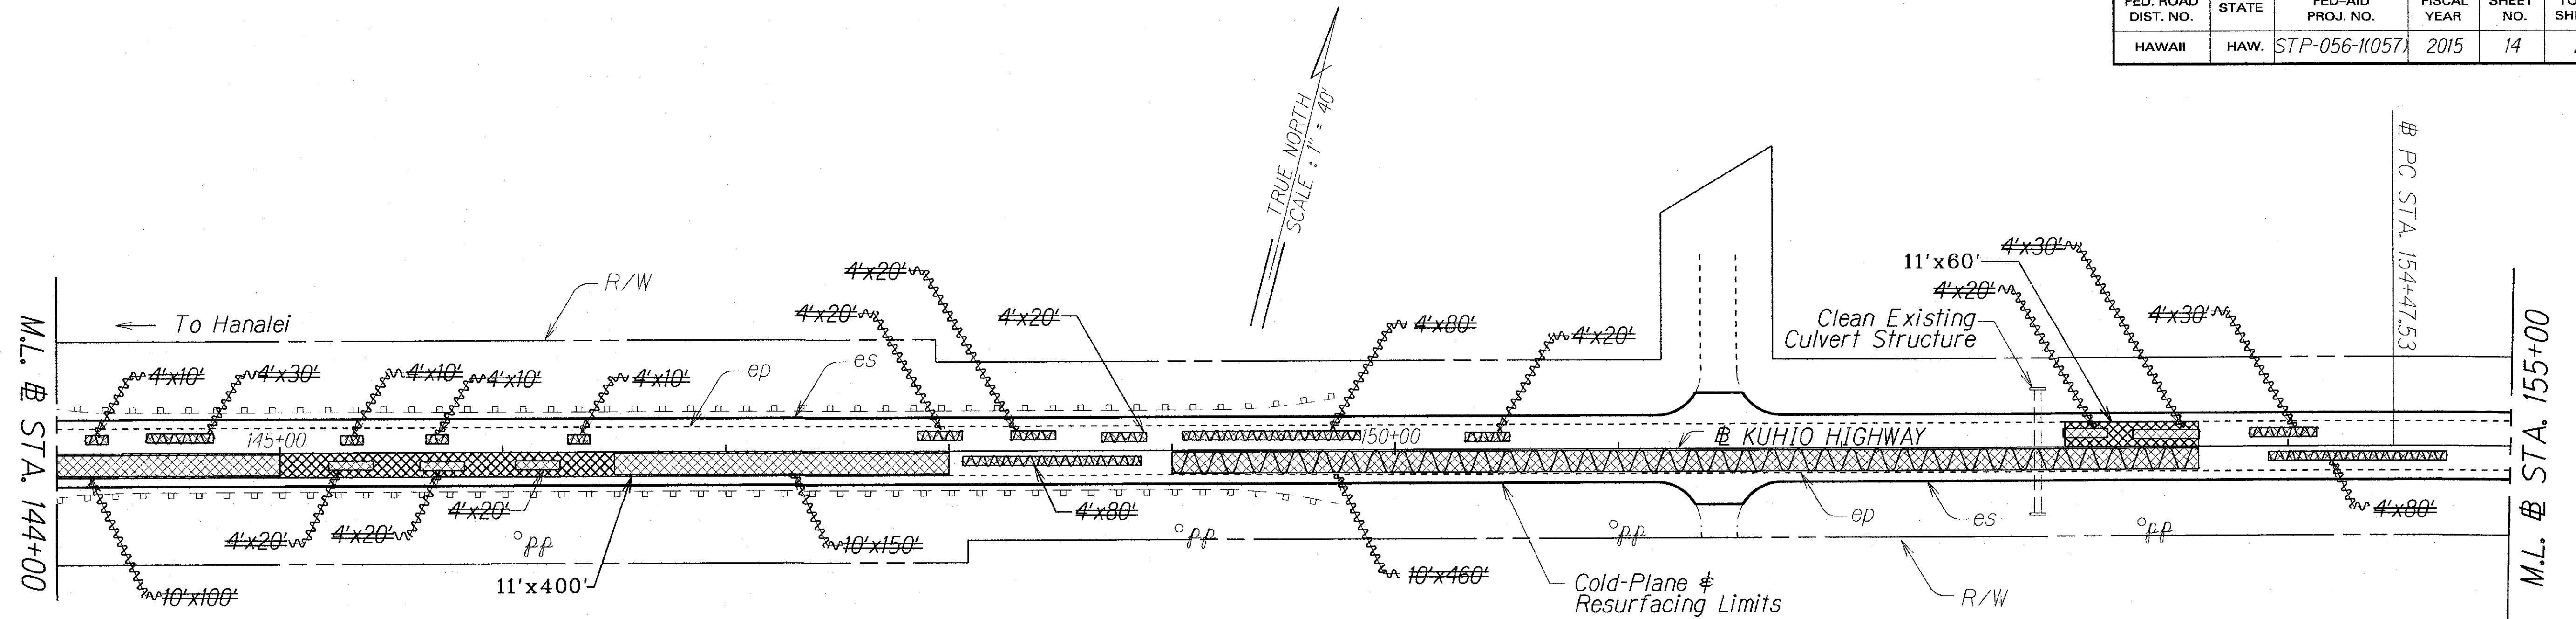

ORIGINAL PLAN	SURVEY PLOTTED BY	DATE
TRACED BY		
NOTE BOOK		
QUANTITIES BY		
CHECKED BY		

LEGEND FOR AS-BUILT POSTINGS	
	Squiggly line for as-built deletion
	Double line for as-built deletion
Roadway	Text for as-built posting

STATE OF HAWAII
DEPARTMENT OF TRANSPORTATION
HIGHWAYS DIVISION


ROADWAY PLAN

KUHIO HIGHWAY RESURFACING
Vic. of South Koolau Road to Kapuna Road
Mile Post 16.88 to Mile Post 18.95
Federal-Aid Project No. STP-056-11057
Scale: 1" = 40' Date: Oct. 2014

SHEET No. 5 OF 6 SHEETS

"AS-BUILT"

FED. ROAD DIST. NO.	STATE	FED-AID PROJ. NO.	FISCAL YEAR	SHEET NO.	TOTAL SHEETS
HAWAII	HAW.	STP-056-1(057)	2015	15	24

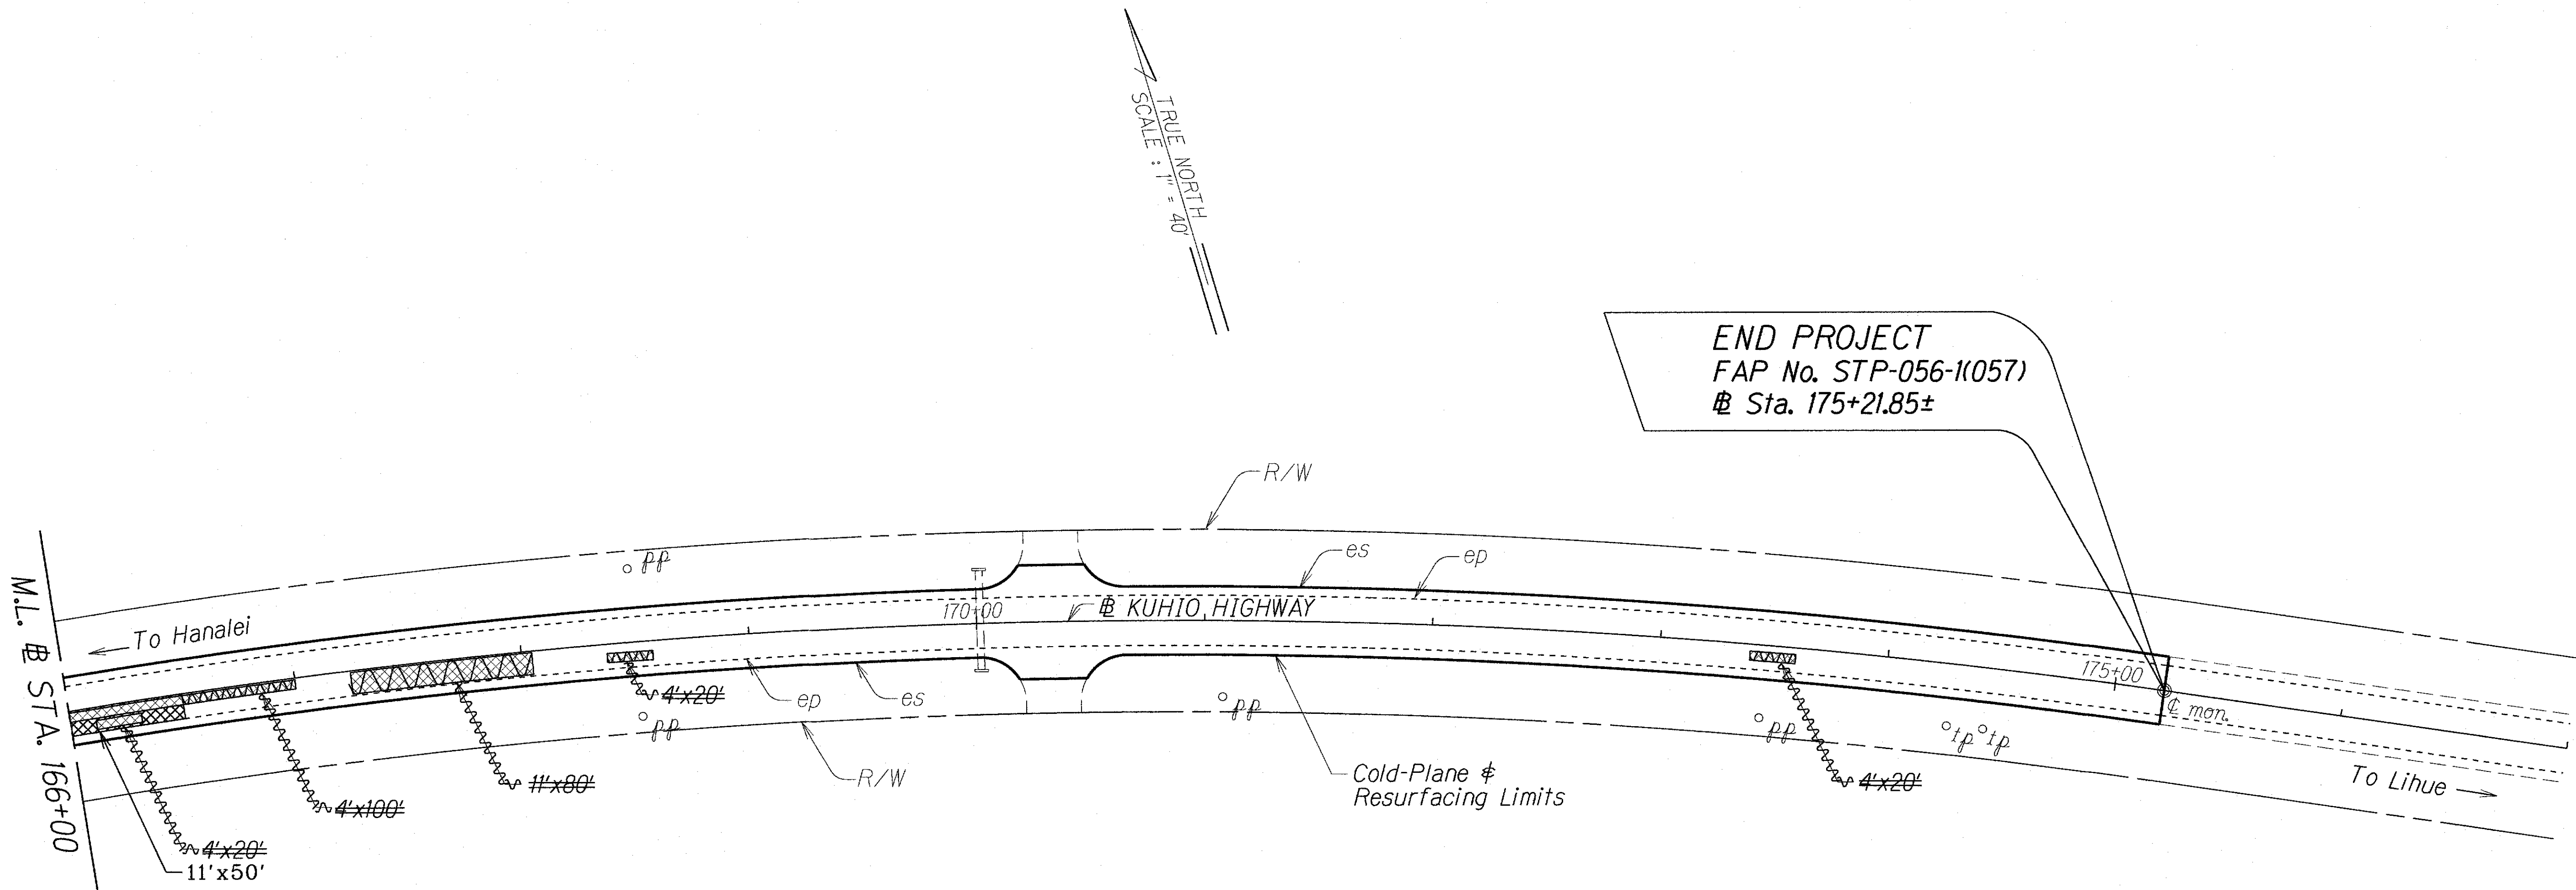

ORIGINAL	SURVEY PLATTED BY	DATE
PLAN	DRAWN BY	
NOTED	DESIGNED BY	
QUANTITIES BY		
CHECKED BY		

LEGEND FOR AS-BUILT POSTINGS	
	Squiggly line for as-built deletion
	Double line for as-built deletion
Roadway	Text for as-built posting

STATE OF HAWAII
DEPARTMENT OF TRANSPORTATION
HIGHWAYS DIVISION
ROADWAY PLAN
KUHIO HIGHWAY RESURFACING
Vic. of South Koolau Road to Kapuna Road
Mile Post 16.88 to Mile Post 18.95
Federal-Aid Project No. STP-056-1(057)
Scale: 1" = 40' Date: Oct. 2014
SHEET No. 6 OF 6 SHEETS