



FED. ROAD DIST. NO.	STATE	PROJ. NO.	FISCAL YEAR	SHEET NO.	TOTAL SHEETS
HAWAII	HAW.	56D-01-13	2013	ADD. 6	23

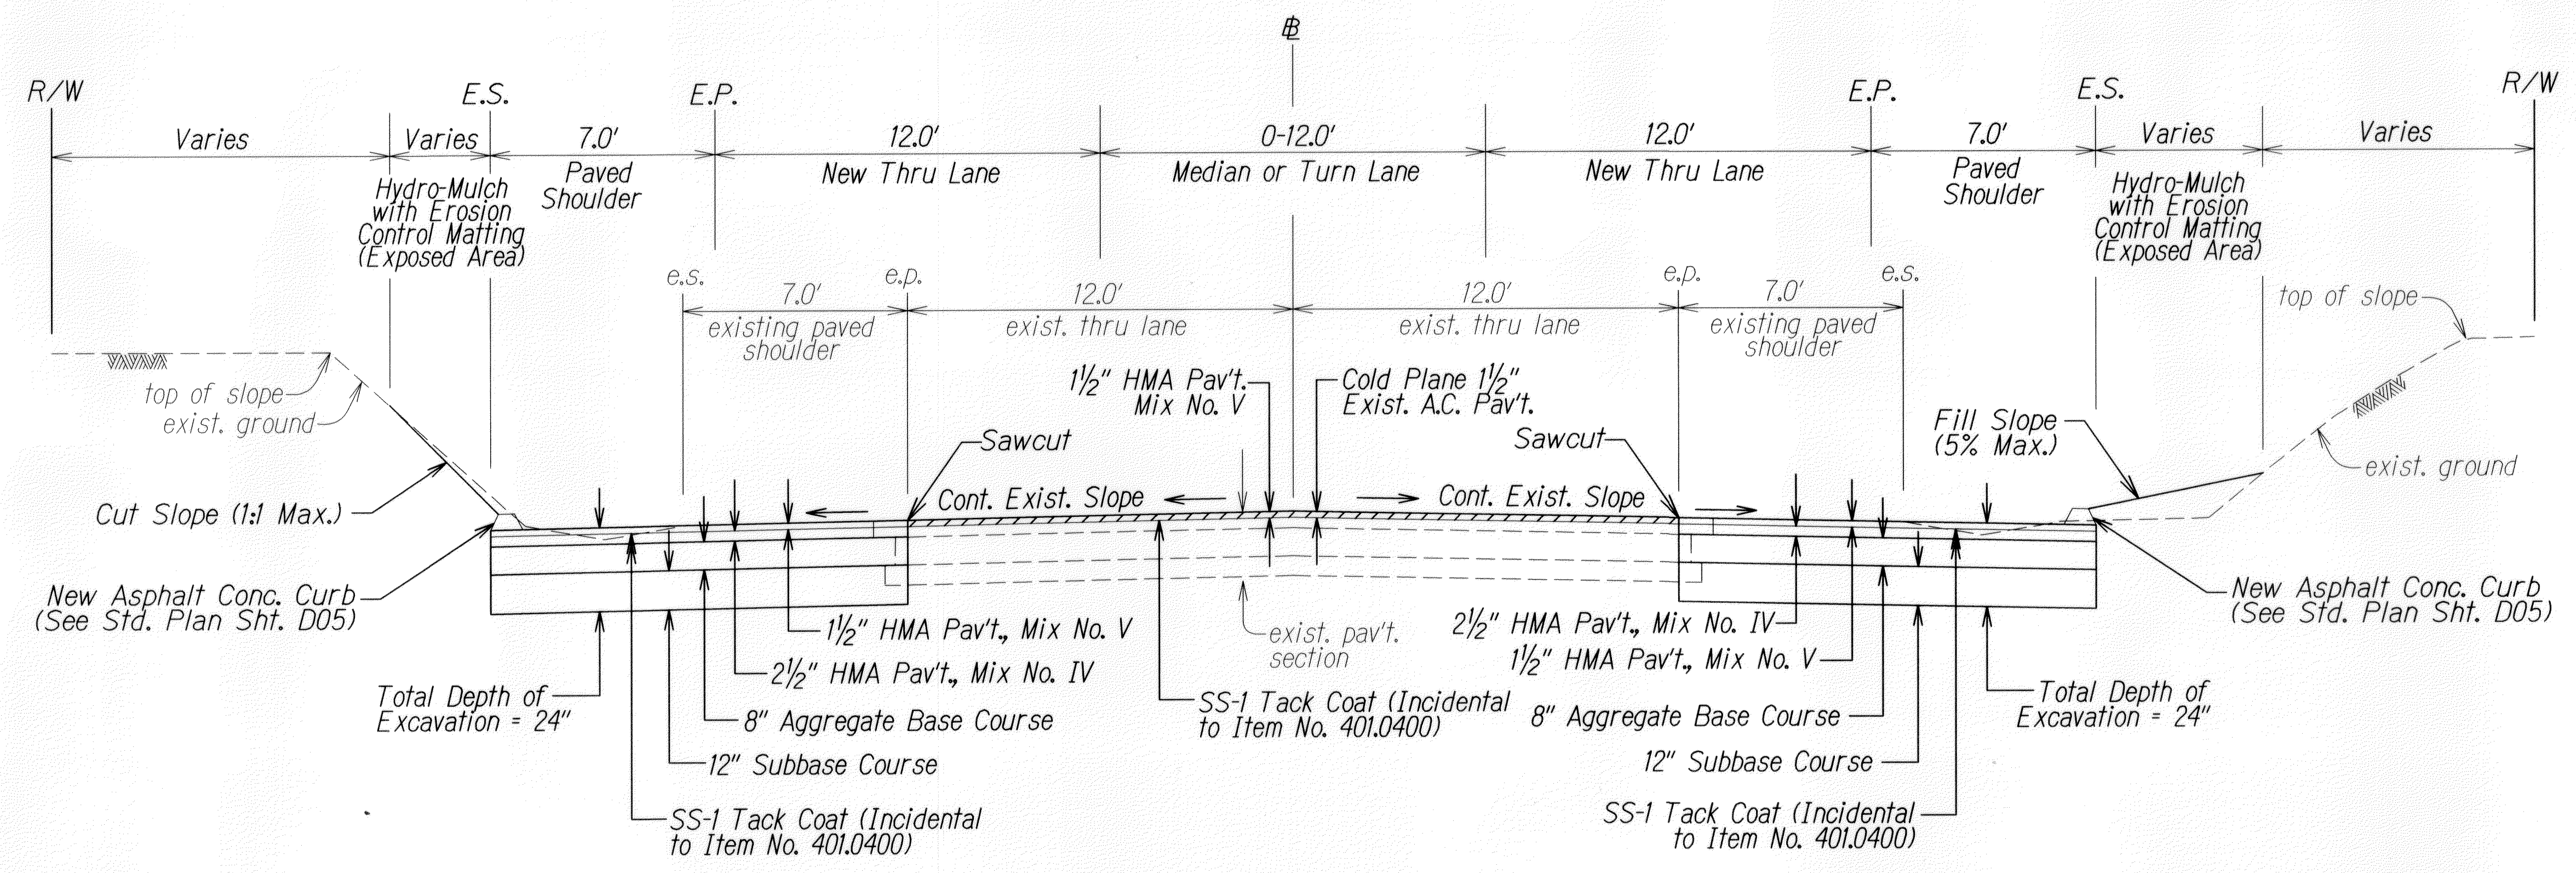


△ TYPICAL SECTION @ PAVEMENT W/ CURB
Not to Scale

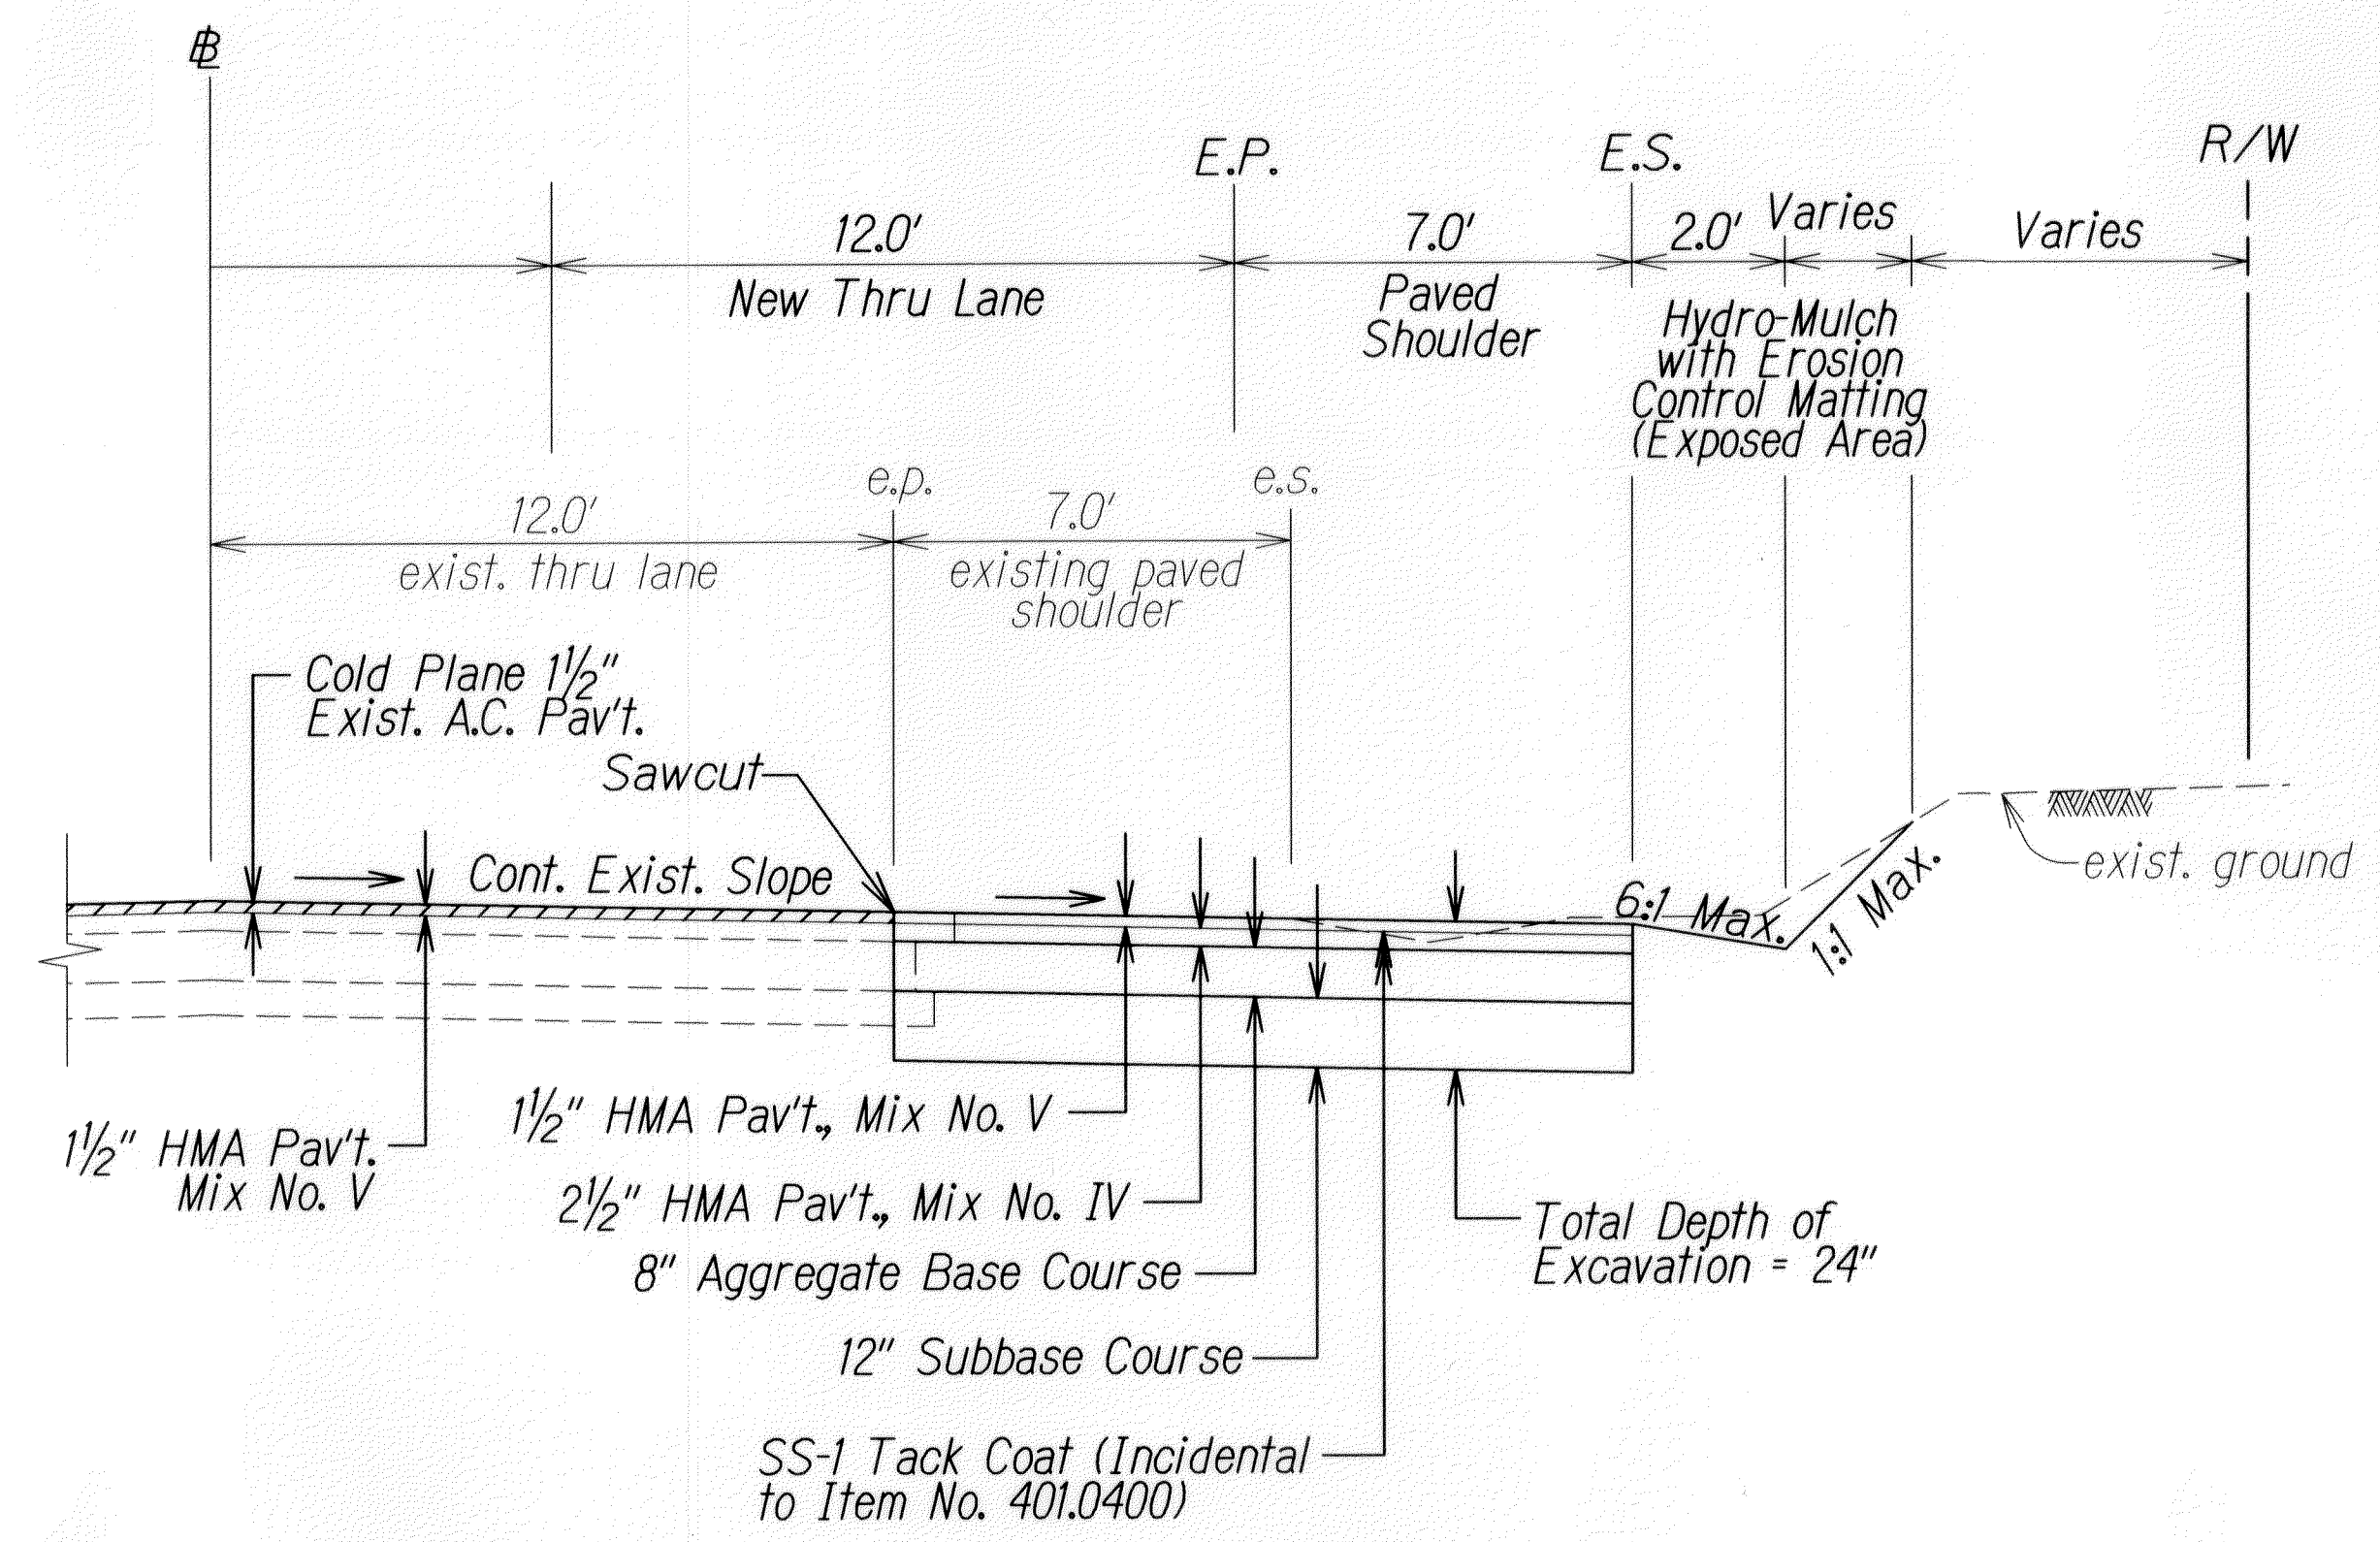


△ TYPICAL SECTION @ PAVEMENT W/O CURB
Not to Scale

6/17/13	△	Typical Section @ Pavement w/ Curb
6/17/13	△	Typical Section @ Pavement w/o Curb
DATE		REVISION
STATE OF HAWAII DEPARTMENT OF TRANSPORTATION HIGHWAYS DIVISION TYPICAL SECTIONS KUHIO HIGHWAY Intersection Improvements at Kapaka Street Project No. 56D-01-13 Not to Scale Date: June 2013 SHEET No. 1 OF 2 SHEETS		

FED. ROAD DIST. NO.	STATE	PROJ. NO.	FISCAL YEAR	SHEET NO.	TOTAL SHEETS
HAWAII	HAW.	56D-01-13	2013	ADD. 7	23

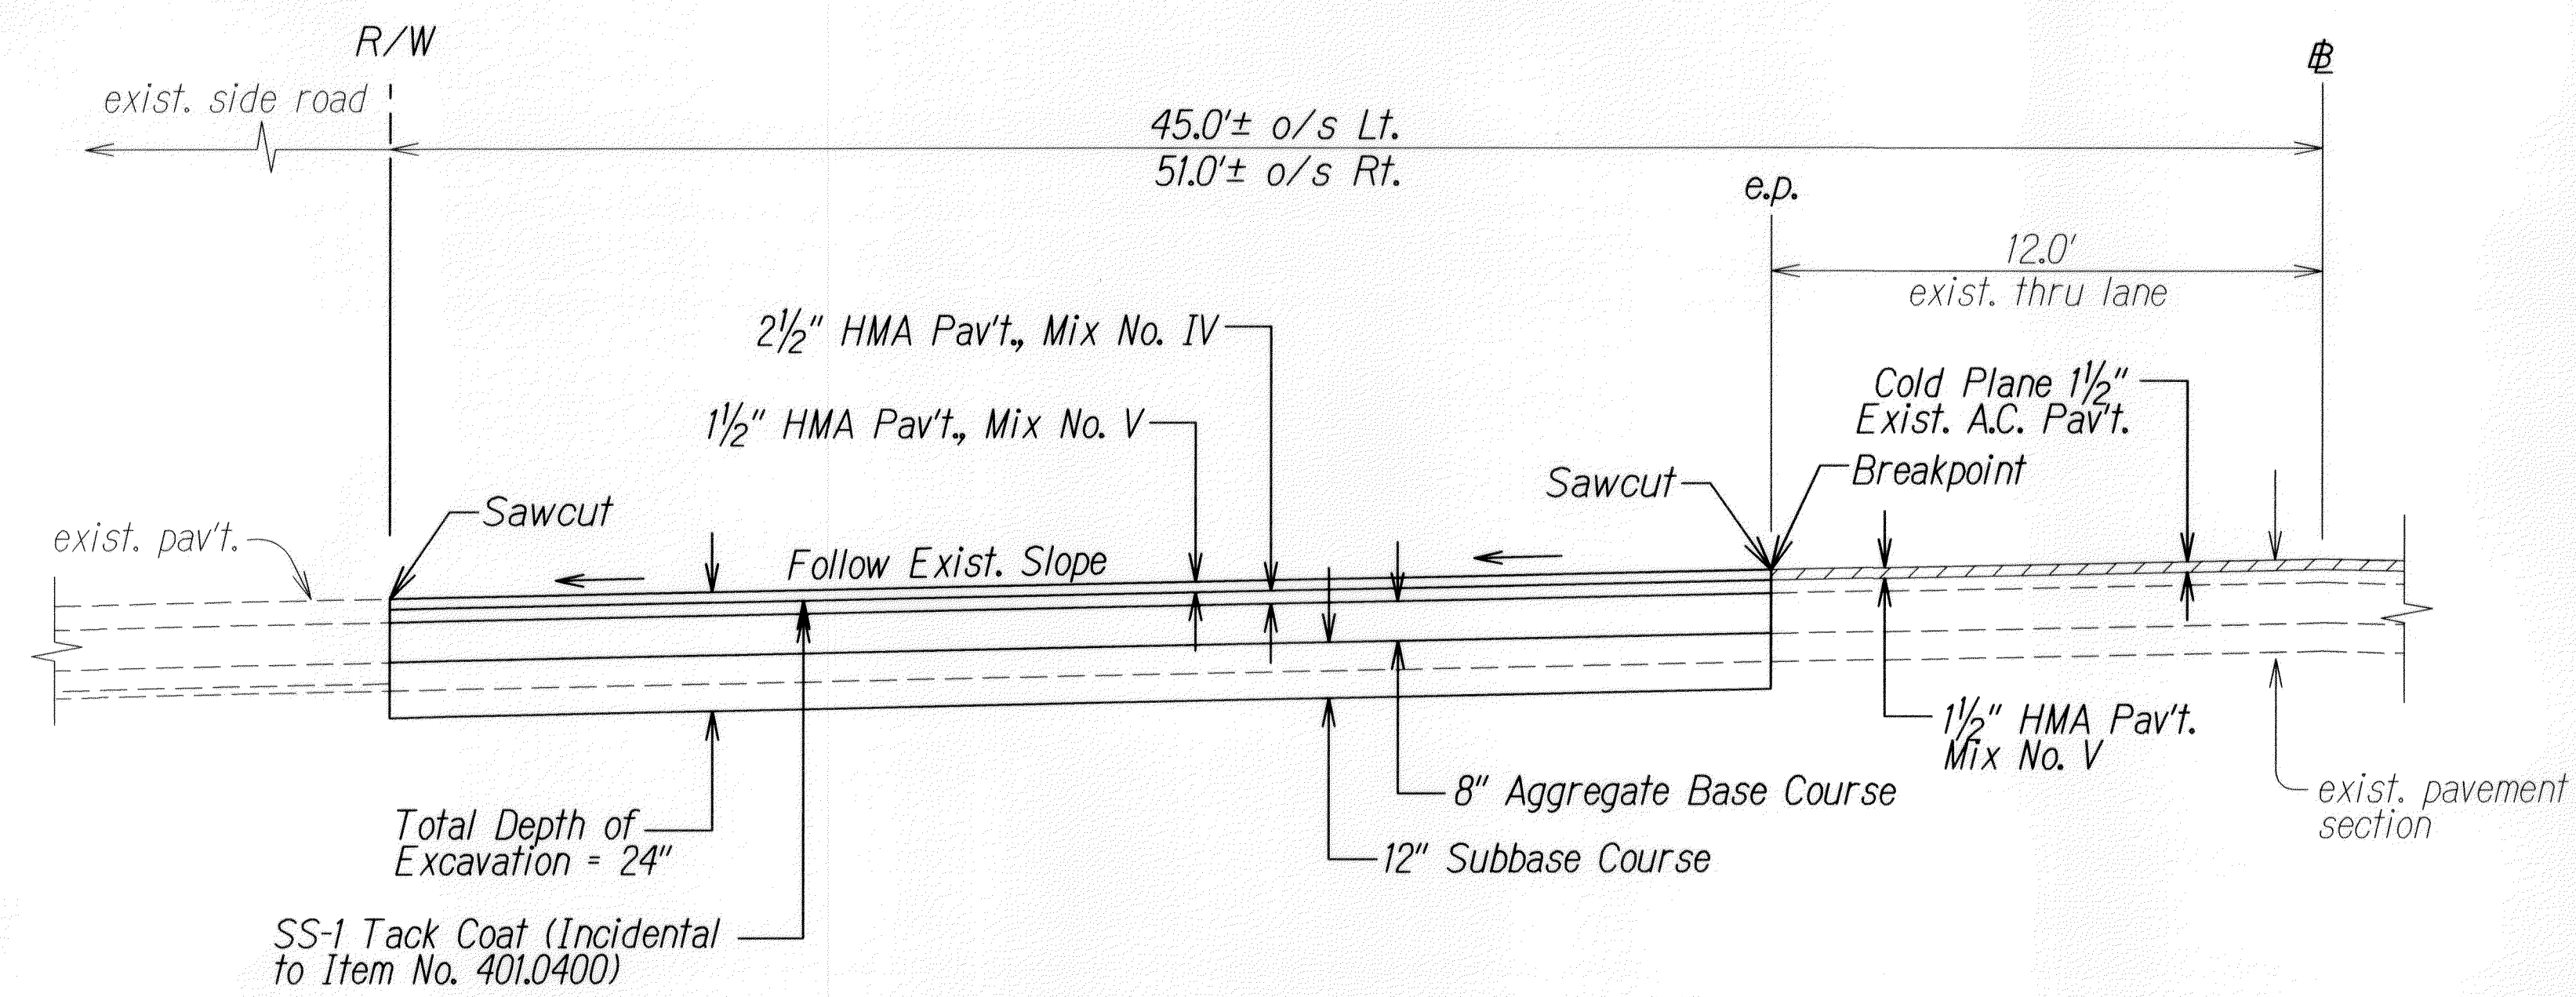

TYPICAL SECTION
△ CONNECTION TO EXISTING SIDEROAD
Not to Scale

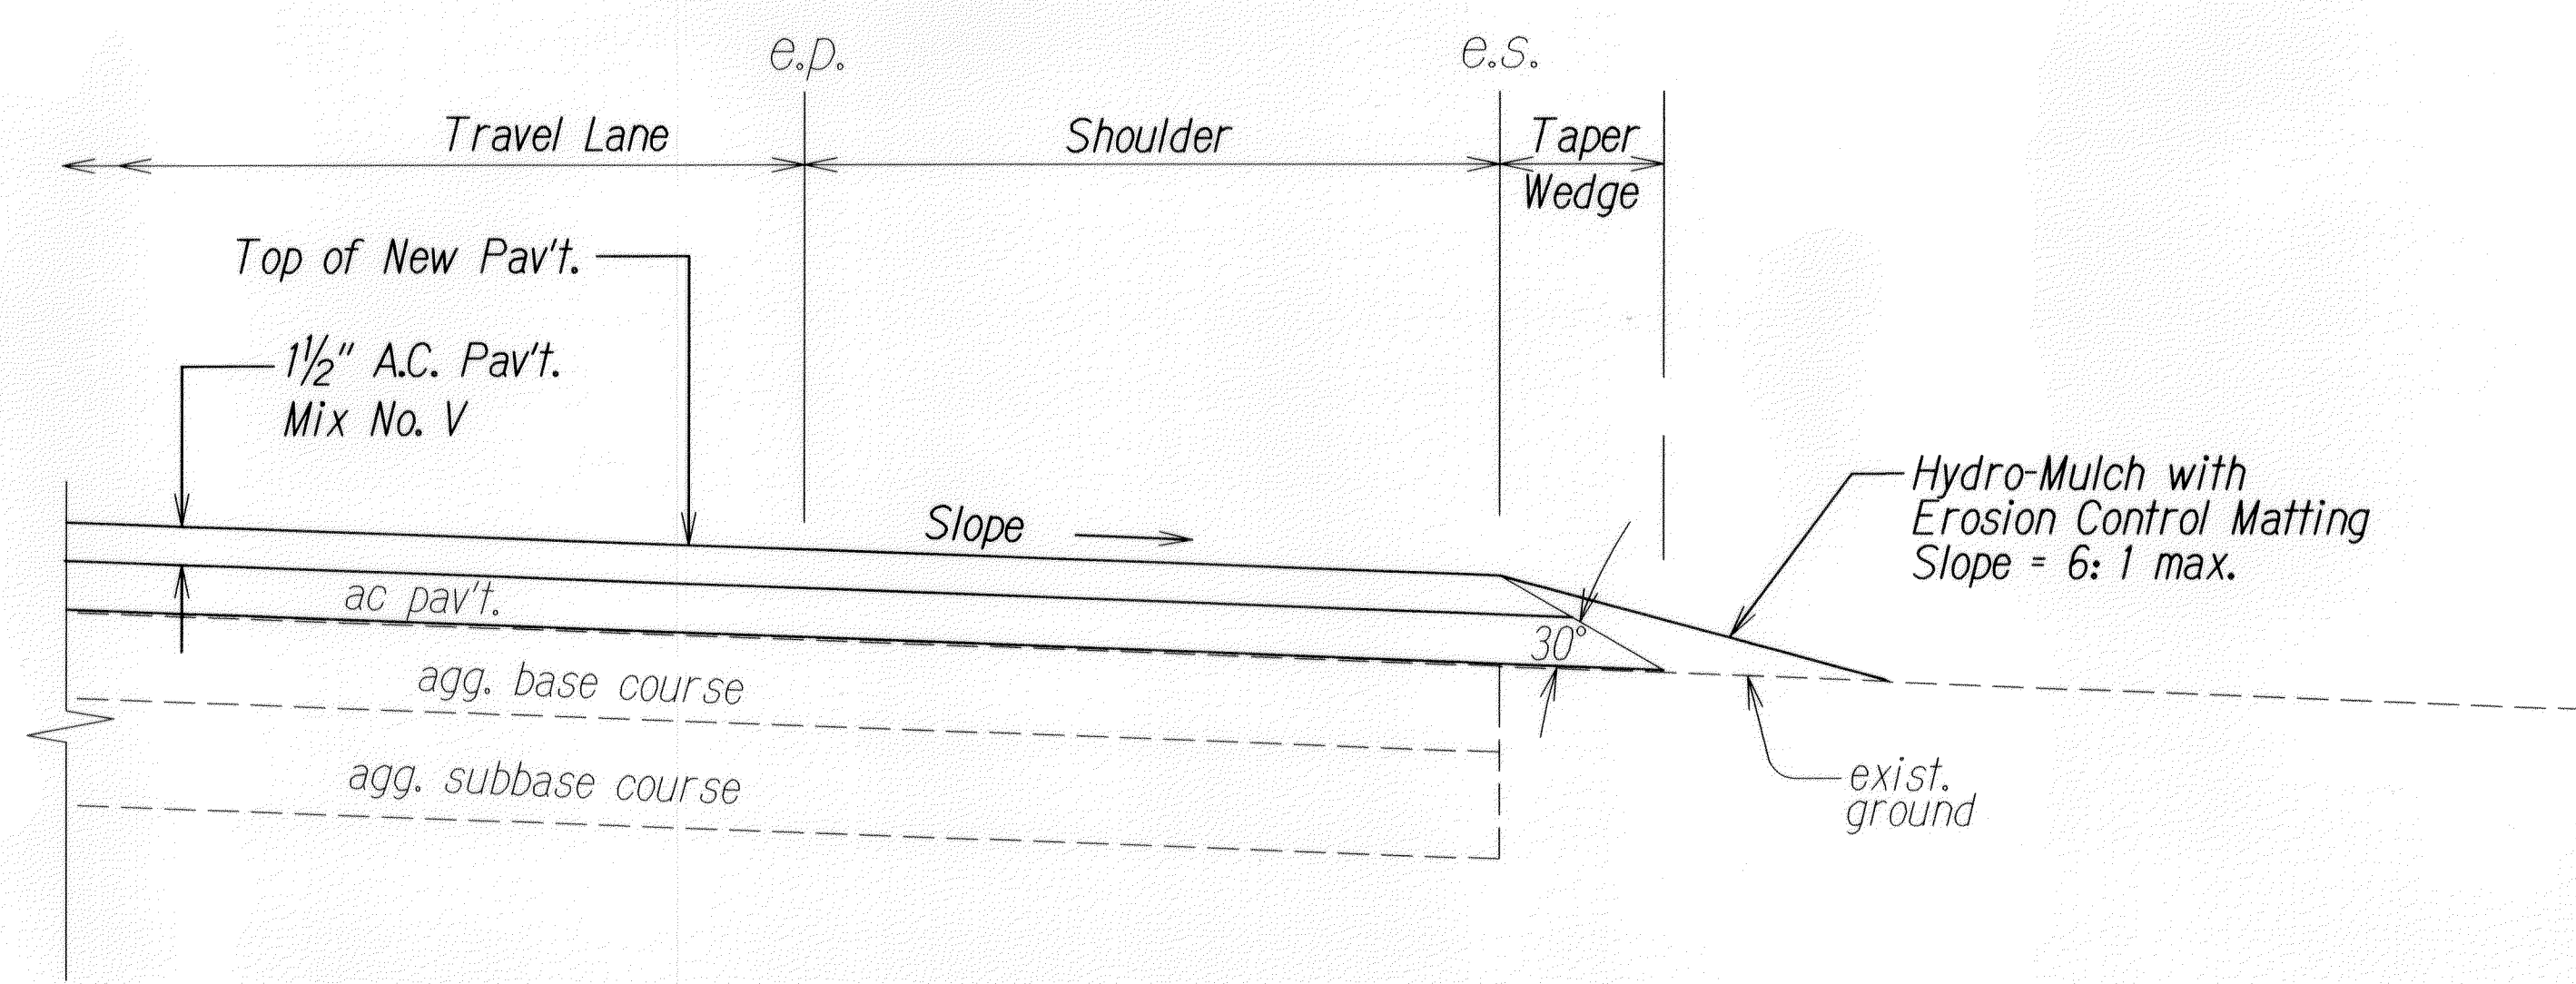


△ TYPICAL PAVEMENT EDGE DETAIL
Not to Scale

- Note:*
- Contractor shall mount a device directly on the paver screed extension to provide a 30° beveled shoulder edge.
 - Construct safety edge at all edges of a.c. pavement. This work shall be considered incidental to Item No. 401.0400 - HMA Pavement Mix no. IV.

6/17/13	△ - Typical Pavement Edge Detail
6/17/13	△ - Typical Section Connection to Existing Sideroad
DATE	REVISION
STATE OF HAWAII DEPARTMENT OF TRANSPORTATION HIGHWAYS DIVISION TYPICAL SECTIONS <u>KUHIO HIGHWAY</u> <u>Intersection Improvements at Kapaka Street</u> <u>Project No. 56D-01-13</u> <i>Not to Scale</i> <i>Date: June 2013</i>	
SHEET No. 2 OF 2 SHEETS	

ORIGINAL PLAN	SURVEY PLOTTED BY	DATE
DRAWN BY		
NOTE BOOK		
QUANTITIES BY		
CHECKED BY		

FED. ROAD DIST. NO.	STATE	PROJ. NO.	FISCAL YEAR	SHEET NO.	TOTAL SHEETS
HAWAII	HAW.	56D-01-13	2013	ADD. 15	23

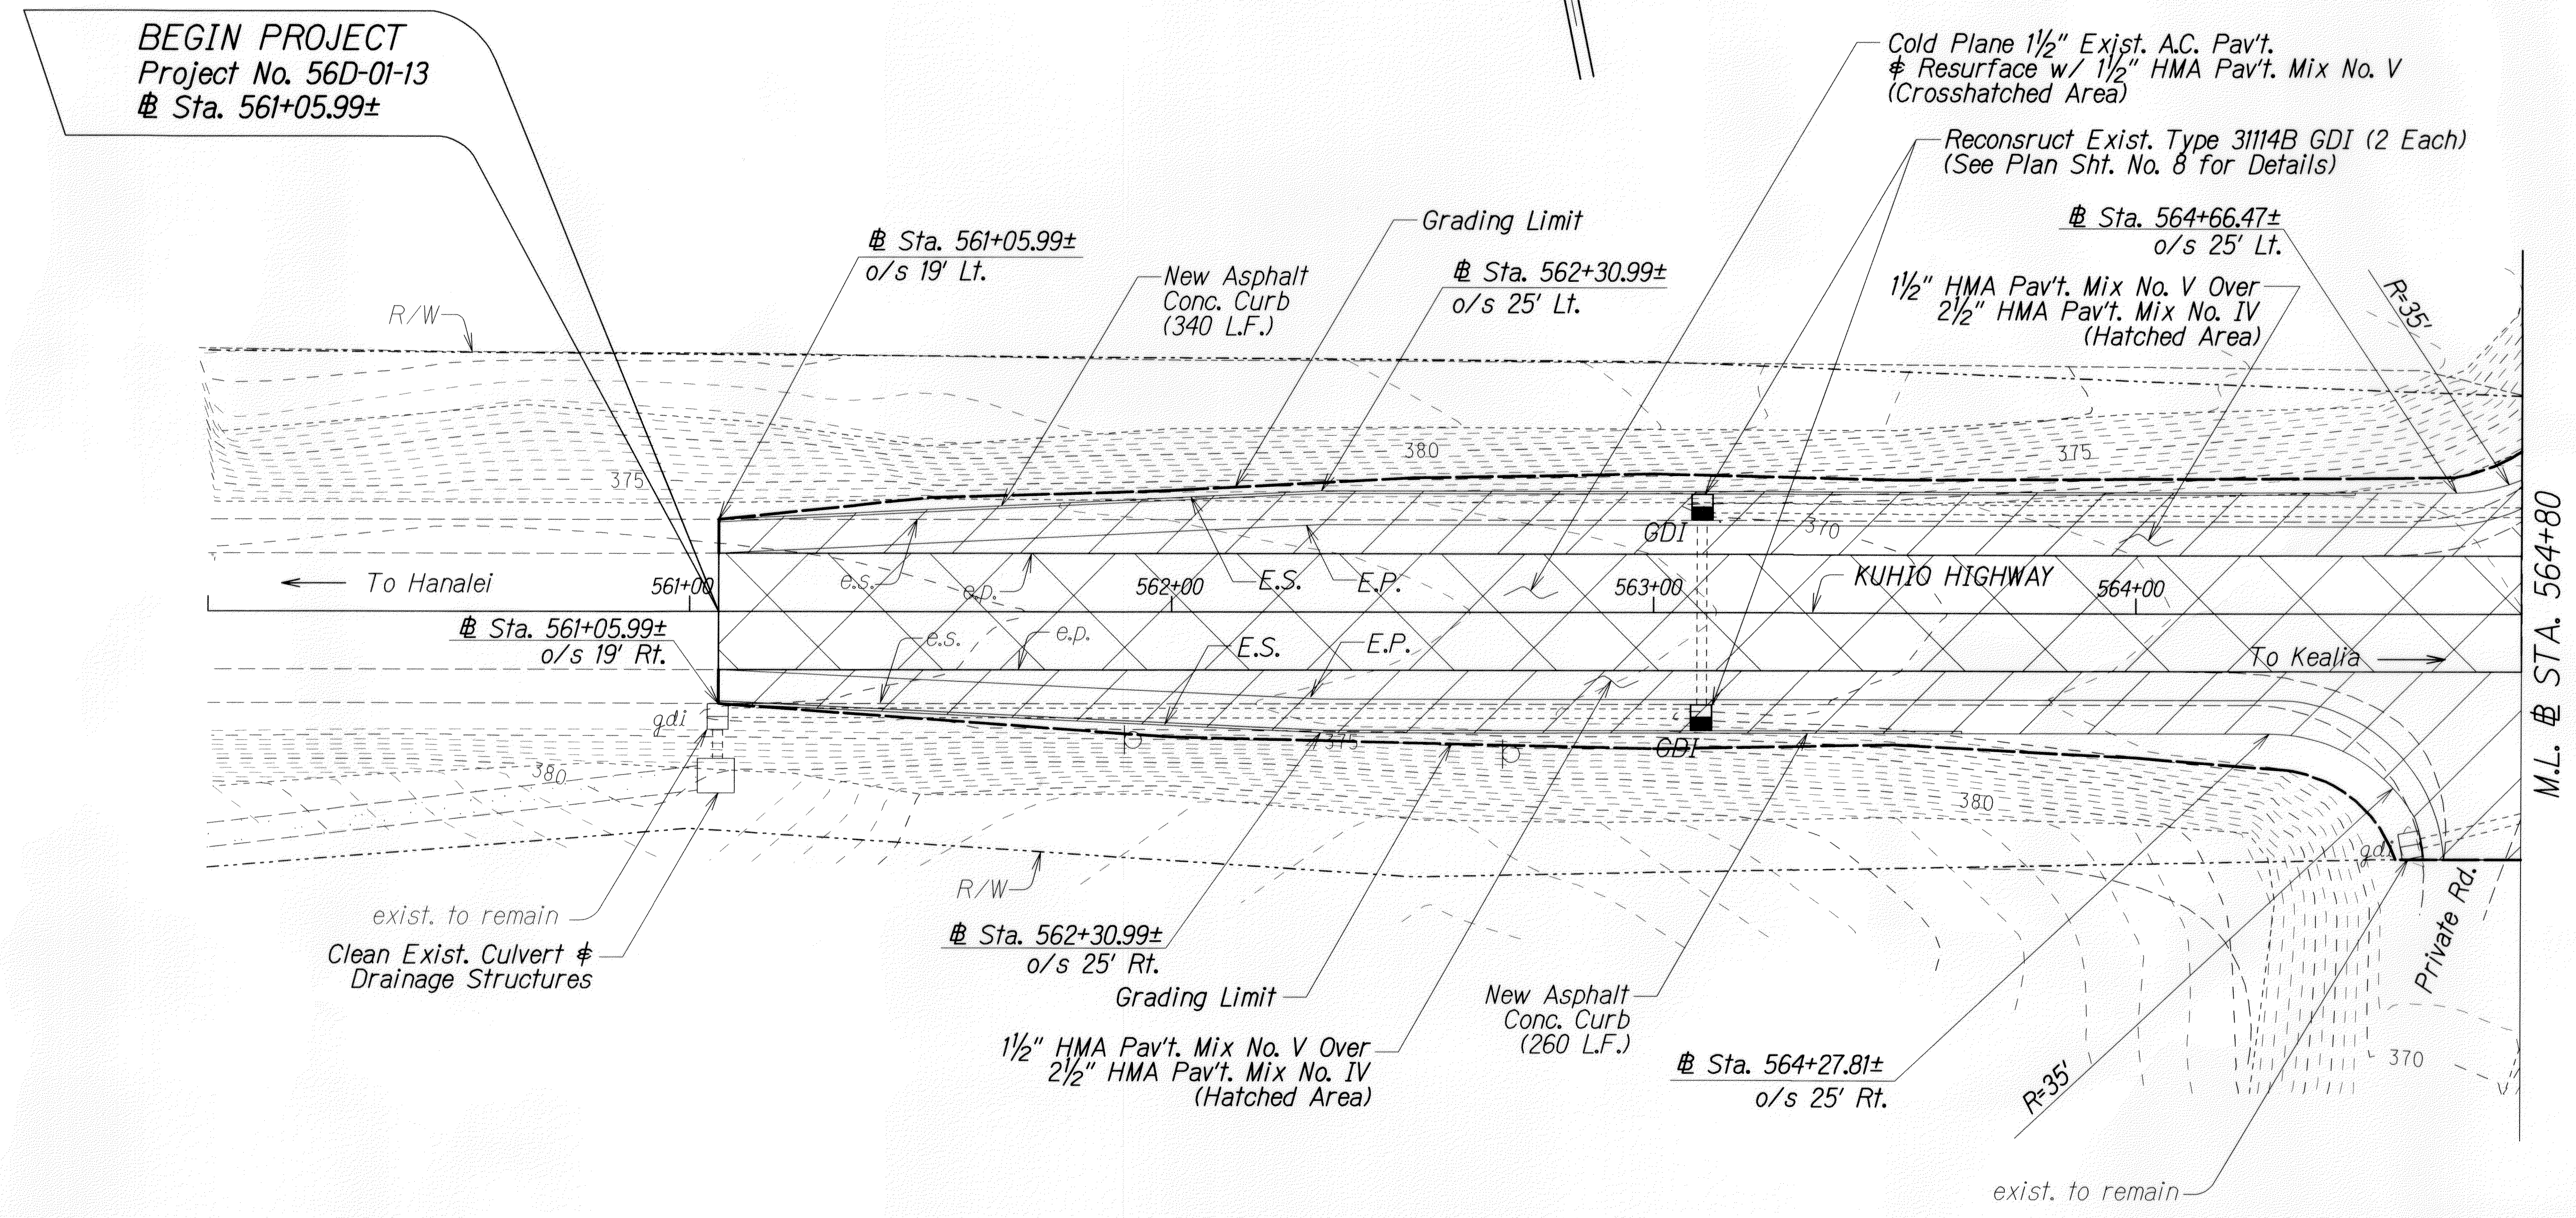

TRUE NORTH
SCALE: 1" = 20'


ORIGINAL PLAN	SURVEY PLOTTED BY	DATE
DRAWN BY		
NOTE BOOK		
QUANTITIES BY		
CHECKED BY		

Legend:
 — 1 1/2" Cold Plane (Crosshatched Area)

6/17/13	△ - Roadway Plan
DATE	REVISION
STATE OF HAWAII DEPARTMENT OF TRANSPORTATION HIGHWAYS DIVISION	
ROADWAY PLAN	
KUHIU HIGHWAY	
Intersection Improvements at Kapaka Street	
Project No. 56D-01-13	
Scale: 1" = 20'	Date: June 2013
SHEET No. 1 OF 2 SHEETS	

ADD. 15

FED. ROAD DIST. NO.	STATE	PROJ. NO.	FISCAL YEAR	SHEET NO.	TOTAL SHEETS
HAWAII	HAW.	56D-01-13	2013	ADD. 16	23

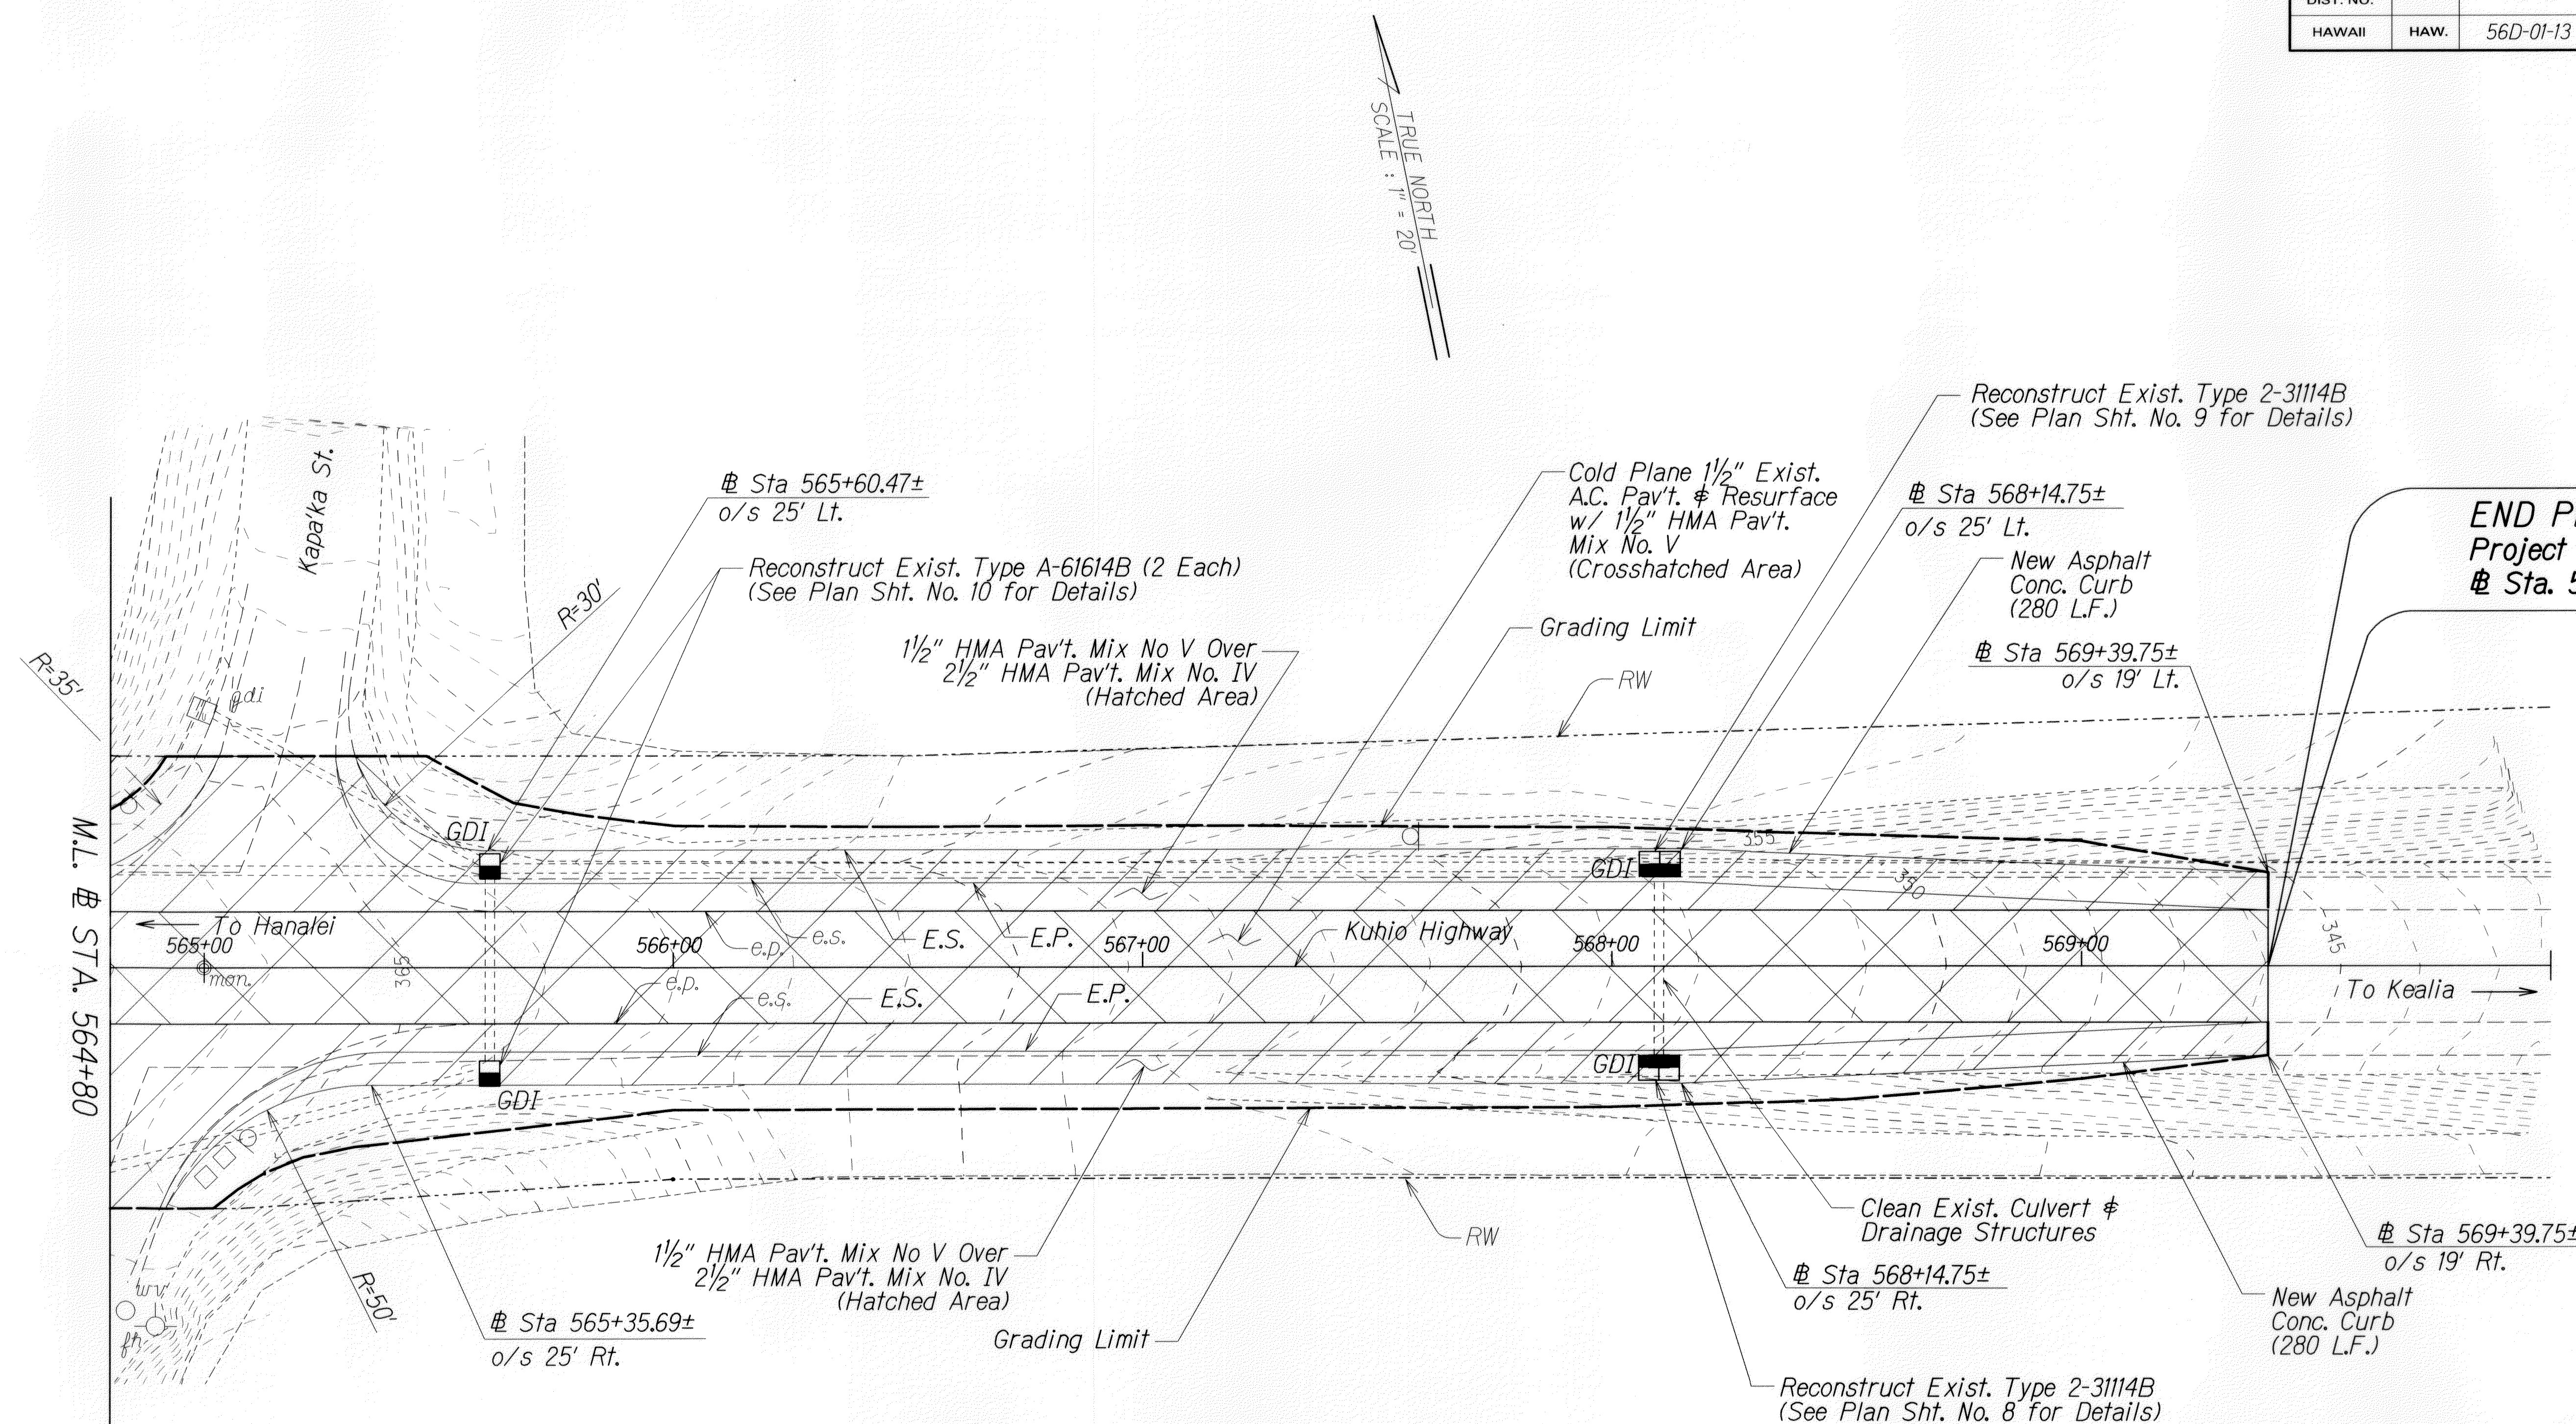

END PROJECT
Project No. 56D-01-13
Sta. 569+39.75±

Legend:
 — 1 1/2" Cold Plane (Crosshatched Area)

6/17/13	△ - Roadway Plan
DATE	REVISION
STATE OF HAWAII DEPARTMENT OF TRANSPORTATION HIGHWAYS DIVISION ROADWAY PLAN KUHIO HIGHWAY Intersection Improvements at Kapaka Street Project No. 56D-01-13 Scale: 1" = 20' Date: June 2013	
SHEET No. 2 OF 2 SHEETS	


ADD. 16

SURVEY PLOTTED BY	DATE
DRAWN BY	
DESIGNED BY	
CHECKED BY	
ORIGINAL PLAN	
NOTE BOOK	
ADD. Design	

FED. ROAD DIST. NO.	STATE	PROJ. NO.	FISCAL YEAR	SHEET NO.	TOTAL SHEETS
HAWAII	HAW.	56D-01-13	2013	ADD. 19S-1	23


Note:

- During non-working periods, place a temporary wedge along the face of all drop-offs. The wedge should consist of stable material placed at a slope of 6H:1V or flatter.
- Channelizing devices shall be double base tubular markers or equal.
- The Contractor shall make adjustments at intersections, driveways and structures to fit field conditions.
- Signs are shown for one direction of travel only. Place devices similar to those depicted for the opposite direction of travel.
- Final location and spacing of signs and devices may be changed to fit field conditions as approved by the Engineer.
- No equipment, materials or vehicles shall be allowed to park in the buffer space.
- Furnish and utilize two (2) variable message board as directed by the Engineer.
- In lieu of 24 hours, 7 days per week flagger control at intersecting streets, restore 2-lane, 2-way traffic during non-working hours; Refer to note 13 of Plan Sht. No. 20.

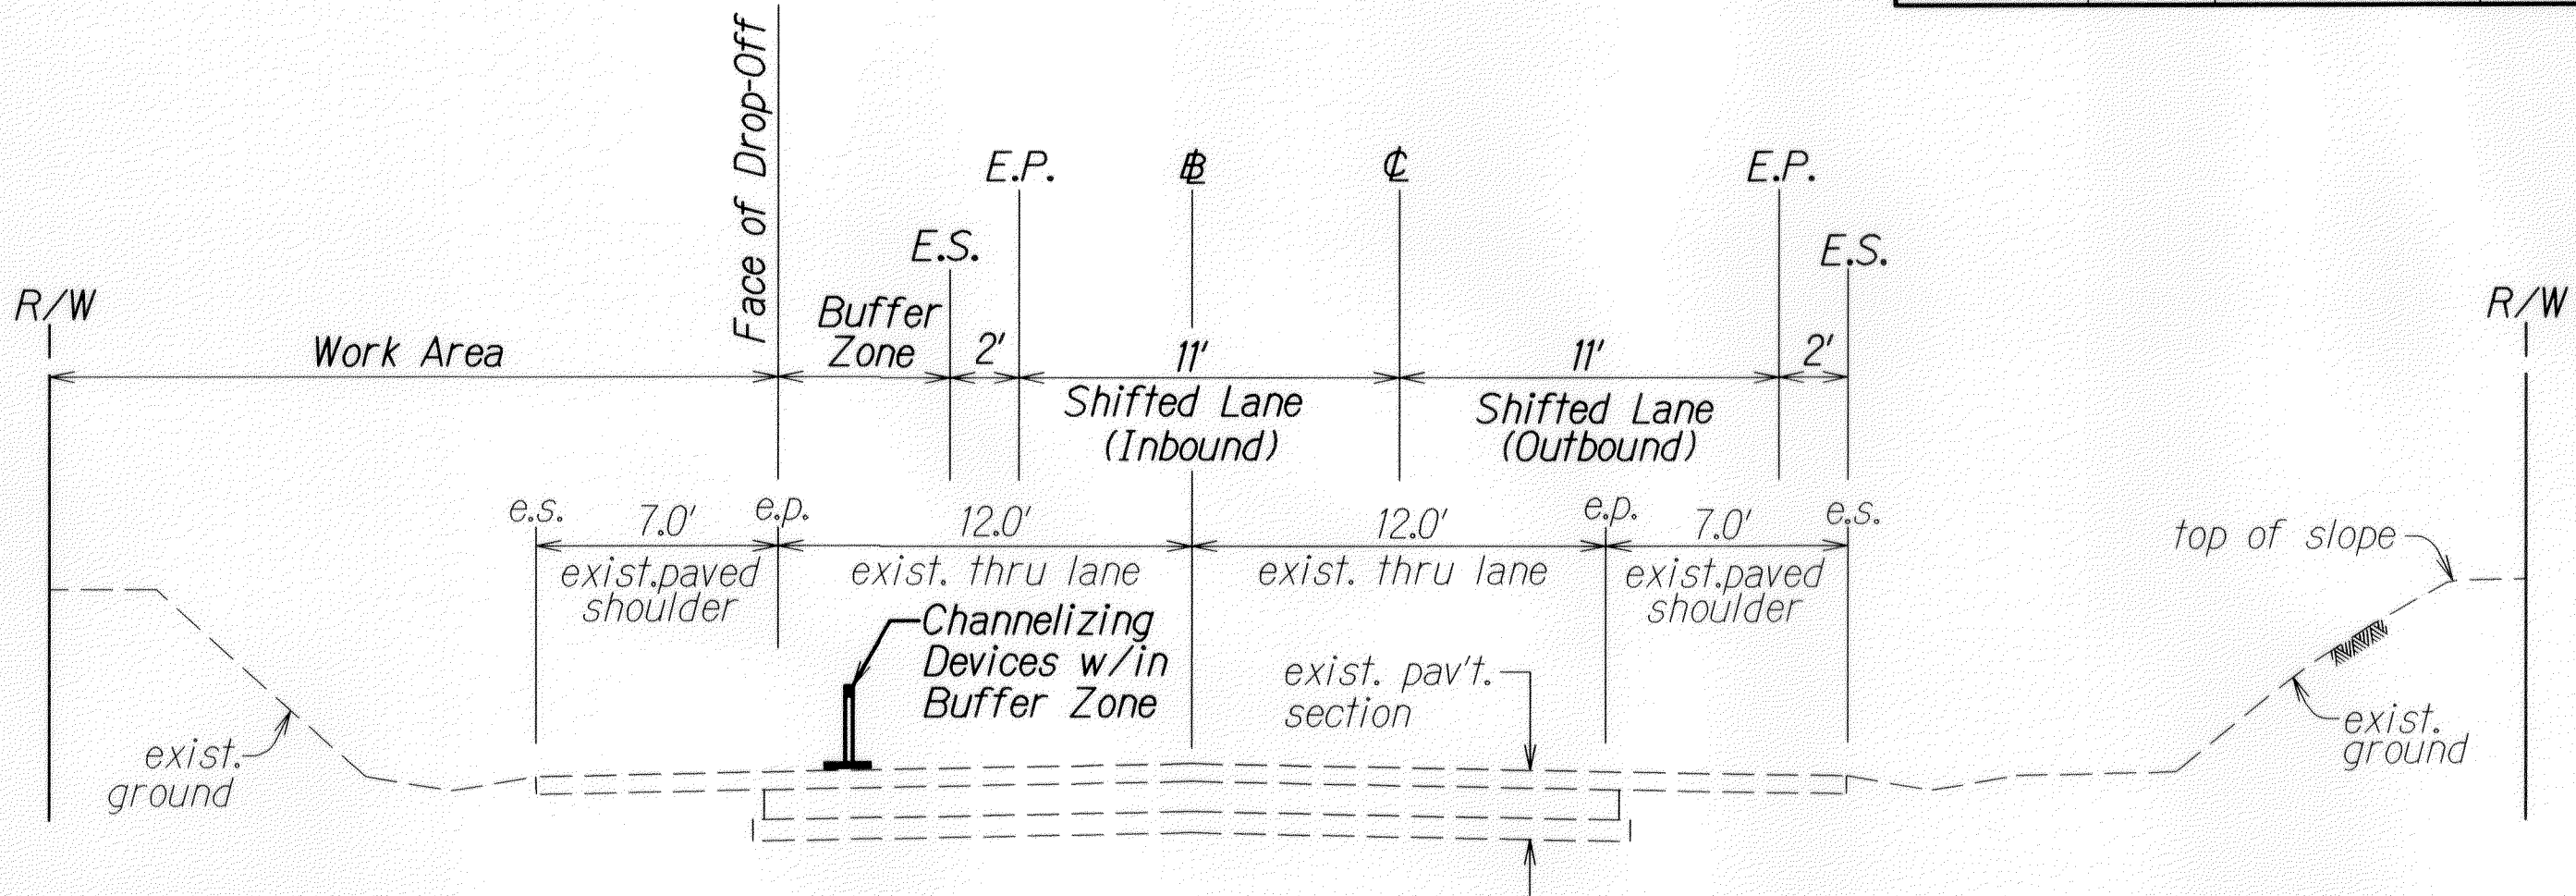

TYPICAL SECTION
Not to Scale

Install Flashing Yellow Beacon
w/ Solar Panel, Battery Pack
and Mounting Hardware

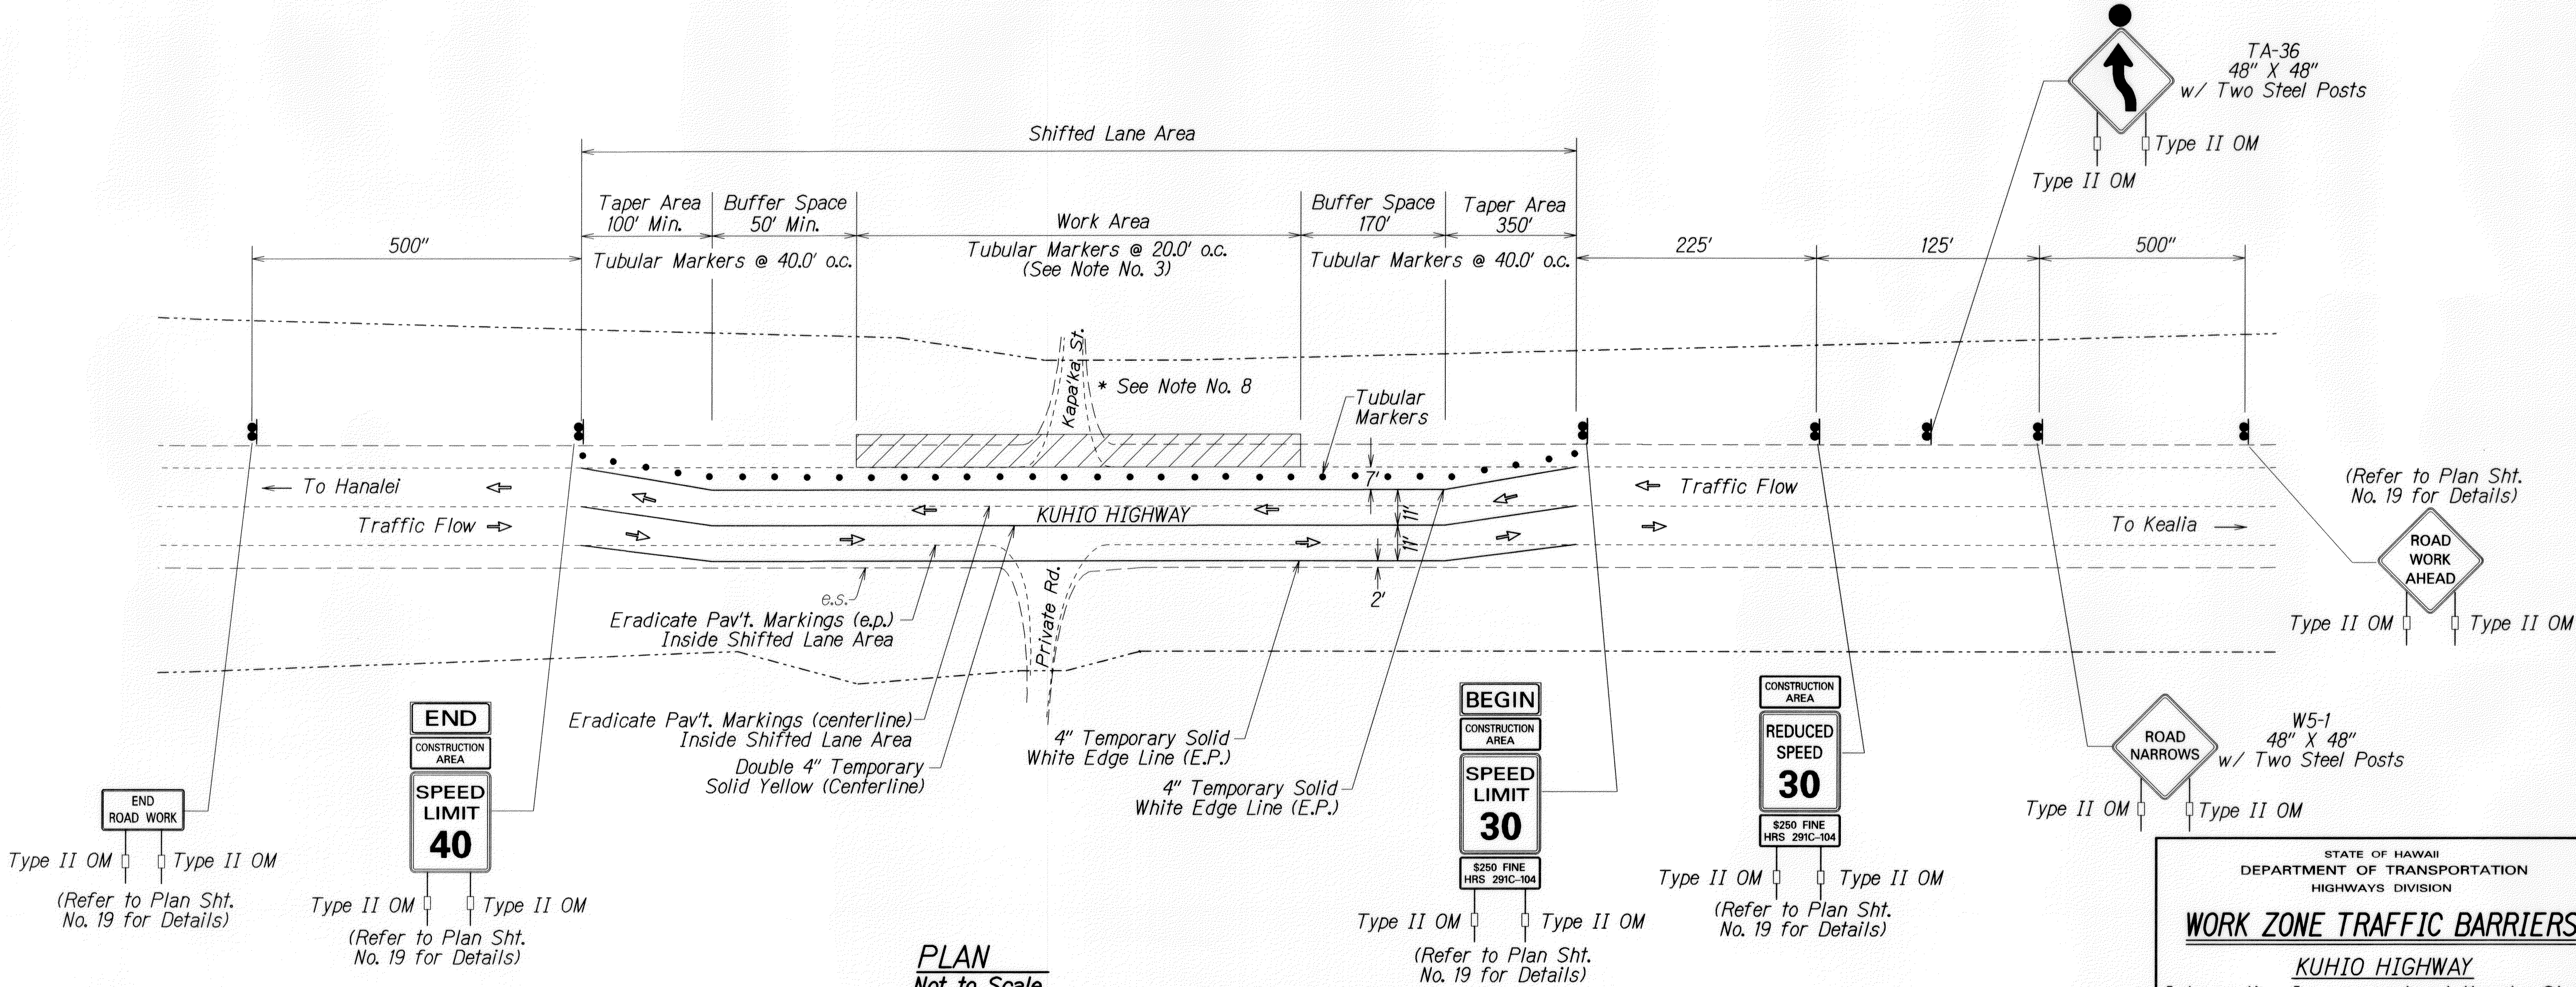

PLAN
Not to Scale

STATE OF HAWAII
DEPARTMENT OF TRANSPORTATION
HIGHWAYS DIVISION

WORK ZONE TRAFFIC BARRIERS
KUHIO HIGHWAY
Intersection Improvements at Kapaka Street
Project No. 56D-01-13

Not to Scale
Date: June 2013

SHEET No. 1 OF 1 SHEETS

SURVEY PLOTTED BY	DATE
DRAWN BY	
DESIGNED BY	
QUANTITIES BY	
CHECKED BY	
ORIGINAL PLAN	
NOTE BOOK	
NO.	