


FED. ROAD DIST. NO.	STATE	PROJ. NO.	FISCAL YEAR	SHEET NO.	TOTAL SHEETS
HAWAII	HAW.	56D-01-13	2013	18	23

TRUE NORTH  
SCALE: 1" = 40'

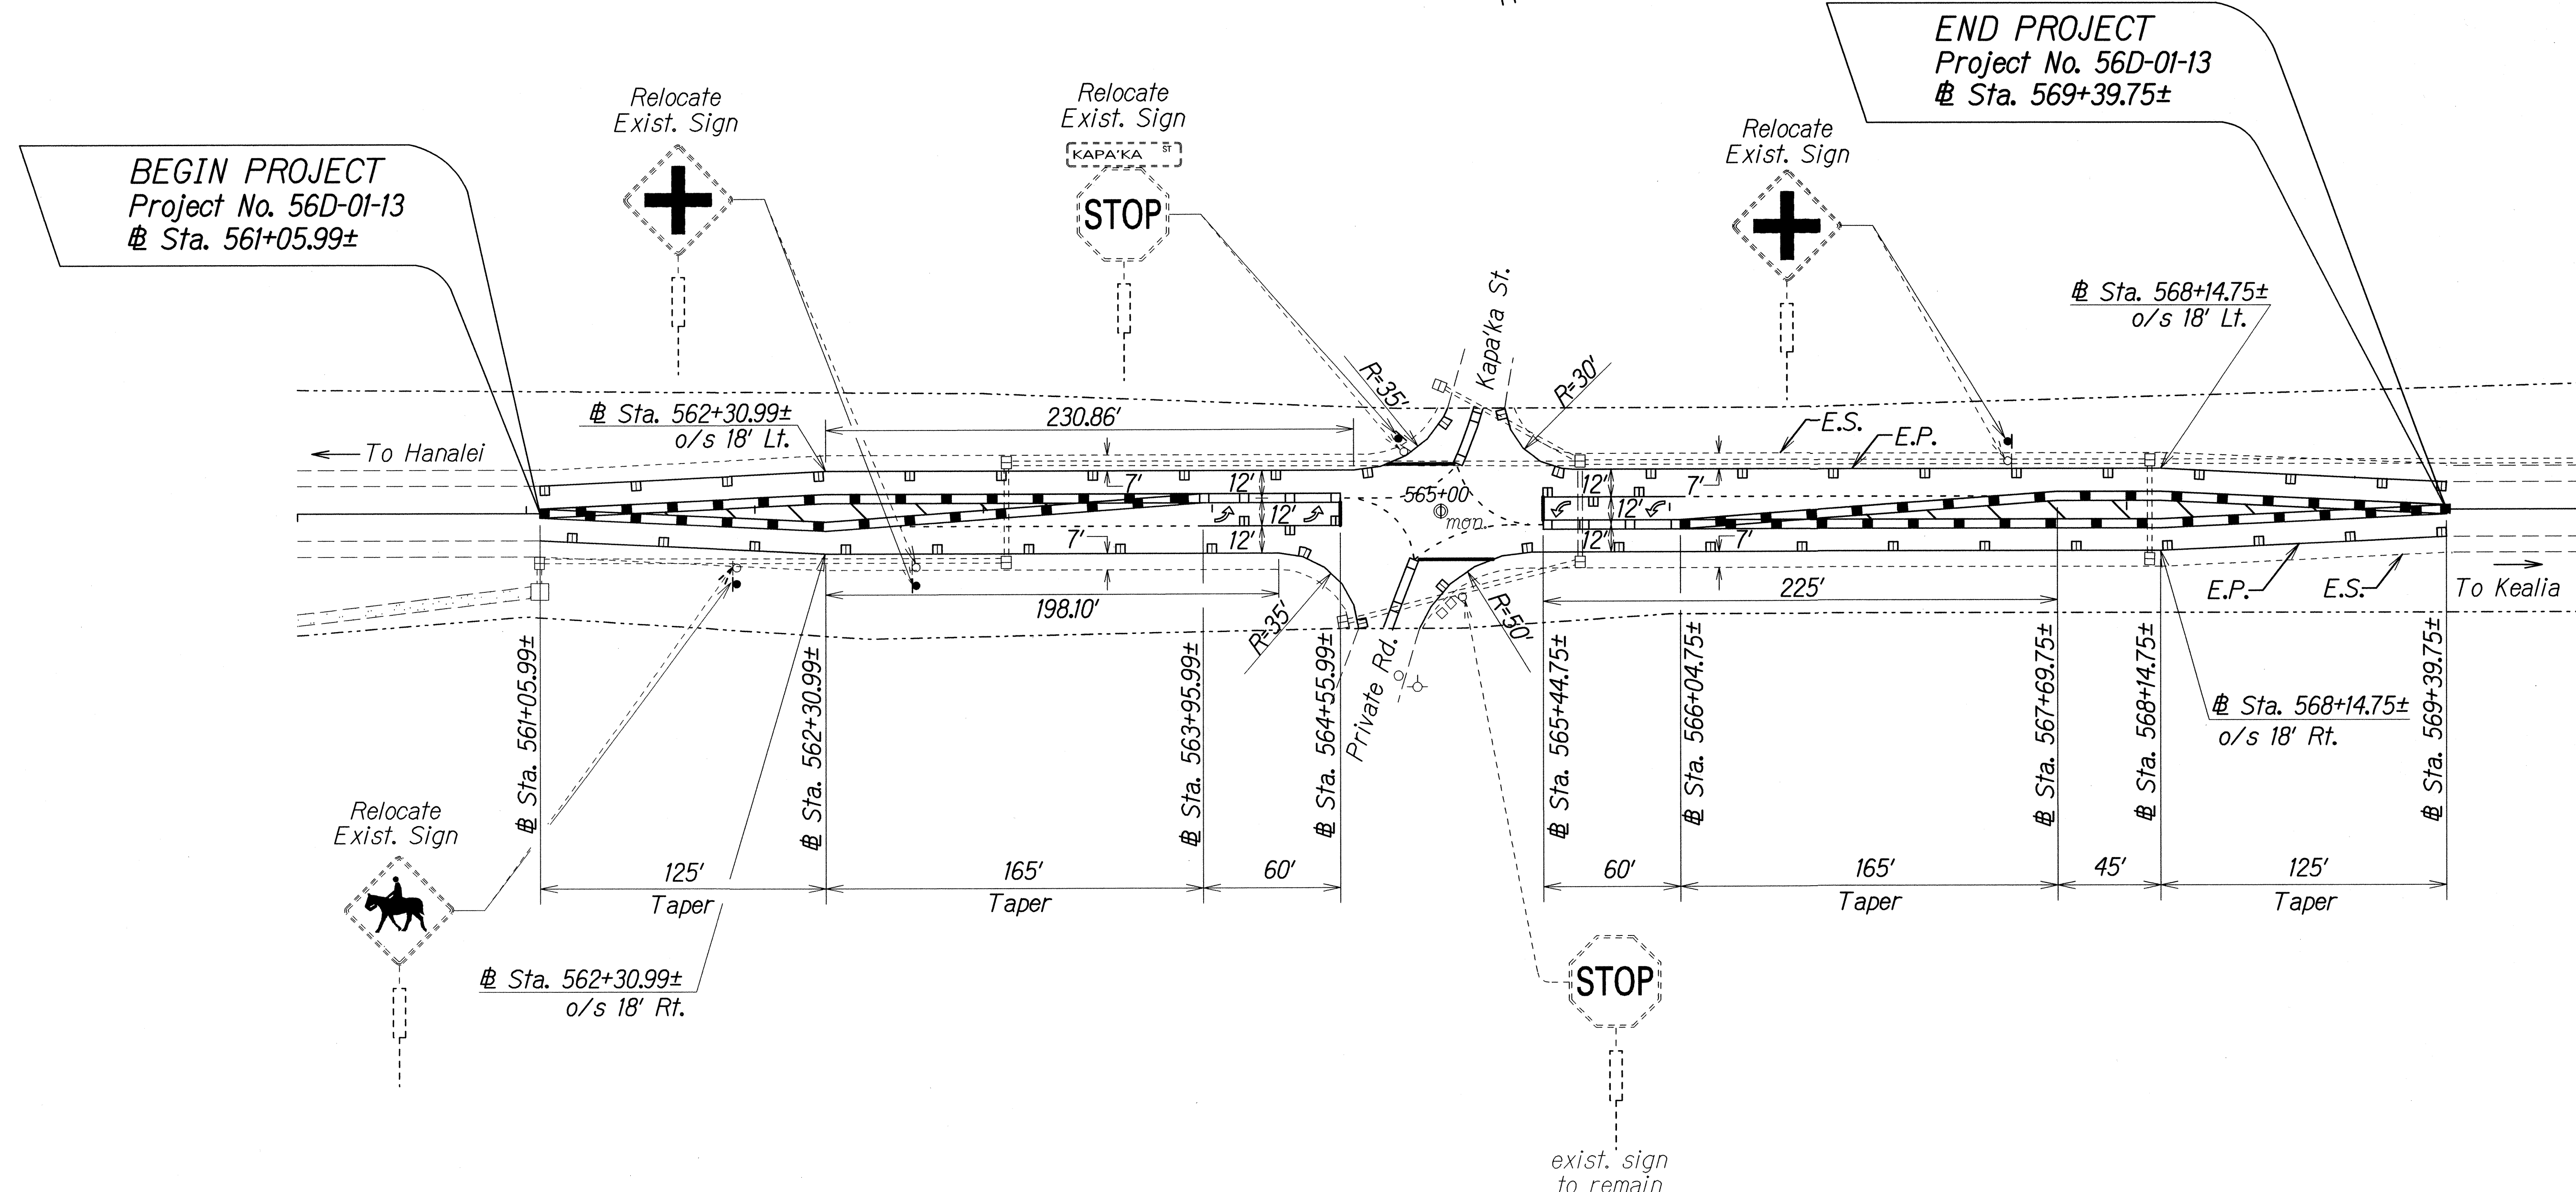

SURVEY PLOTTED BY	DATE
DESIGNED BY	
NOTED BY	
QUANTITIES BY	
CHECKED BY	

STATE OF HAWAII  
DEPARTMENT OF TRANSPORTATION  
HIGHWAYS DIVISION

**PAVEMENT MARKING**  
**TRAFFIC SIGNING PLAN**

KUHIO HIGHWAY  
Intersection Improvements at Kapaka Street  
Project No. 56D-01-13

Scale: 1" = 40'      Date: January 2013

SHEET No. T2 OF 4 SHEETS