


FED. ROAD DIST. NO.	STATE	PROJ. NO.	FISCAL YEAR	SHEET NO.	TOTAL SHEETS
HAWAII	HAW.	56D-01-13	2013	ADD. 15	23

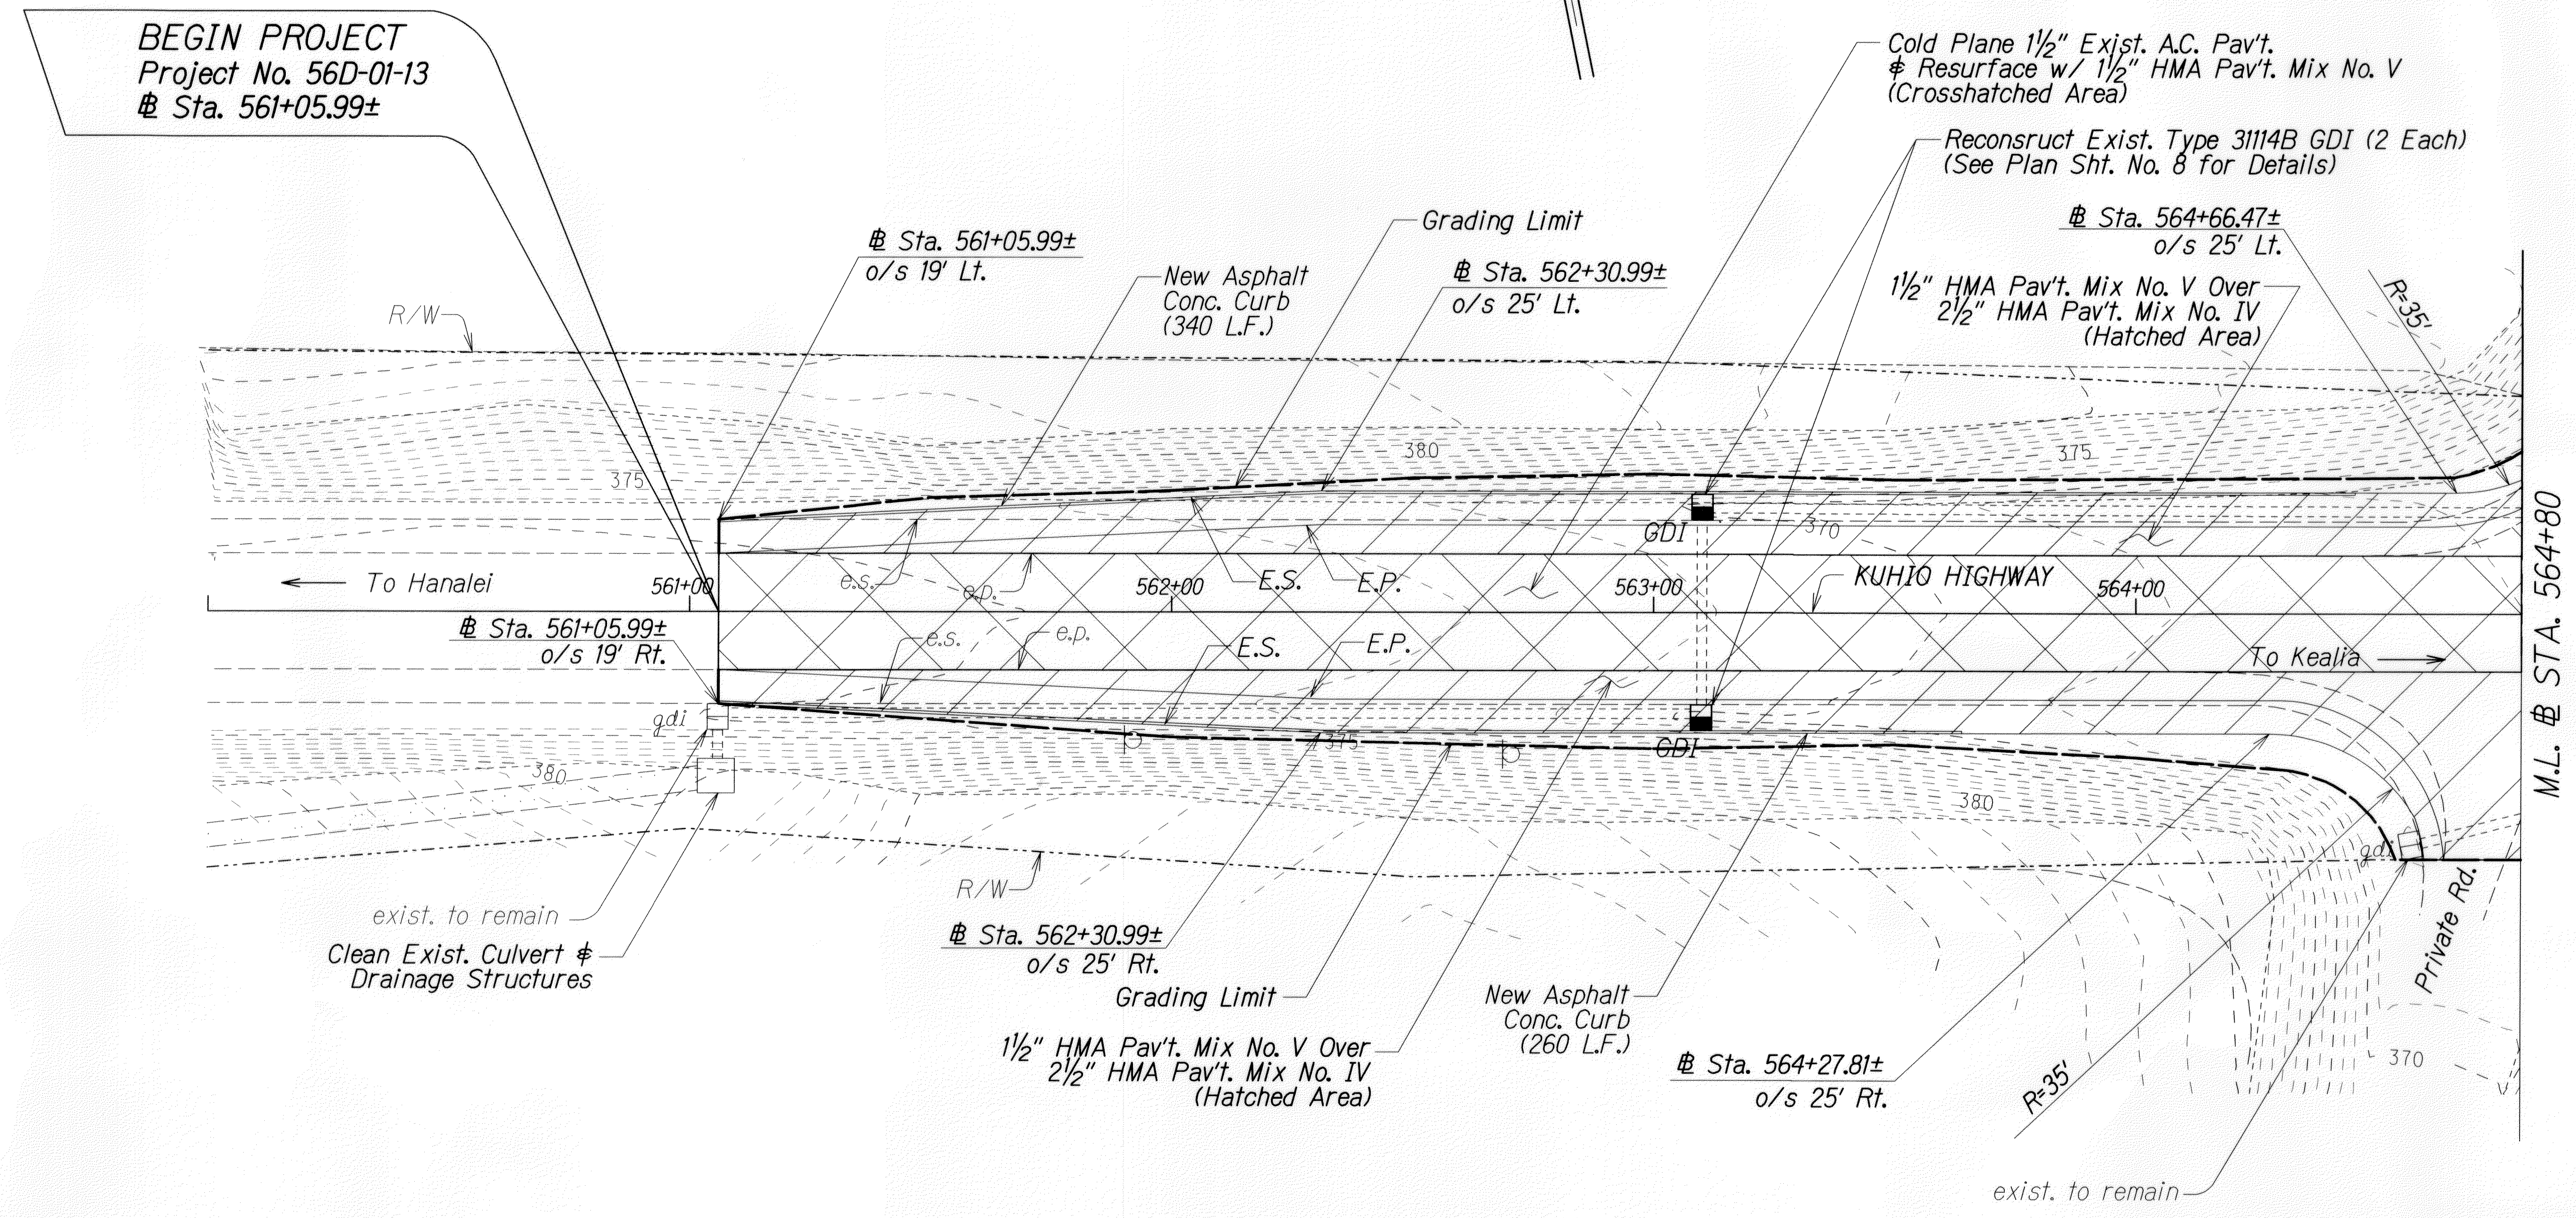

TRUE NORTH
SCALE: 1" = 20'


ORIGINAL PLAN	SURVEY PLOTTED BY	DATE
DRAWN BY		
NOTE BOOK		
QUANTITIES BY		
CHECKED BY		

Legend:
 — 1 1/2" Cold Plane (Crosshatched Area)

6/17/13	△ - Roadway Plan
DATE	REVISION
STATE OF HAWAII DEPARTMENT OF TRANSPORTATION HIGHWAYS DIVISION	
ROADWAY PLAN	
KUHIU HIGHWAY	
Intersection Improvements at Kapaka Street	
Project No. 56D-01-13	
Scale: 1" = 20'	Date: June 2013
SHEET No. 1 OF 2 SHEETS	

ADD. 15

FED. ROAD DIST. NO.	STATE	PROJ. NO.	FISCAL YEAR	SHEET NO.	TOTAL SHEETS
HAWAII	HAW.	56D-01-13	2013	ADD. 16	23

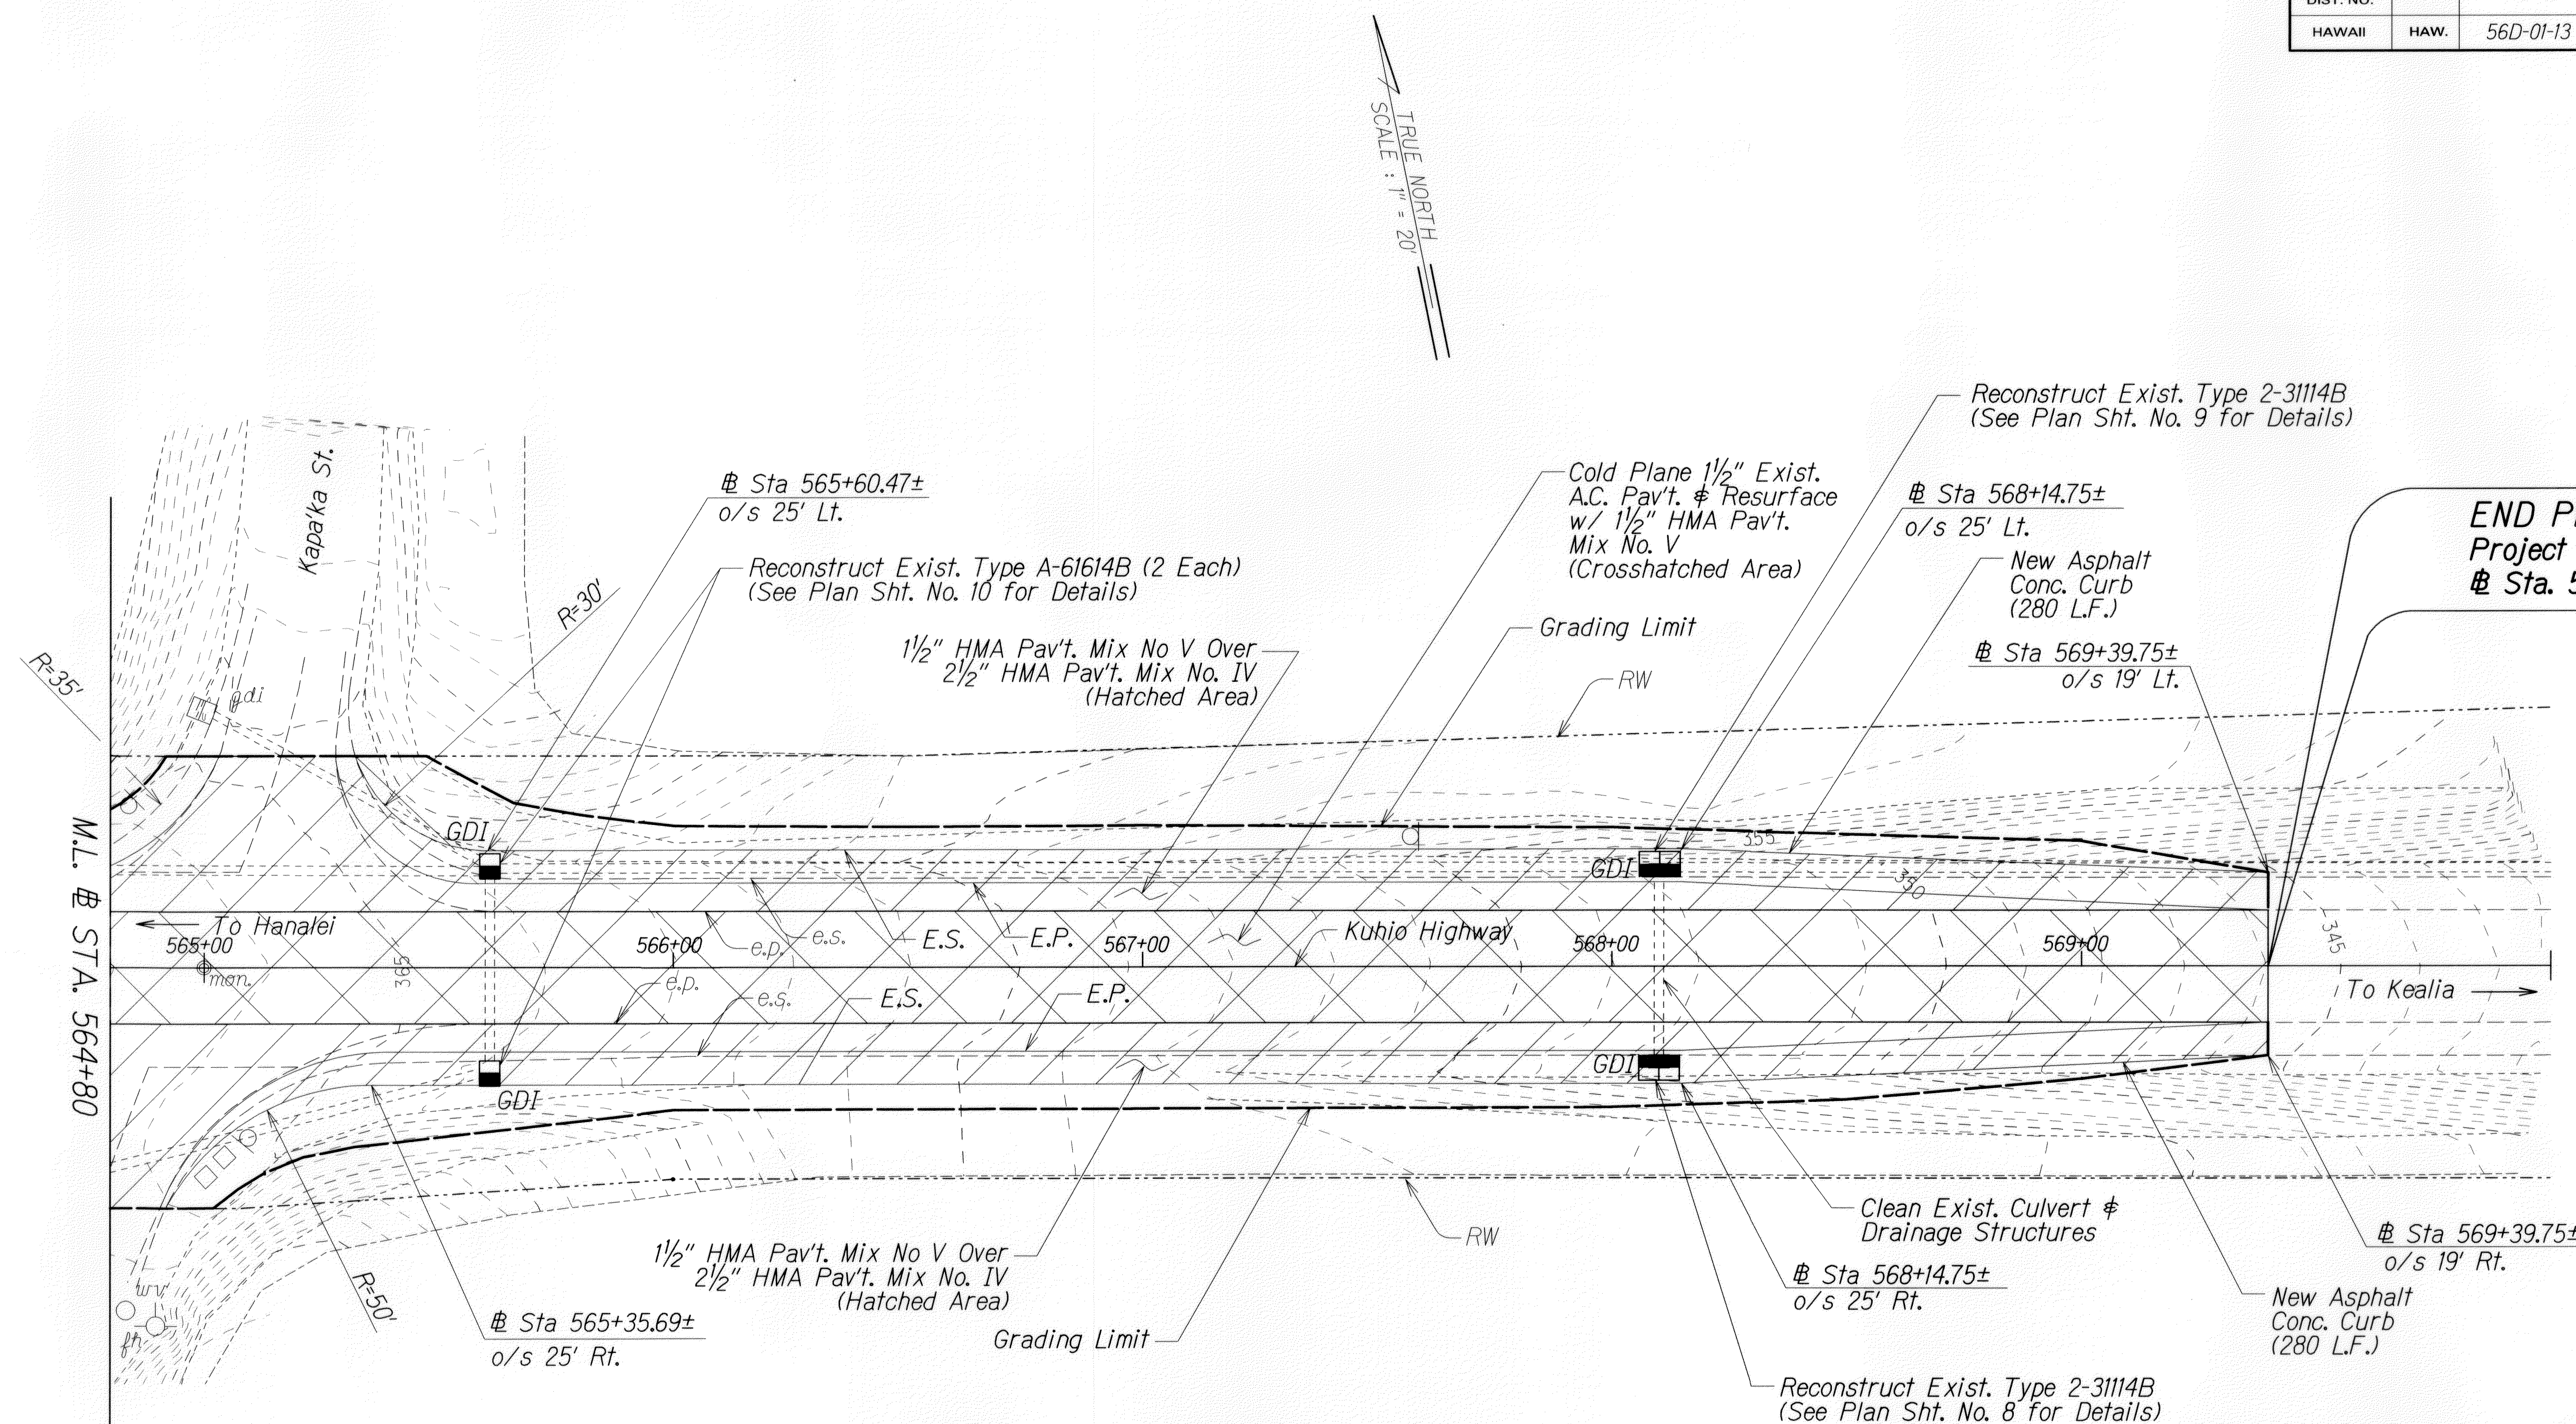

TRUE NORTH
SCALE : 1" = 20'

END PROJECT
Project No. 56D-01-13
Sta. 569+39.75±

DATE	_____
SURVEY PLOTTED BY	_____
DRAWN BY	_____
DESIGNED BY	_____
CHECKED BY	_____
ORIGINAL PLAN	_____
NOTE BOOK	_____
ADD. Design	_____

Legend:
 — 1 1/2" Cold Plane (Crosshatched Area)

6/17/13	△ - Roadway Plan
DATE	REVISION
STATE OF HAWAII DEPARTMENT OF TRANSPORTATION HIGHWAYS DIVISION ROADWAY PLAN <u>KUHIO HIGHWAY</u> <u>Intersection Improvements at Kapaka Street</u> <u>Project No. 56D-01-13</u> Scale: 1" = 20' Date: June 2013	
SHEET No. 2 OF 2 SHEETS	