

INDEX TO DRAWINGS	
SHEET NO.	DESCRIPTION
1	TITLE SHEET
2	STANDARD PLANS SUMMARY
3	GENERAL NOTES & LEGEND
4 - 5	WATER POLLUTION AND EROSION CONTROL NOTES
6 - 7	TYPICAL SECTIONS
8 - 11	MISCELLANEOUS DETAILS
12 - 13	PORTABLE CONCRETE BARRIER
14	GENERAL ROADWAY IMPROVEMENTS LAYOUT
15 - 16	ROADWAY PLAN
17	PAVEMENT MARKING, NOTES, LEGEND, AND SIGN DETAILS
18	PAVEMENT MARKING AND TRAFFIC SIGNING PLAN
19	HIGH SPEED UNDIVIDED HIGHWAY WORK ZONE SIGNING PLAN, NOTES & DETAILS
20	TRAFFIC CONTROL PLAN WITHIN COUNTY RIGHT-OF-WAY
21 - 23	CROSS-SECTIONS

STATE OF HAWAII

DEPARTMENT OF TRANSPORTATION

HIGHWAYS DIVISION

HONOLULU, HAWAII

"AS-BUILT"

PLANS FOR

KUHIO HIGHWAY

INTERSECTION IMPROVEMENTS


AT KAPA'KA STREET

PROJECT NO. 56D-01-13


DISTRICT OF HANAIEI

ISLAND OF KAUAI

FED. ROAD DIST. NO.	STATE	PROJ. NO.	FISCAL YEAR	SHEET NO.	TOTAL SHEETS
HAWAII	HAW.	56D-01-13	2013	1	23

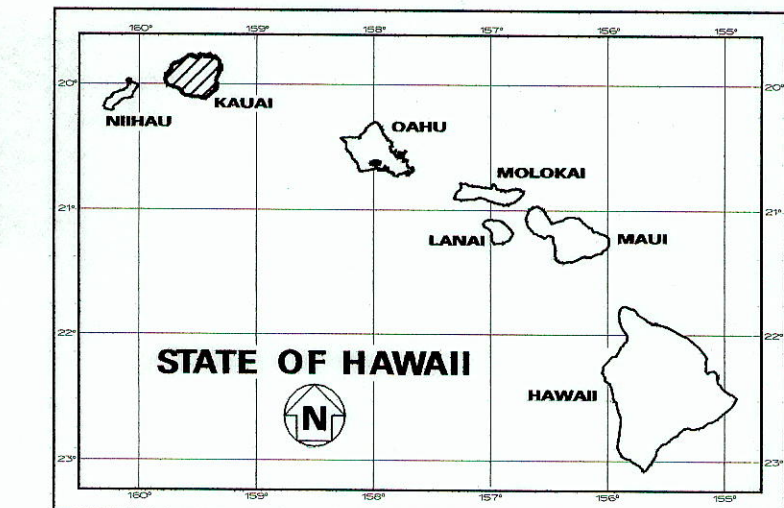

PROJECT LOCATION

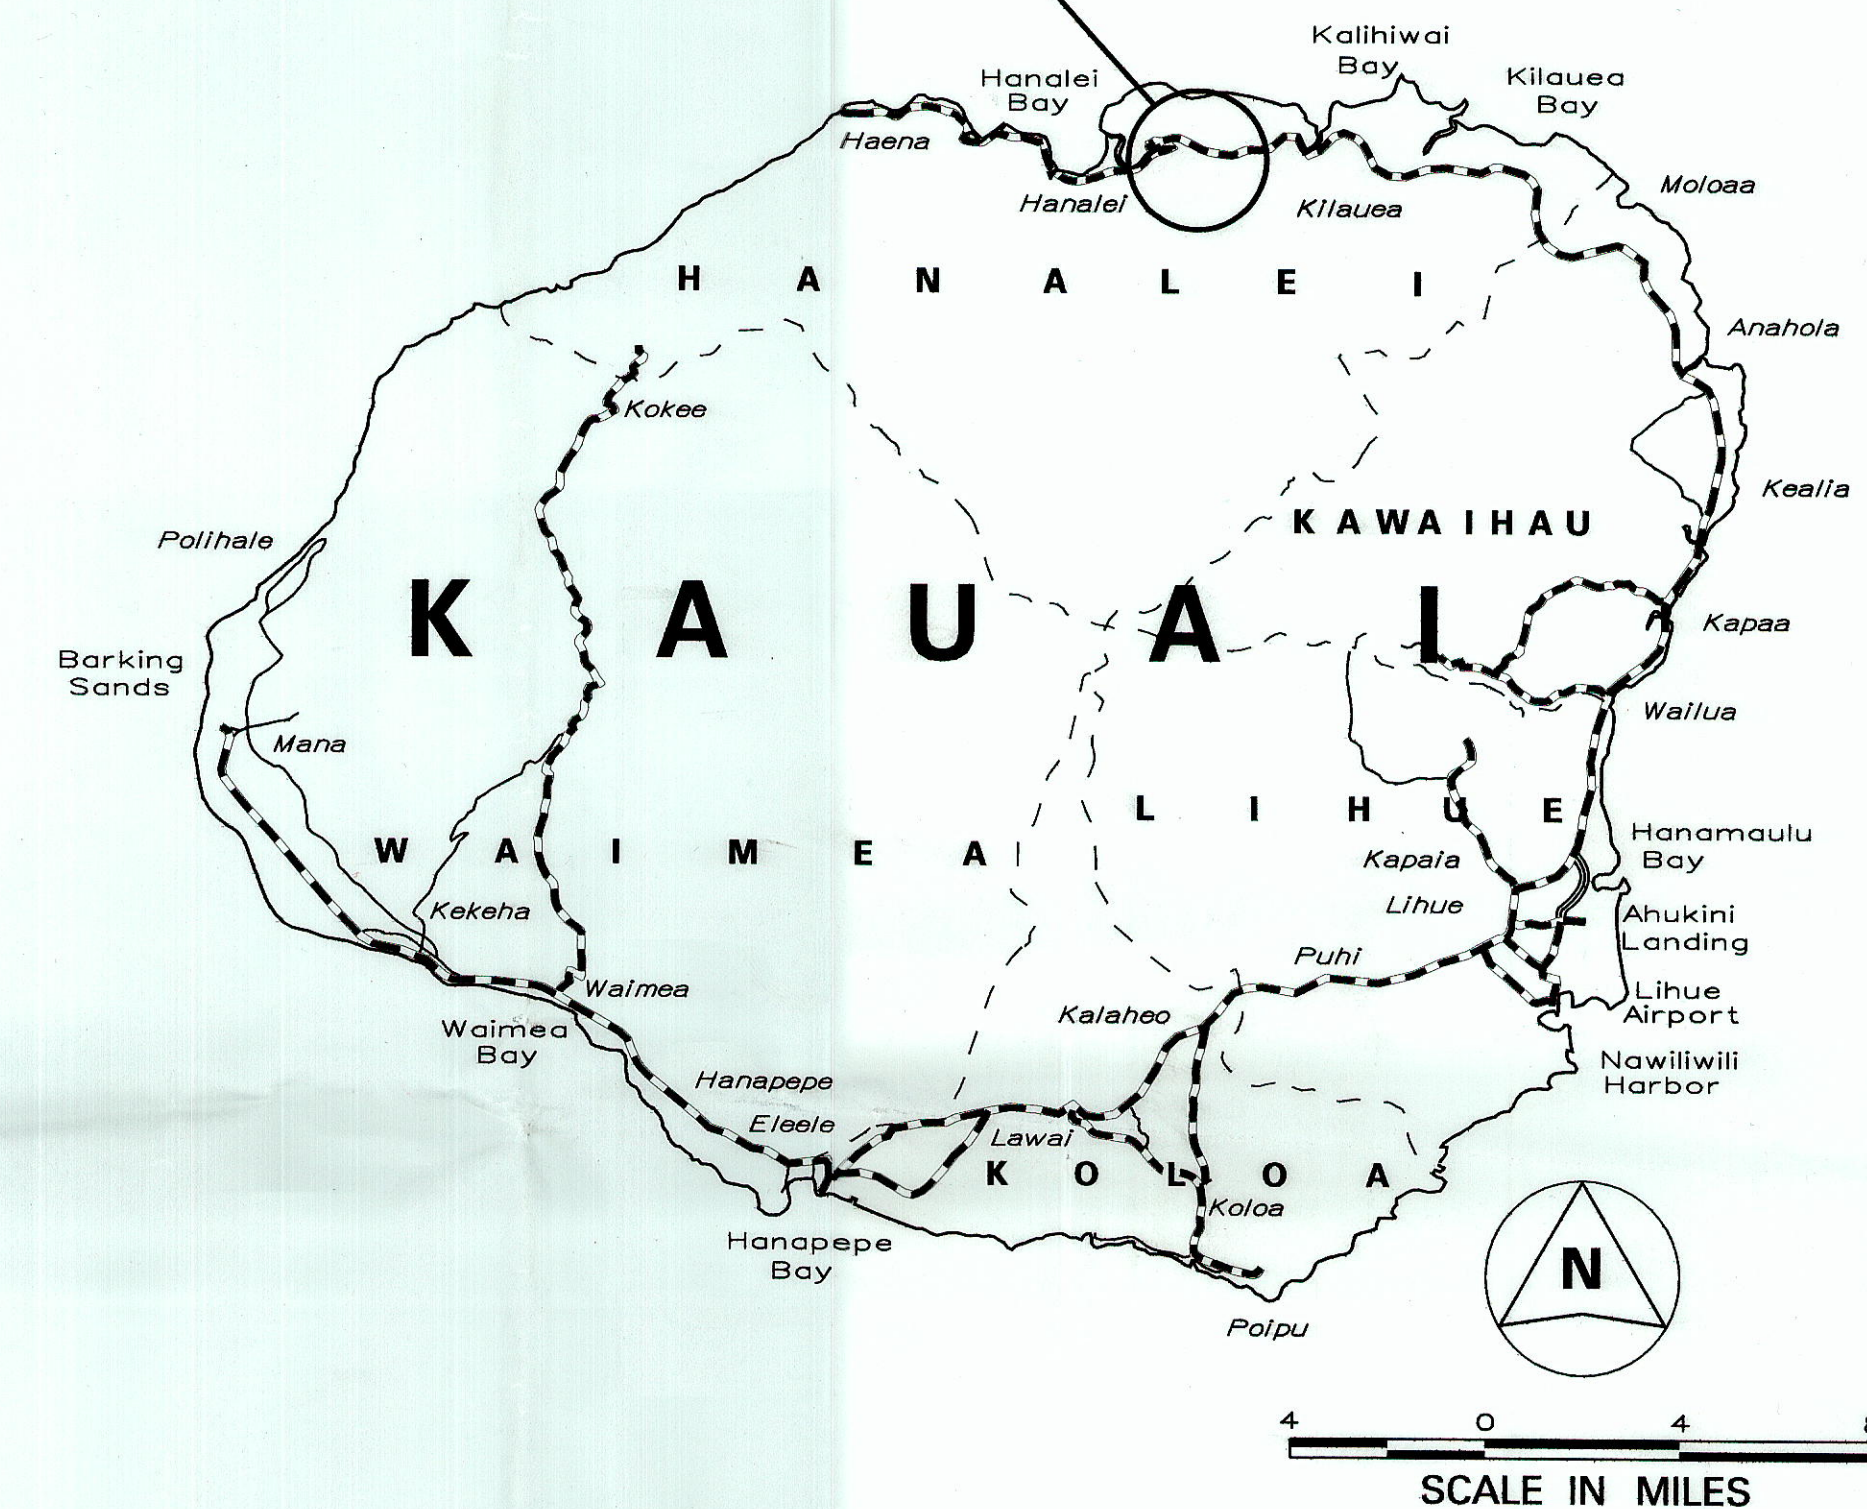

FEDERAL AID PROJECTS PREVIOUSLY CONSTRUCTED OR UNDER CONSTRUCTION

MILE POST 27.14 TO MILE POST 27.32

CHANGES MADE DURING CONSTRUCTION HAVE BEEN INCORPORATED ON THESE PLANS EXCEPT CHANGES IN THE ORIGINAL THEORETICAL QUANTITIES. FOR ACTUAL QUANTITIES, REFER TO PROJECT LEDGER AND/OR COMPUTATION BOOK.

Shirley K. King 7/16/15
RESIDENT ENGINEER DATE

DEPARTMENT OF TRANSPORTATION
STATE OF HAWAII

APPROVED:
Arina J. J. J. 4/11/13
for DIR. OF TRANSPORTATION DATE

HWY-K DESIGNED BY
HWY-KE MANAGED BY
241-3000 PHONE
APRIL 2013 DATE

