




**△ COLD PLANED TRANSITION TO EXISTING A.C. PAVEMENT AT THE BEGINNING AND END OF PROJECT**  
Not to Scale

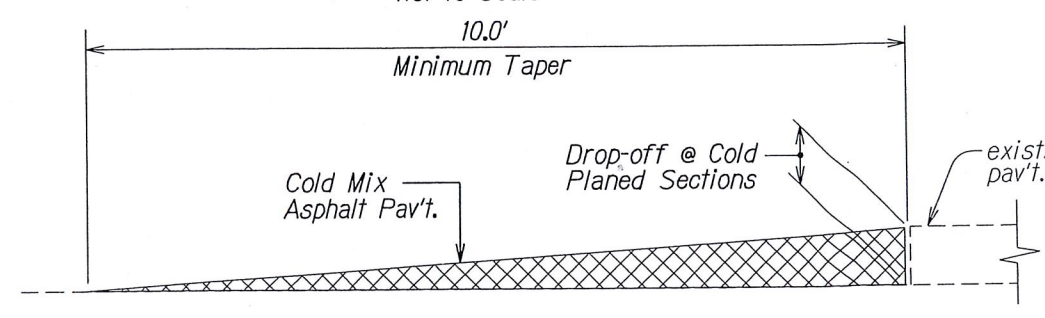

**△ RESURFACING AT GUARDRAIL**  
Not to Scale

**△ TEMPORARY TRANSITION AT COLD PLANED AREAS**  
Not to Scale

Note: Contractor shall construct temporary pavement taper to prevent sharp pavement drop-offs at all cold planed sections. Prior to final Hot Mix Asphalt Pavement, Mix No. IV placement, temporary pavement taper shall be removed.

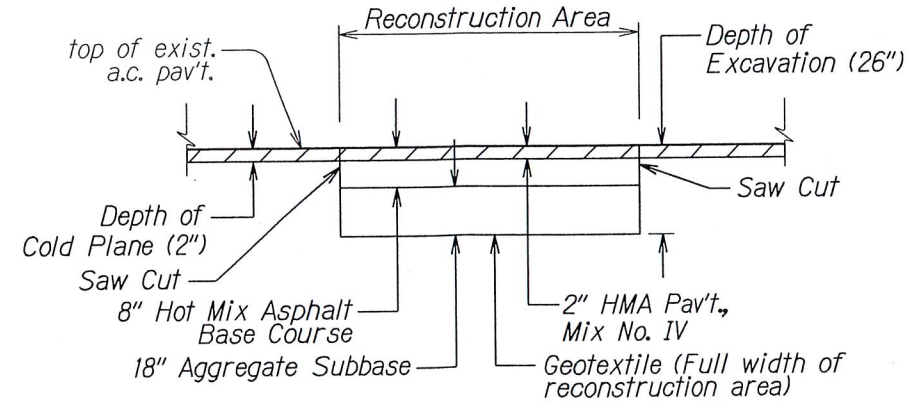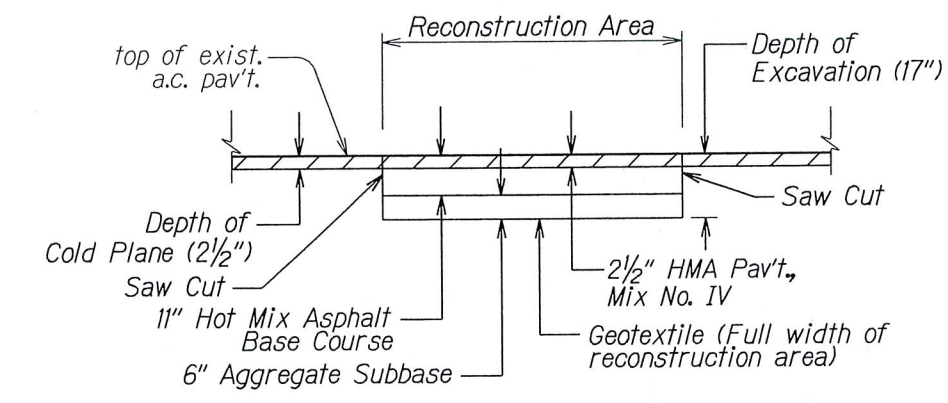

**△△ A.C. PAVEMENT RECONSTRUCTION DETAIL**  
Sta. 97+75.91 TO Sta. 139+00  
Not to Scale

**△△ A.C. PAVEMENT RECONSTRUCTION DETAIL**  
Sta. 139+00 TO Sta. 144+50  
Not to Scale

- Note:
1. Reconstruct weakened pavement areas prior to cold plane.
  2. Excavation to the full depth of reconstruction areas (17 inches) shall be paid for under Item No. 414.0110 - Excavation of Weakened Pavement Areas and shall not be paid separately.

- Note:
1. Reconstruct weakened pavement areas prior to cold plane.
  2. Excavation to the full depth of reconstruction areas (26 inches) shall be paid for under Item No. 414.0110 - Excavation of Weakened Pavement Areas and shall not be paid separately.

June 6, 2013	△ A.C. Pavement Reconstruction Details and Notes
May 13, 2013	△ Resurfacing at Guardrail
May 13, 2013	△ Cold Planed Transition at the Beginning and End of Project
May 13, 2013	△ A.C. Pavement Reconstruction Details and Notes
DATE	REVISION
STATE OF HAWAII DEPARTMENT OF TRANSPORTATION HIGHWAYS DIVISION	
<b>TYPICAL SECTIONS</b>	
KUHIU HIGHWAY RESURFACING Hardy Street to Vicinity of Laukini Road Project No. 56A-01-13M	
Not to Scale	Date: May 2013
SHEET No. 4 OF 4 SHEETS	