

INDEX TO DRAWINGS	
SHEET NO.	DESCRIPTION
1	TITLE SHEET
2	STANDARD PLANS SUMMARY
3	GENERAL NOTES & LEGEND
4 - 5	WATER POLLUTION AND EROSION CONTROL NOTES
6 - 9	TYPICAL SECTIONS
10 - 12	ROADWAY PLAN
13	PAVEMENT MARKING, NOTES, LEGEND, AND SIGN DETAILS
14 - 16	PAVEMENT MARKING AND TRAFFIC SIGNING PLAN
17	SIGN DETAILS
18 - 22	LOOP DETECTOR PLAN
23	LOW SPEED UNDIVIDED HIGHWAY WORK ZONE SIGNING PLAN, NOTES & DETAILS
24	TRAFFIC CONTROL PLAN WITHIN COUNTY RIGHT-OF-WAY

STATE OF HAWAII

DEPARTMENT OF TRANSPORTATION

HIGHWAYS DIVISION

HONOLULU, HAWAII

"AS-BUILT"

PLANS FOR


KUHIO HIGHWAY RESURFACING

HARDY STREET TO VICINITY OF LAUKINI ROAD



PROJECT NO. 56A-01-13M

DISTRICT OF LIHUE

ISLAND OF KAUAI

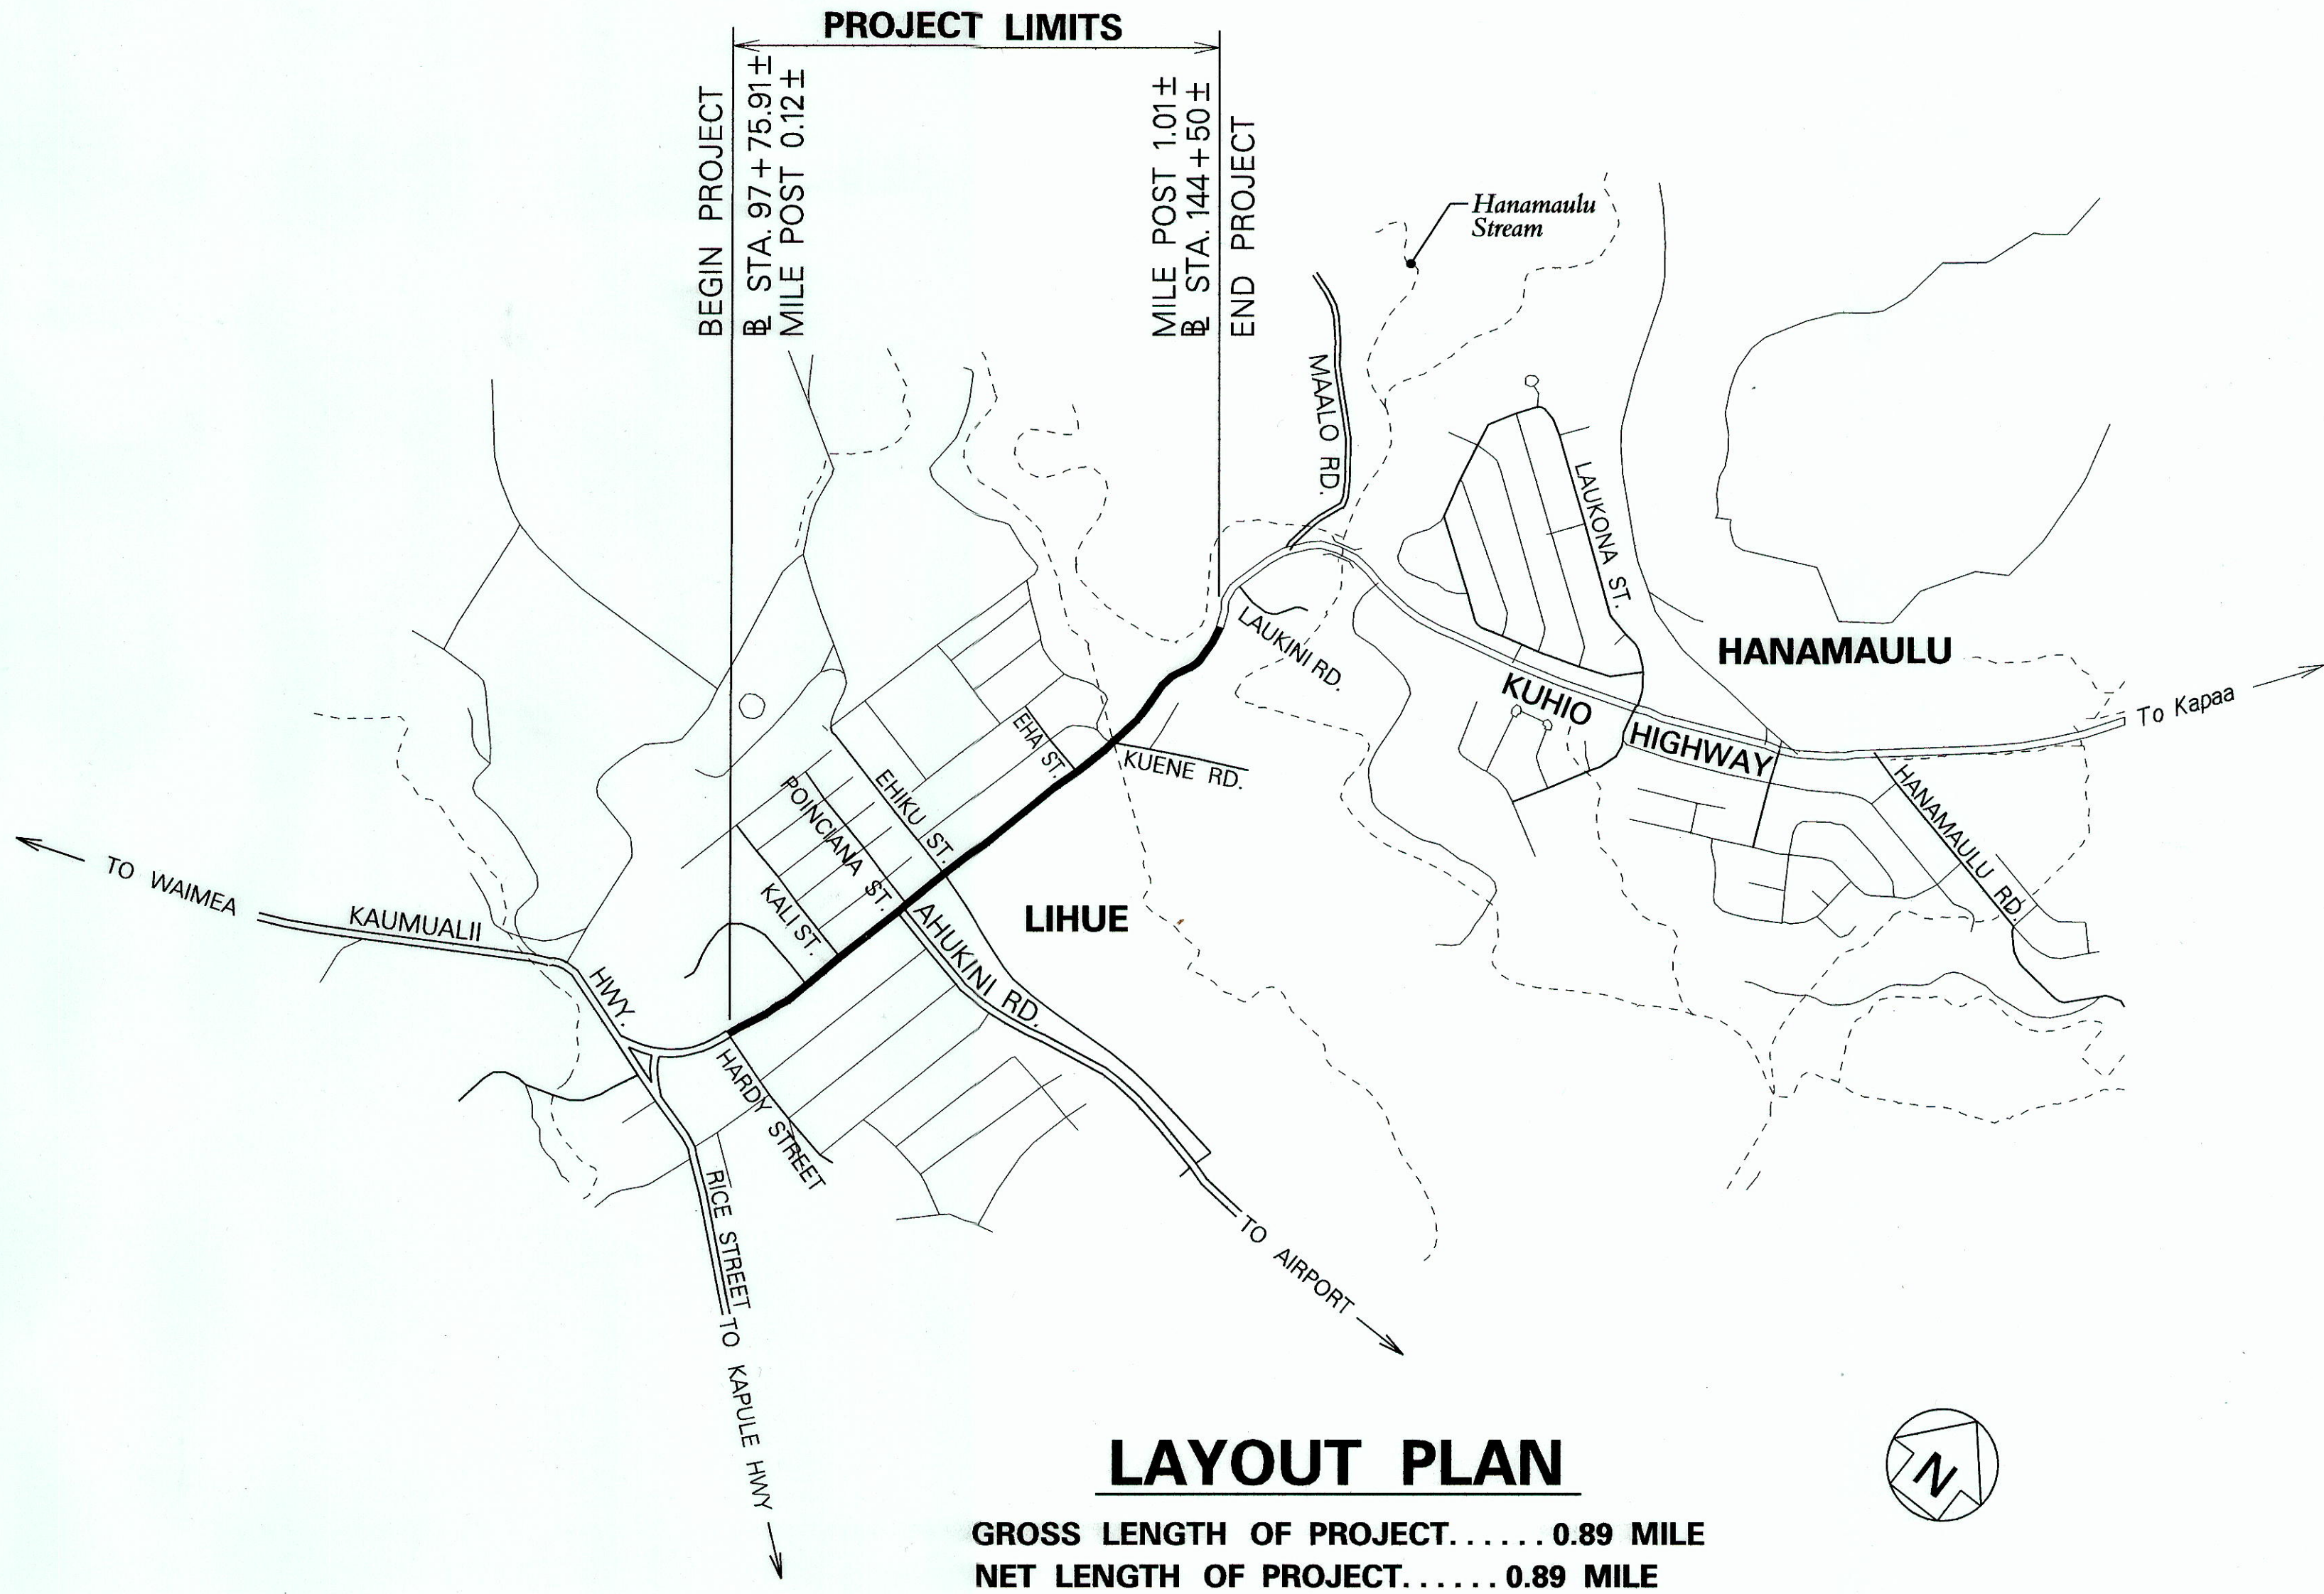

FED. ROAD DIST. NO.	STATE	PROJ. NO.	FISCAL YEAR	SHEET NO.	TOTAL SHEETS
HAWAII	HAW.	56A-01-13M	2013	1	24

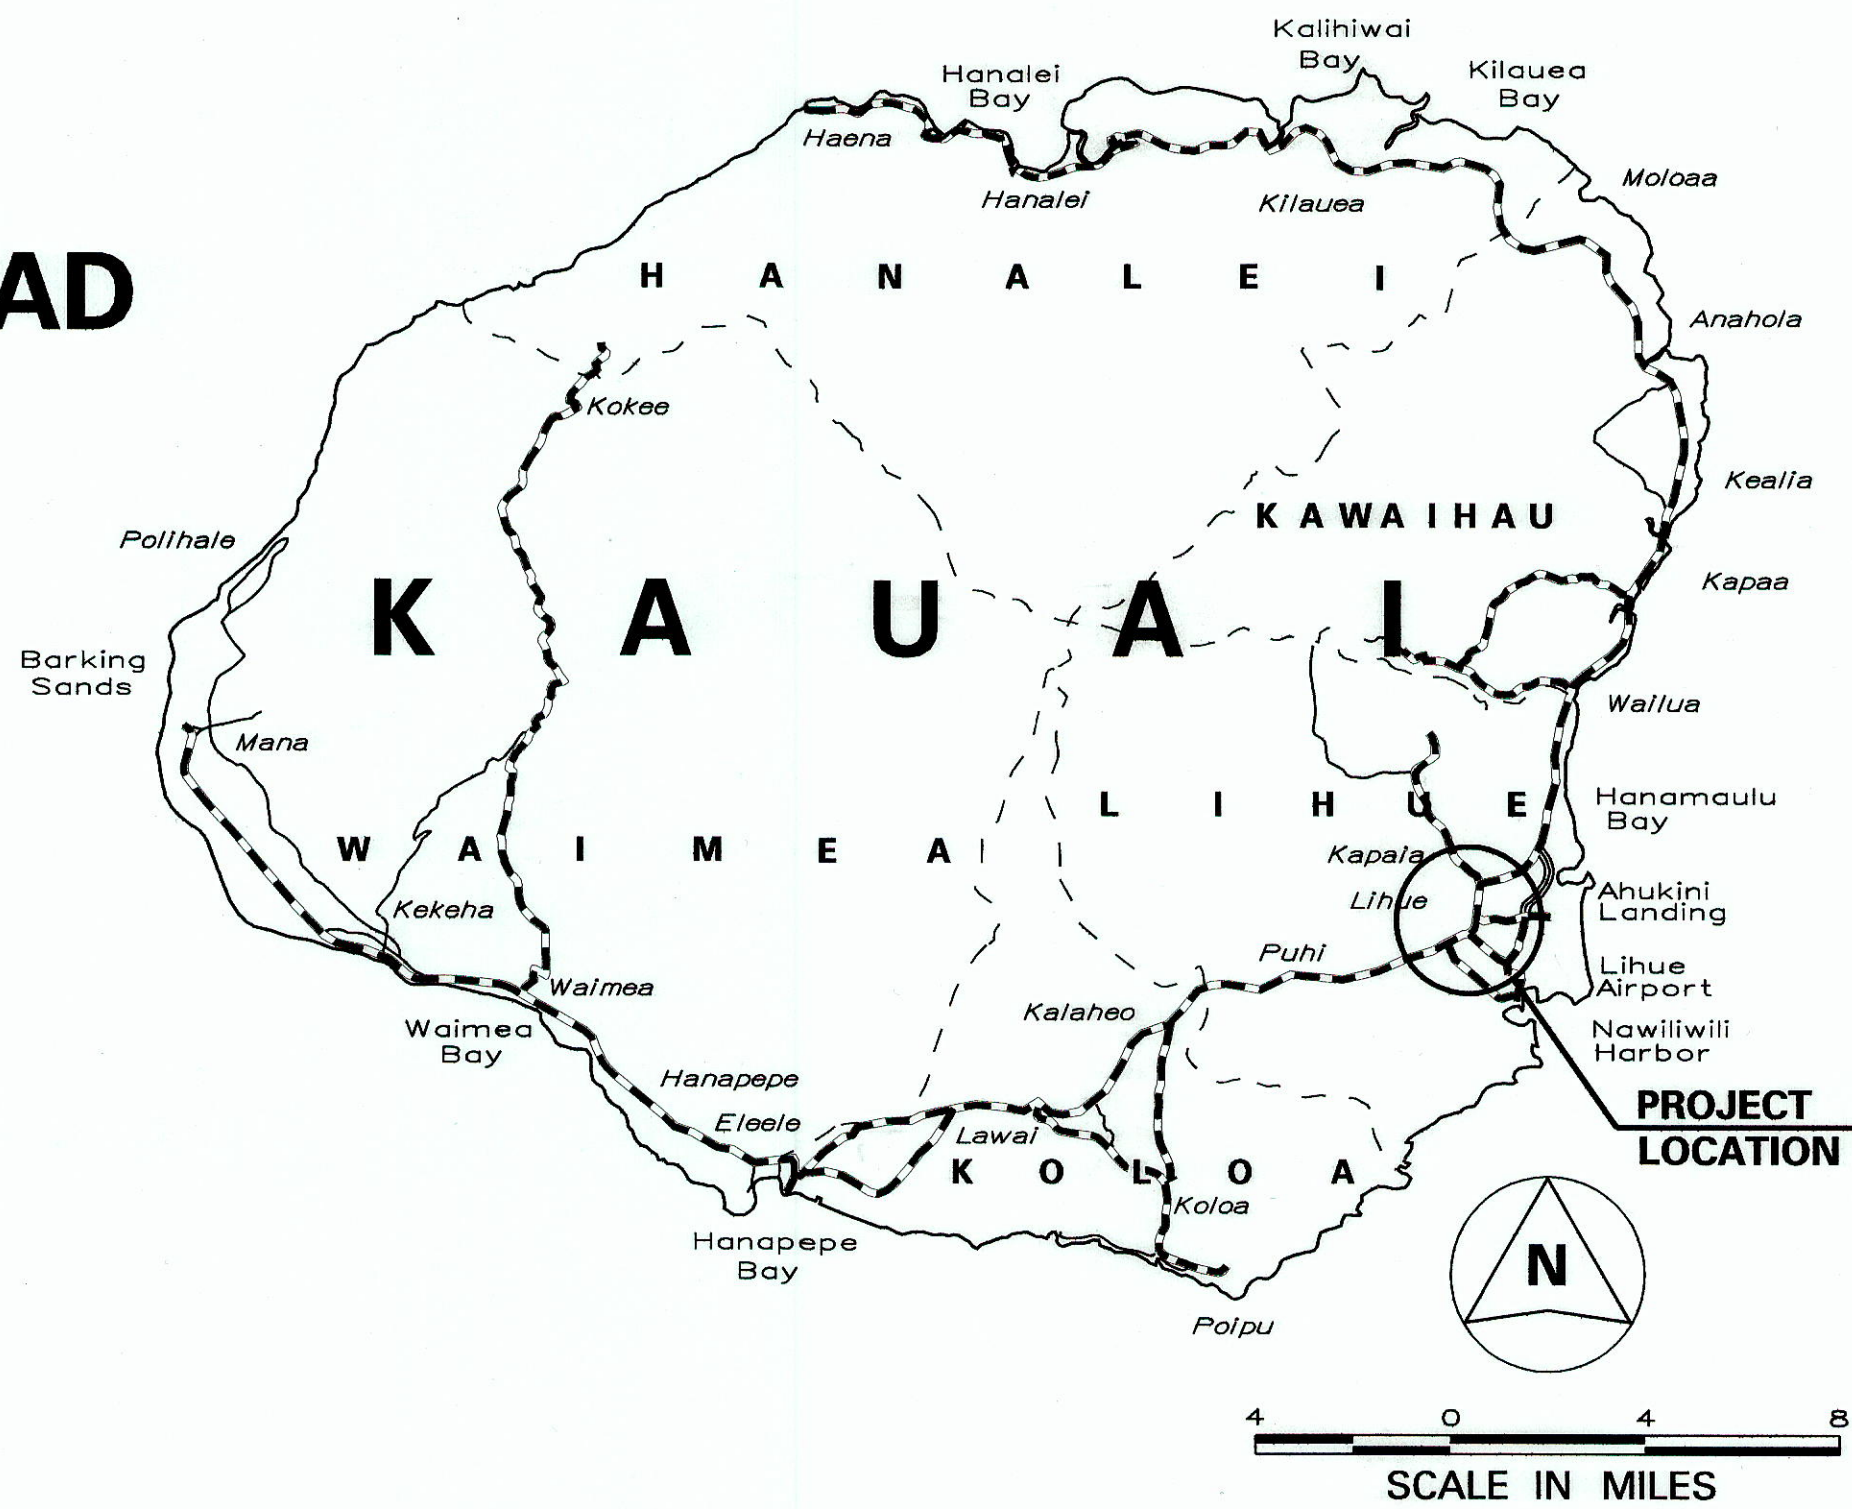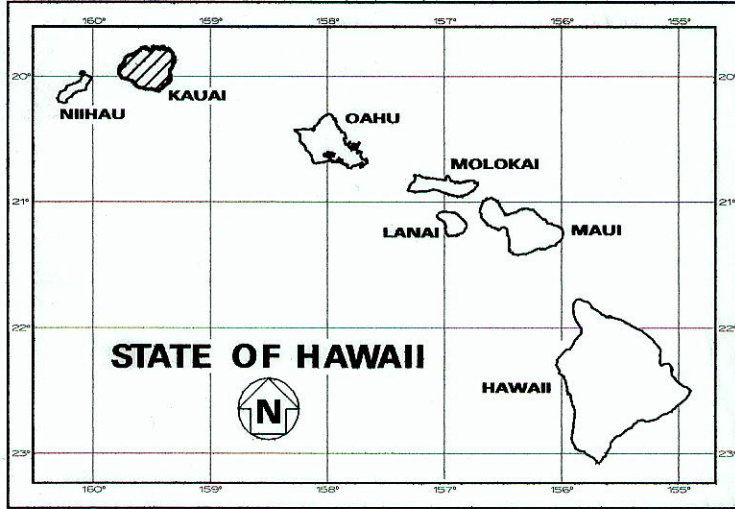

----- FEDERAL AID PROJECTS PREVIOUSLY CONSTRUCTED OR UNDER CONSTRUCTION

MILE POST 0.12 TO MILE POST 1.01

CHANGES MADE DURING CONSTRUCTION HAVE BEEN INCORPORATED ON THESE PLANS EXCEPT CHANGES IN THE ORIGINAL THEORETICAL QUANTITIES. FOR ACTUAL QUANTITIES, REFER TO PROJECT LEADER AND/OR COMPUTATION BOOK.

RESIDENT ENGINEER 7/7/16 DATE

DEPARTMENT OF TRANSPORTATION
 STATE OF HAWAII
 APPROVED: *[Signature]* 3/27/13
 for DIR. OF TRANSPORTATION DATE

DESIGNED BY
 HWY-K
 MANAGED BY
 HWY-KE
 241-3000 PHONE
 April 2013 DATE