
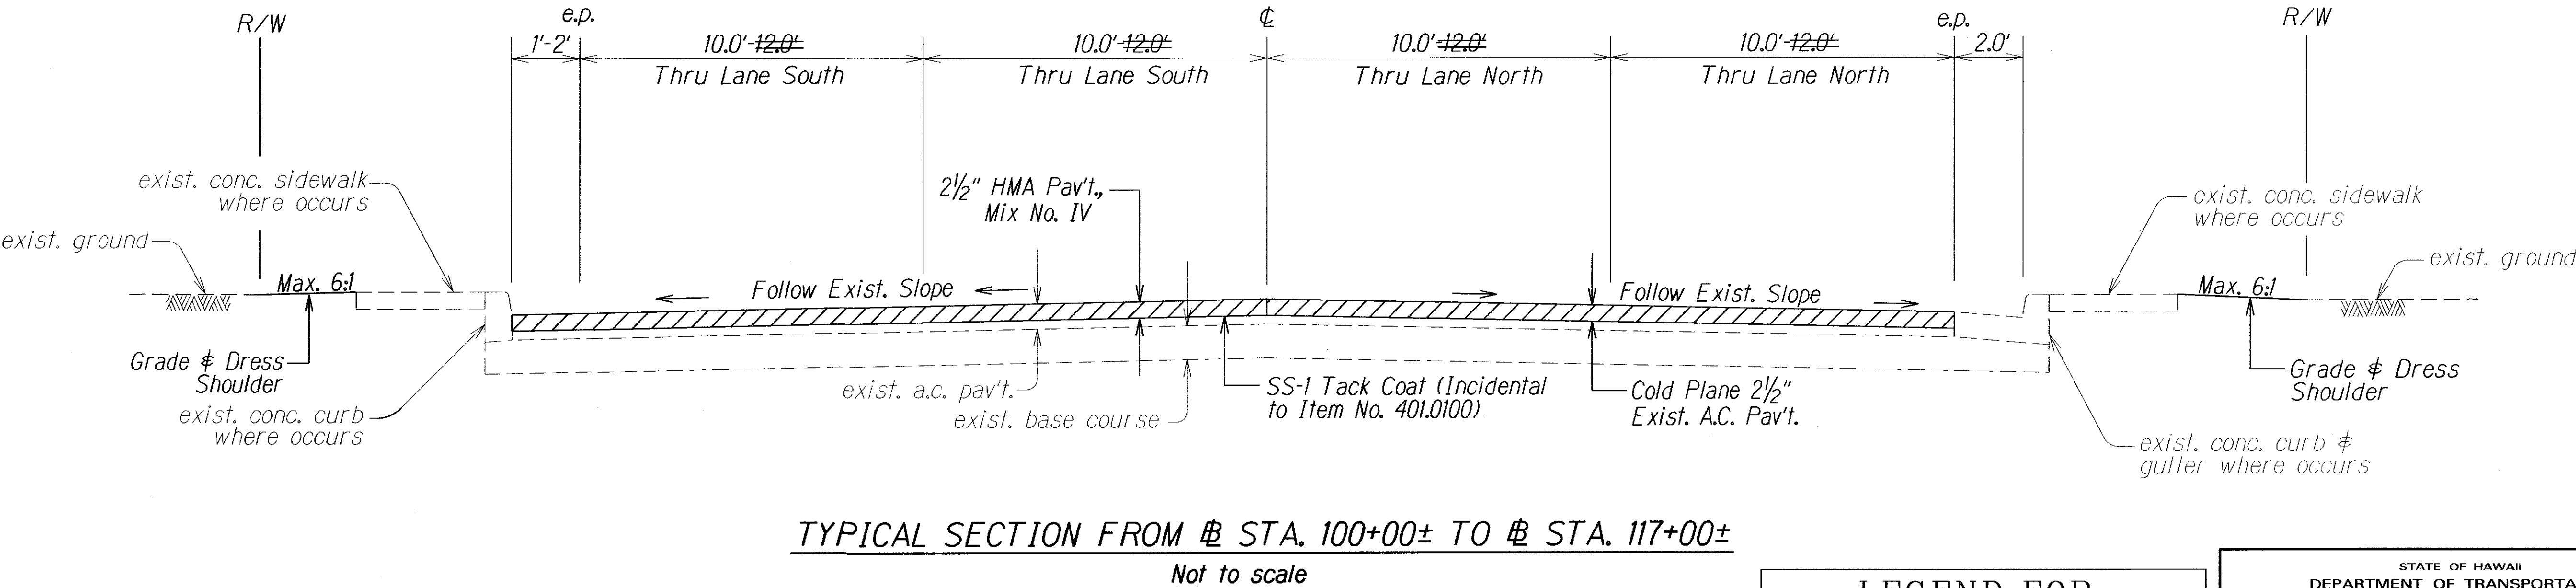


FED. ROAD DIST. NO.	STATE	PROJ. NO.	FISCAL YEAR	SHEET NO.	TOTAL SHEETS
HAWAII	HAW.	56A-01-13M	2013	6	24

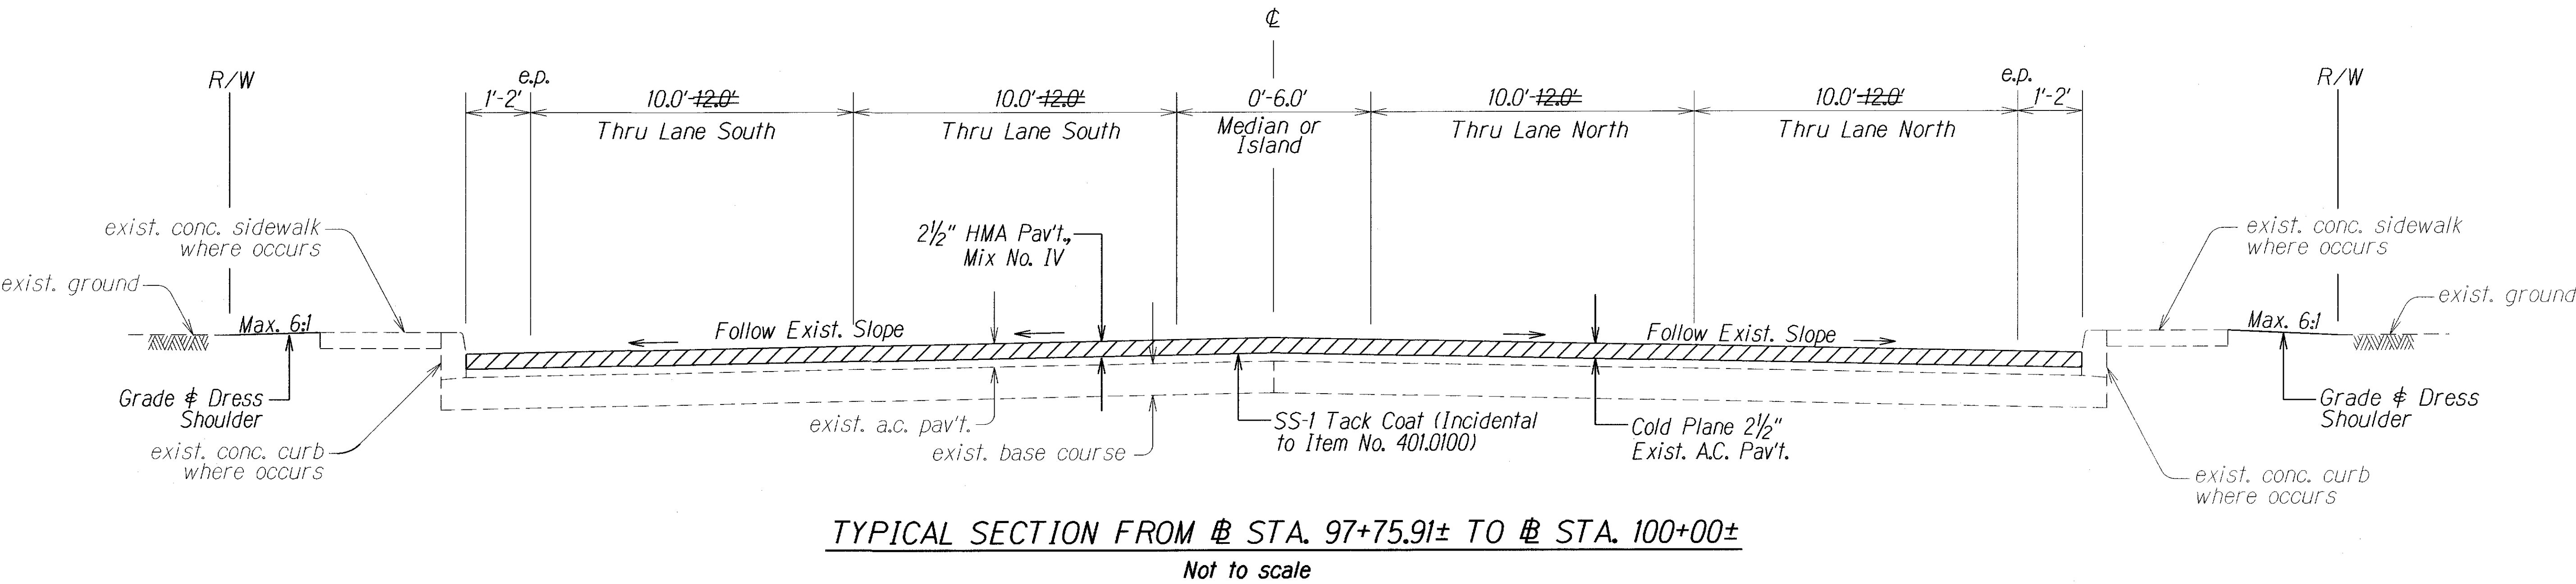


ORIGINAL PLAN	DATE
SURVEY PLOTTED BY	
DRAWN BY	
DESIGNED BY	
CHECKED BY	
INSTR. BOOK	
DATE	
BY	
DATE	
BY	

LEGEND FOR AS-BUILT POSTINGS	
	Squiggly line for as-built deletion
	Double line for as-built deletion
Roadway	Text for as-built posting


STATE OF HAWAII DEPARTMENT OF TRANSPORTATION HIGHWAYS DIVISION
TYPICAL SECTIONS
KUHIO HIGHWAY RESURFACING Hardy Street to Vicinity of Laukini Road Project No. 56A-01-13M
Not to scale Date: January 2013
SHEET No. 1 OF 4 SHEETS

"AS-BUILT"


FED. ROAD DIST. NO.	STATE	PROJ. NO.	FISCAL YEAR	SHEET NO.	TOTAL SHEETS
HAWAII	HAW.	56A-01-13M	2013	7	24

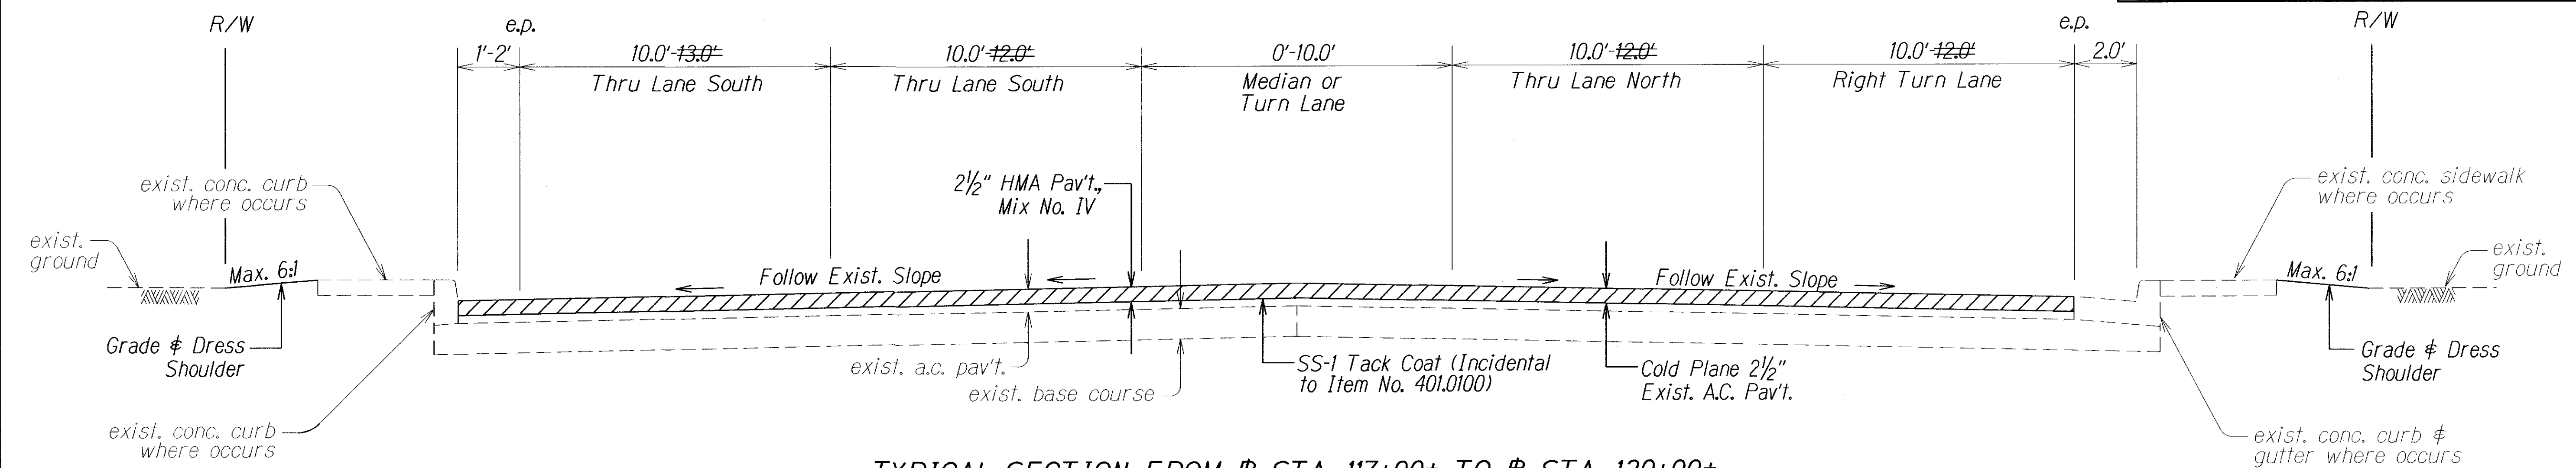

TYPICAL SECTION FROM STA. 117+00± TO STA. 130+00±
Not to scale

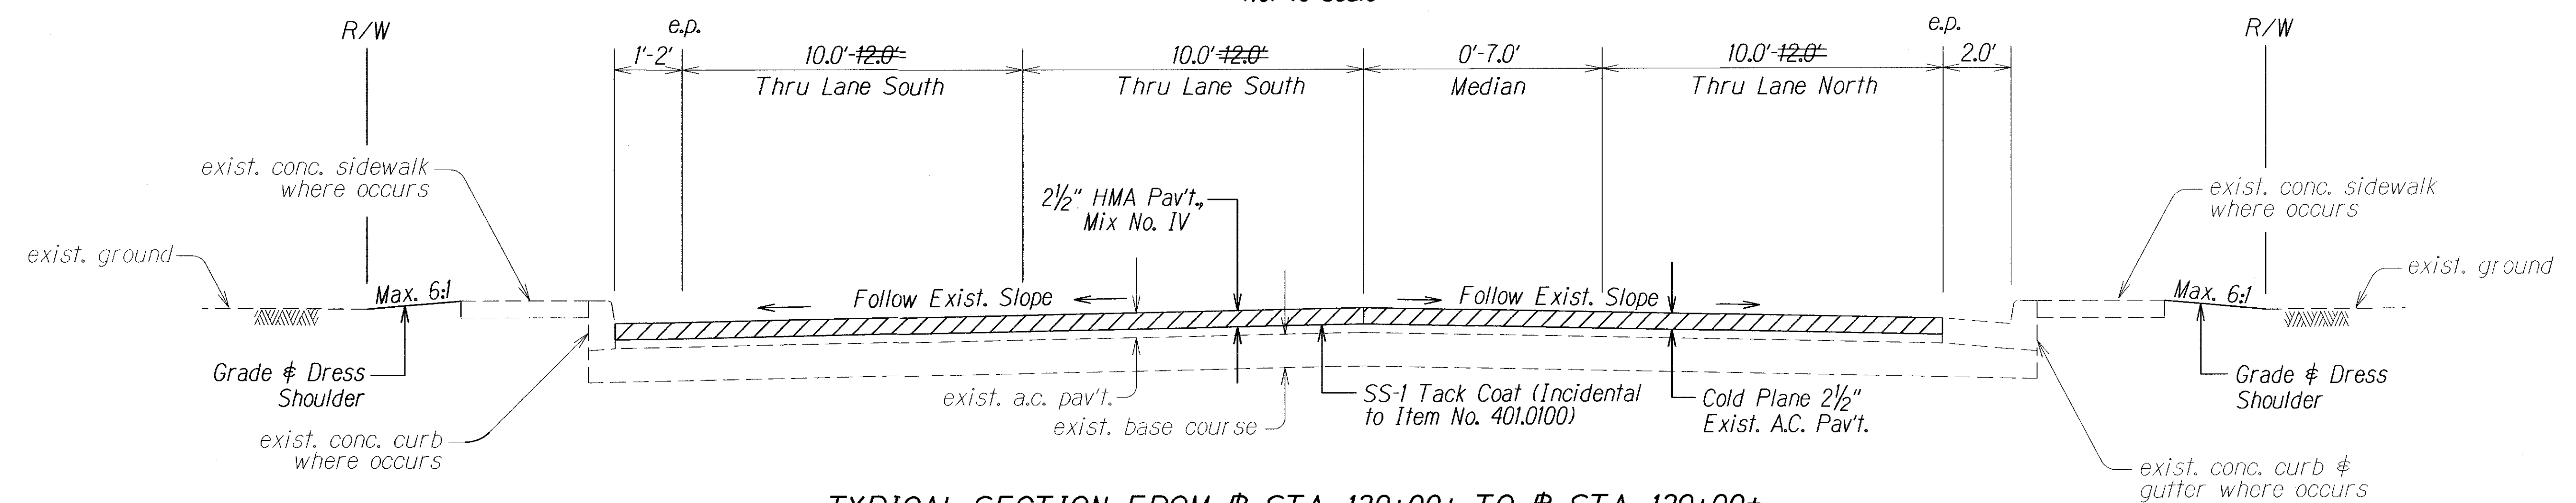

TYPICAL SECTION FROM STA. 130+00± TO STA. 139+00±
Not to scale

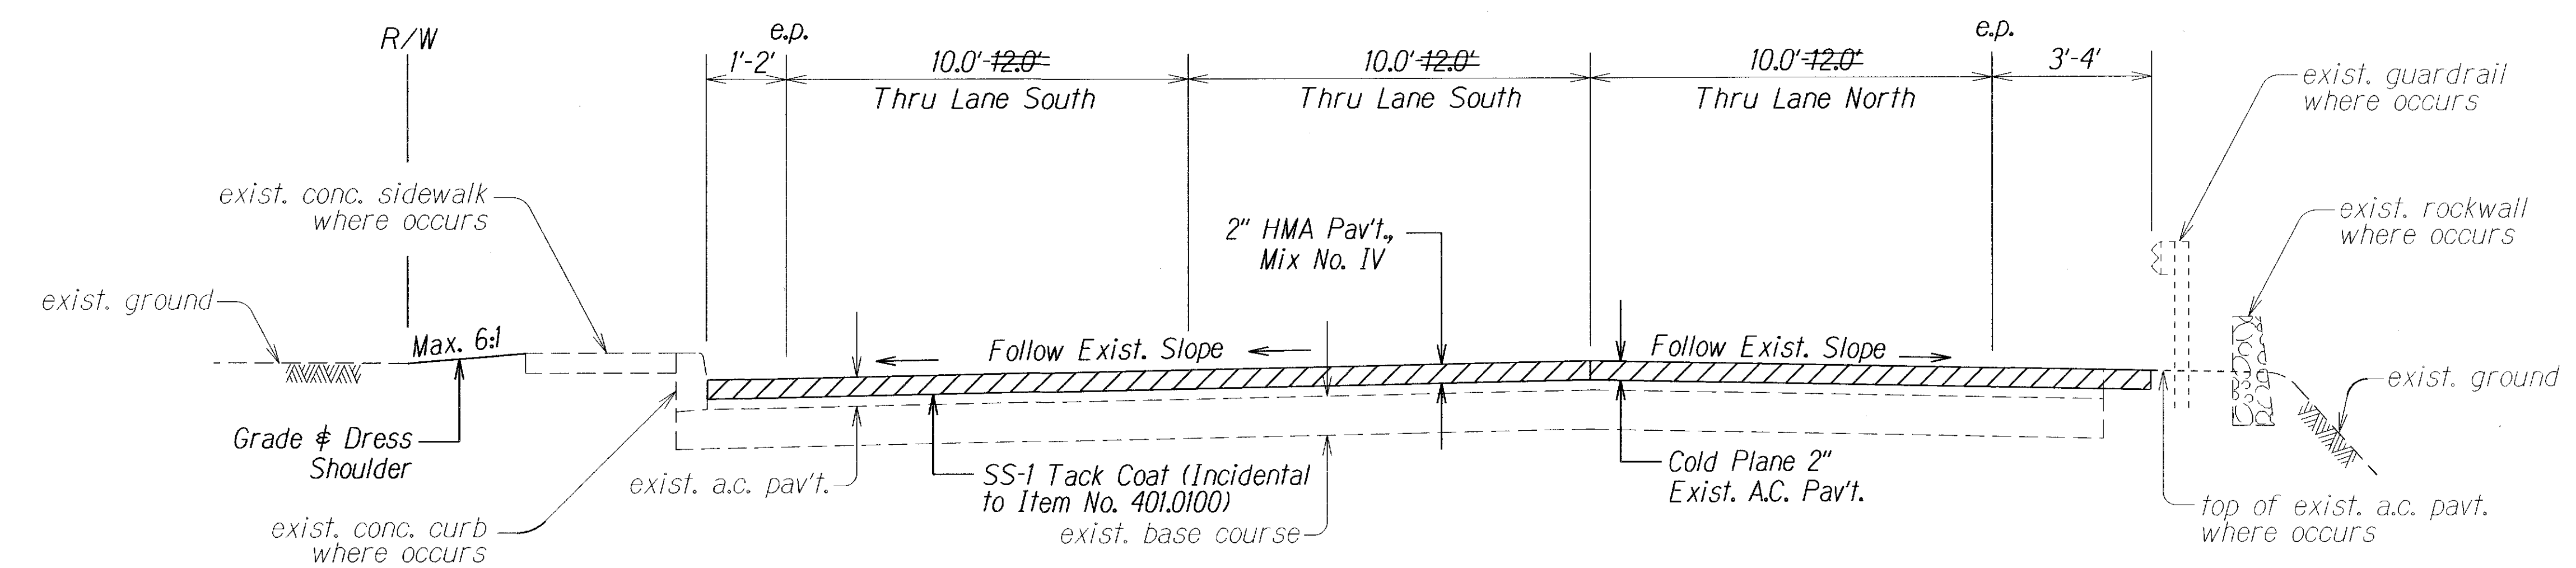

TYPICAL SECTION FROM STA. 139+00± TO STA. 144+50±
Not to scale

LEGEND FOR AS-BUILT POSTINGS	
	Squiggly line for as-built deletion
	Double line for as-built deletion
Roadway	Text for as-built posting

STATE OF HAWAII
DEPARTMENT OF TRANSPORTATION
HIGHWAYS DIVISION


TYPICAL SECTIONS

KUHIO HIGHWAY RESURFACING
Hardy Street to Vicinity of Laukini Road
Project No. 56A-01-13M


Not to scale Date: January 2013

ORIGINAL PLAN	DATE
DESIGNED BY	
TRACED BY	
QUANTITIES BY	
CHECKED BY	


FED. ROAD DIST. NO.	STATE	PROJ. NO.	FISCAL YEAR	SHEET NO.	TOTAL SHEETS
HAWAII	HAW.	56A-01-13M	2013	8	24

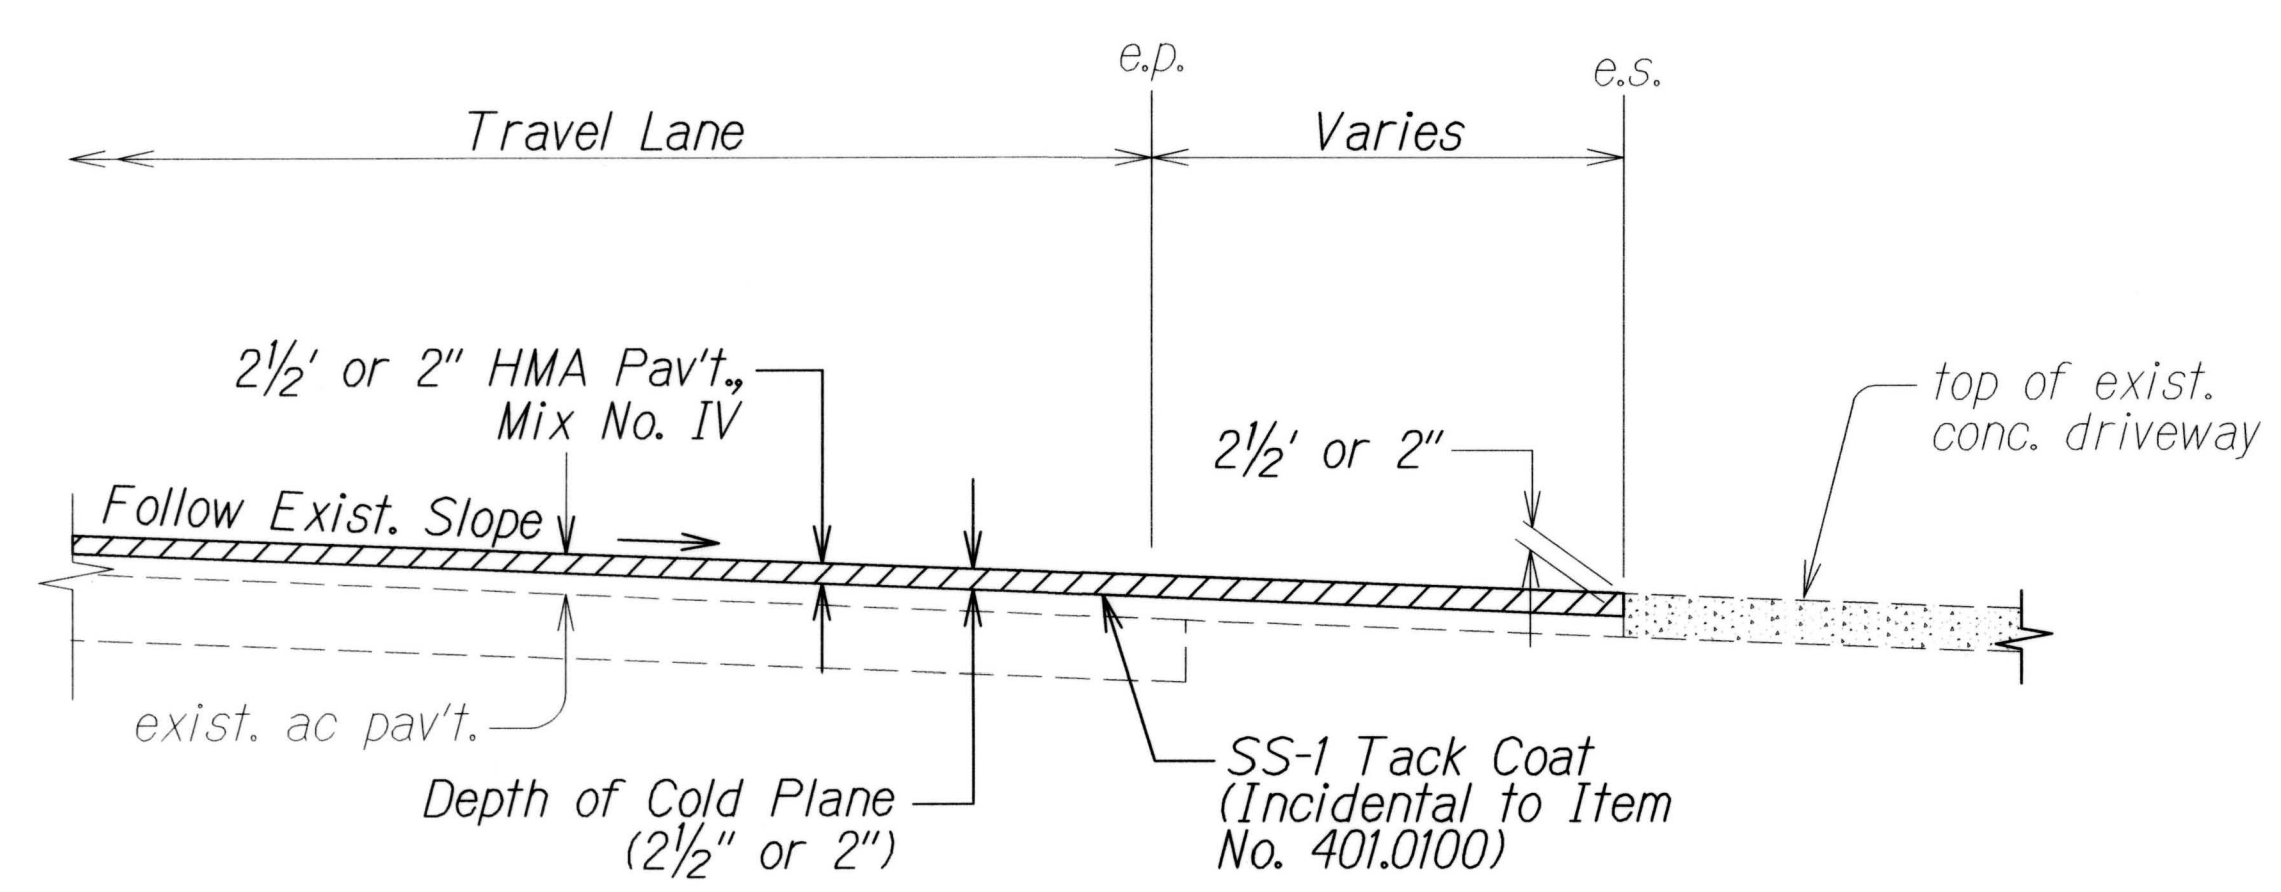


RESURFACING AT CONCRETE DRIVEWAYS
Not to Scale

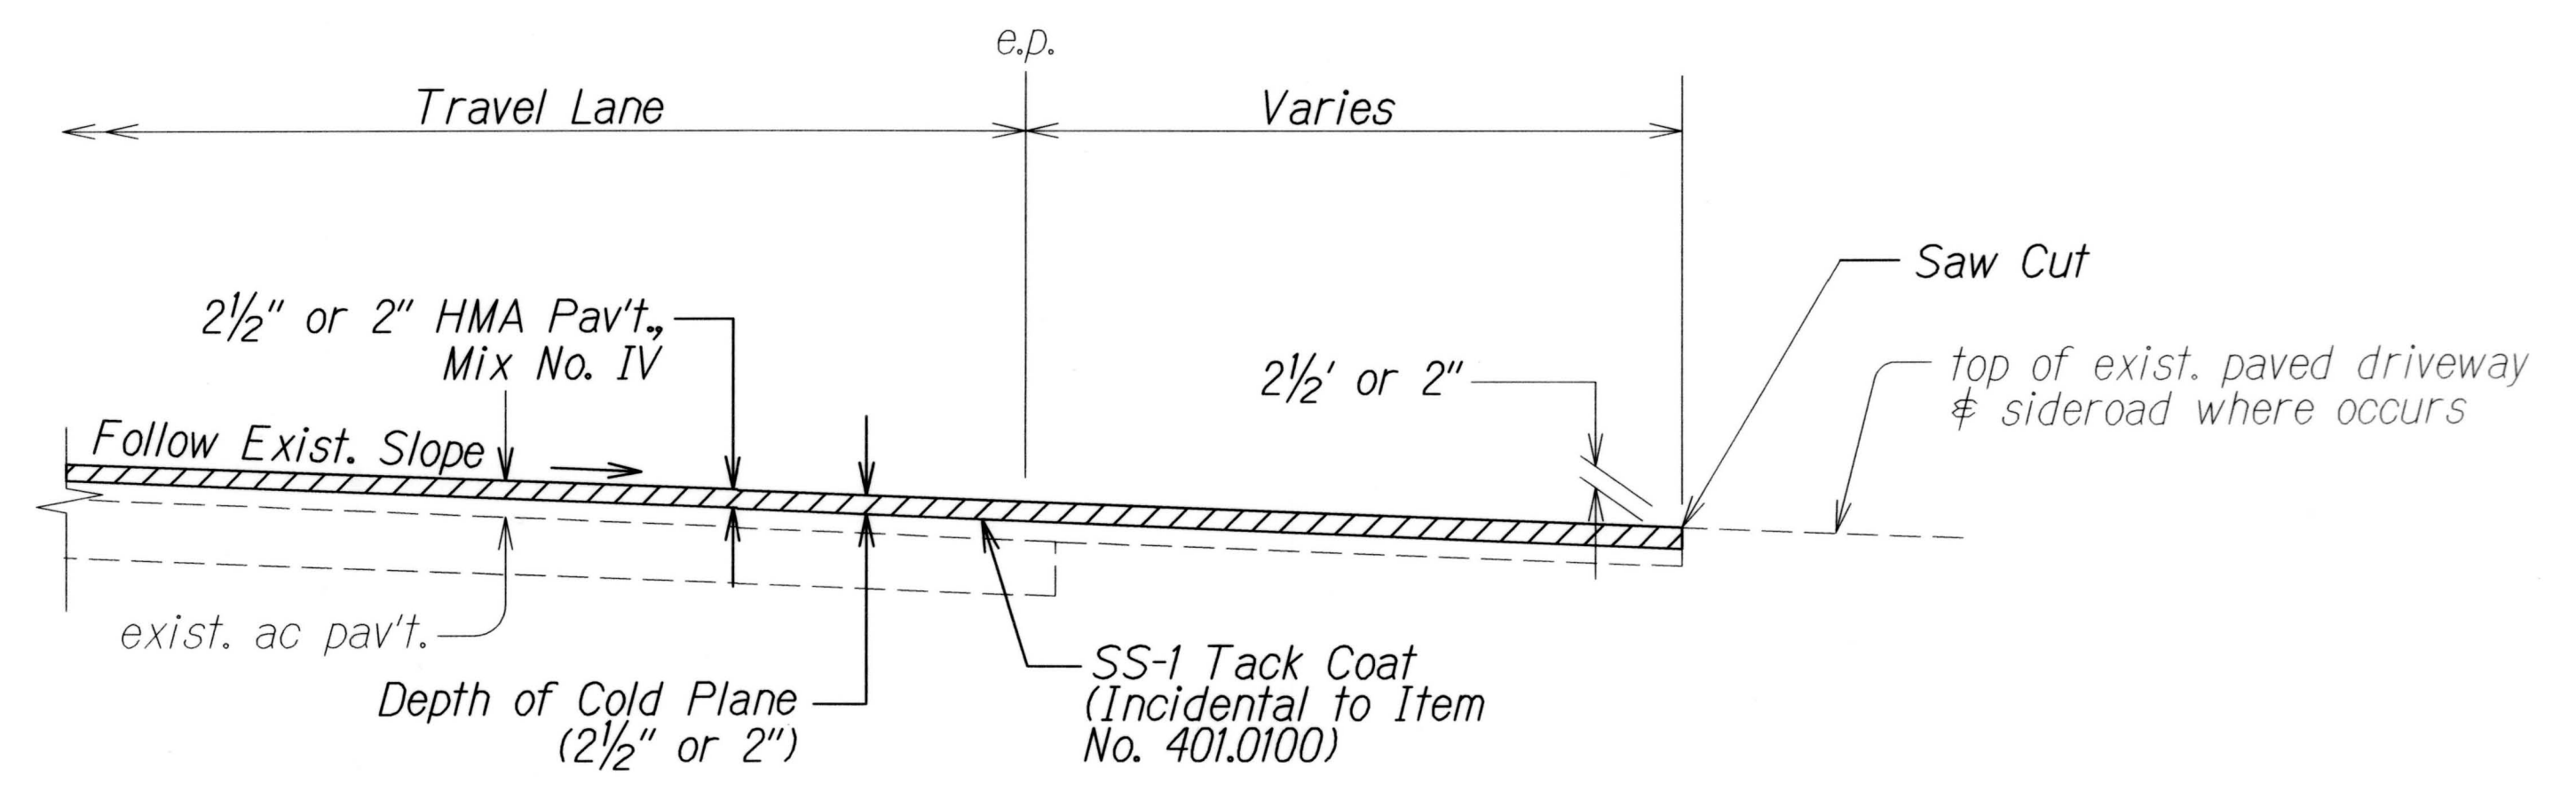

RESURFACING AT PAVED SIDEROADS/DRIVEWAYS
Not to Scale

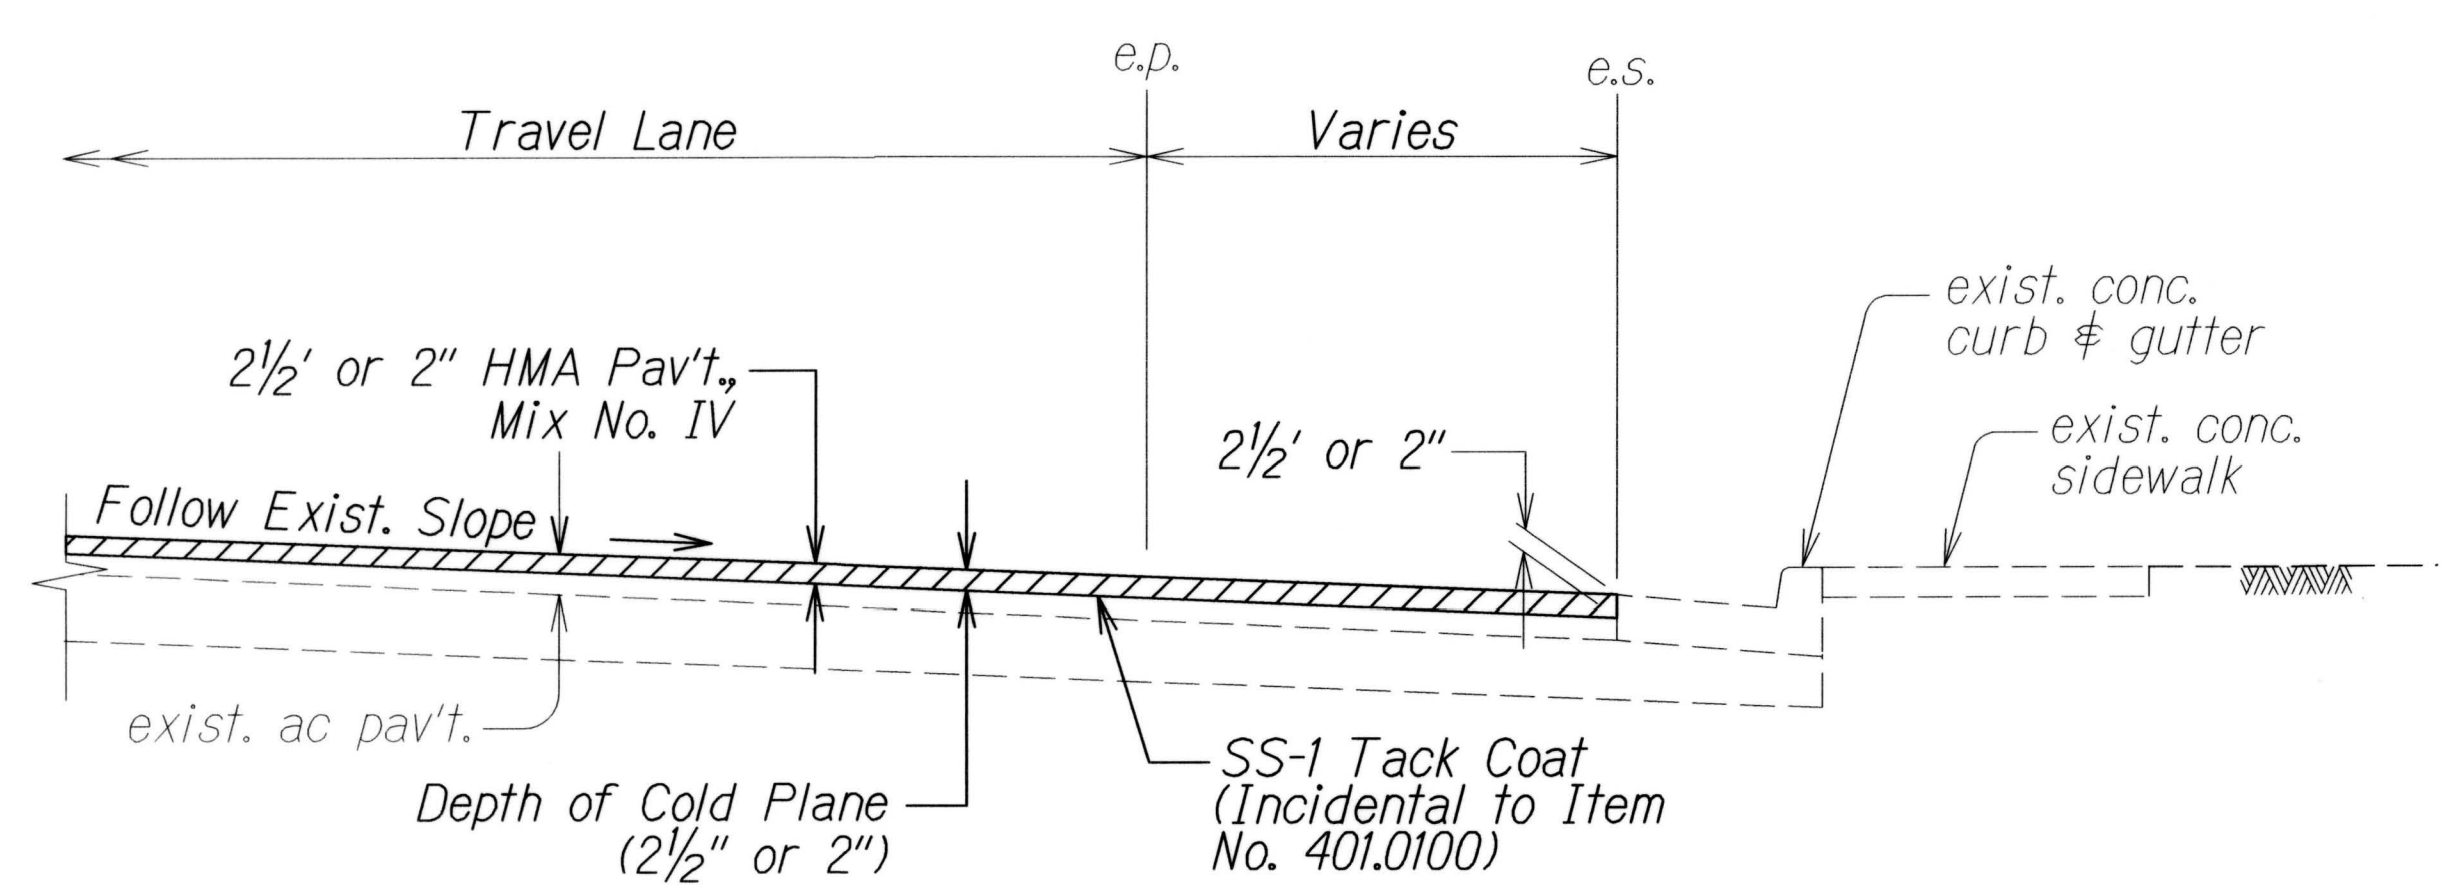

RESURFACING AT CONCRETE CURB & GUTTER
Not to Scale

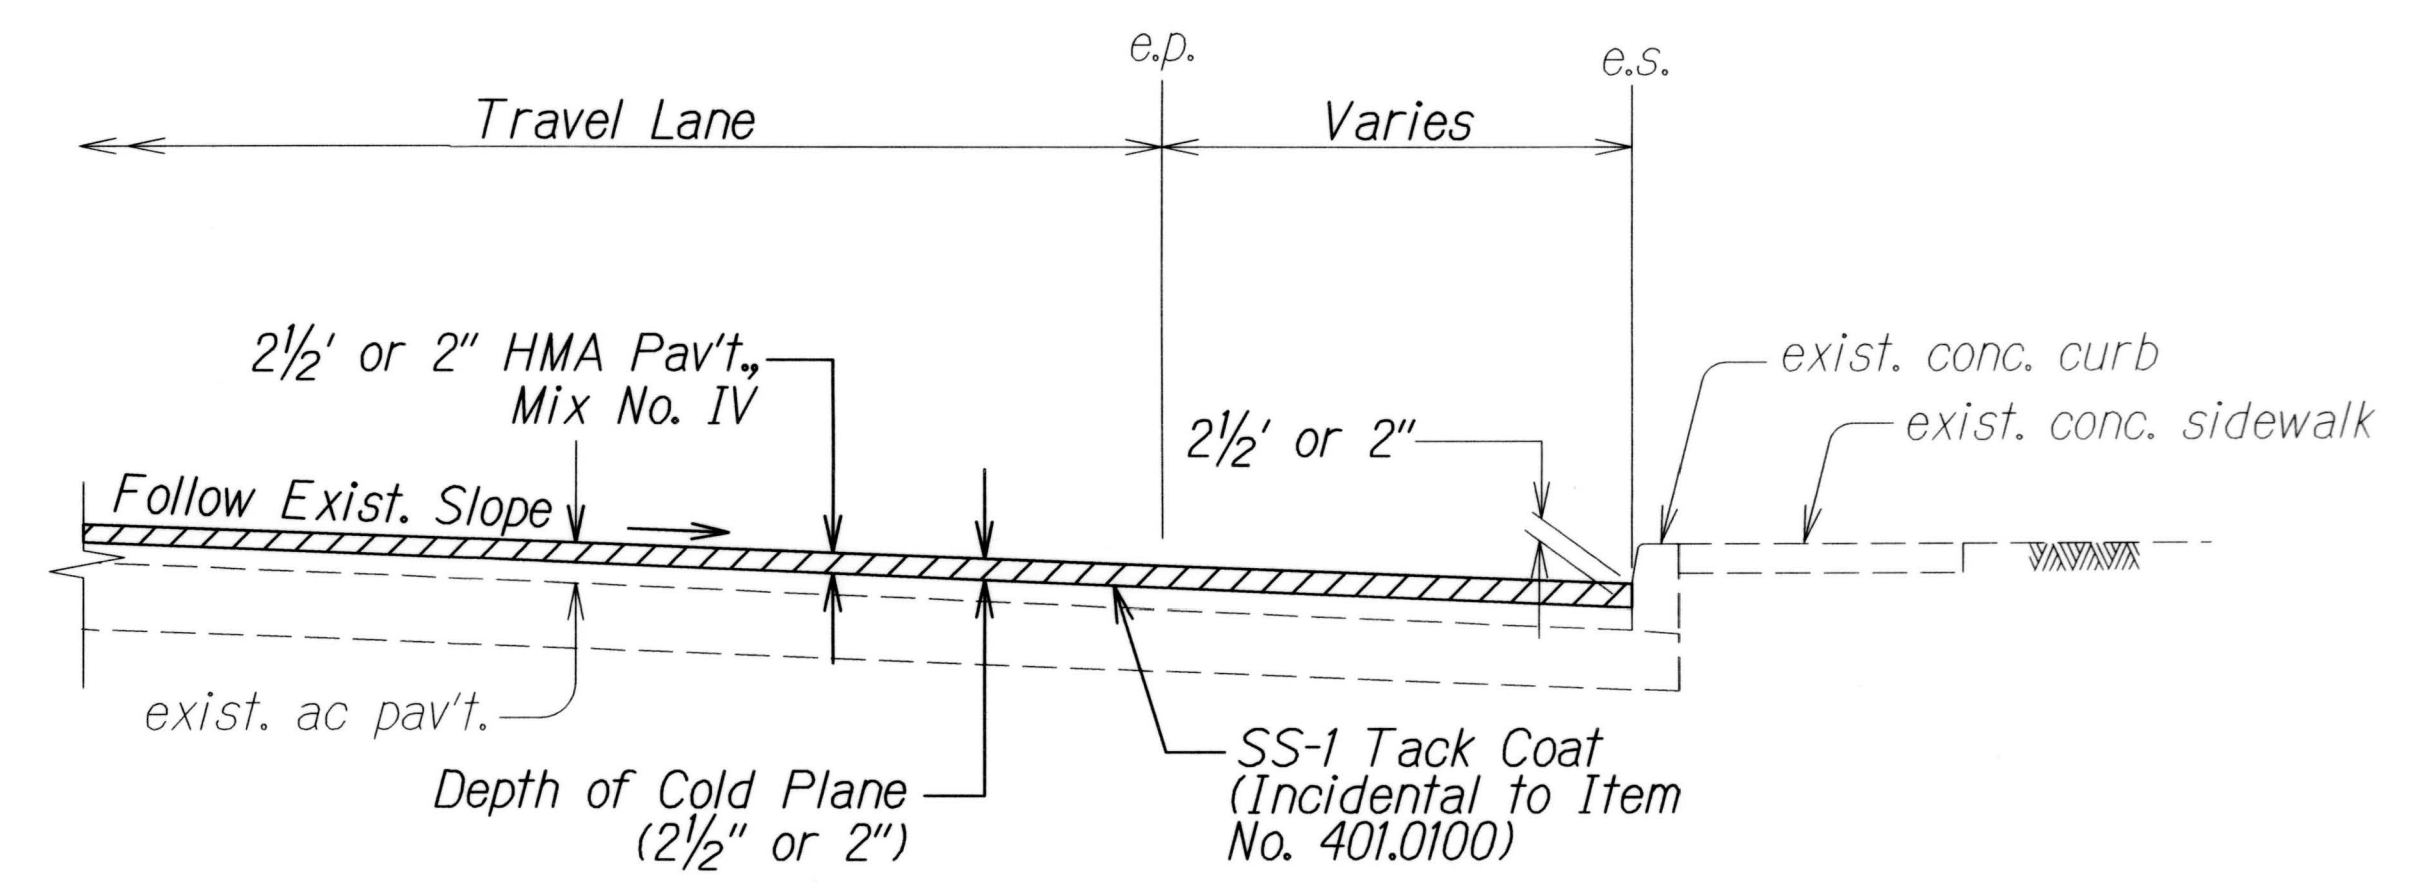

RESURFACING AT CONCRETE CURB
Not to Scale

ORIGINAL PLAN	SURVEY PLOTTED BY	DATE
NOTE BOOK	DRAWN BY	
REVISIONS	TRACED BY	
QUANTITIES	CHECKED BY	
NO.		

STATE OF HAWAII
DEPARTMENT OF TRANSPORTATION
HIGHWAYS DIVISION




TYPICAL SECTIONS

KUHIO HIGHWAY RESURFACING
Hardy Street to Vicinity of Laukini Road
Project No. 56A-01-13M

Not to Scale Date: January 2013


SHEET No. 3 OF 4 SHEETS

FED. ROAD DIST. NO.	STATE	PROJ. NO.	FISCAL YEAR	SHEET NO.	TOTAL SHEETS
HAWAII	HAW.	56A-01-13M	2013	ADD.9	24

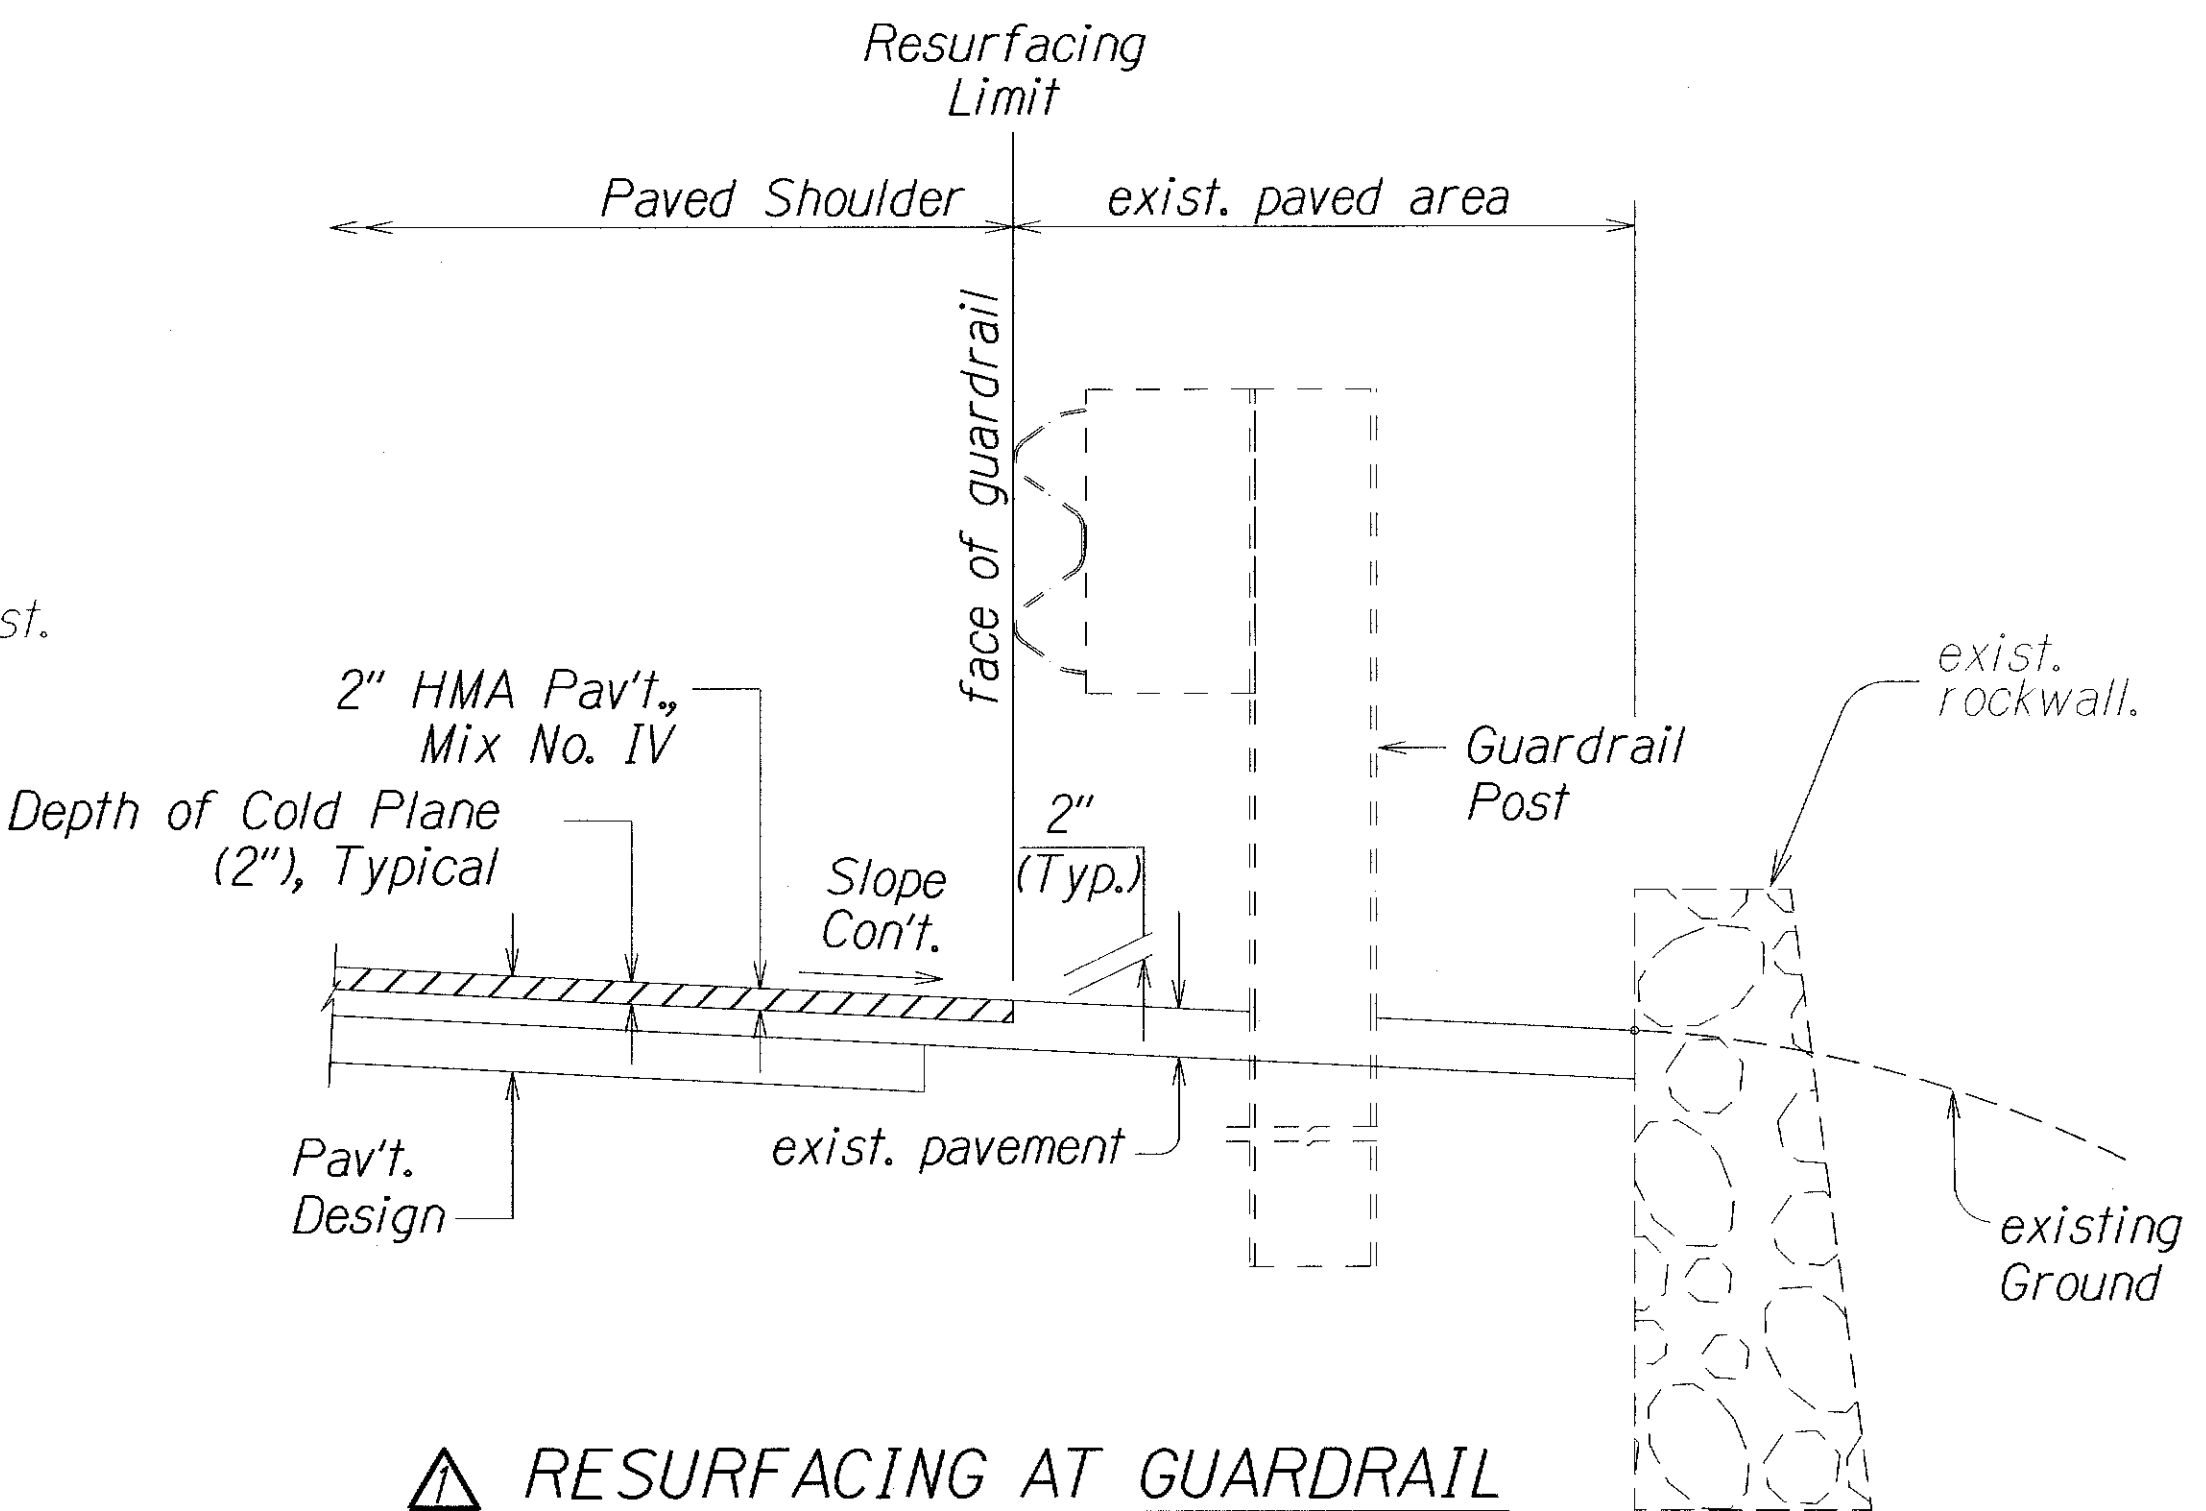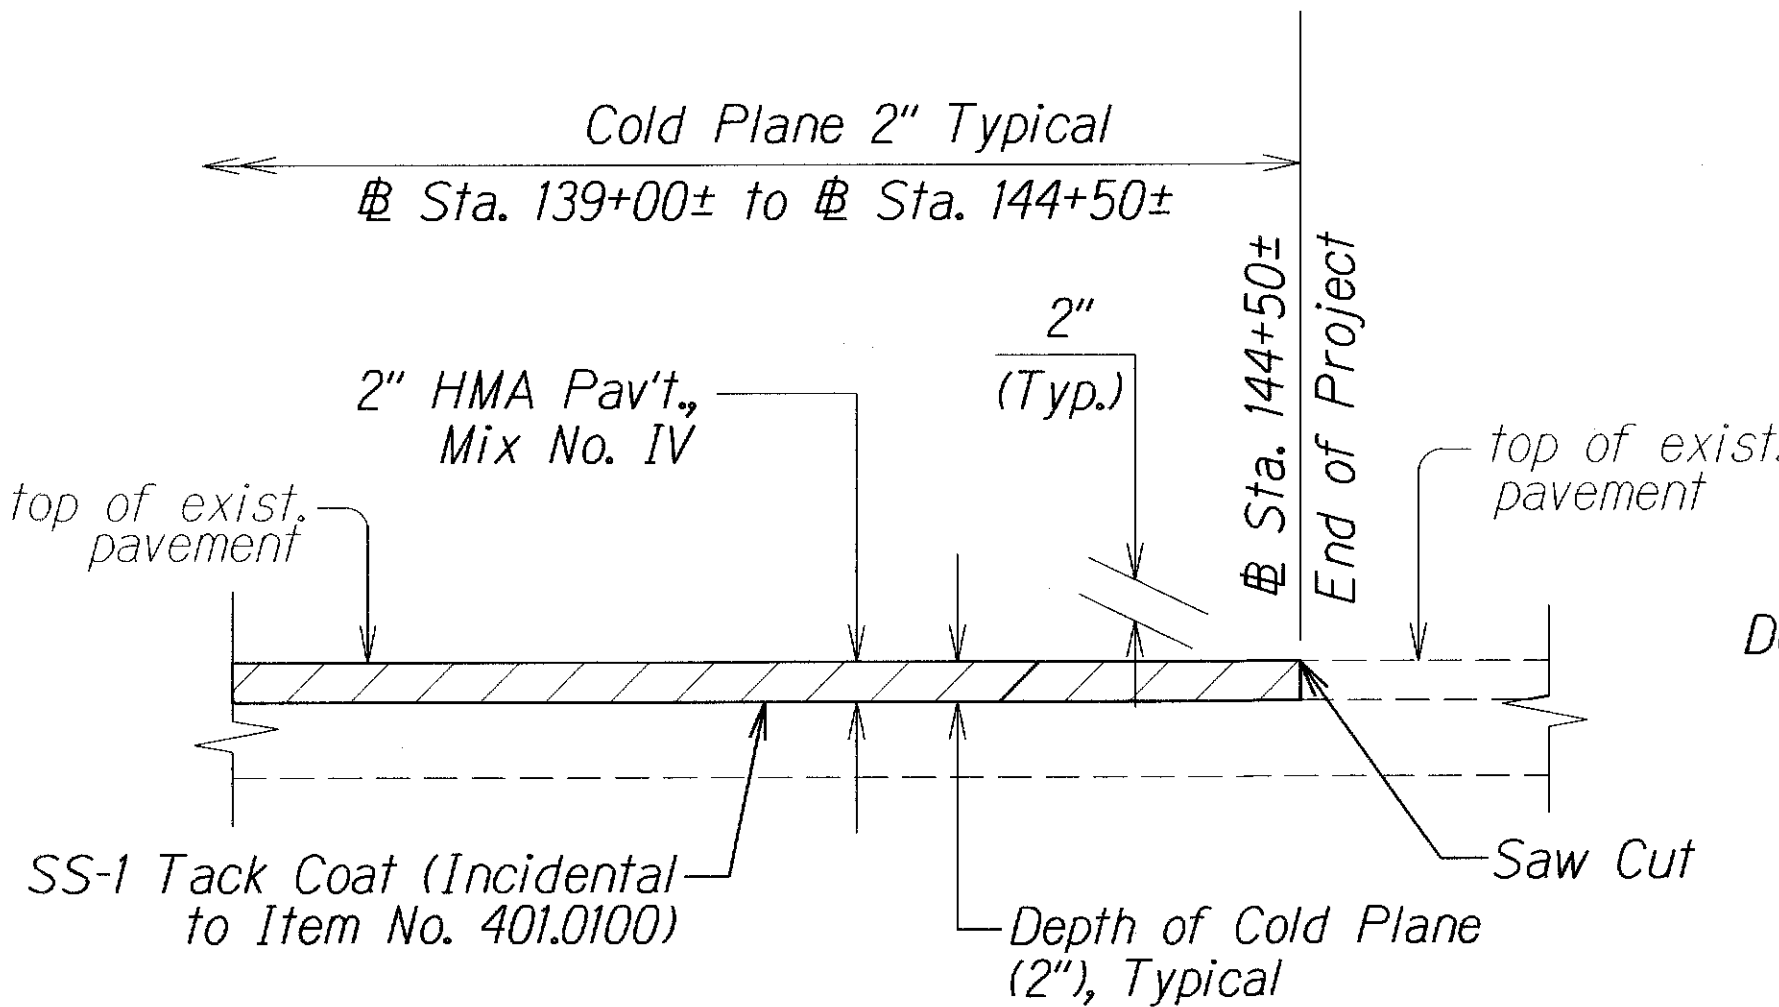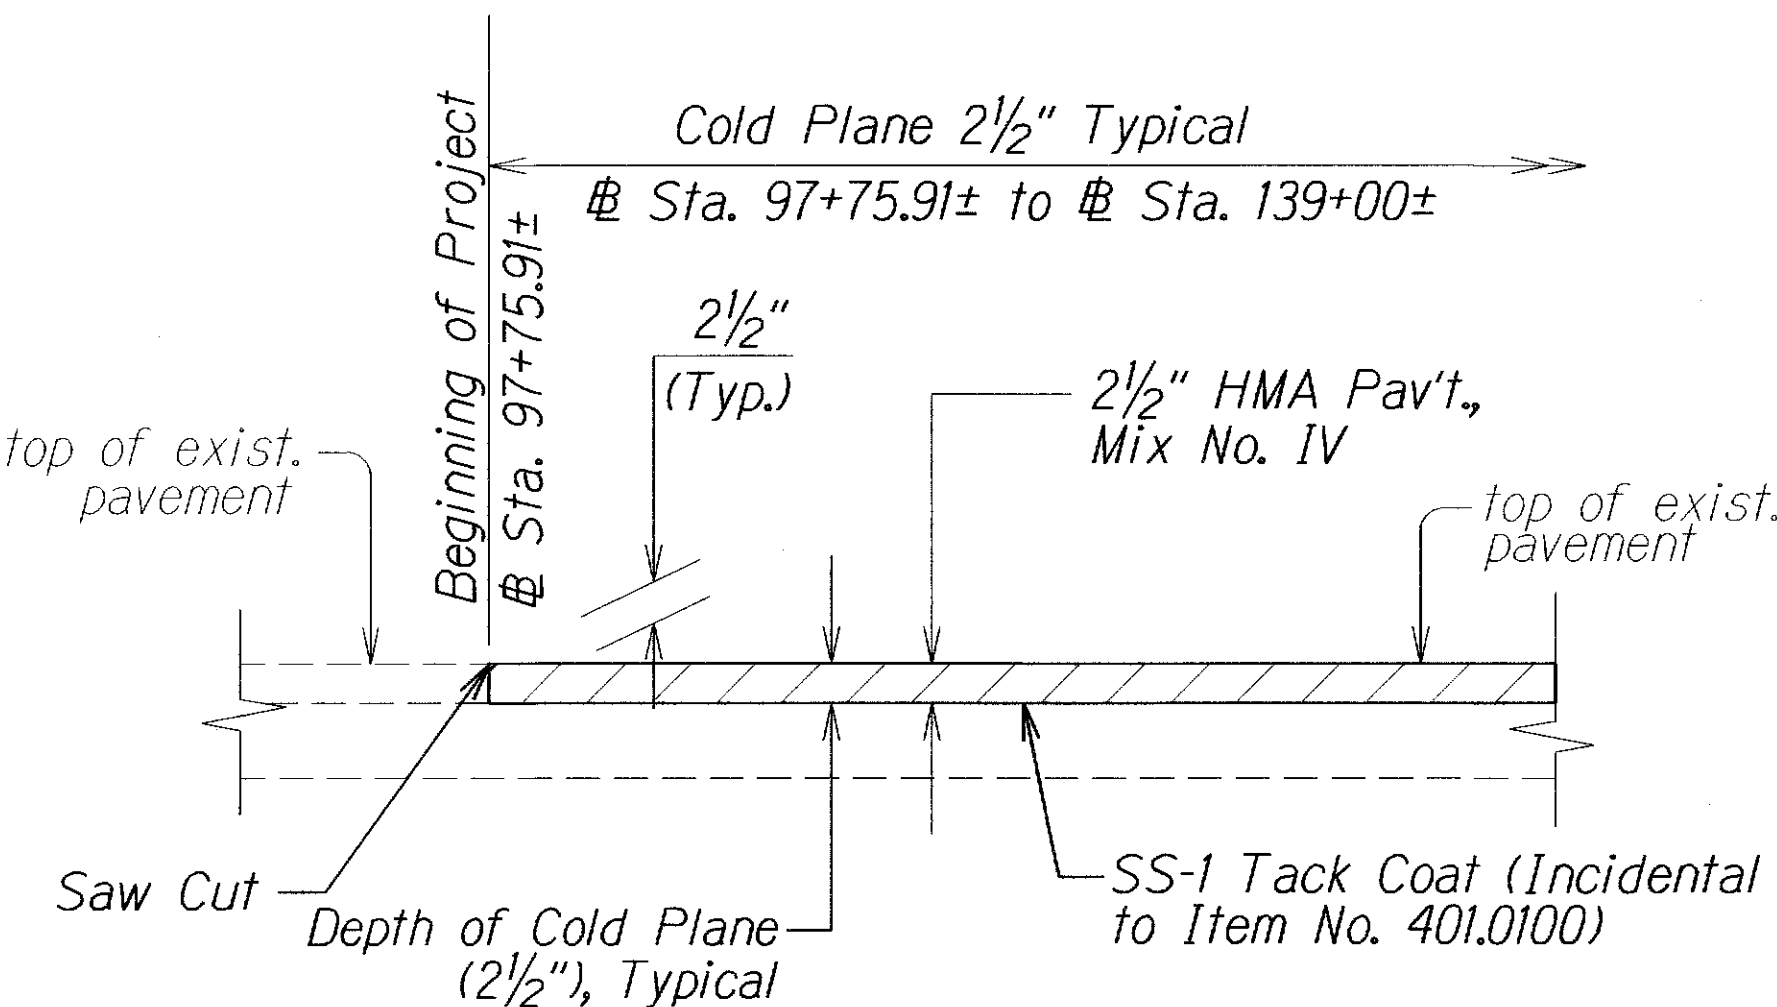


△ COLD PLANED TRANSITION TO EXISTING A.C. PAVEMENT AT THE BEGINNING AND END OF PROJECT
Not to Scale

△ RESURFACING AT GUARDRAIL
Not to Scale

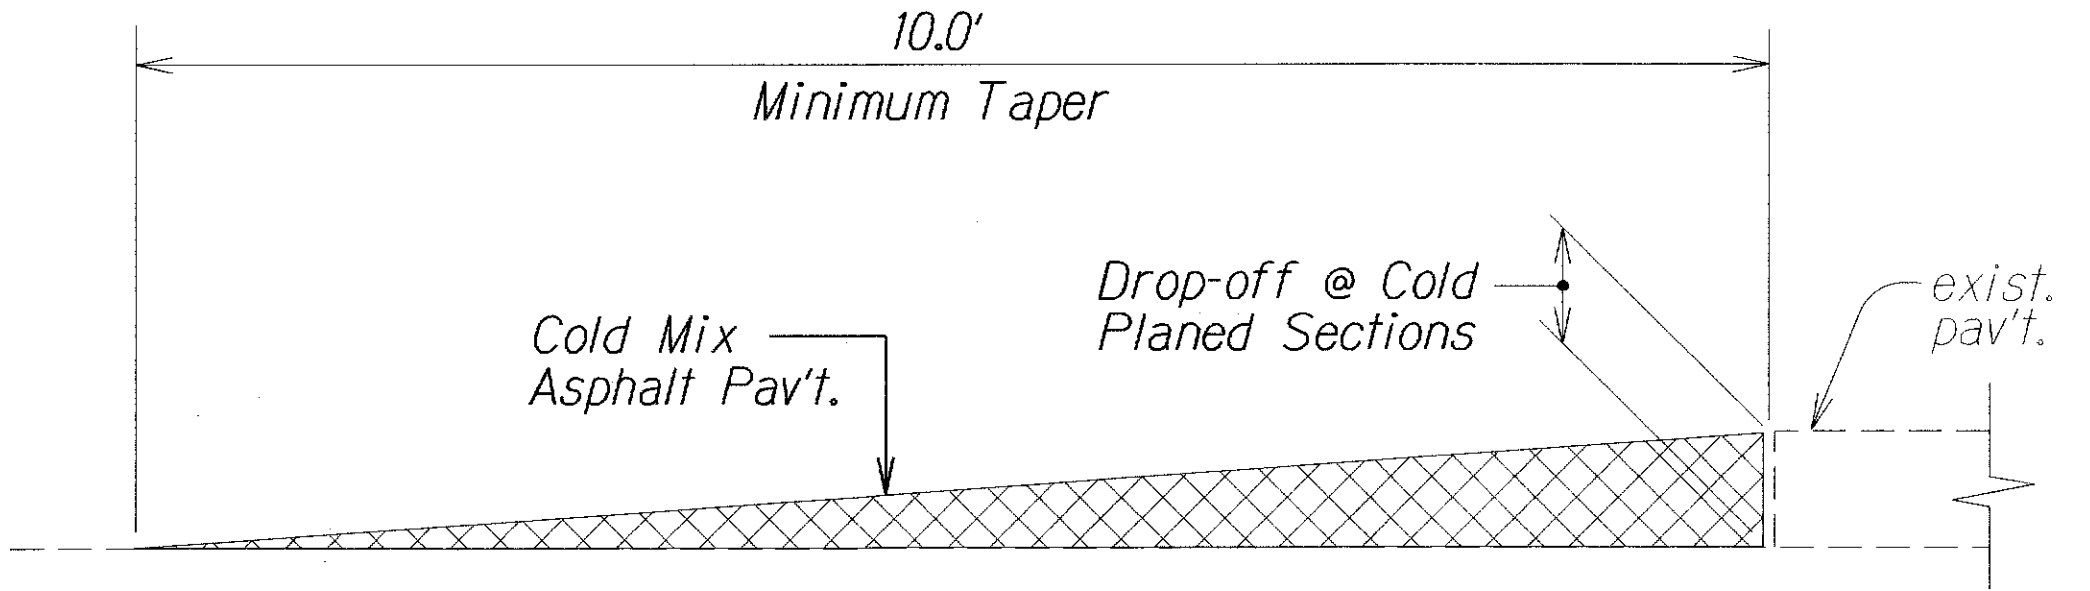


TEMPORARY TRANSITION AT COLD PLANED AREAS
Not to Scale

Note: Contractor shall construct temporary pavement taper to prevent sharp pavement drop-offs at all cold planed sections. Prior to final Hot Mix Asphalt Pavement, Mix No. IV placement, temporary pavement taper shall be removed.

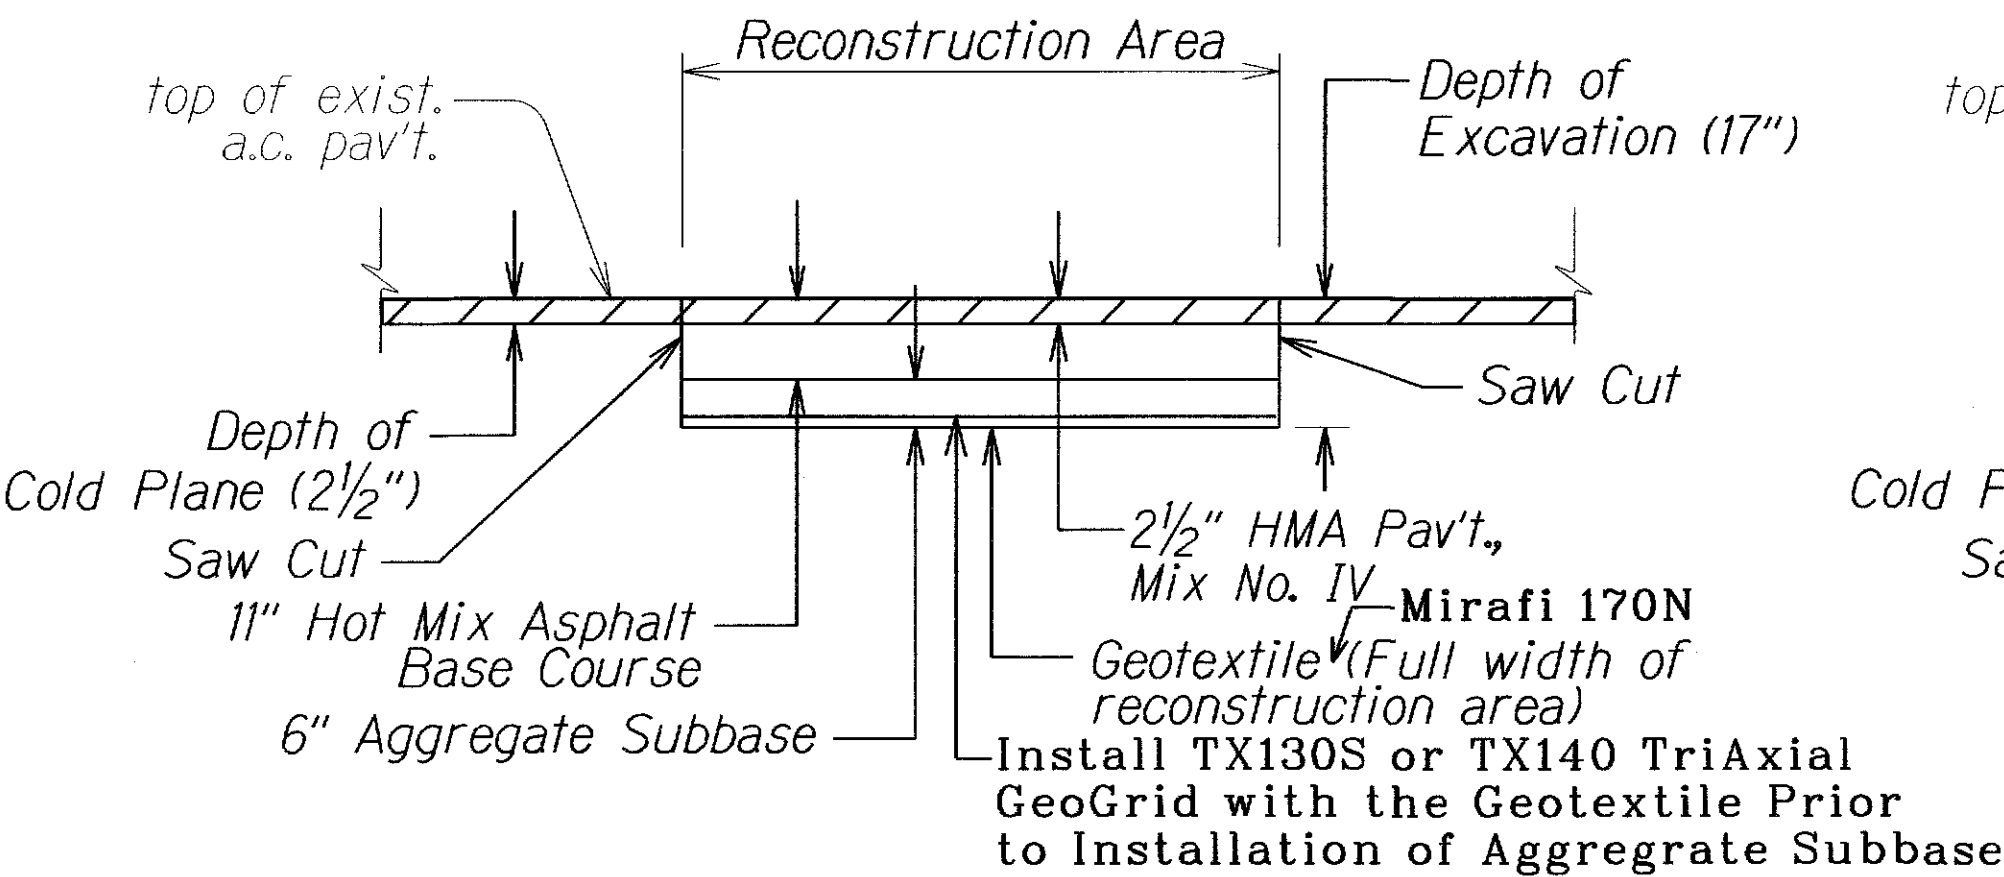

△△ A.C. PAVEMENT RECONSTRUCTION DETAIL
△ STA. 97+75.91 TO △ STA. 139+00
Not to Scale

- Note:
1. Reconstruct weakened pavement areas prior to cold plane.
 2. Excavation to the full depth of reconstruction areas (17 inches) shall be paid for under Item No. 414.0110 - Excavation of Weakened Pavement Areas and shall not be paid separately.

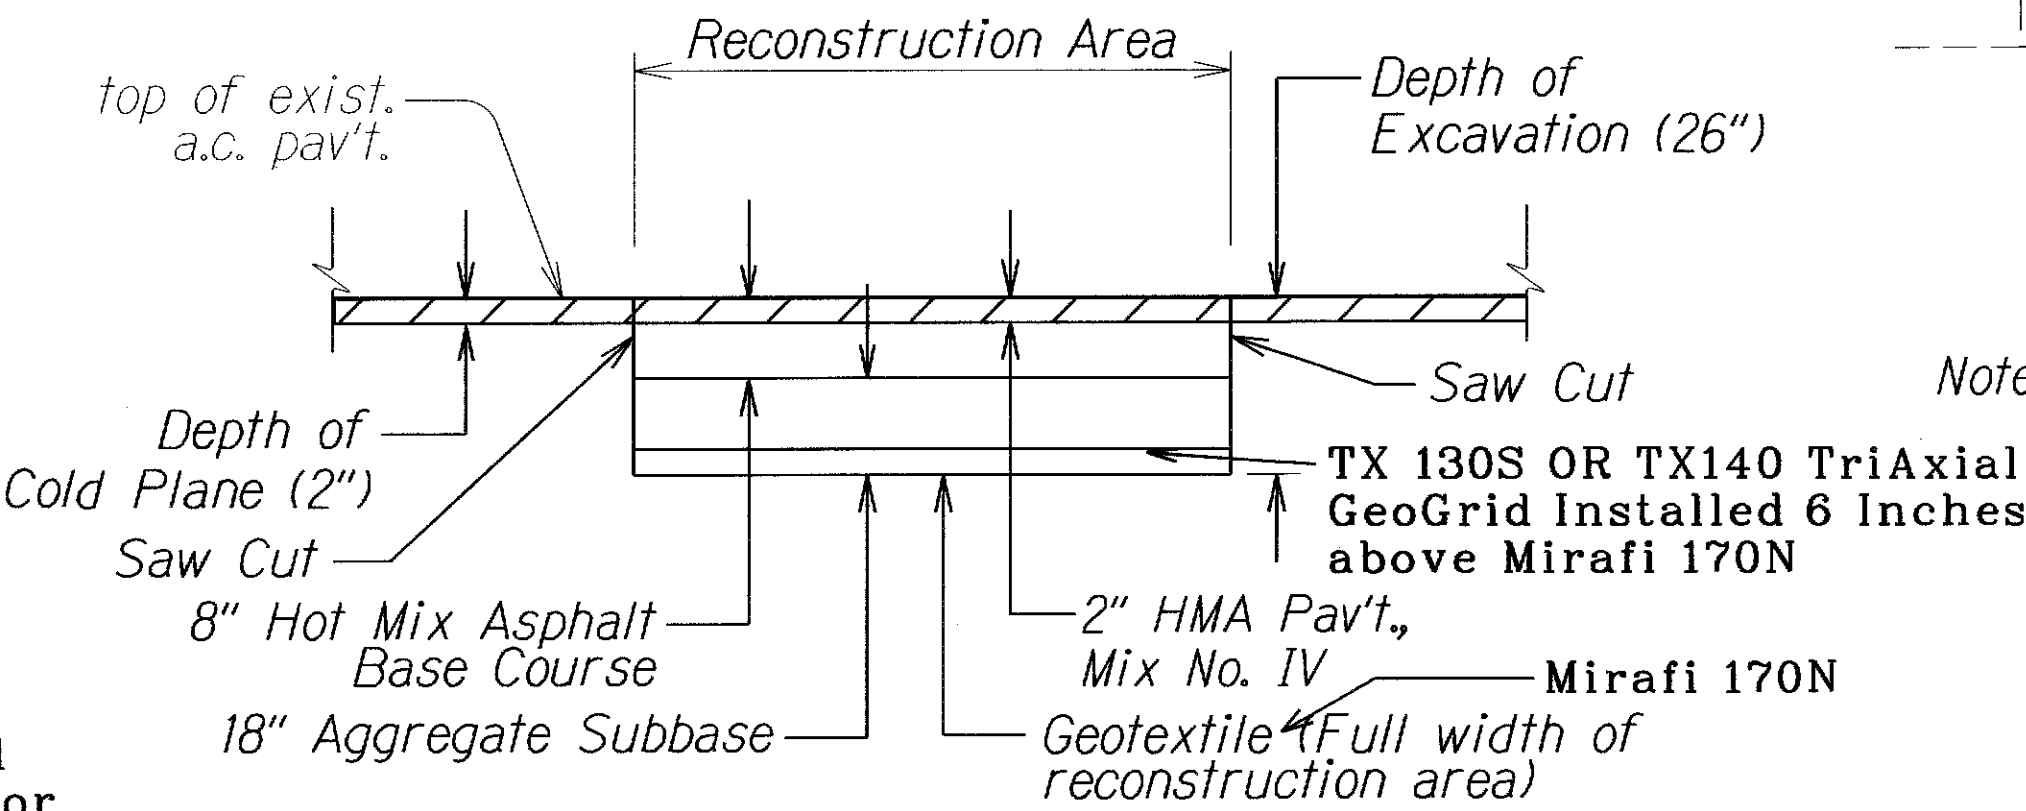

△△ A.C. PAVEMENT RECONSTRUCTION DETAIL
△ STA. 139+00 TO △ STA. 144+50
Not to Scale

- Note:
1. Reconstruct weakened pavement areas prior to cold plane.
 2. Excavation to the full depth of reconstruction areas (26 inches) shall be paid for under Item No. 414.0110 - Excavation of Weakened Pavement Areas and shall not be paid separately.

LEGEND FOR AS-BUILT POSTINGS	
	Squiggly line for as-built deletion
	Double line for as-built deletion
Roadway	Text for as-built posting

June 6, 2013	△ - A.C. Pavement Reconstruction Details and Notes
May 13, 2013	△ - Resurfacing at Guardrail
May 13, 2013	△ - Cold Planed Transition at the Beginning and End of Project
May 13, 2013	△ - A.C. Pavement Reconstruction Details and Notes
DATE	REVISION

STATE OF HAWAII DEPARTMENT OF TRANSPORTATION HIGHWAYS DIVISION	
<u>TYPICAL SECTIONS</u>	
<u>KUHIO HIGHWAY RESURFACING</u> <u>Hardy Street to Vicinity of Laukini Road</u> <u>Project No. 56A-01-13M</u>	
Not to Scale	Date: May 2013
SHEET No. 4 OF 4 SHEETS	

ORIGINAL PLAN	DATE
SURVEY PLOTTED BY	
DESIGNED BY	
QUANTITIES BY	
CHECKED BY	
NOTED BY	
DATE	