

FED. ROAD DIST. NO.	STATE	FEDERAL AID PROJ. NO.	FISCAL YEAR	SHEET NO.	TOTAL SHEETS
HAWAII	HAW.	ER-16(001)	2012	8	29

Approved By:

District Engineer
HDOT

Date

LEGEND FOR
AS-BUILT POSTINGS



Squiggly line for as-built deletion




Double line for as-built deletion

Roadway

Text for as-built posting

TRUE NORTH

SCALE: 1" = 40'

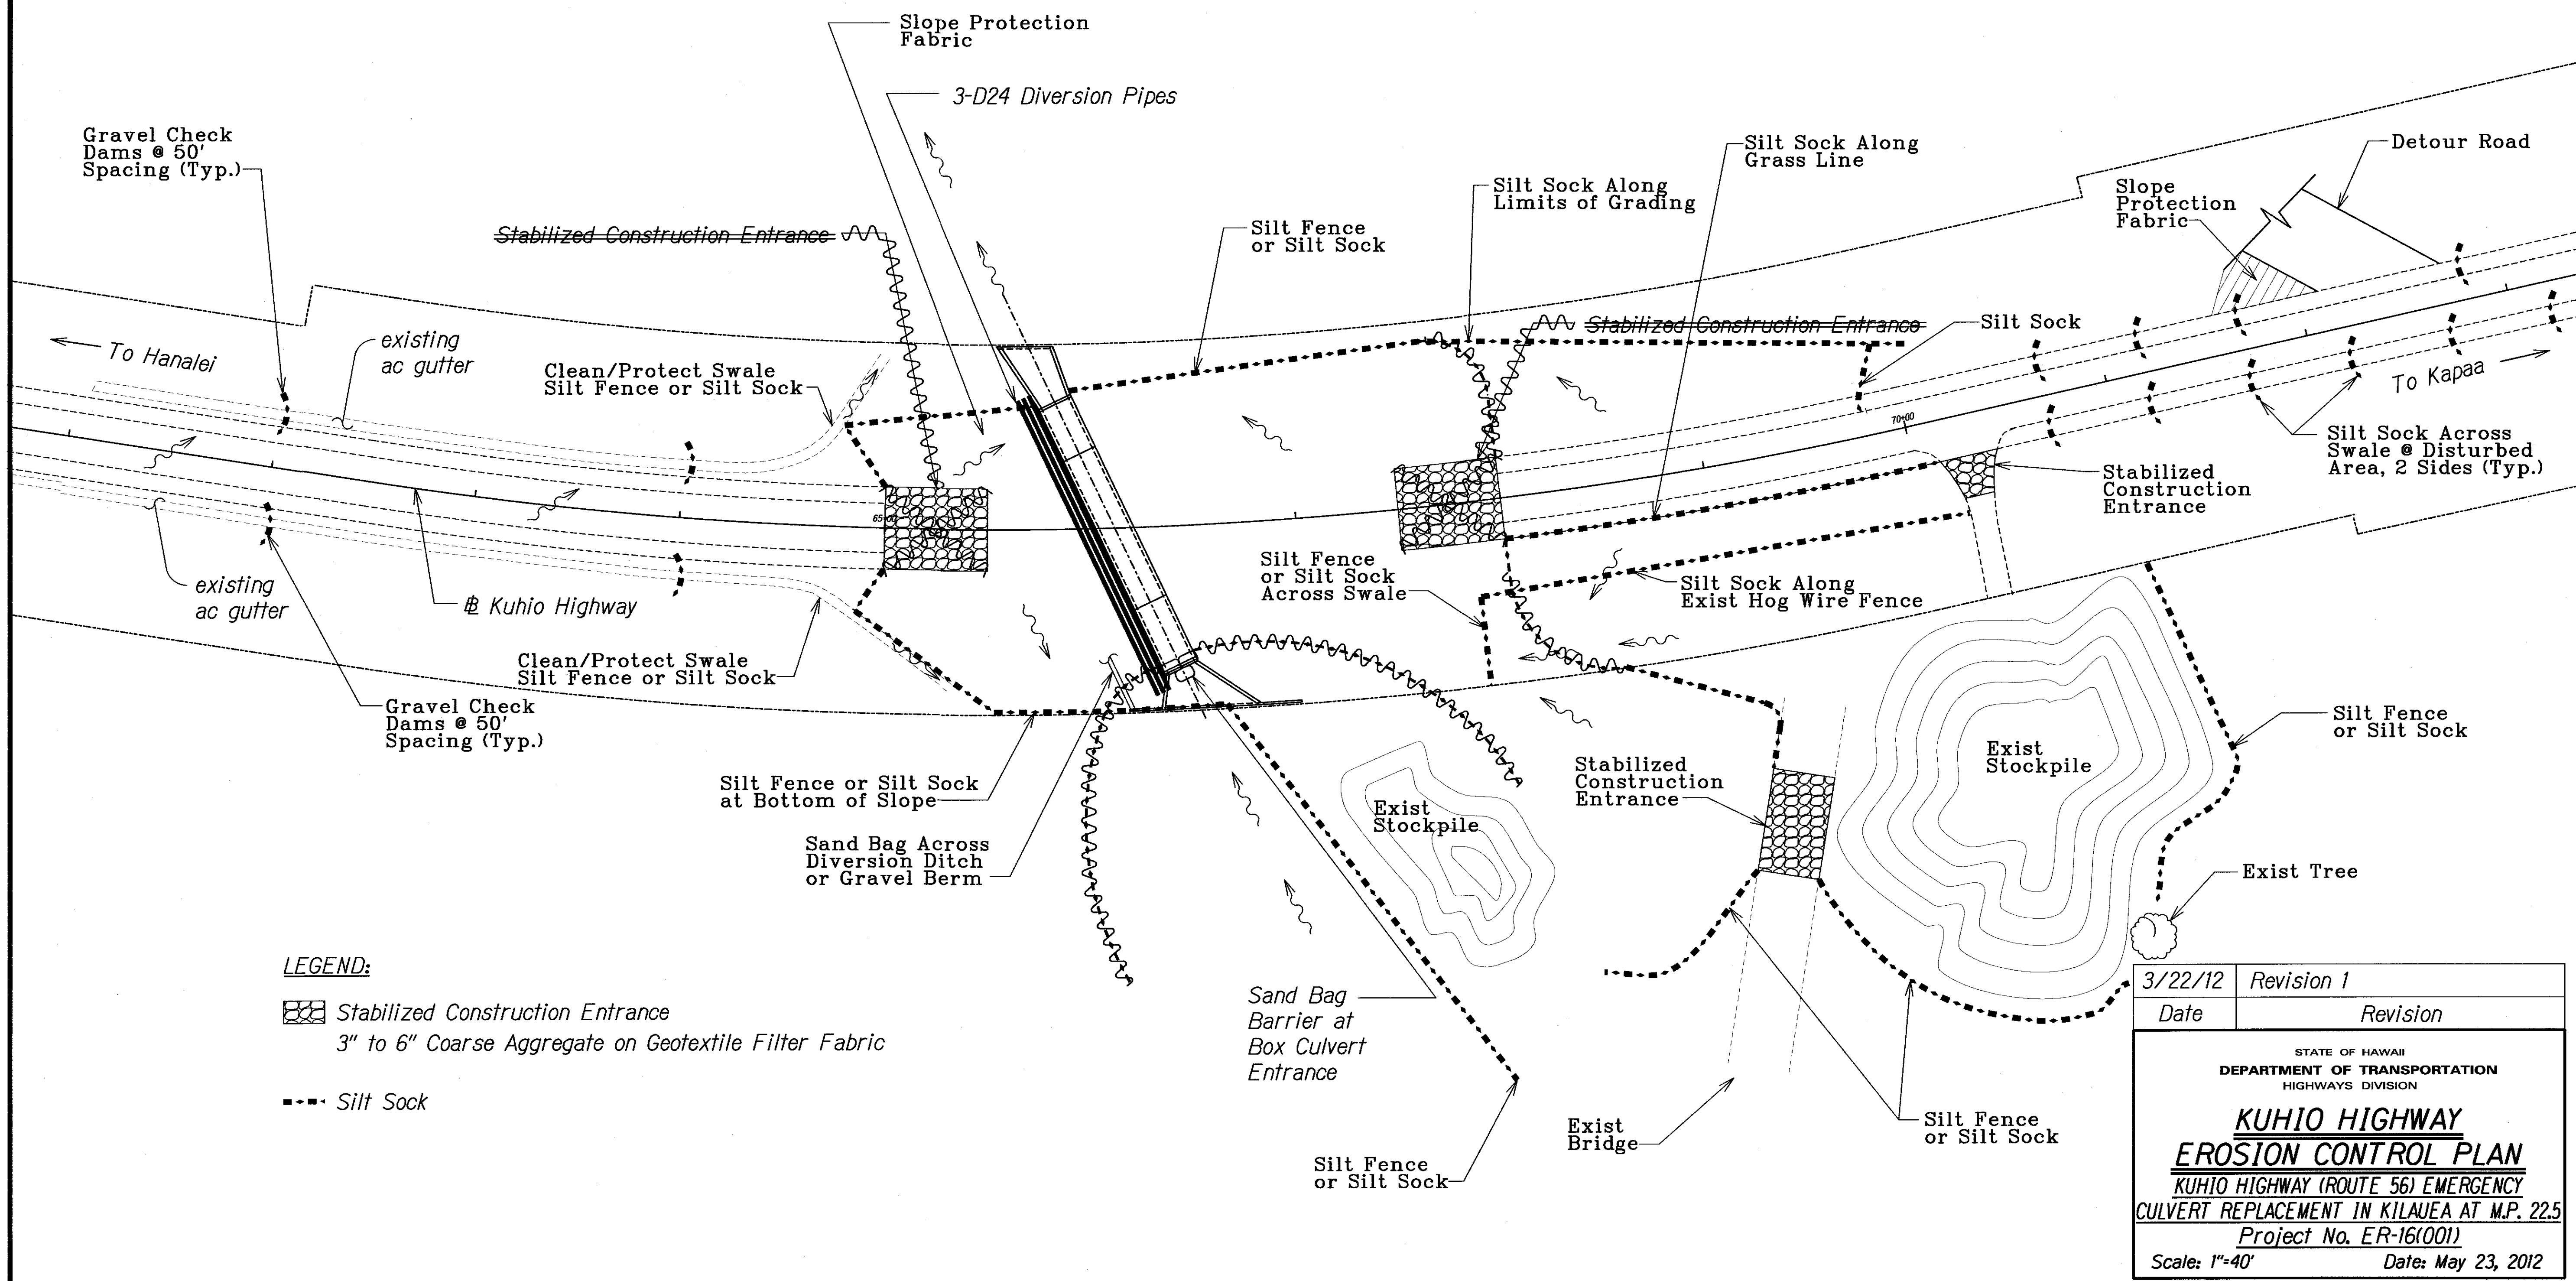

LEGEND:



Stabilized Construction Entrance
3" to 6" Coarse Aggregate on Geotextile Filter Fabric



Silt Sock

DESIGNED BY	DATE
DRAWN BY	
CHECKED BY	
NOTED BY	
DATE	

3/22/12

Revision 1

Date

Revision

STATE OF HAWAII

DEPARTMENT OF TRANSPORTATION

HIGHWAYS DIVISION

KUHIO HIGHWAY

EROSION CONTROL PLAN

KUHIO HIGHWAY (ROUTE 56) EMERGENCY

CULVERT REPLACEMENT IN KILAUEA AT M.P. 22.5

Project No. ER-16(001)

Scale: 1"=40'

Date: May 23, 2012

SHEET No. C-7 OF 9 SHEETS

"AS-BUILT"