
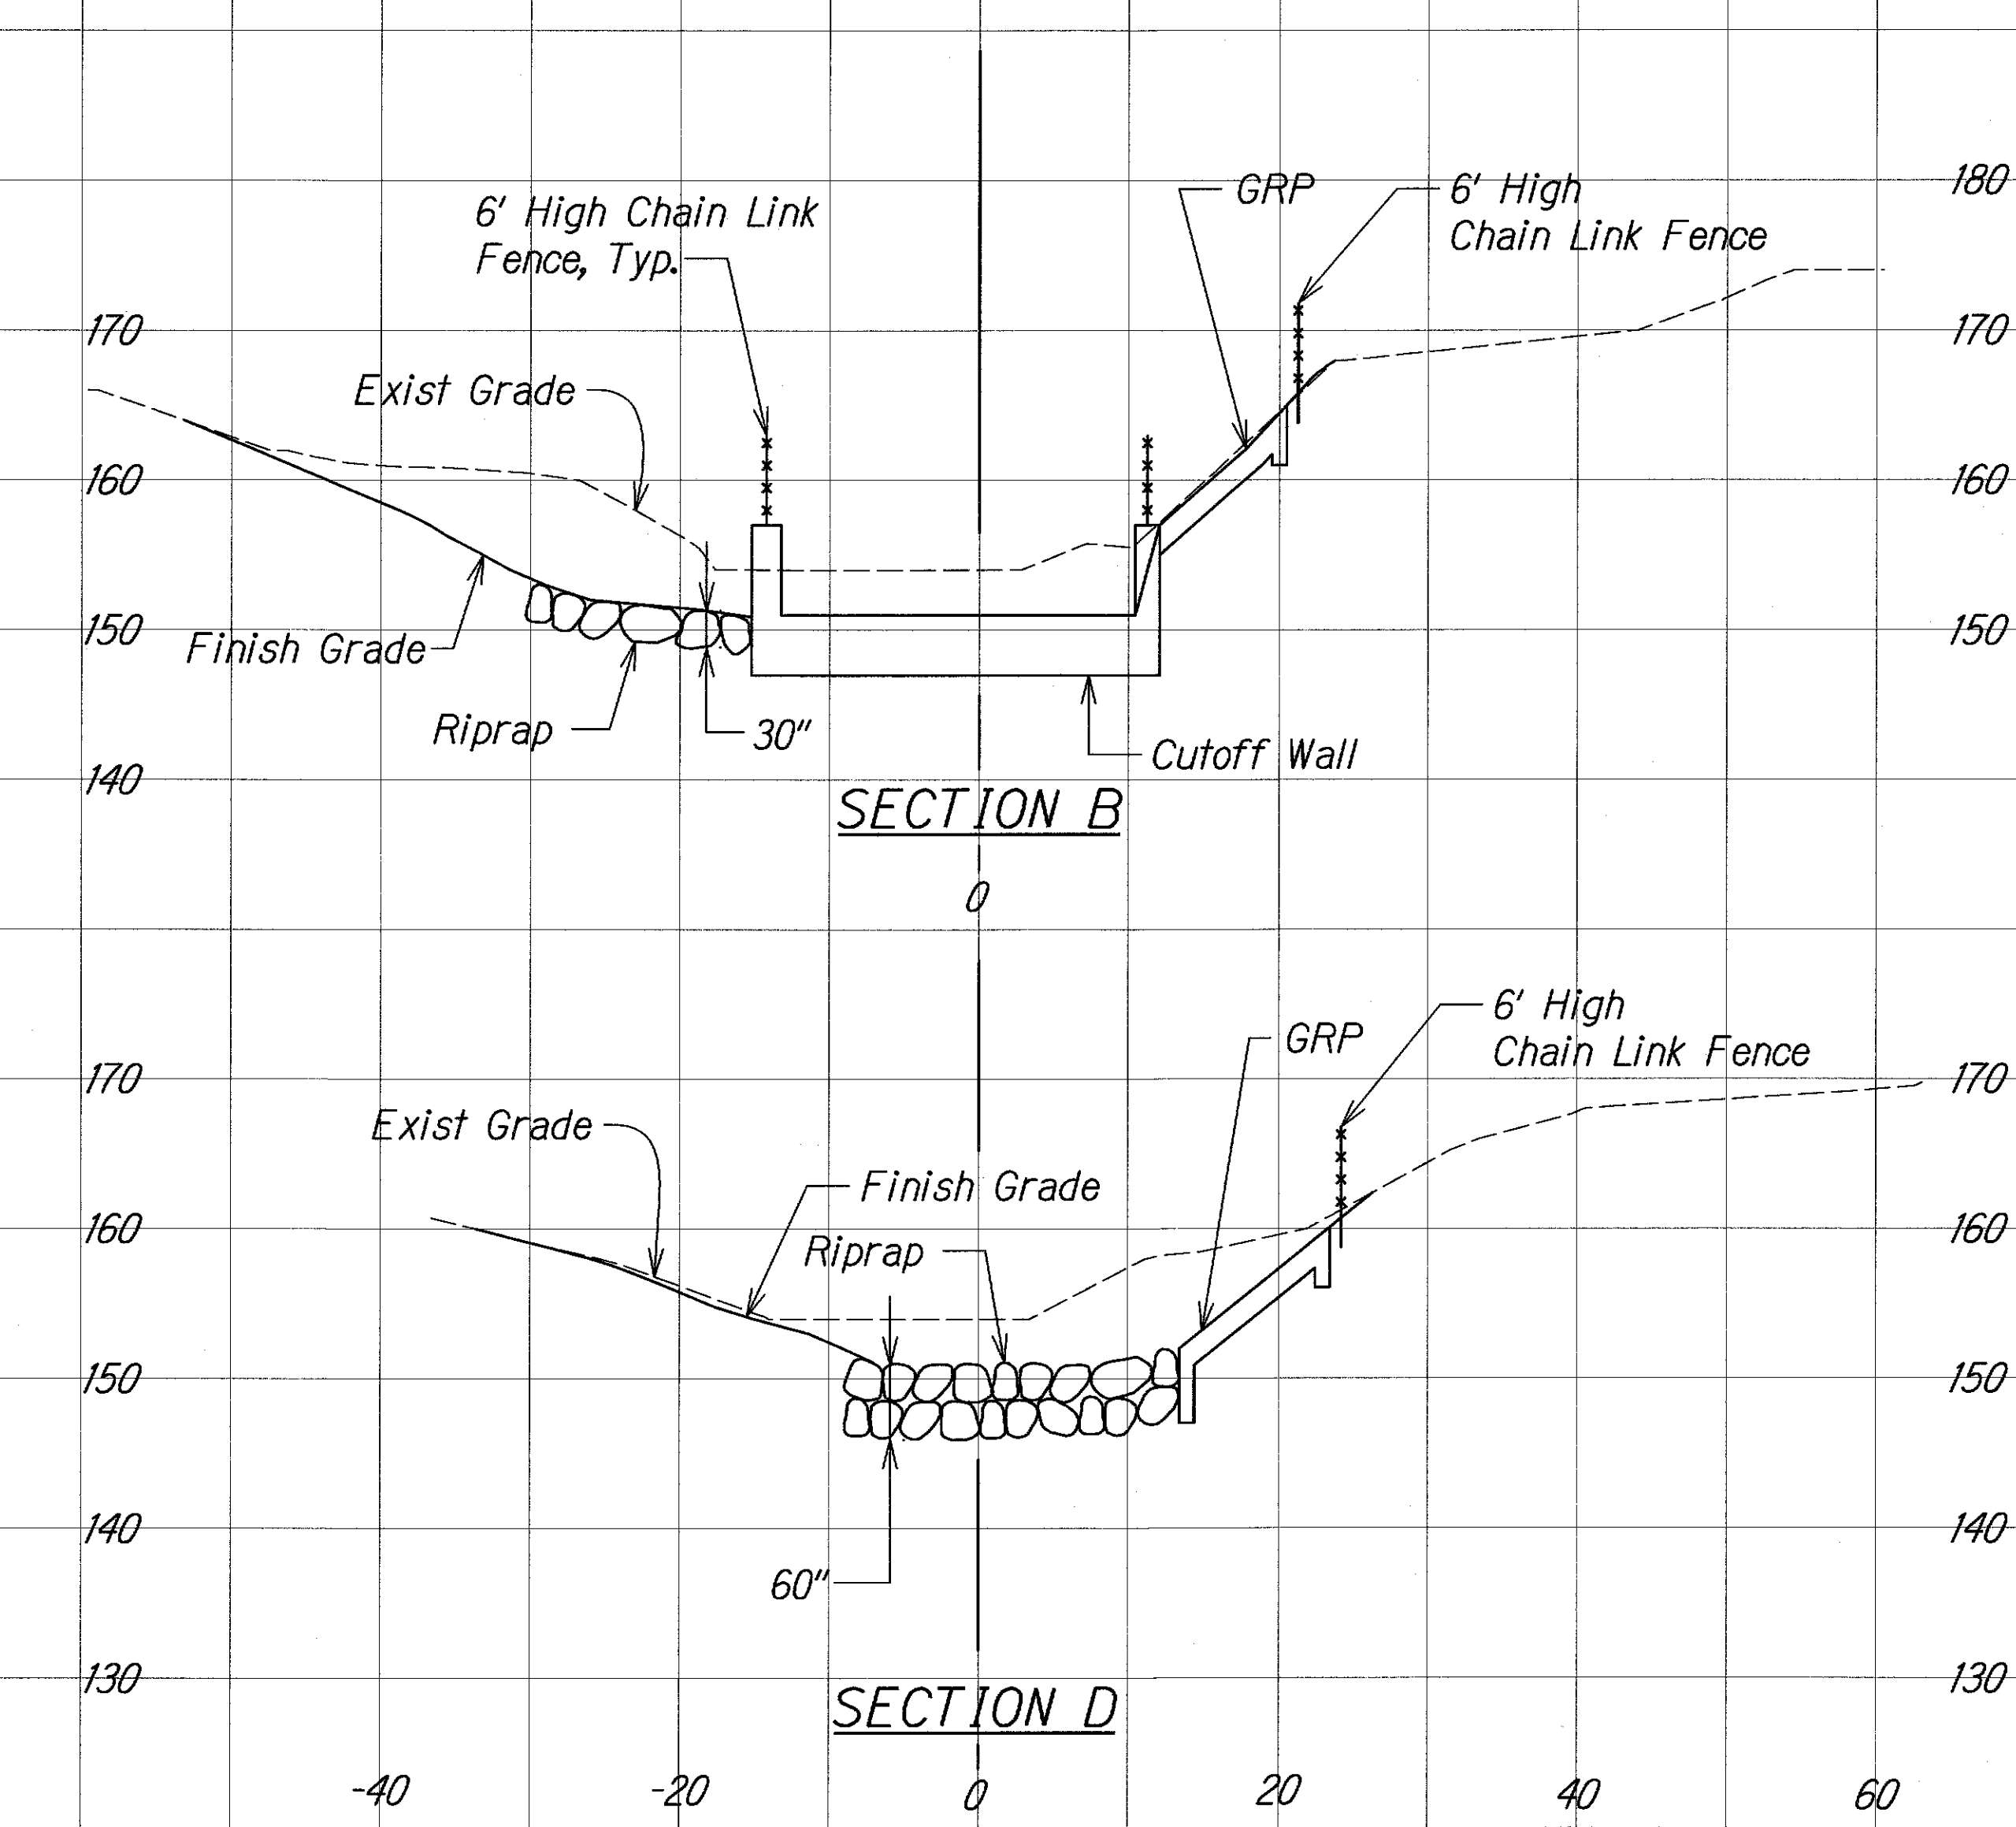


FED. ROAD DIST. NO.	STATE	FEDERAL AID PROJ. NO.	FISCAL YEAR	SHEET NO.	TOTAL SHEETS
HAWAII	HAW.	ER-16(001)	2012	7	29

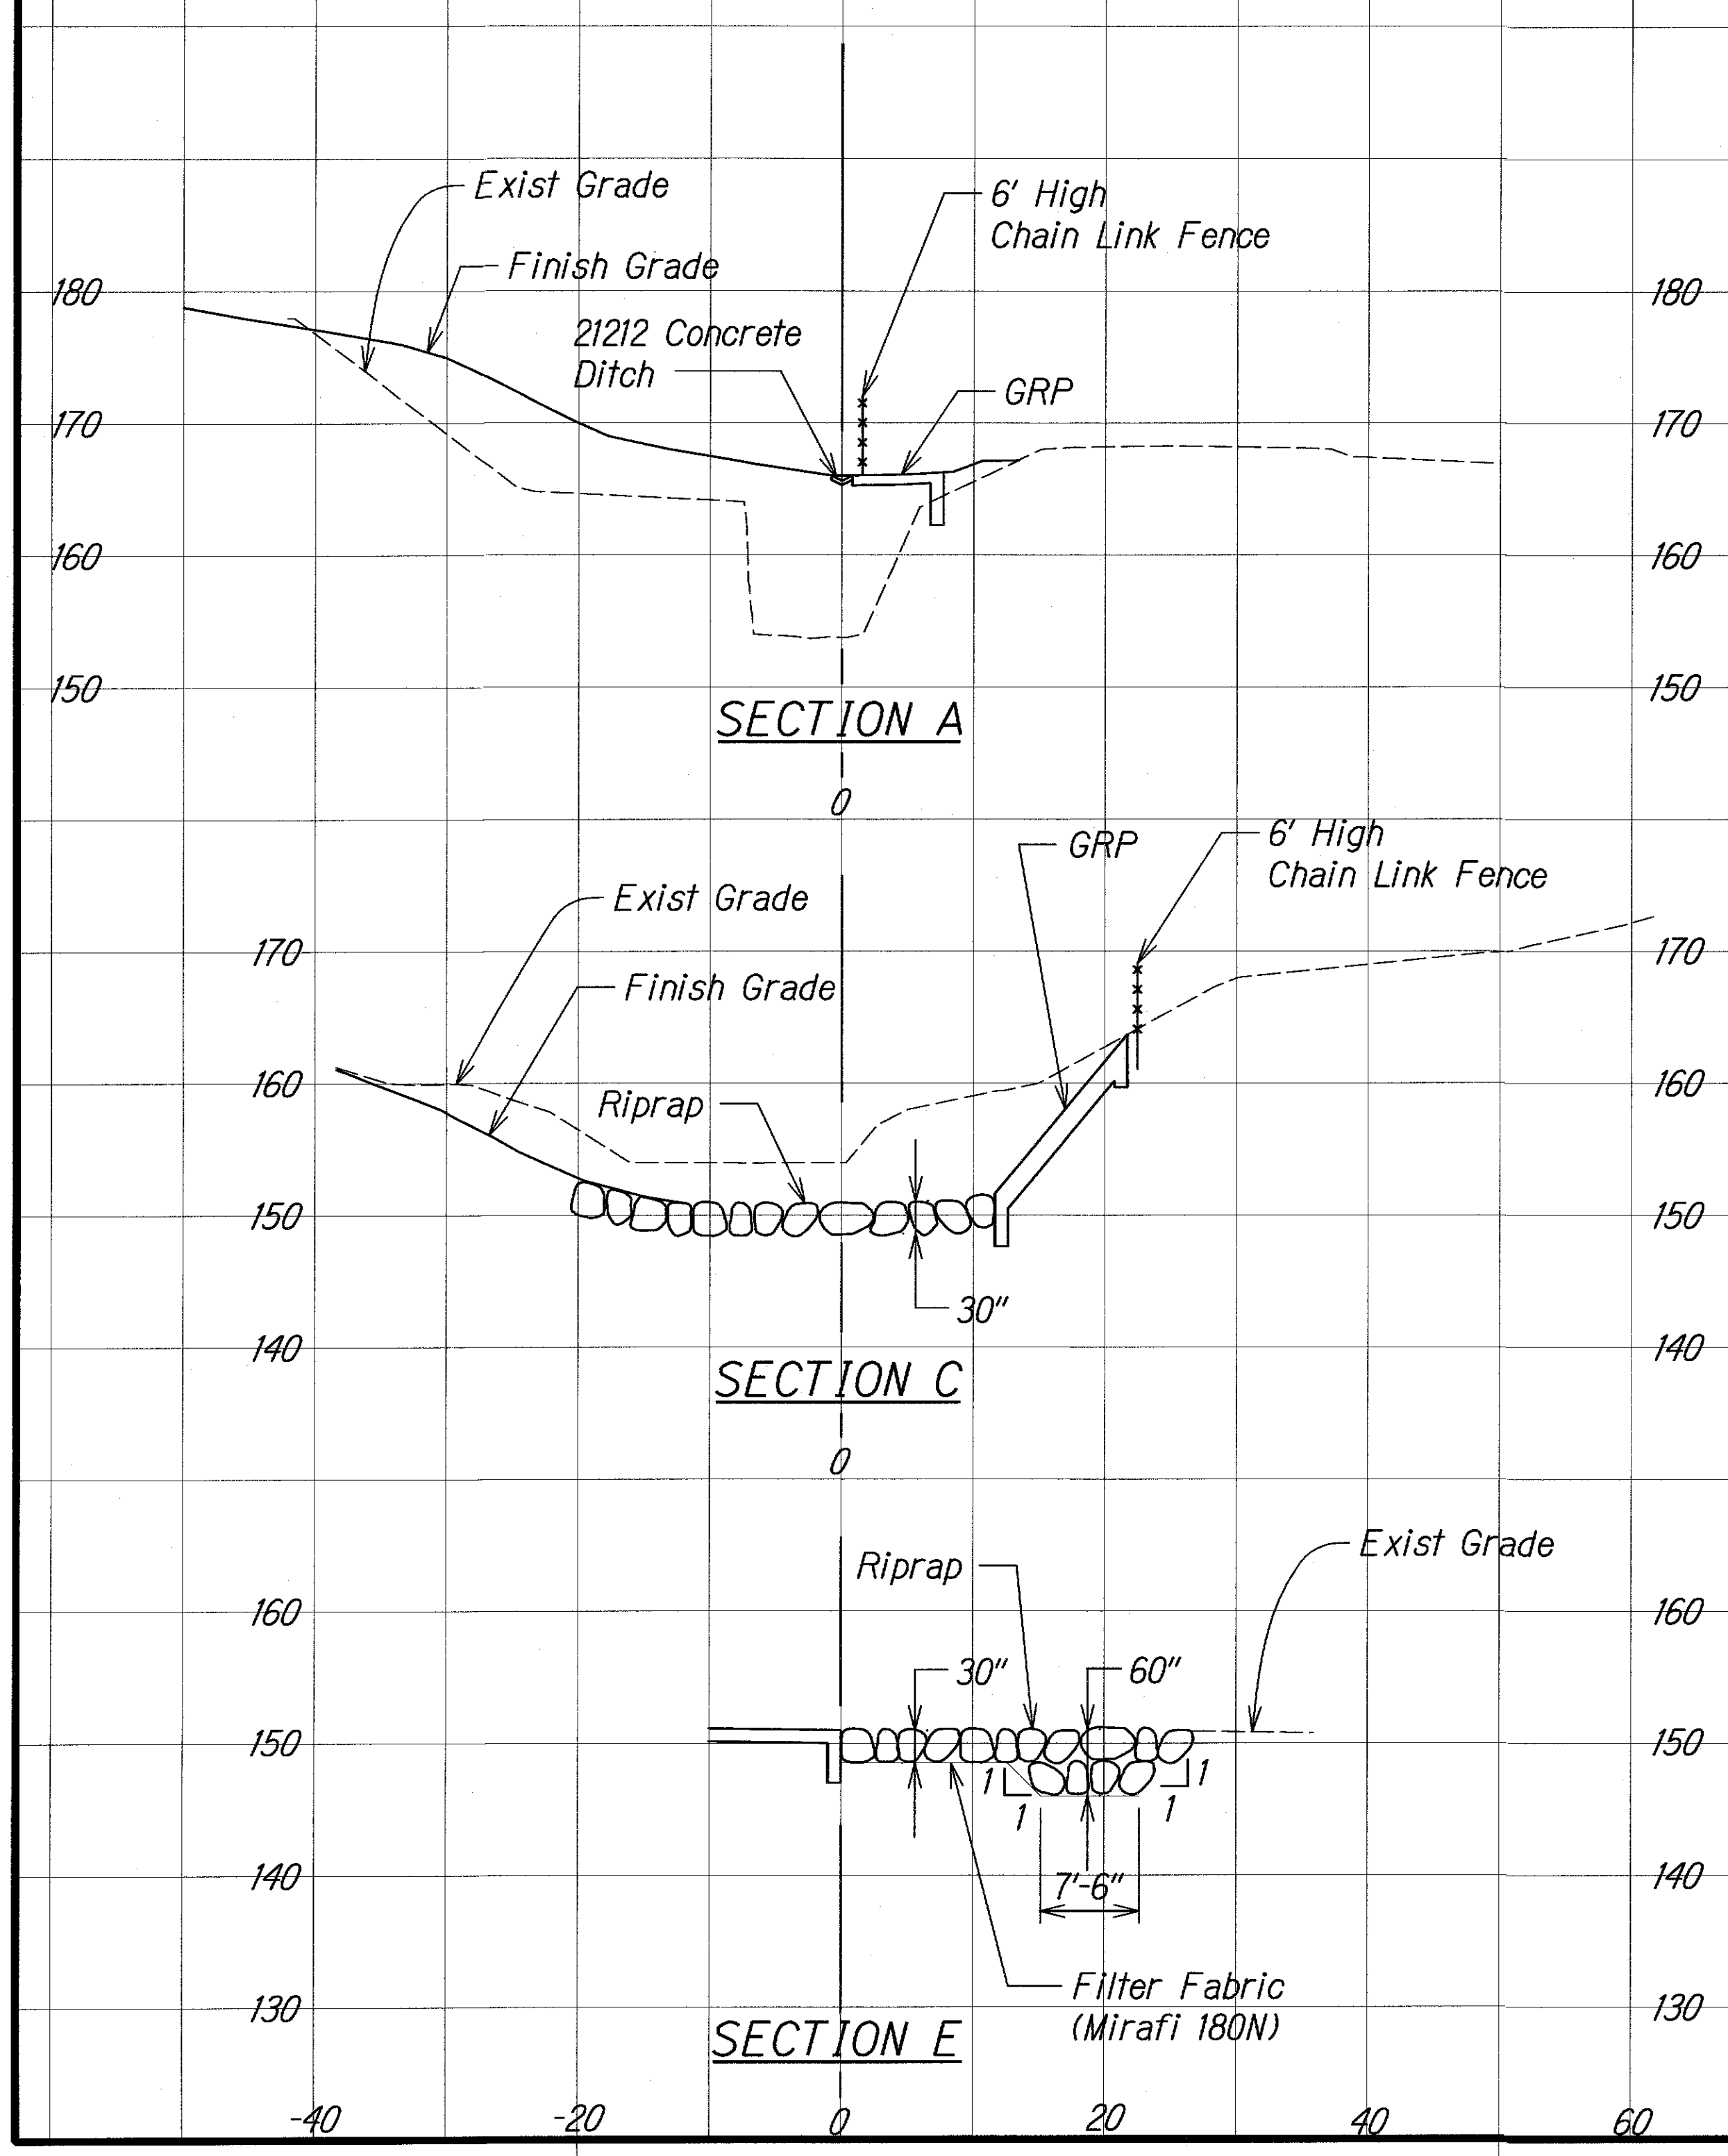

SCALE
 Horiz.: 1" = 10'
 Vert.: 1" = 10'

ORIGINAL PLAN	DATE
DESIGNED BY	
DRAWN BY	
CHECKED BY	
NOTED BY	
QUANTITIES BY	
REVISIONS	

STATE OF HAWAII
 DEPARTMENT OF TRANSPORTATION
 HIGHWAYS DIVISION

**KUHIO HIGHWAY
 OUTLET SECTIONS**

KUHIO HIGHWAY (ROUTE 56) EMERGENCY
 CULVERT REPLACEMENT IN KILAUEA AT M.P. 22.5
 Project No. ER-16(001)
 Scale: 1"=10' Date: May 23, 2012

SHEET No. C-6 OF 9 SHEETS