


FED. ROAD DIST. NO.	STATE	FEDERAL AID PROJ. NO.	FISCAL YEAR	SHEET NO.	TOTAL SHEETS
HAWAII	HAW.	ER-16(001)	2012	3	29

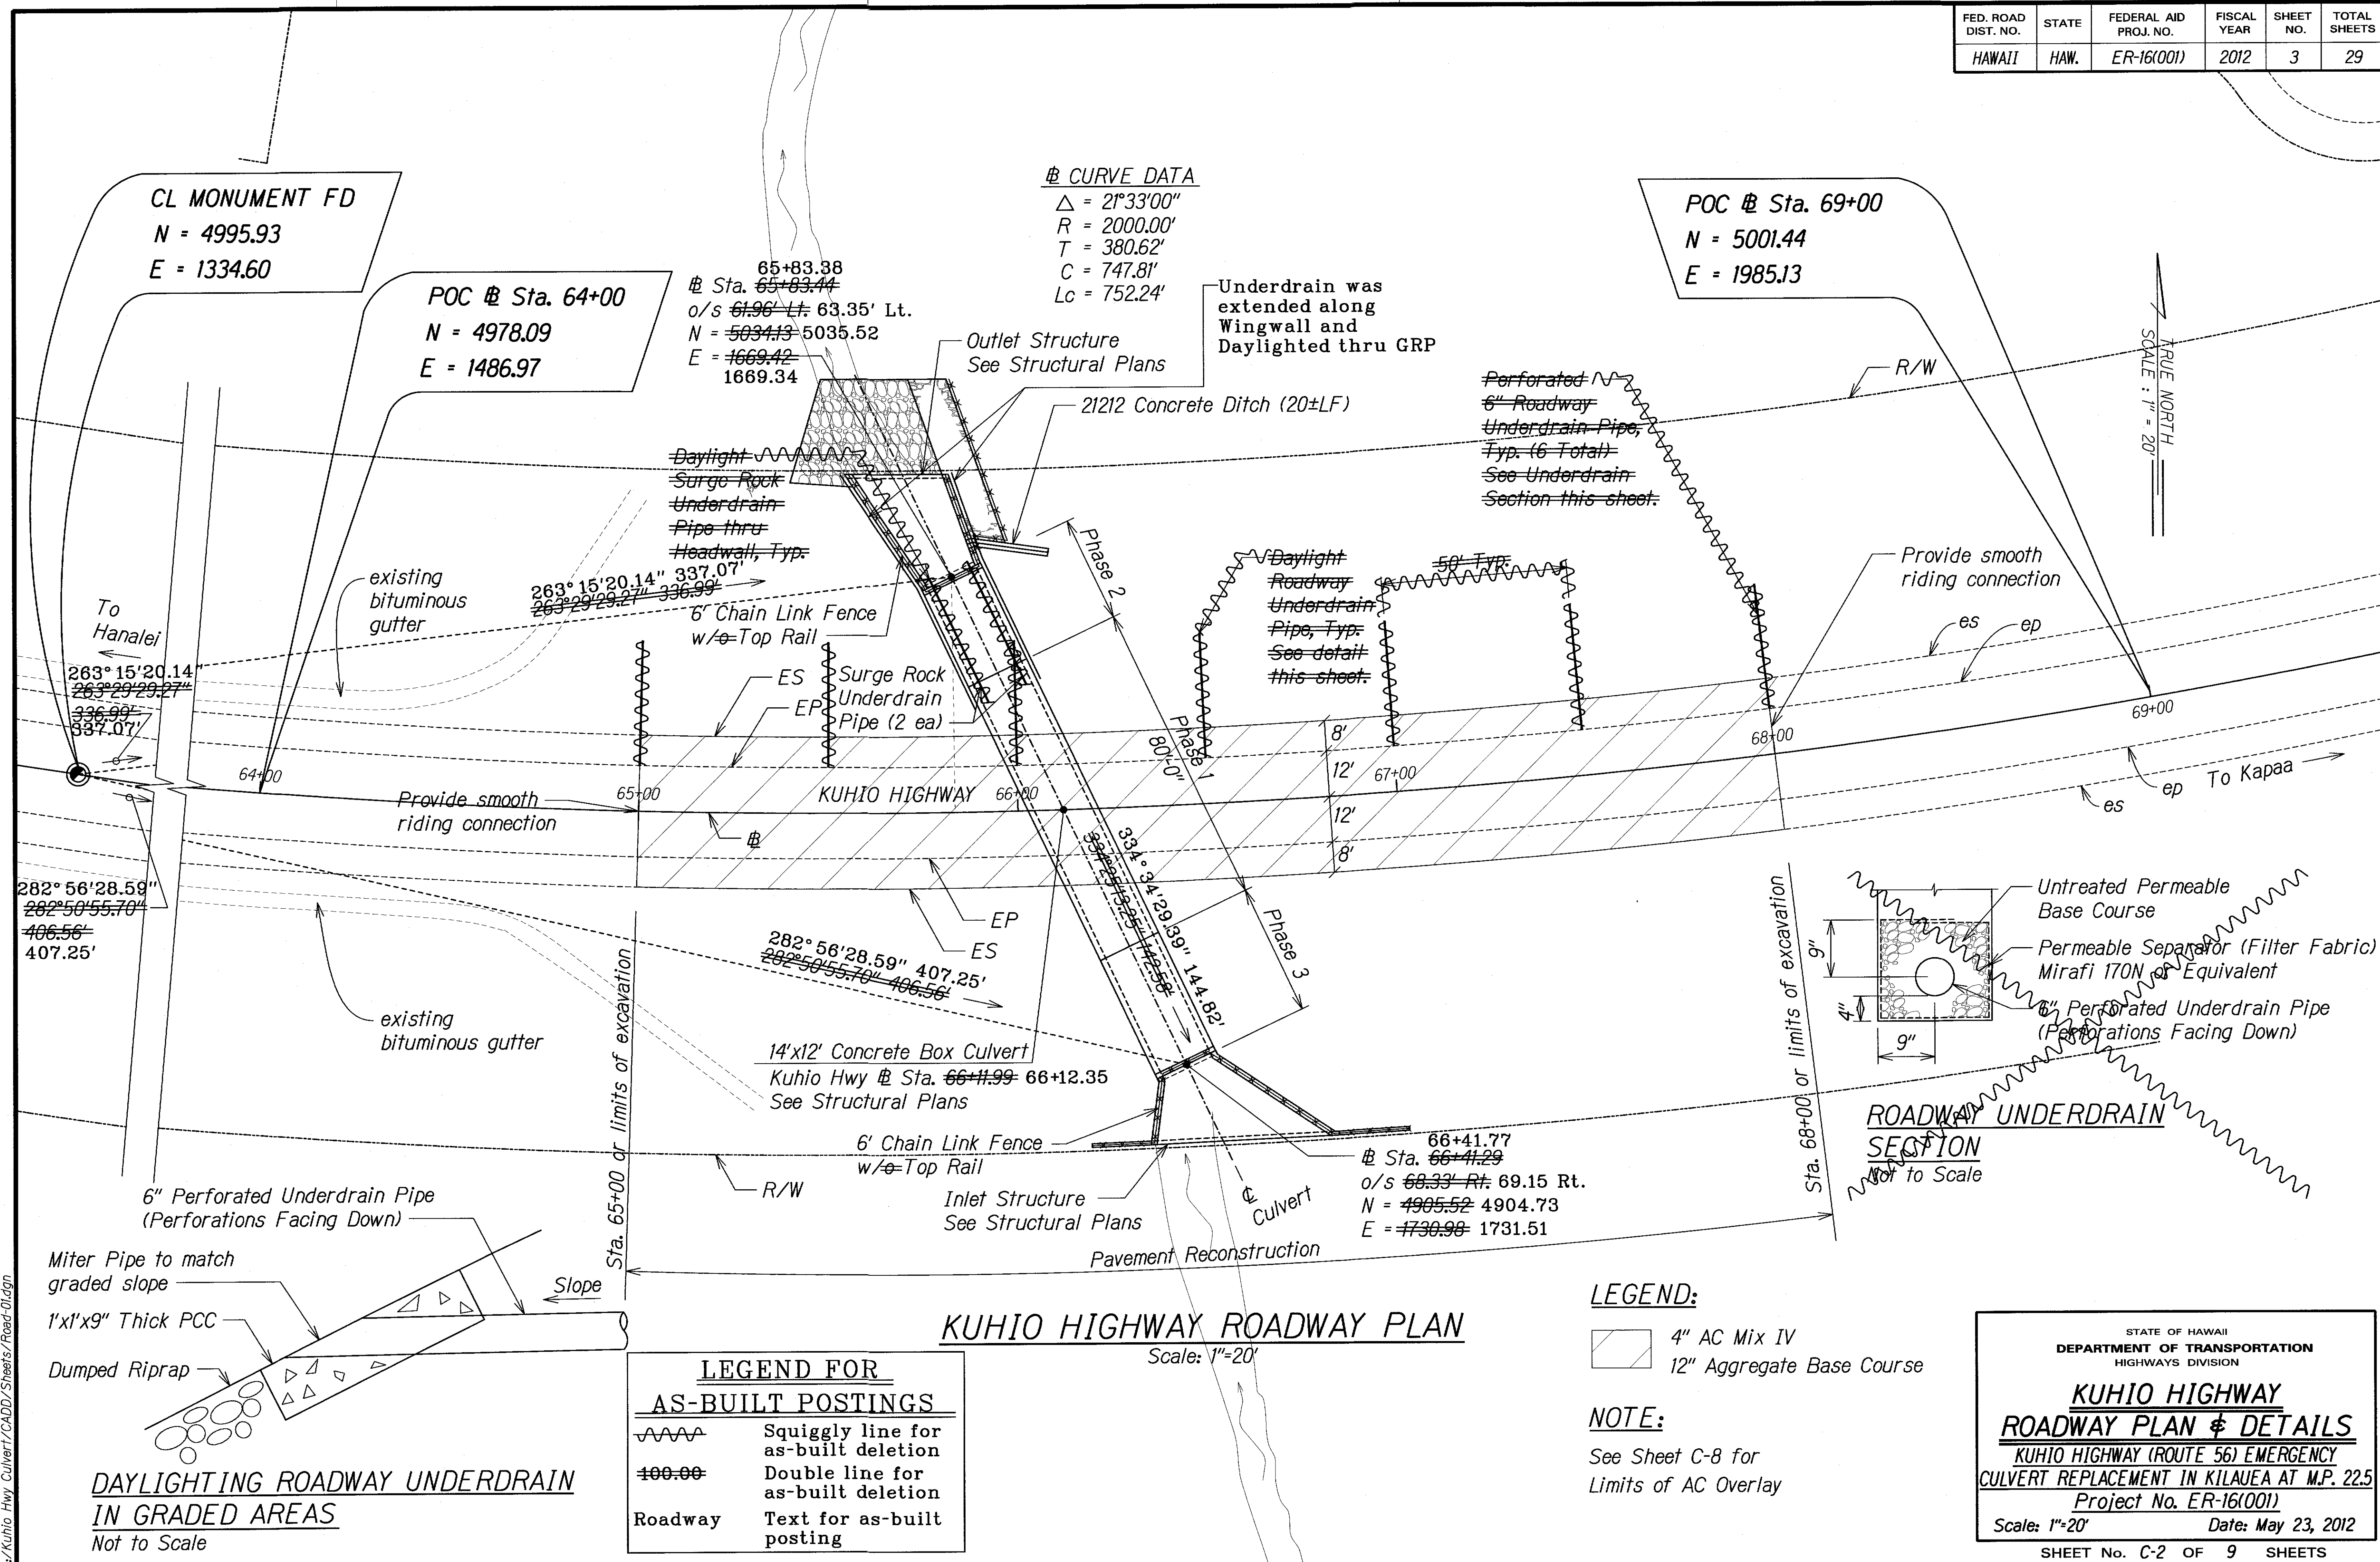

DATE	_____
SURVEY PLOTTED BY	_____
DRAWN BY	_____
CHECKED BY	_____
ORIGINAL PLAN	_____
NOTE BOOK	_____
CHECKED BY	_____

T-1/Kuhio Hwy Culvert/CADD/Sheets/Road/Algn

LEGEND:

- 4" AC Mix IV
- 12" Aggregate Base Course

NOTE:

See Sheet C-8 for
Limits of AC Overlay

LEGEND FOR AS-BUILT POSTINGS	
	Squiggly line for as-built deletion
	Double line for as-built deletion
Roadway	Text for as-built posting

STATE OF HAWAII
DEPARTMENT OF TRANSPORTATION
HIGHWAYS DIVISION

KUHIO HIGHWAY
ROADWAY PLAN & DETAILS
KUHIO HIGHWAY (ROUTE 56) EMERGENCY
CULVERT REPLACEMENT IN KILAUEA AT M.P. 22.5
Project No. ER-16(001)
Scale: 1"=20' Date: May 23, 2012
SHEET No. C-2 OF 9 SHEETS

"AS-BUILT"