
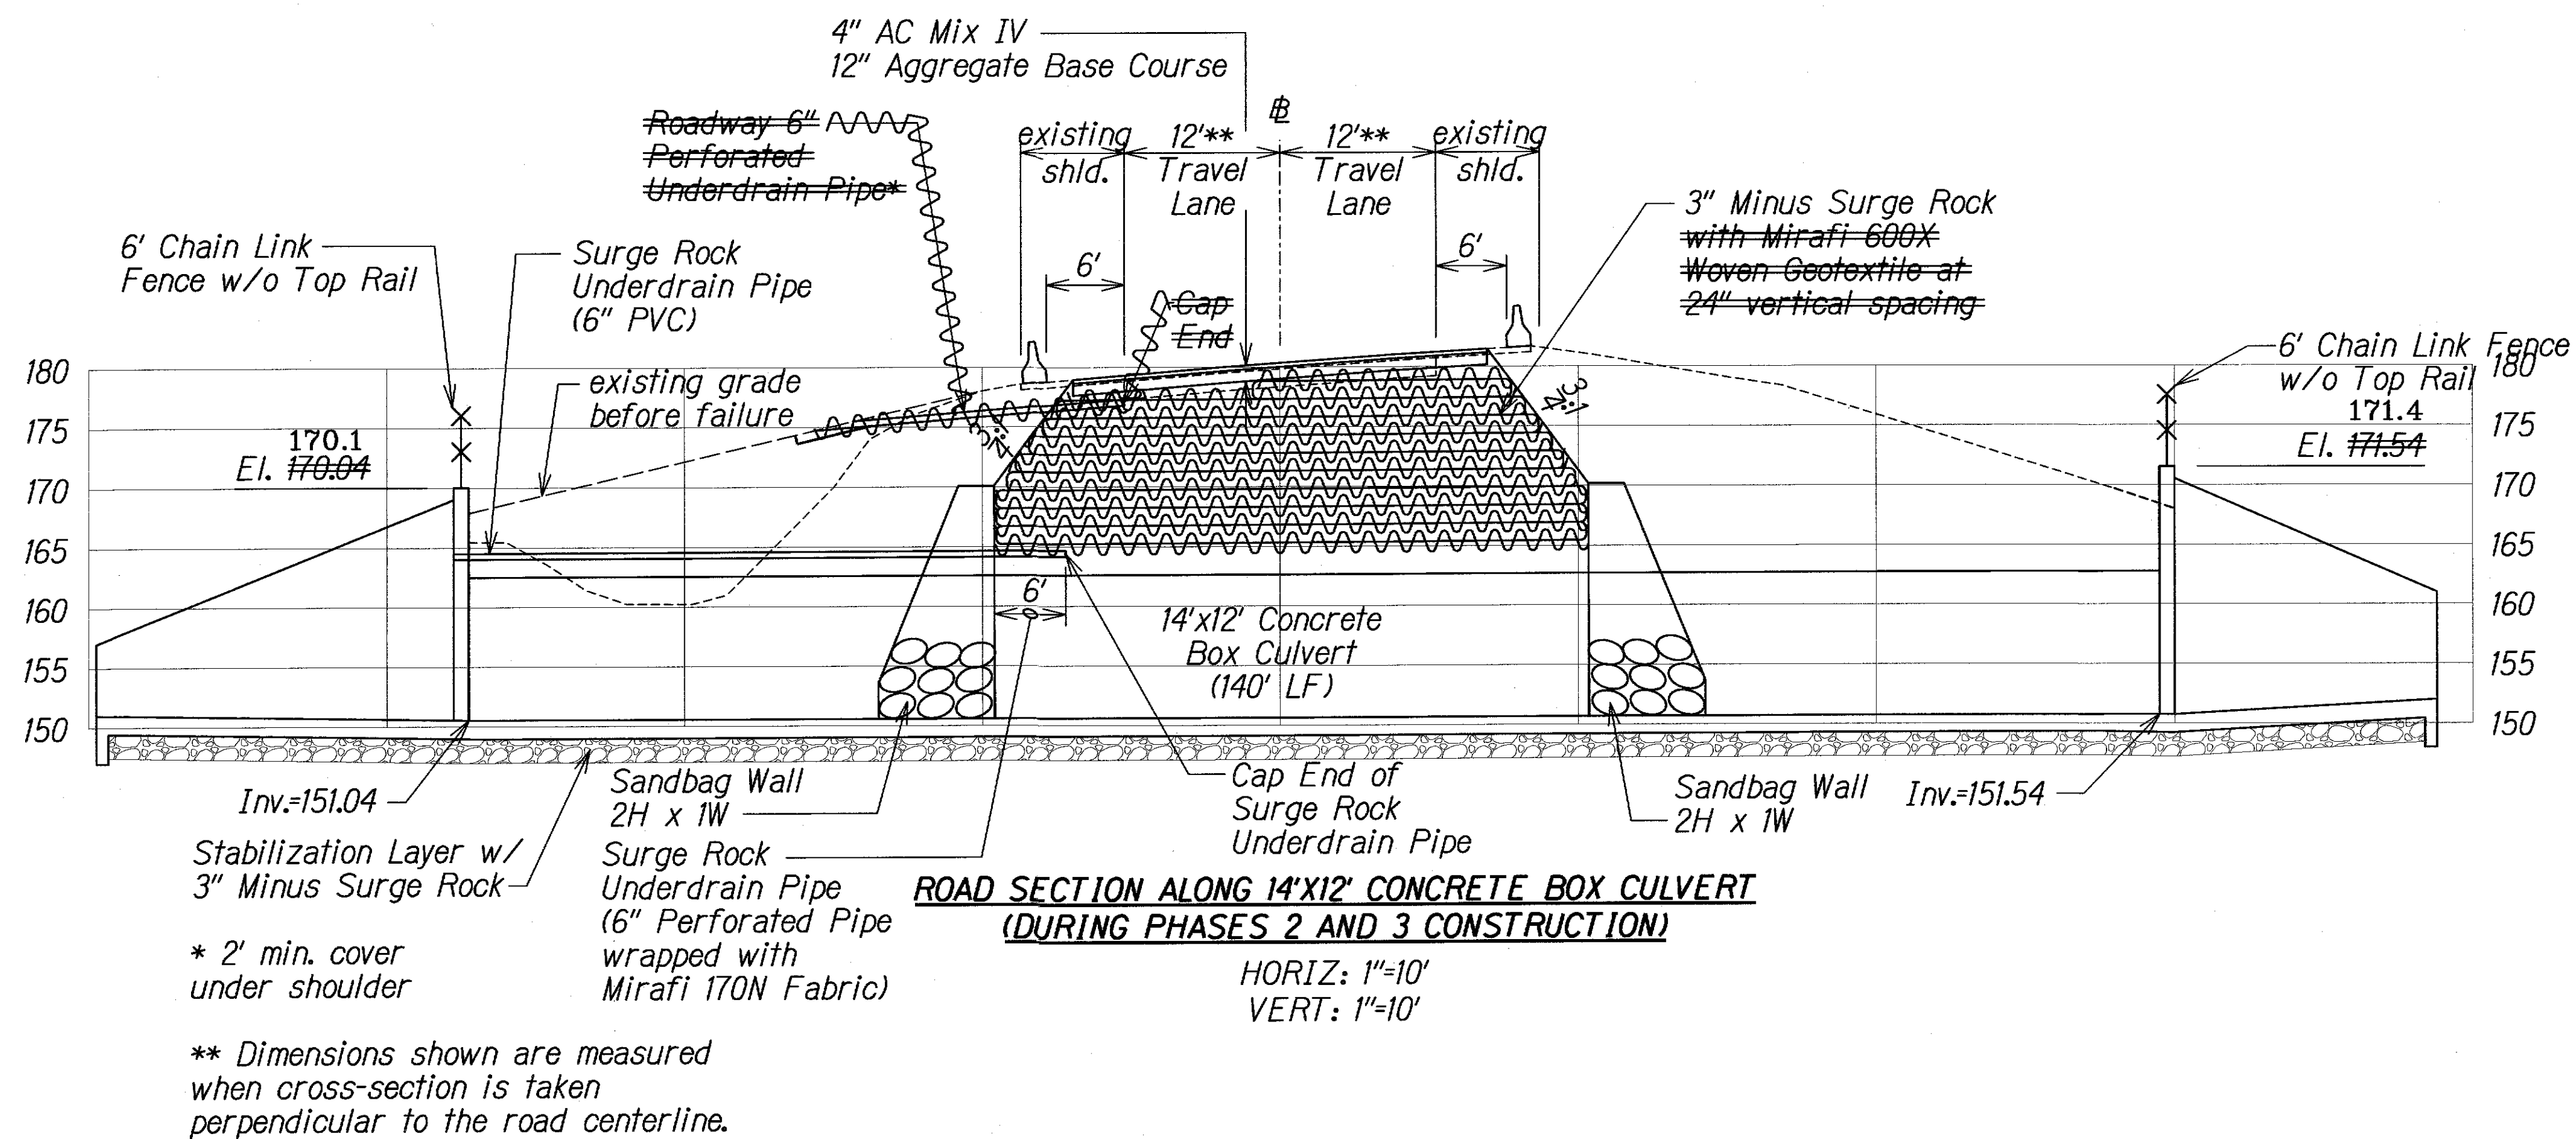
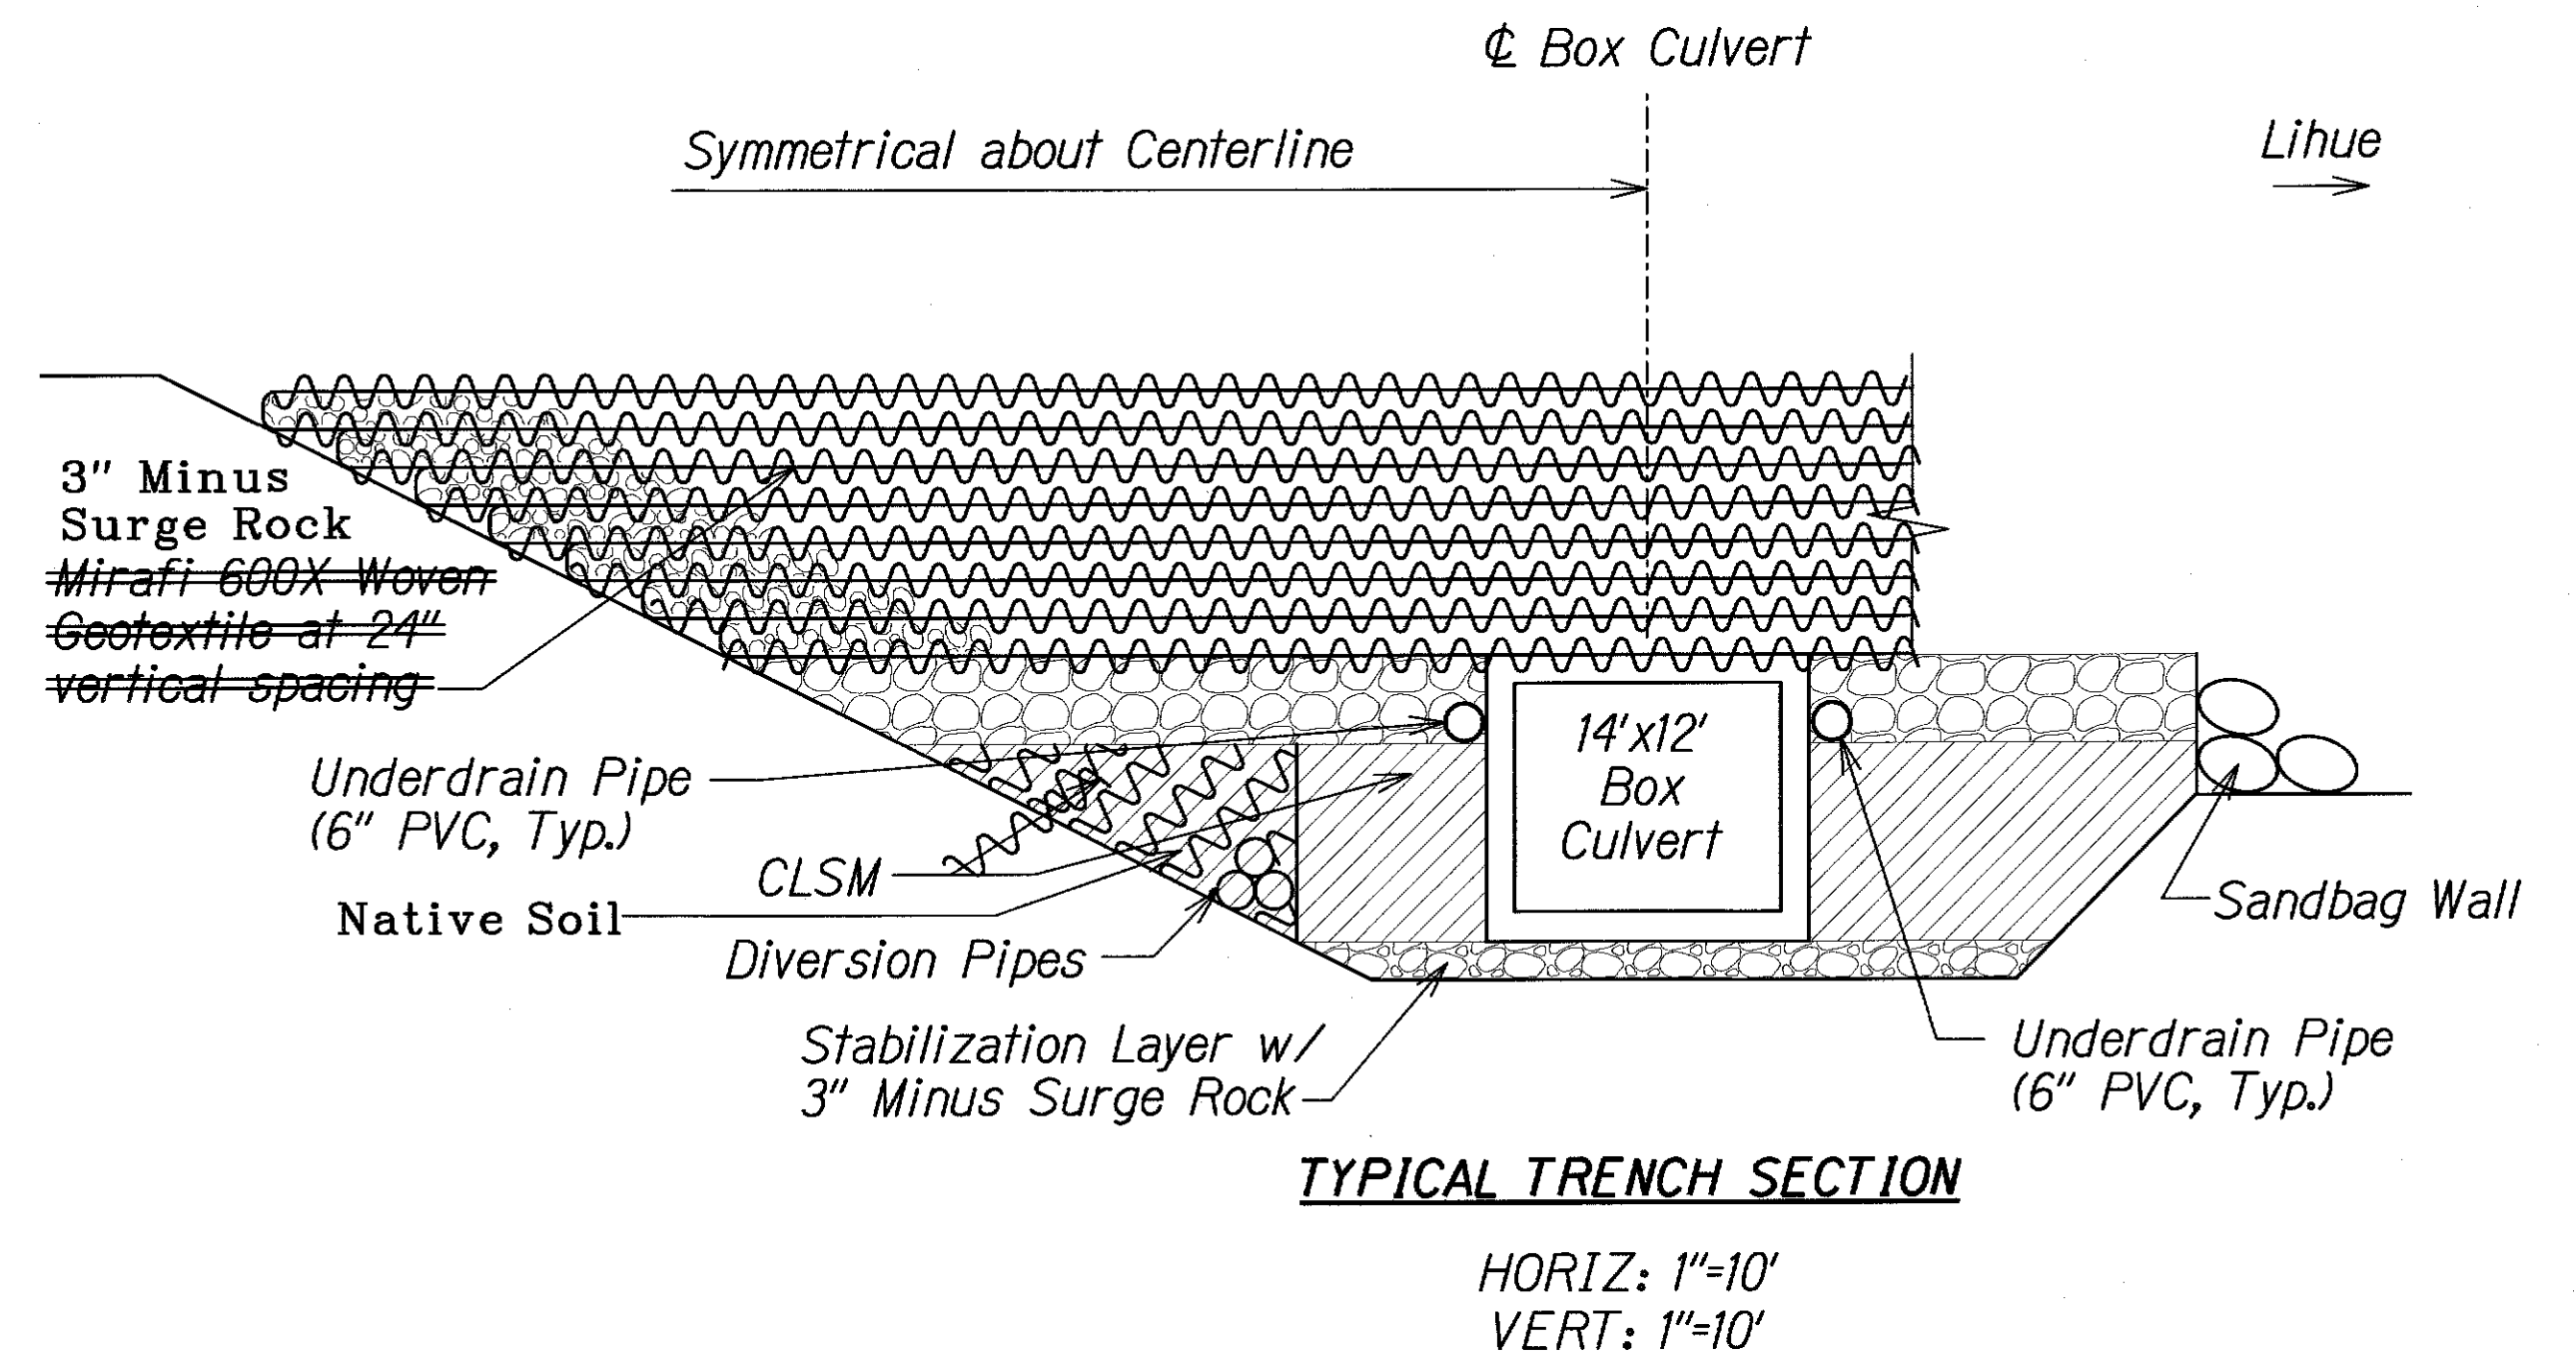


FED. ROAD DIST. NO.	STATE	FEDERAL AID PROJ. NO.	FISCAL YEAR	SHEET NO.	TOTAL SHEETS
HAWAII	HAW.	ER-16(001)	2012	2	29

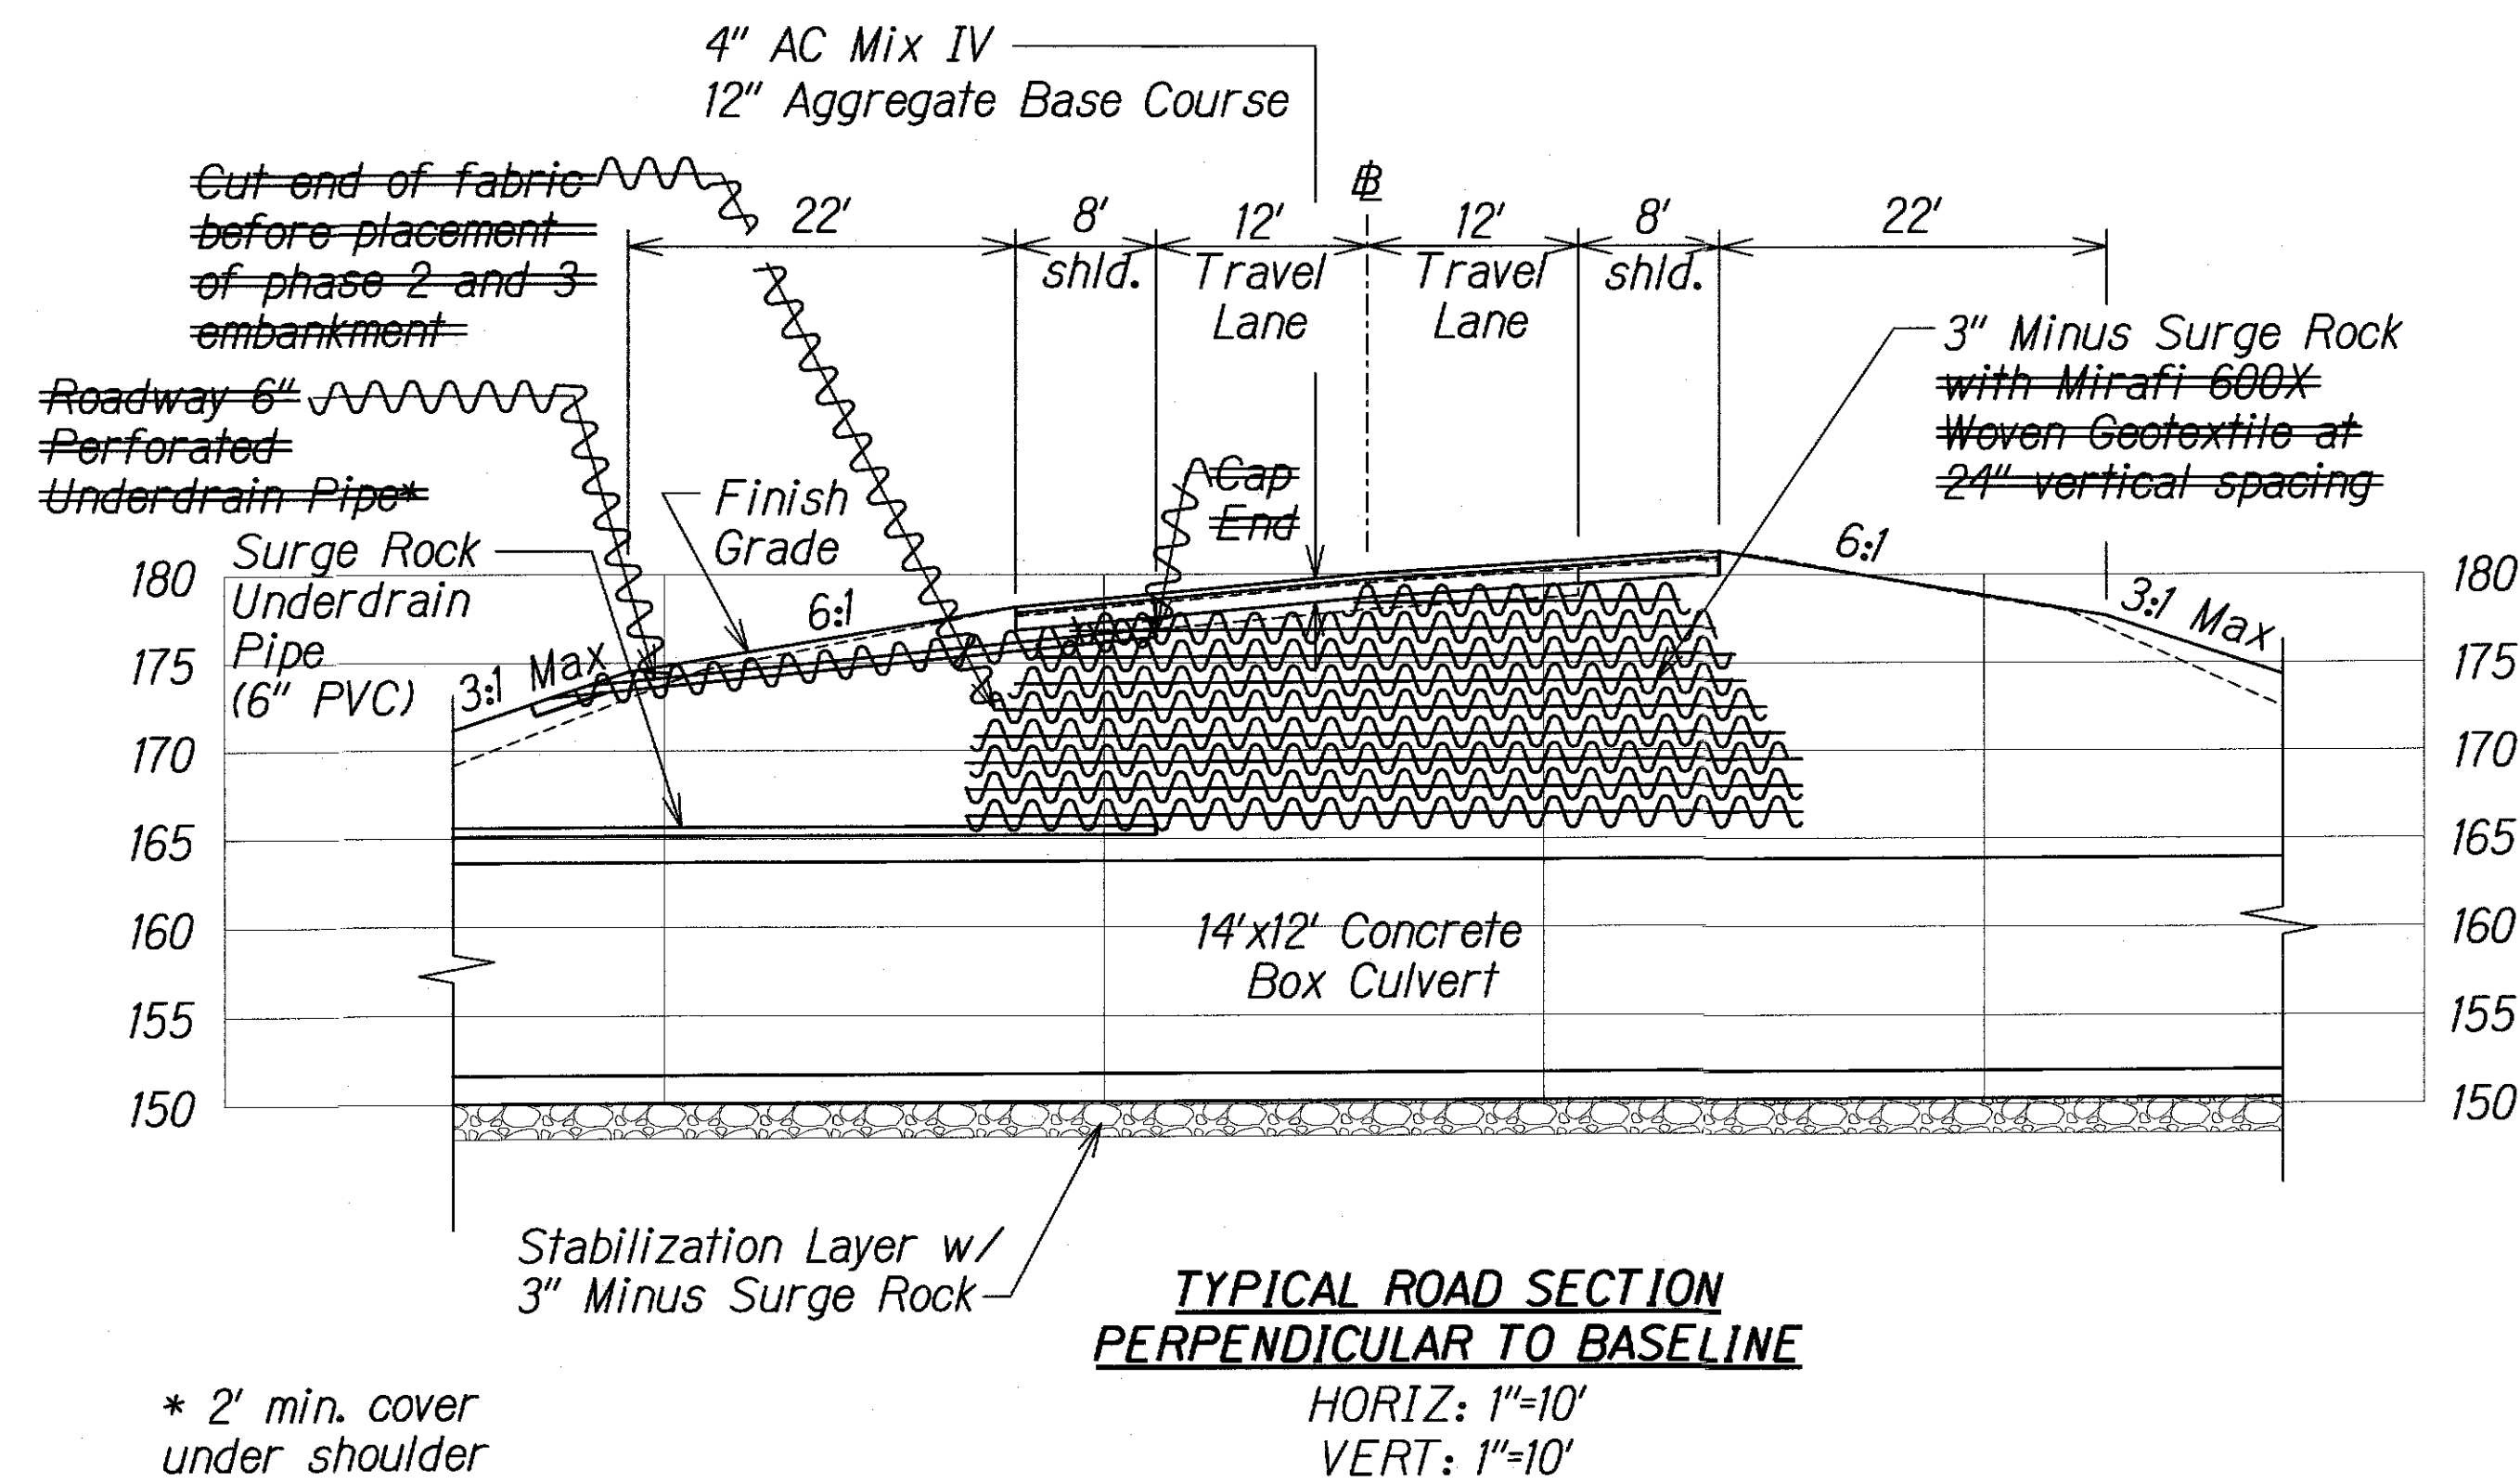

LEGEND FOR AS-BUILT POSTINGS	
	Squiggly line for as-built deletion
	Double line for as-built deletion
Roadway	Text for as-built posting

STATE OF HAWAII
DEPARTMENT OF TRANSPORTATION
HIGHWAYS DIVISION

KUHIO HIGHWAY
TYPICAL SECTIONS
KUHIO HIGHWAY (ROUTE 56) EMERGENCY
CULVERT REPLACEMENT IN KILAUEA AT M.P. 22.5
Project No. ER-16(001)
Scale: As shown Date: May 23, 2012
SHEET No. C-1 OF 9 SHEETS