


FED. ROAD DIST. NO.	STATE	FEDERAL AID PROJ. NO.	FISCAL YEAR	SHEET NO.	TOTAL SHEETS
HAWAII	HAW.	ER-16(003)	2020	11	48

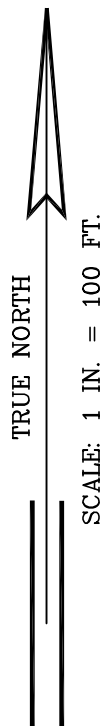

Lot 18
Tax Map Key: 5-2-017: 018
Scott Kagan
Marisa Kagan
Richard H. Tee Stanley
Merdes Karst, Trust
Jungle Tribe
The Gleeson Allemann Family, Trust
(Owners)

Lot 17
Tax Map Key: 5-2-017: 017
Pepperwood Plantations
Steinberg Living Trust
Pepperwood Living Trust
Starchild Living Trust
Jessie L. Shook
Willie H. Shook
Danny M. Shook
Gale H. Shook
(Owners)

Lot 16
Tax Map Key: 5-2-017: 016
Opalipali Condominium
Charles K. Hammond
Craig W. Archambault
Robert Turchyn
Susan Galey, Trust
Margaret Turchyn
Thomas C. Dikeman
Jeannette Rothweiler
John Pickford
Noelene Pickford
(Owners)

Lot 15
Tax Map Key: 5-2-017: 015
Linzmeir Condominium
Alfred Aragona, Trust
(Owner)

Lot 14
Tax Map Key: 5-2-017: 014
Brenden Condominium
Jerry R. Brenden, Trust
Diane P. Brenden, Trust
(Owners)

Tax Map Key: 5-3-001: 015
Princeville Development LLC
(Owner)

NOTES:

ORIGIN OF AZIMUTH "POOKU" Δ
COORDINATES REFERRED TO "POOKU" Δ

- DENOTES ACCESS PERMITTED
- DENOTES NO VEHICLE ACCESS PERMITTED
- DENOTES NO ACCESS PERMITTED
- DENOTES LIMITED ACCESS AS NOTED ON PLAN
(Access Permitted Under Highway Structure Only)

04/30/2020

STATE OF HAWAII
DEPARTMENT OF TRANSPORTATION
HIGHWAYS DIVISION

PARCEL MAP
AND CONSTRUCTION PARCEL

KUHIO HIGHWAY
Emergency Slope Stabilization
in the Vicinity of Kalihiwai Bridge
Federal-Aid Project No. ER-16(003)

Scale: As Shown Date: July 2019

SHEET No. C-3 OF 3 SHEETS