



FED. ROAD DIST. NO.	STATE	FEDERAL AID PROJ. NO.	FISCAL YEAR	SHEET NO.	TOTAL SHEETS
HAWAII	HAW.	ER-16(003)	2020	22	48

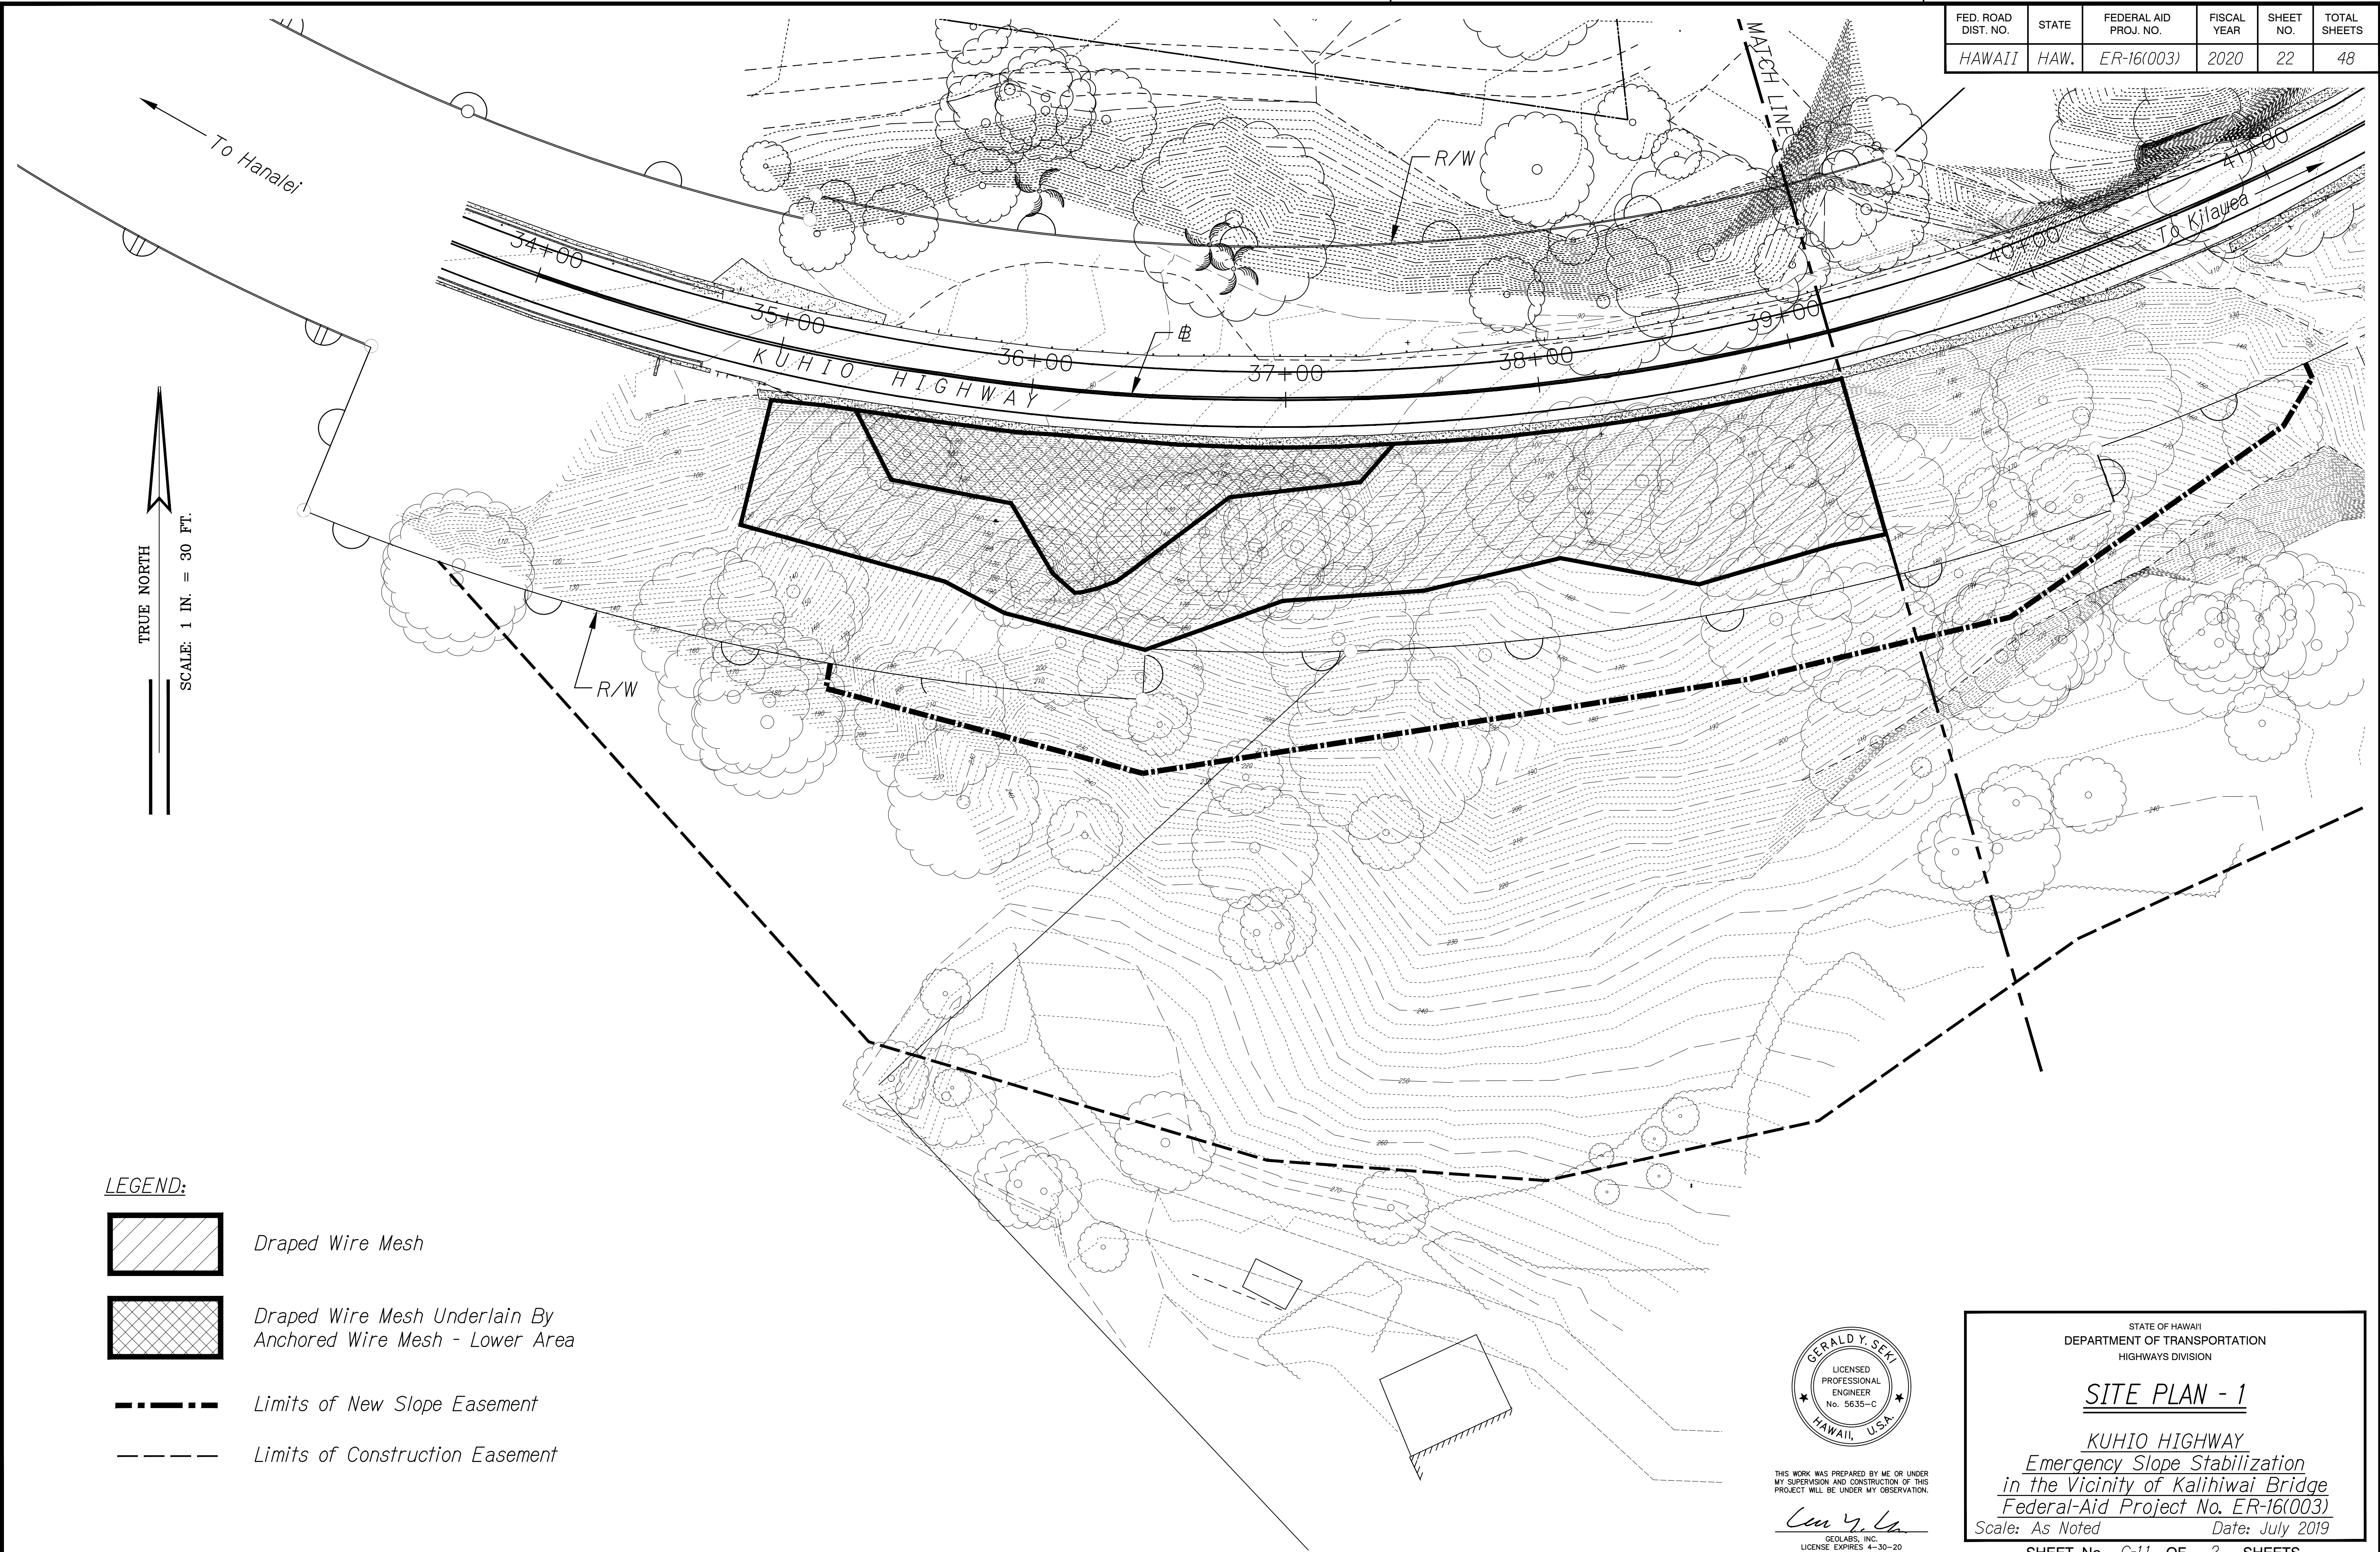


DRAWING NAME: 1. DRAFTING COMPLETED 6/7/21 - 00KALHIWABRIDGESLOPESTABILIZATION.DWG PLOT TIME: 07-05-19, 4:02 PM

ORIGINAL PLAN	DATE
DESIGNED BY	
TRACED BY	
NOTED BY	
CHECKED BY	

LEGEND:

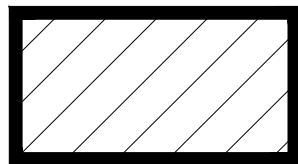


Draped Wire Mesh

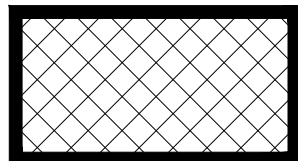

Draped Wire Mesh Underlain By Anchored Wire Mesh - Lower Area



Limits of New Slope Easement

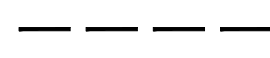

Limits of Construction Easement



THIS WORK WAS PREPARED BY ME OR UNDER MY SUPERVISION AND CONSTRUCTION OF THIS PROJECT WILL BE UNDER MY OBSERVATION.
Lee Y. Lee
GEOLABS, INC.
LICENSE EXPIRES 4-30-20

STATE OF HAWAII
DEPARTMENT OF TRANSPORTATION
HIGHWAYS DIVISION

SITE PLAN - 1

KUHIO HIGHWAY
Emergency Slope Stabilization
in the Vicinity of Kalihiwai Bridge
Federal-Aid Project No. ER-16(003)

Scale: As Noted Date: July 2019

SHEET No. *G-1.1* OF 2 SHEETS

