


| FED. ROAD DIST. NO. | STATE | FED-AID PROJ. NO. | FISCAL YEAR | SHEET NO. | TOTAL SHEETS |
|---------------------|-------|-------------------|-------------|-----------|--------------|
| HAWAII              | HAW.  | NH-056-1(058)     | 2017        | 29        | 30           |




D1-2-1  
Not to Scale

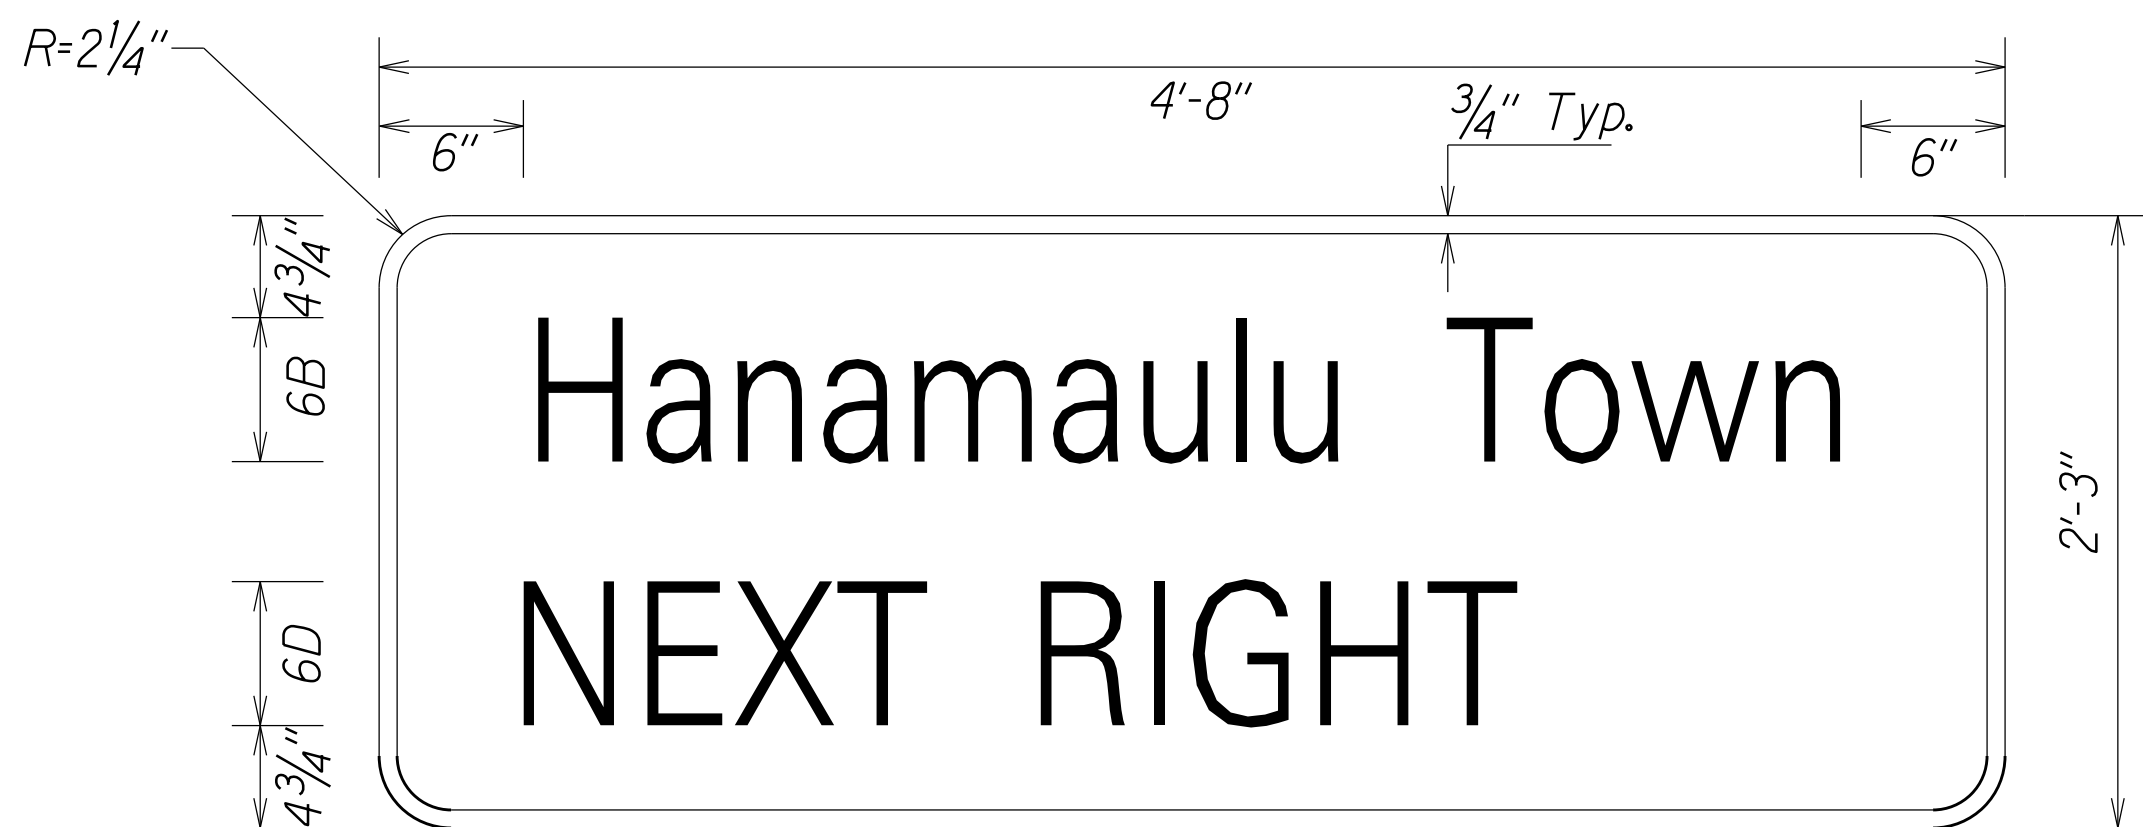

Sign support: 2-Flanged  
Channel (4.00 lbs/ft.)


D1-2-2  
Not to Scale

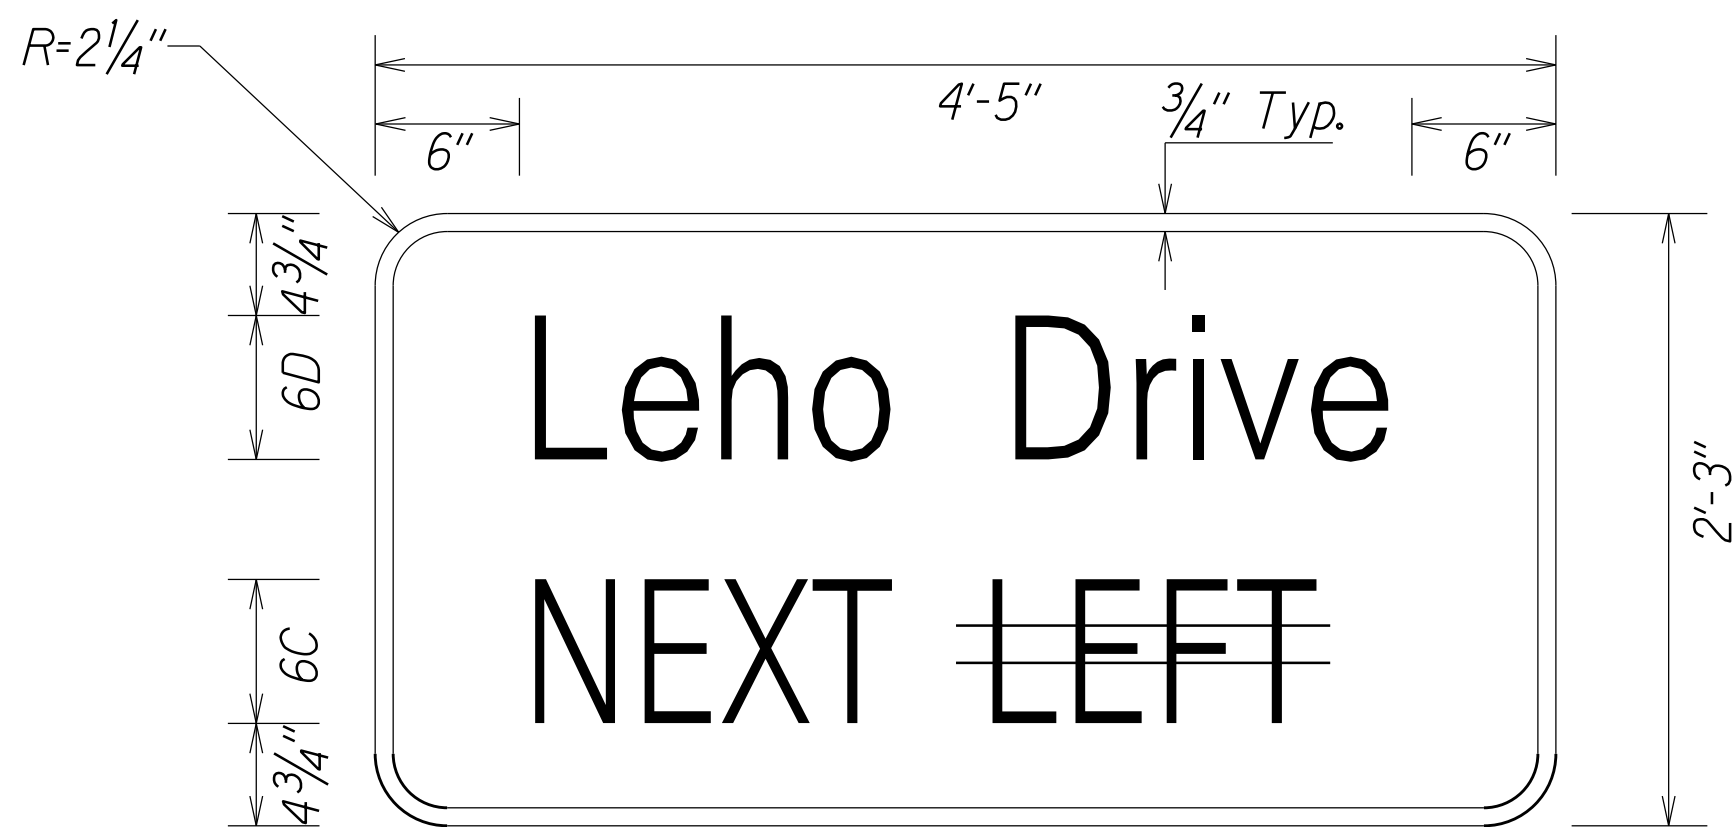

Sign support: 2-Flanged  
Channel (4.00 lbs/ft.)


D1-2-3  
Not to Scale

Right

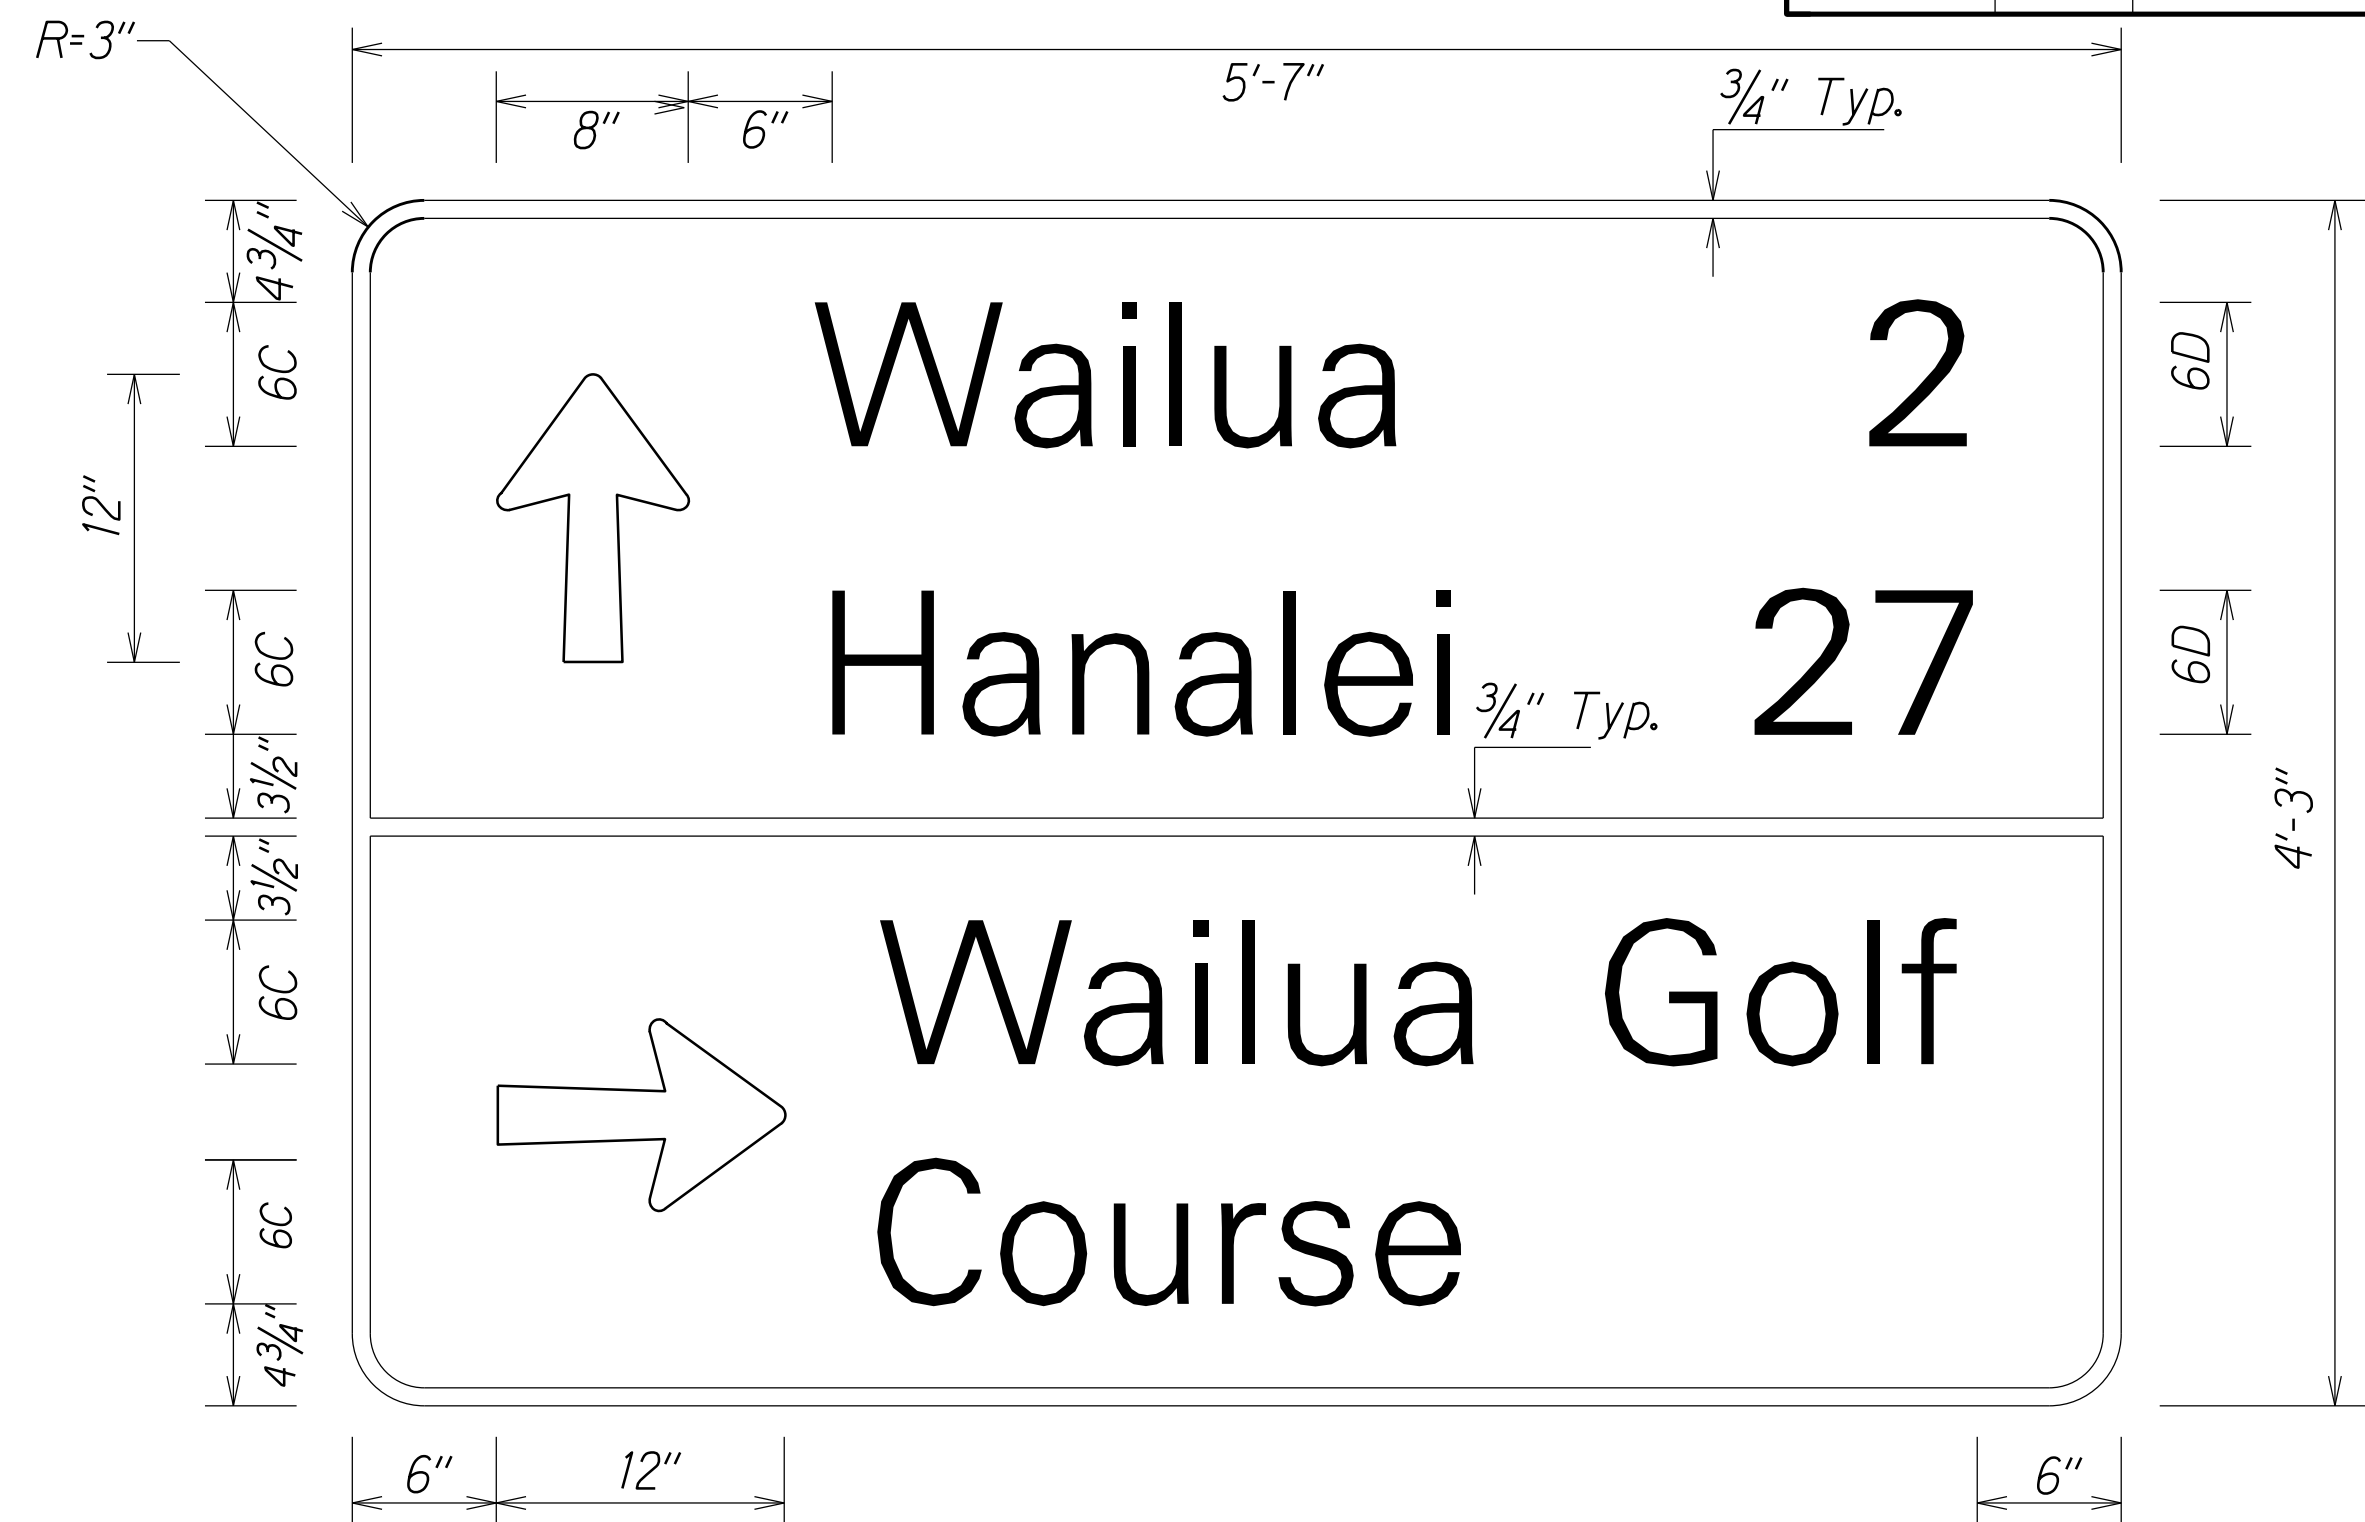

Sign support: 3-Flanged  
Channel (4.00 lbs/ft.)

D1-3a-1  
Not to Scale

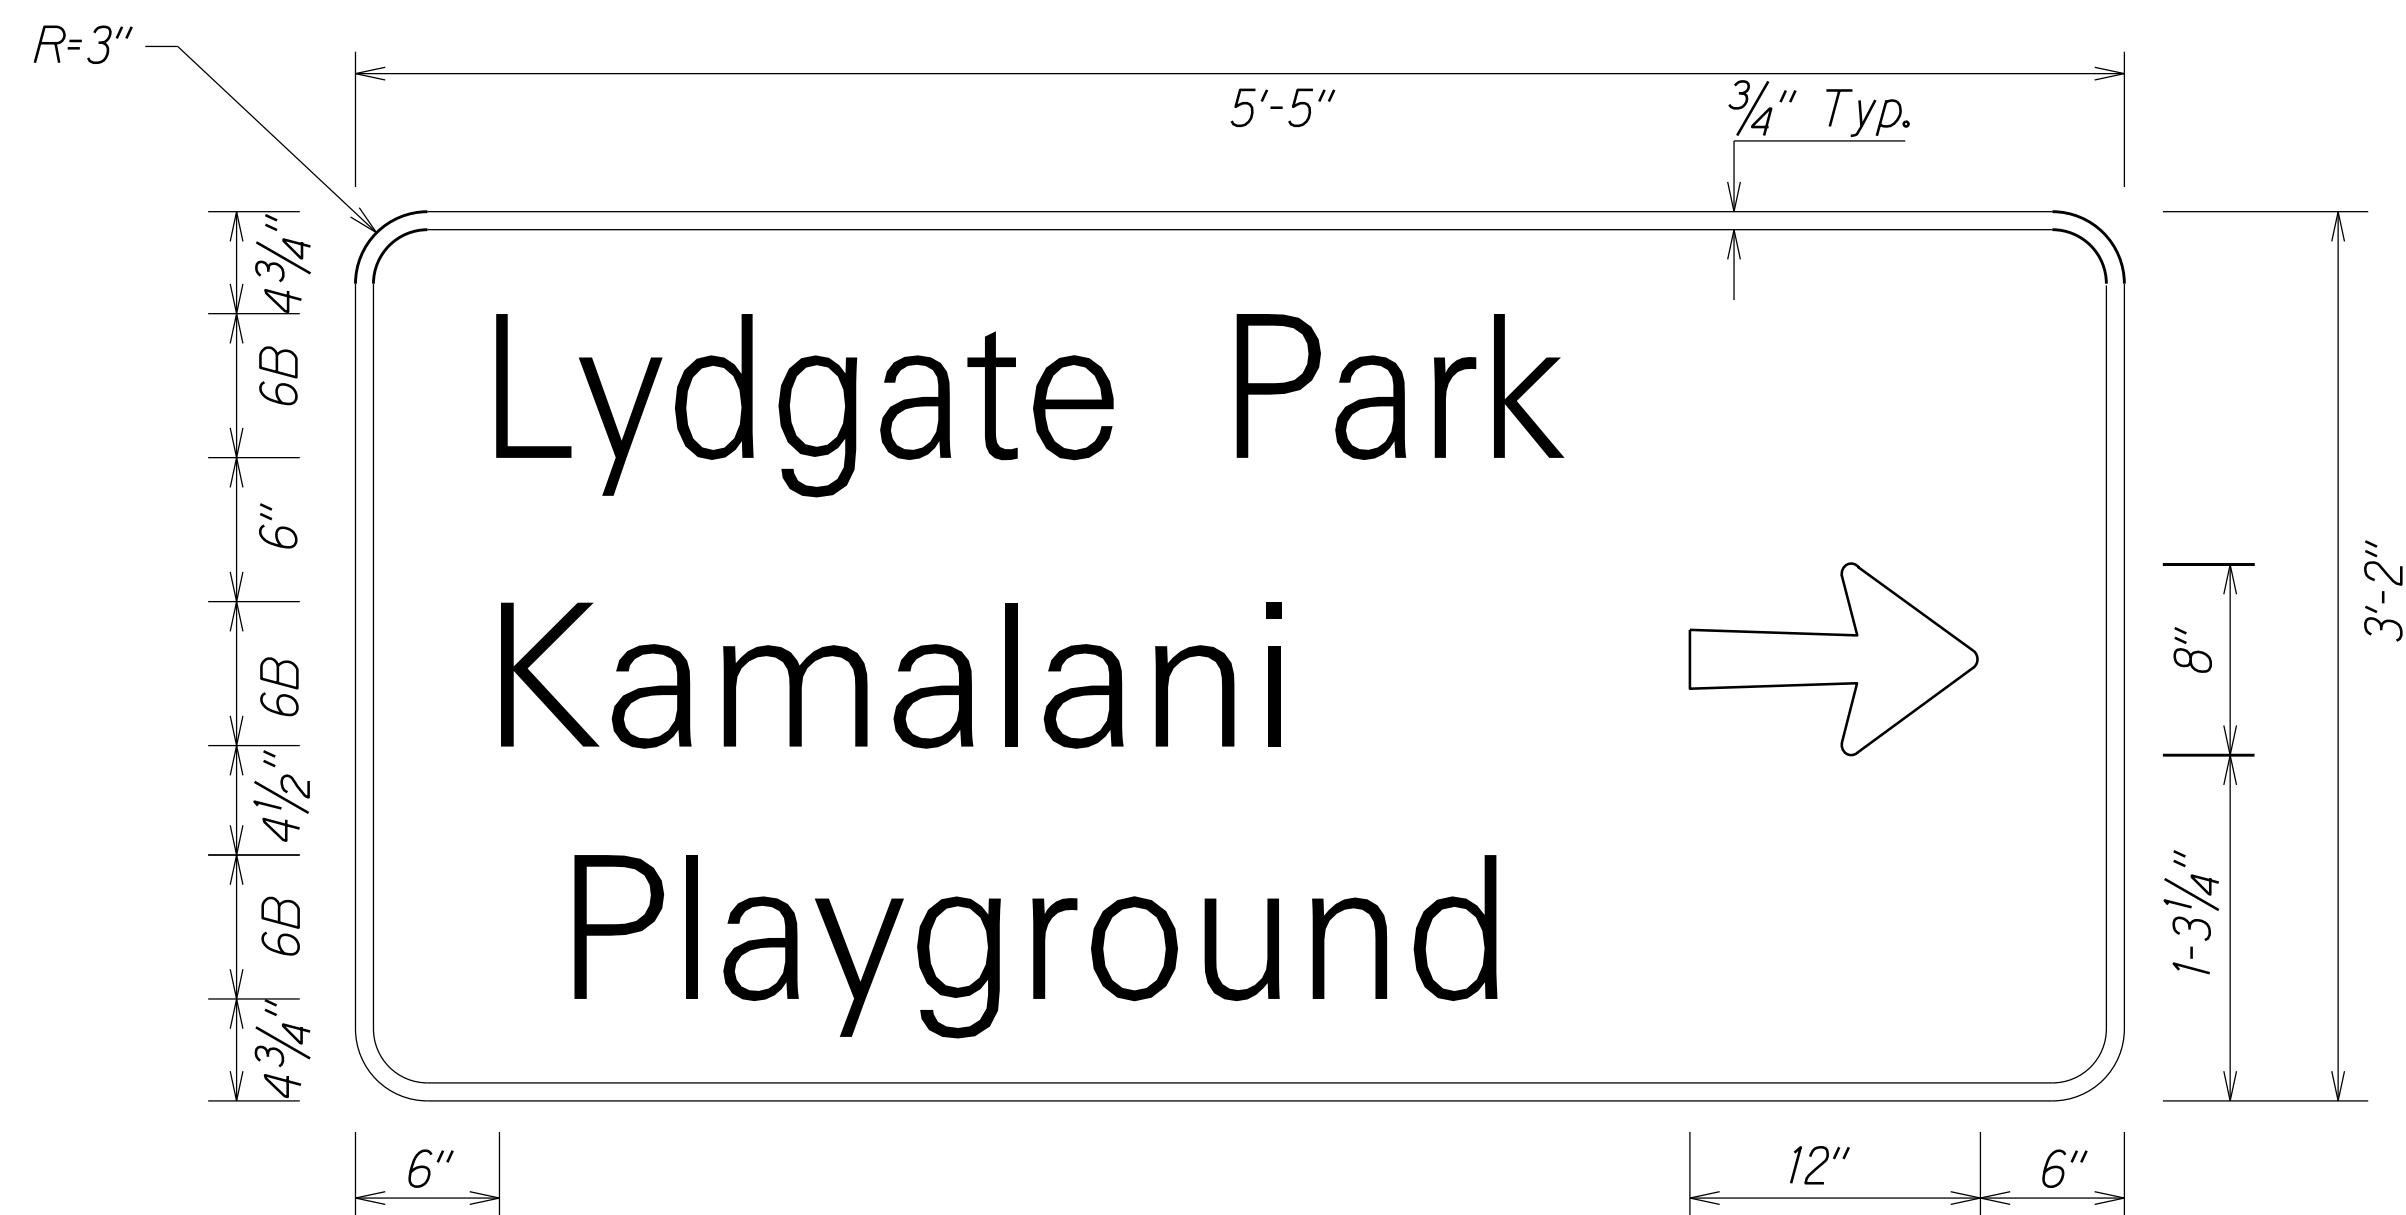

Sign support: 3-Flanged  
Channel (4.00 lbs/ft.)

D1-2  
Not to Scale

Note: Destination sigh shall have white lettering on green background.

| LEGEND FOR AS-BUILT POSTINGS |                                     |
|------------------------------|-------------------------------------|
|                              | Squiggly line for as-built deletion |
|                              | Double line for as-built deletion   |
| Roadway                      | Text for as-built posting           |

STATE OF HAWAII  
DEPARTMENT OF TRANSPORTATION  
HIGHWAYS DIVISION

DESTINATION SIGN DETAIL

KUHIO HIGHWAY RESURFACING  
Kapule Highway to North Leho Drive  
Fed-Aid Project No. NH-056-1(058)

Scale: As Noted Date: Oct. 2016

SHEET No. 1 OF 1 SHEETS

"AS-BUILT"