


FED. ROAD DIST. NO.	STATE	FED-AID PROJ. NO.	FISCAL YEAR	SHEET NO.	TOTAL SHEETS
HAWAII	HAW.	NH-056-1(058)	2017	10	30


BEGIN PROJECT
FAP No. NH-056-1(058)
Sta. 238+00

TRUE NORTH
SCALE : 1" = 40'

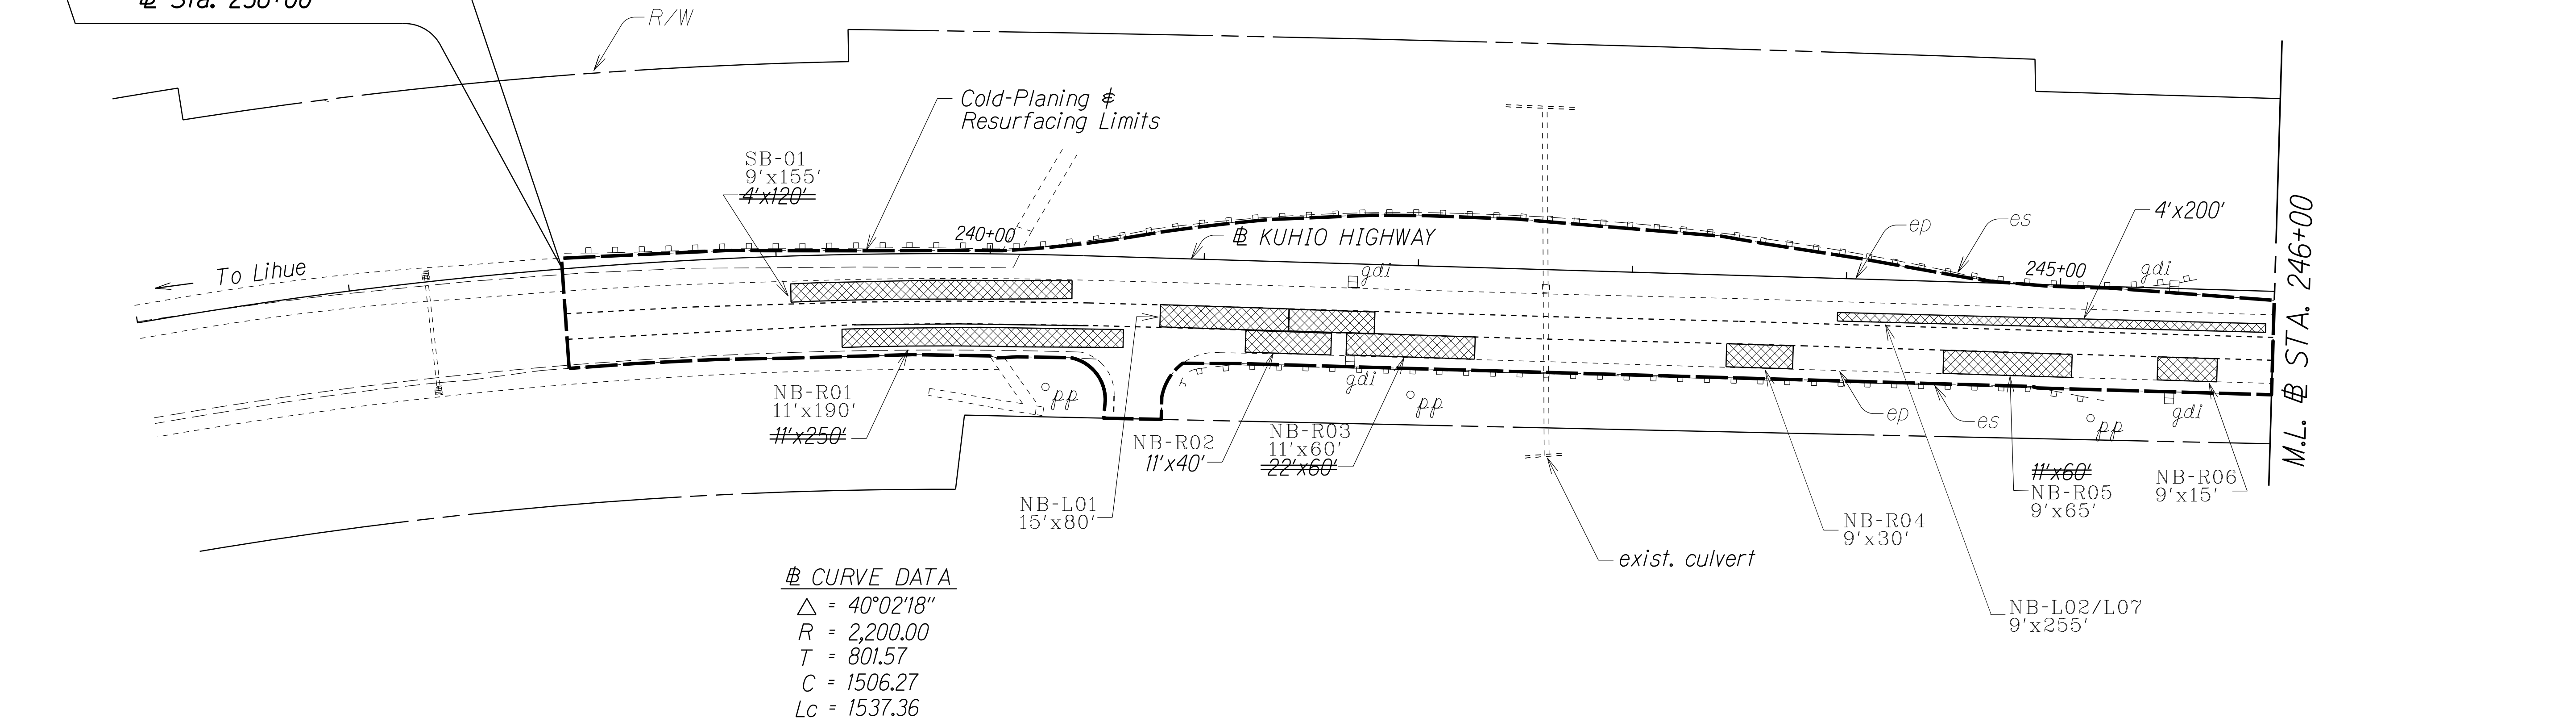

CURVE DATA
 $\Delta = 40^{\circ}02'18''$
 $R = 2,200.00$
 $T = 801.57$
 $C = 1506.27$
 $L_c = 1537.36$

TRUE NORTH
SCALE : 1" = 40'

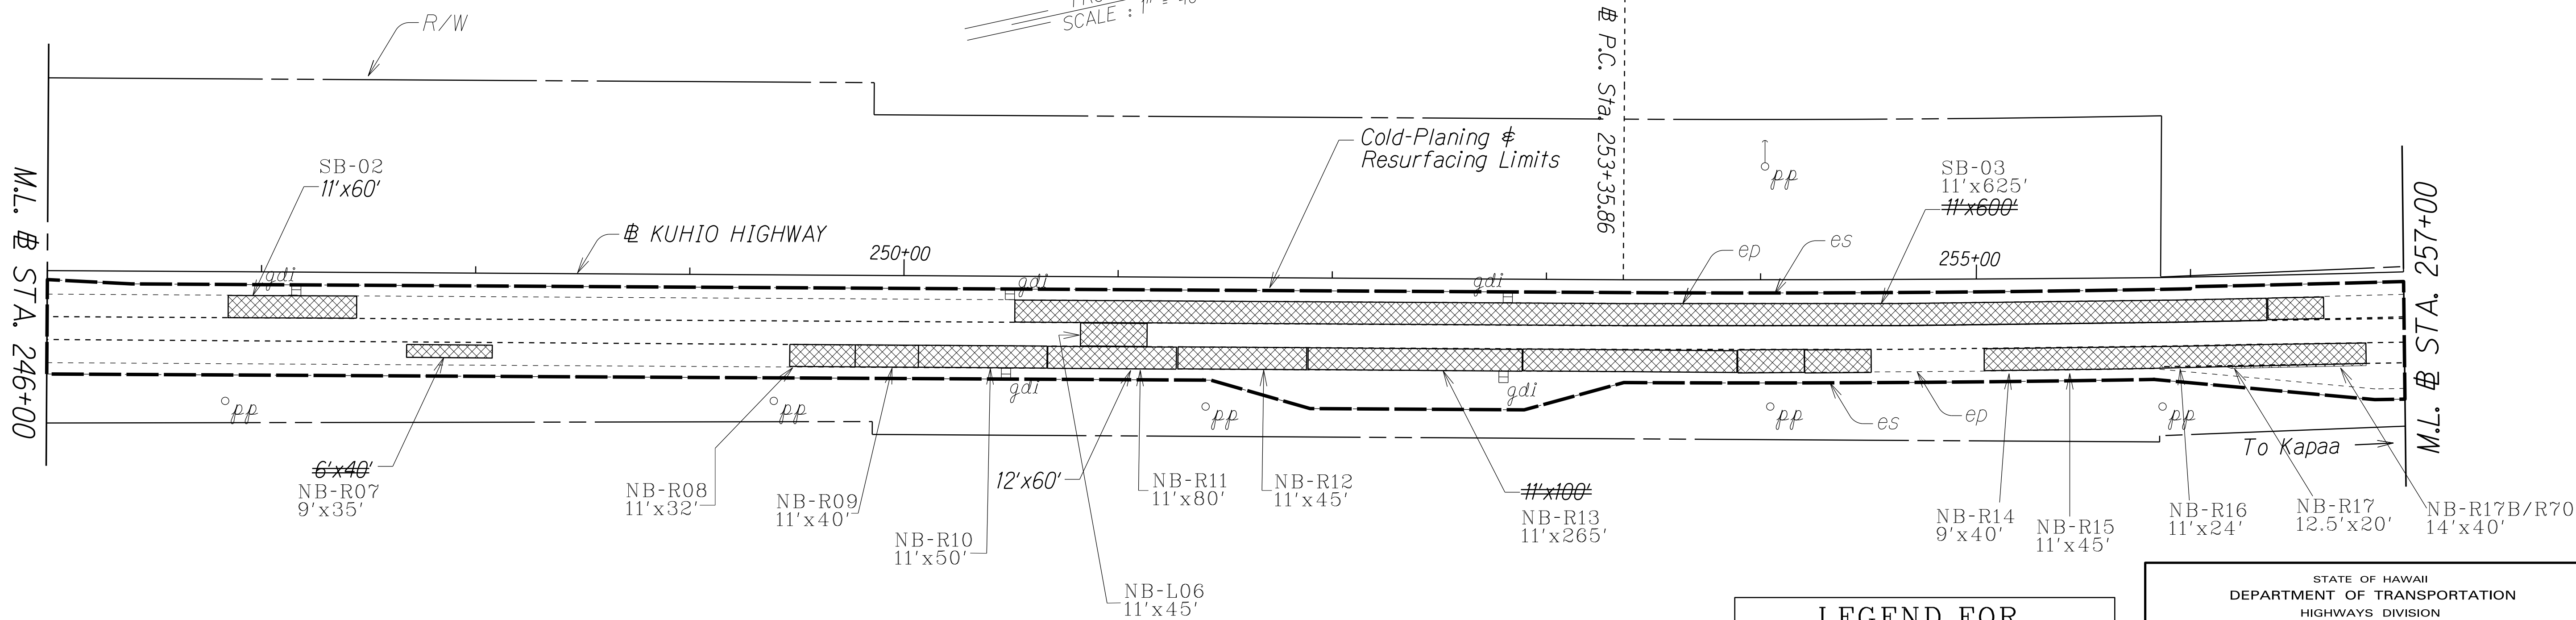

LEGEND FOR AS-BUILT POSTINGS	
	Squiggly line for as-built deletion
	Double line for as-built deletion
Roadway	Text for as-built posting

STATE OF HAWAII
DEPARTMENT OF TRANSPORTATION
HIGHWAYS DIVISION

ROADWAY PLAN



KUHIO HIGHWAY RESURFACING
Kapule Highway to North Leho Drive
Federal-Aid Project No. NH-056-1(058)

Scale: 1" = 40' Date: Oct. 2016

SHEET No. 1 OF 8 SHEETS

"AS-BUILT"

FED. ROAD DIST. NO.	STATE	FED-AID PROJ. NO.	FISCAL YEAR	SHEET NO.	TOTAL SHEETS
HAWAII	HAW.	NH-056-1(058)	2017	11	30

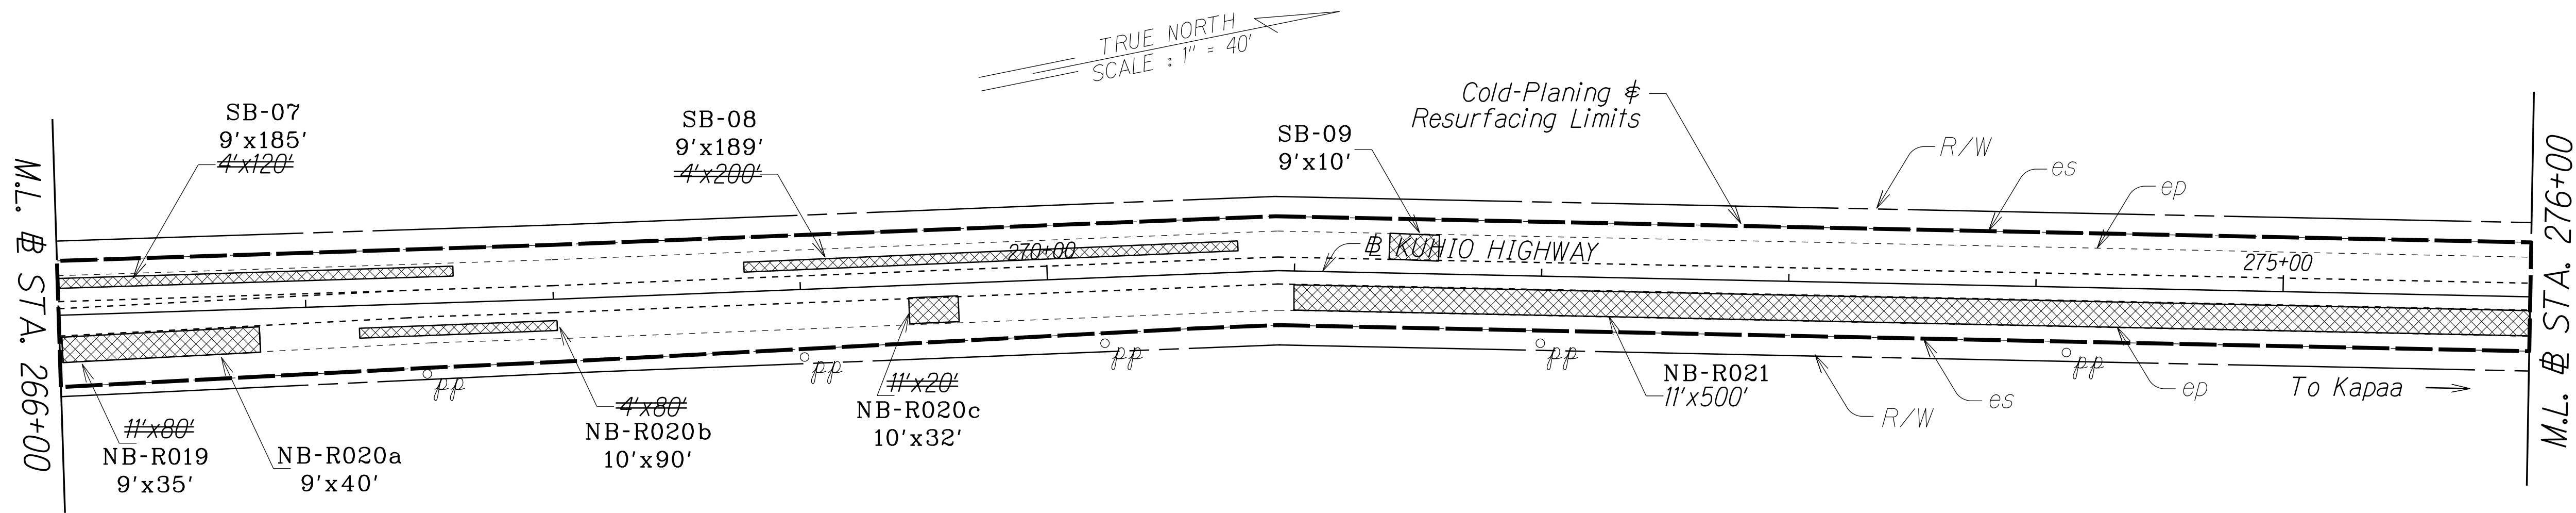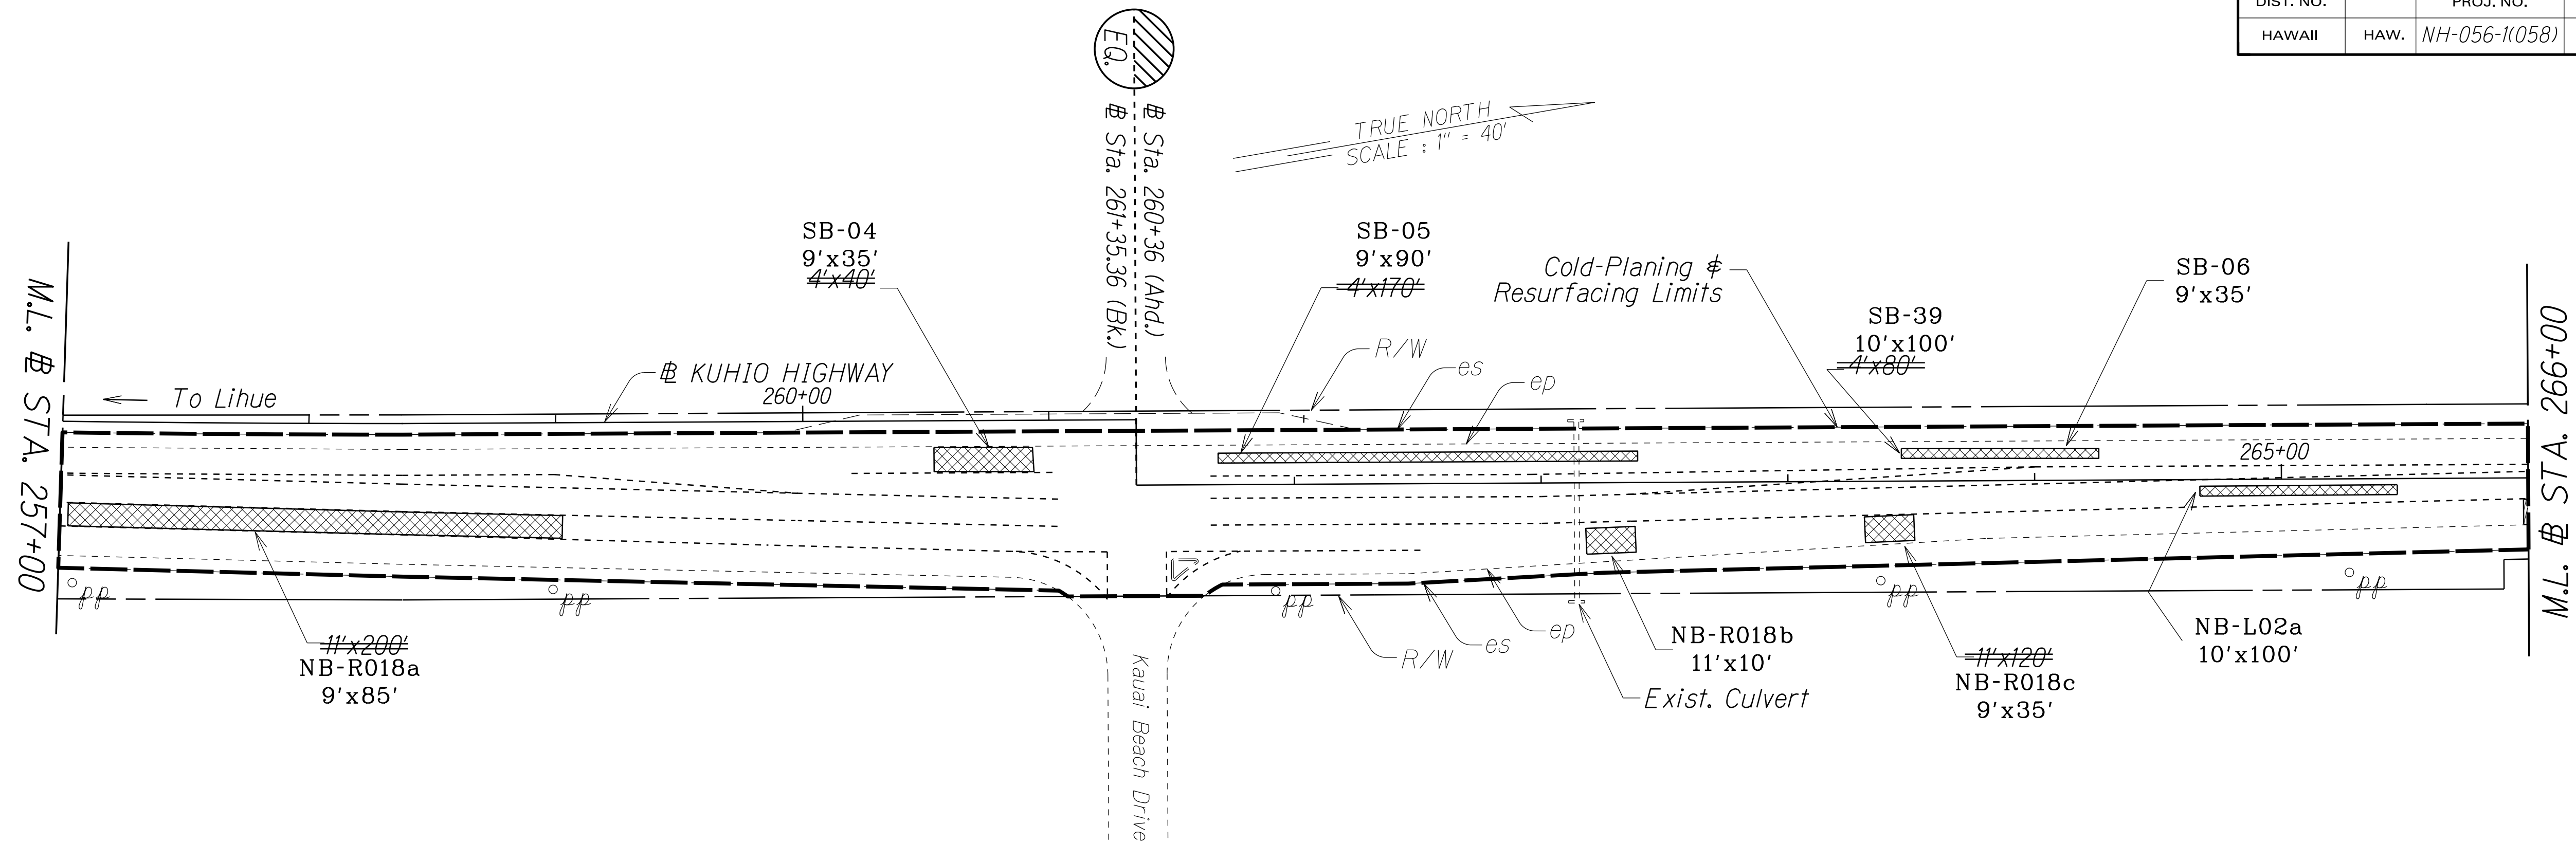

ORIGINAL PLAN	SURVEY PLOTTED BY	DATE
NOTE BOOK	DRAWN BY	
DESIGNED BY	TRACED BY	
CHECKED BY	DESIGNED BY	
	CHECKED BY	

LEGEND FOR AS-BUILT POSTINGS	
	Squiggly line for as-built deletion
	Double line for as-built deletion
Roadway	Text for as-built posting

STATE OF HAWAII
DEPARTMENT OF TRANSPORTATION
HIGHWAYS DIVISION

ROADWAY PLAN



*KUHIO HIGHWAY RESURFACING
Kapule Highway to North Leho Drive
Federal-Aid Project No. NH-056-1(058)*

Scale: 1" = 40' Date: Oct. 2016

SHEET No. 2 OF 8 SHEETS

"AS-BUILT"

FED. ROAD DIST. NO.	STATE	FED-AID PROJ. NO.	FISCAL YEAR	SHEET NO.	TOTAL SHEETS
HAWAII	HAW.	NH-056-1(058)	2017	12	30

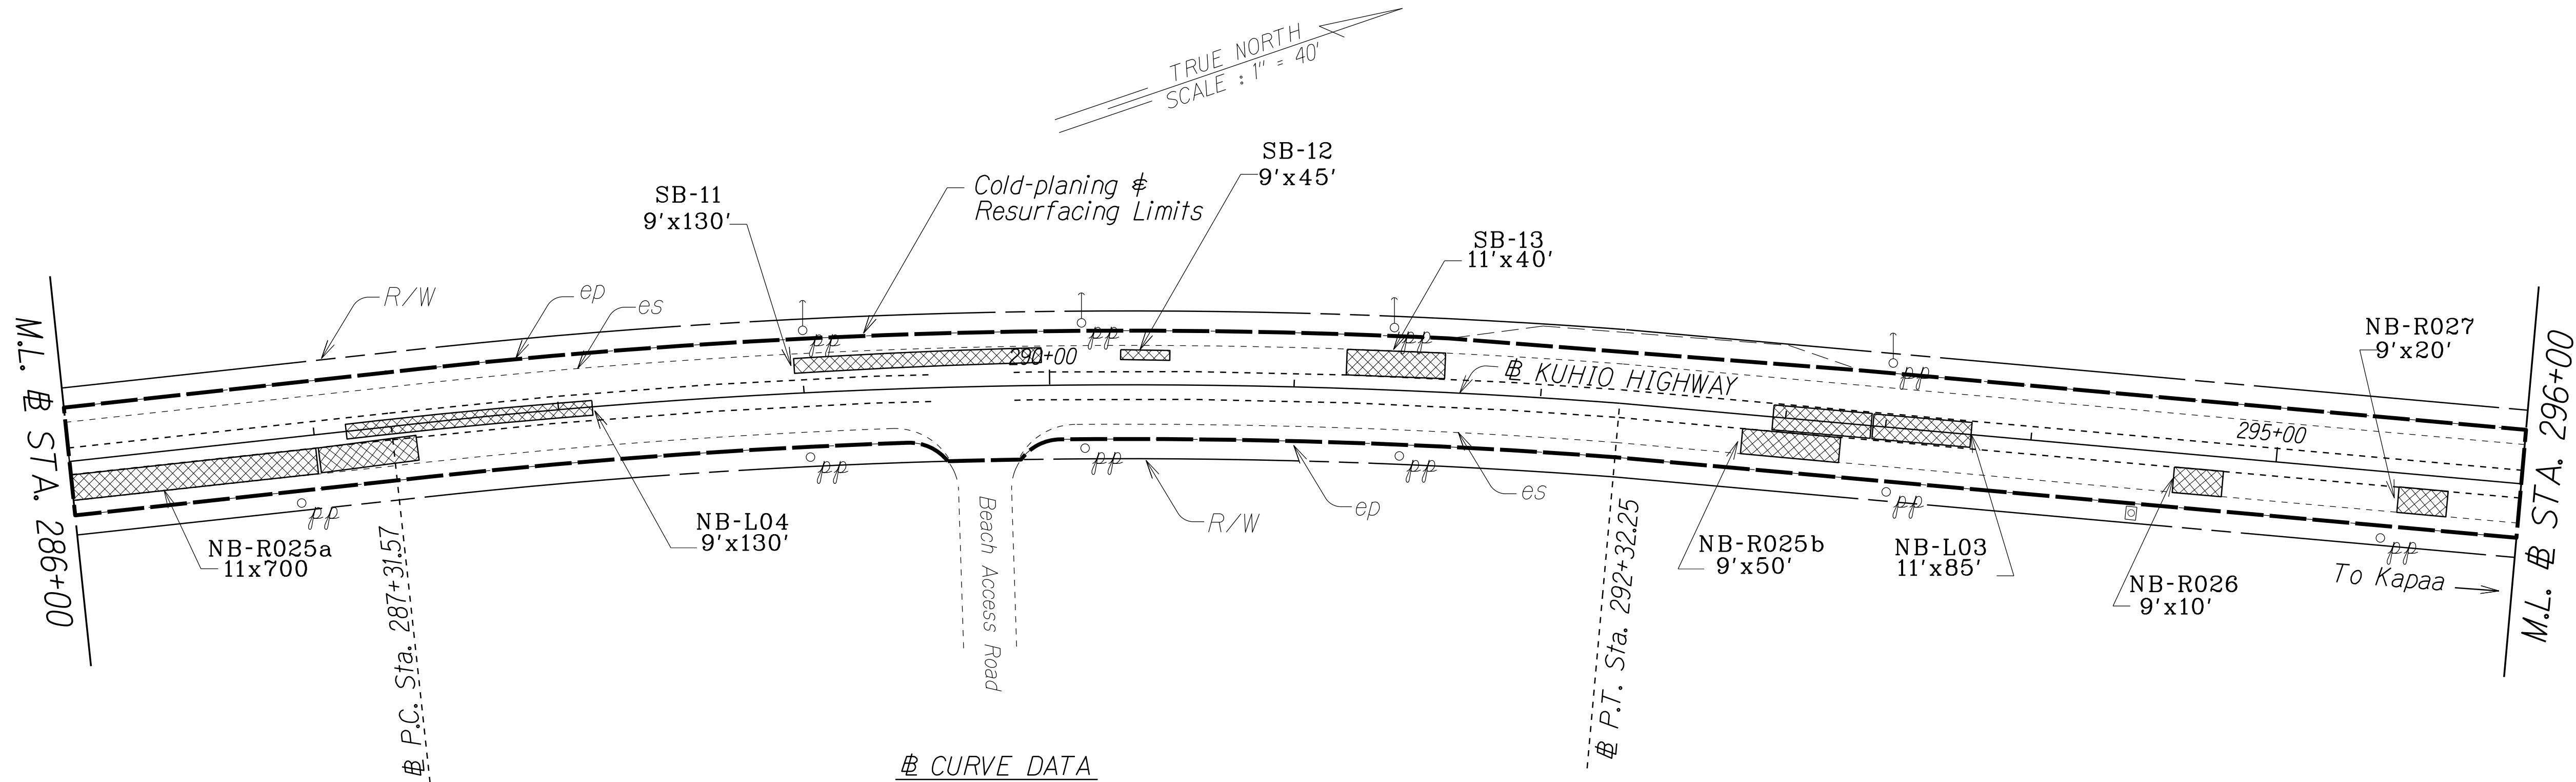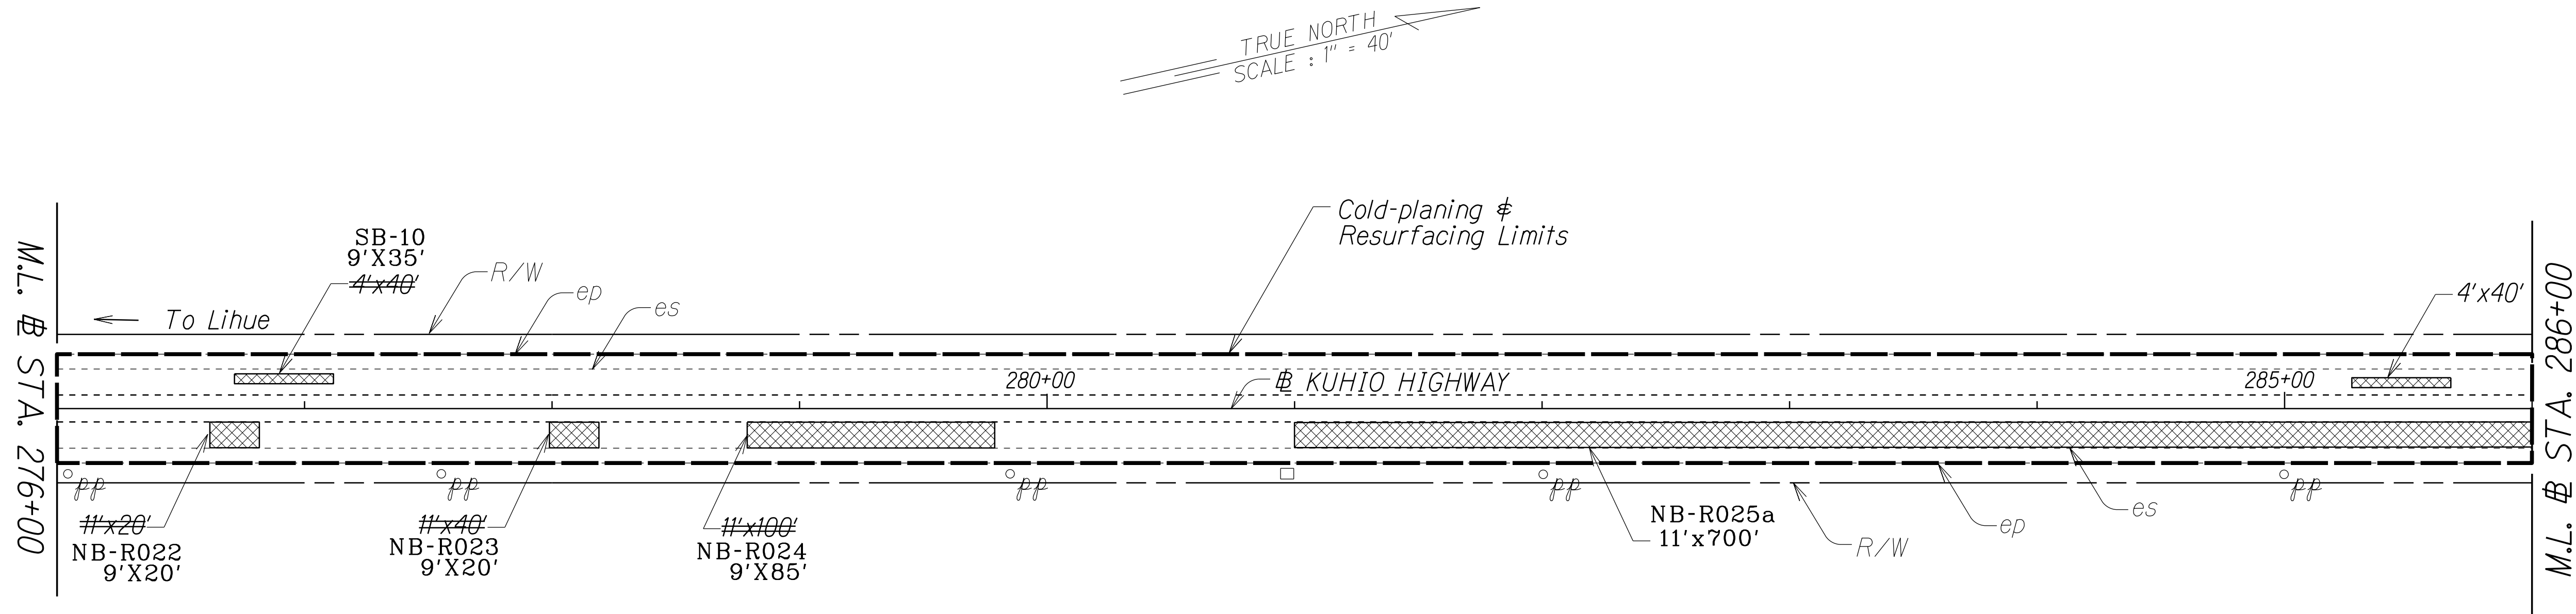

⊕ CURVE DATA
Δ = 14°27'00"
R = 1,500.00
T = 86.16
L = 288.90

**LEGEND FOR
AS-BUILT POSTINGS**

- ~~~~~ Squiggly line for as-built deletion
~~100.00~~ Double line for as-built deletion
Roadway Text for as-built posting

STATE OF HAWAII
DEPARTMENT OF TRANSPORTATION
HIGHWAYS DIVISION
ROADWAY PLAN
KUHIO HIGHWAY RESURFACING
Kapule Highway to North Leho Drive
Federal-Aid Project No. NH-056-1(058)


Scale: 1" = 40' Date: Oct. 2016
SHEET No. 3 OF 8 SHEETS

"AS-BUILT"



12

ORIGINAL PLAN	SURVEY PLOTTED BY	DATE
NOTE BOOK	DRAWN BY	✓
DESIGNED BY	TRACED BY	✓
CHECKED BY	DESIGNED BY	✓
NO.	CHECKED BY	✓

FED. ROAD DIST. NO.	STATE	FED-AID PROJ. NO.	FISCAL YEAR	SHEET NO.	TOTAL SHEETS
HAWAII	HAW.	NH-056-1(058)	2017	13	30

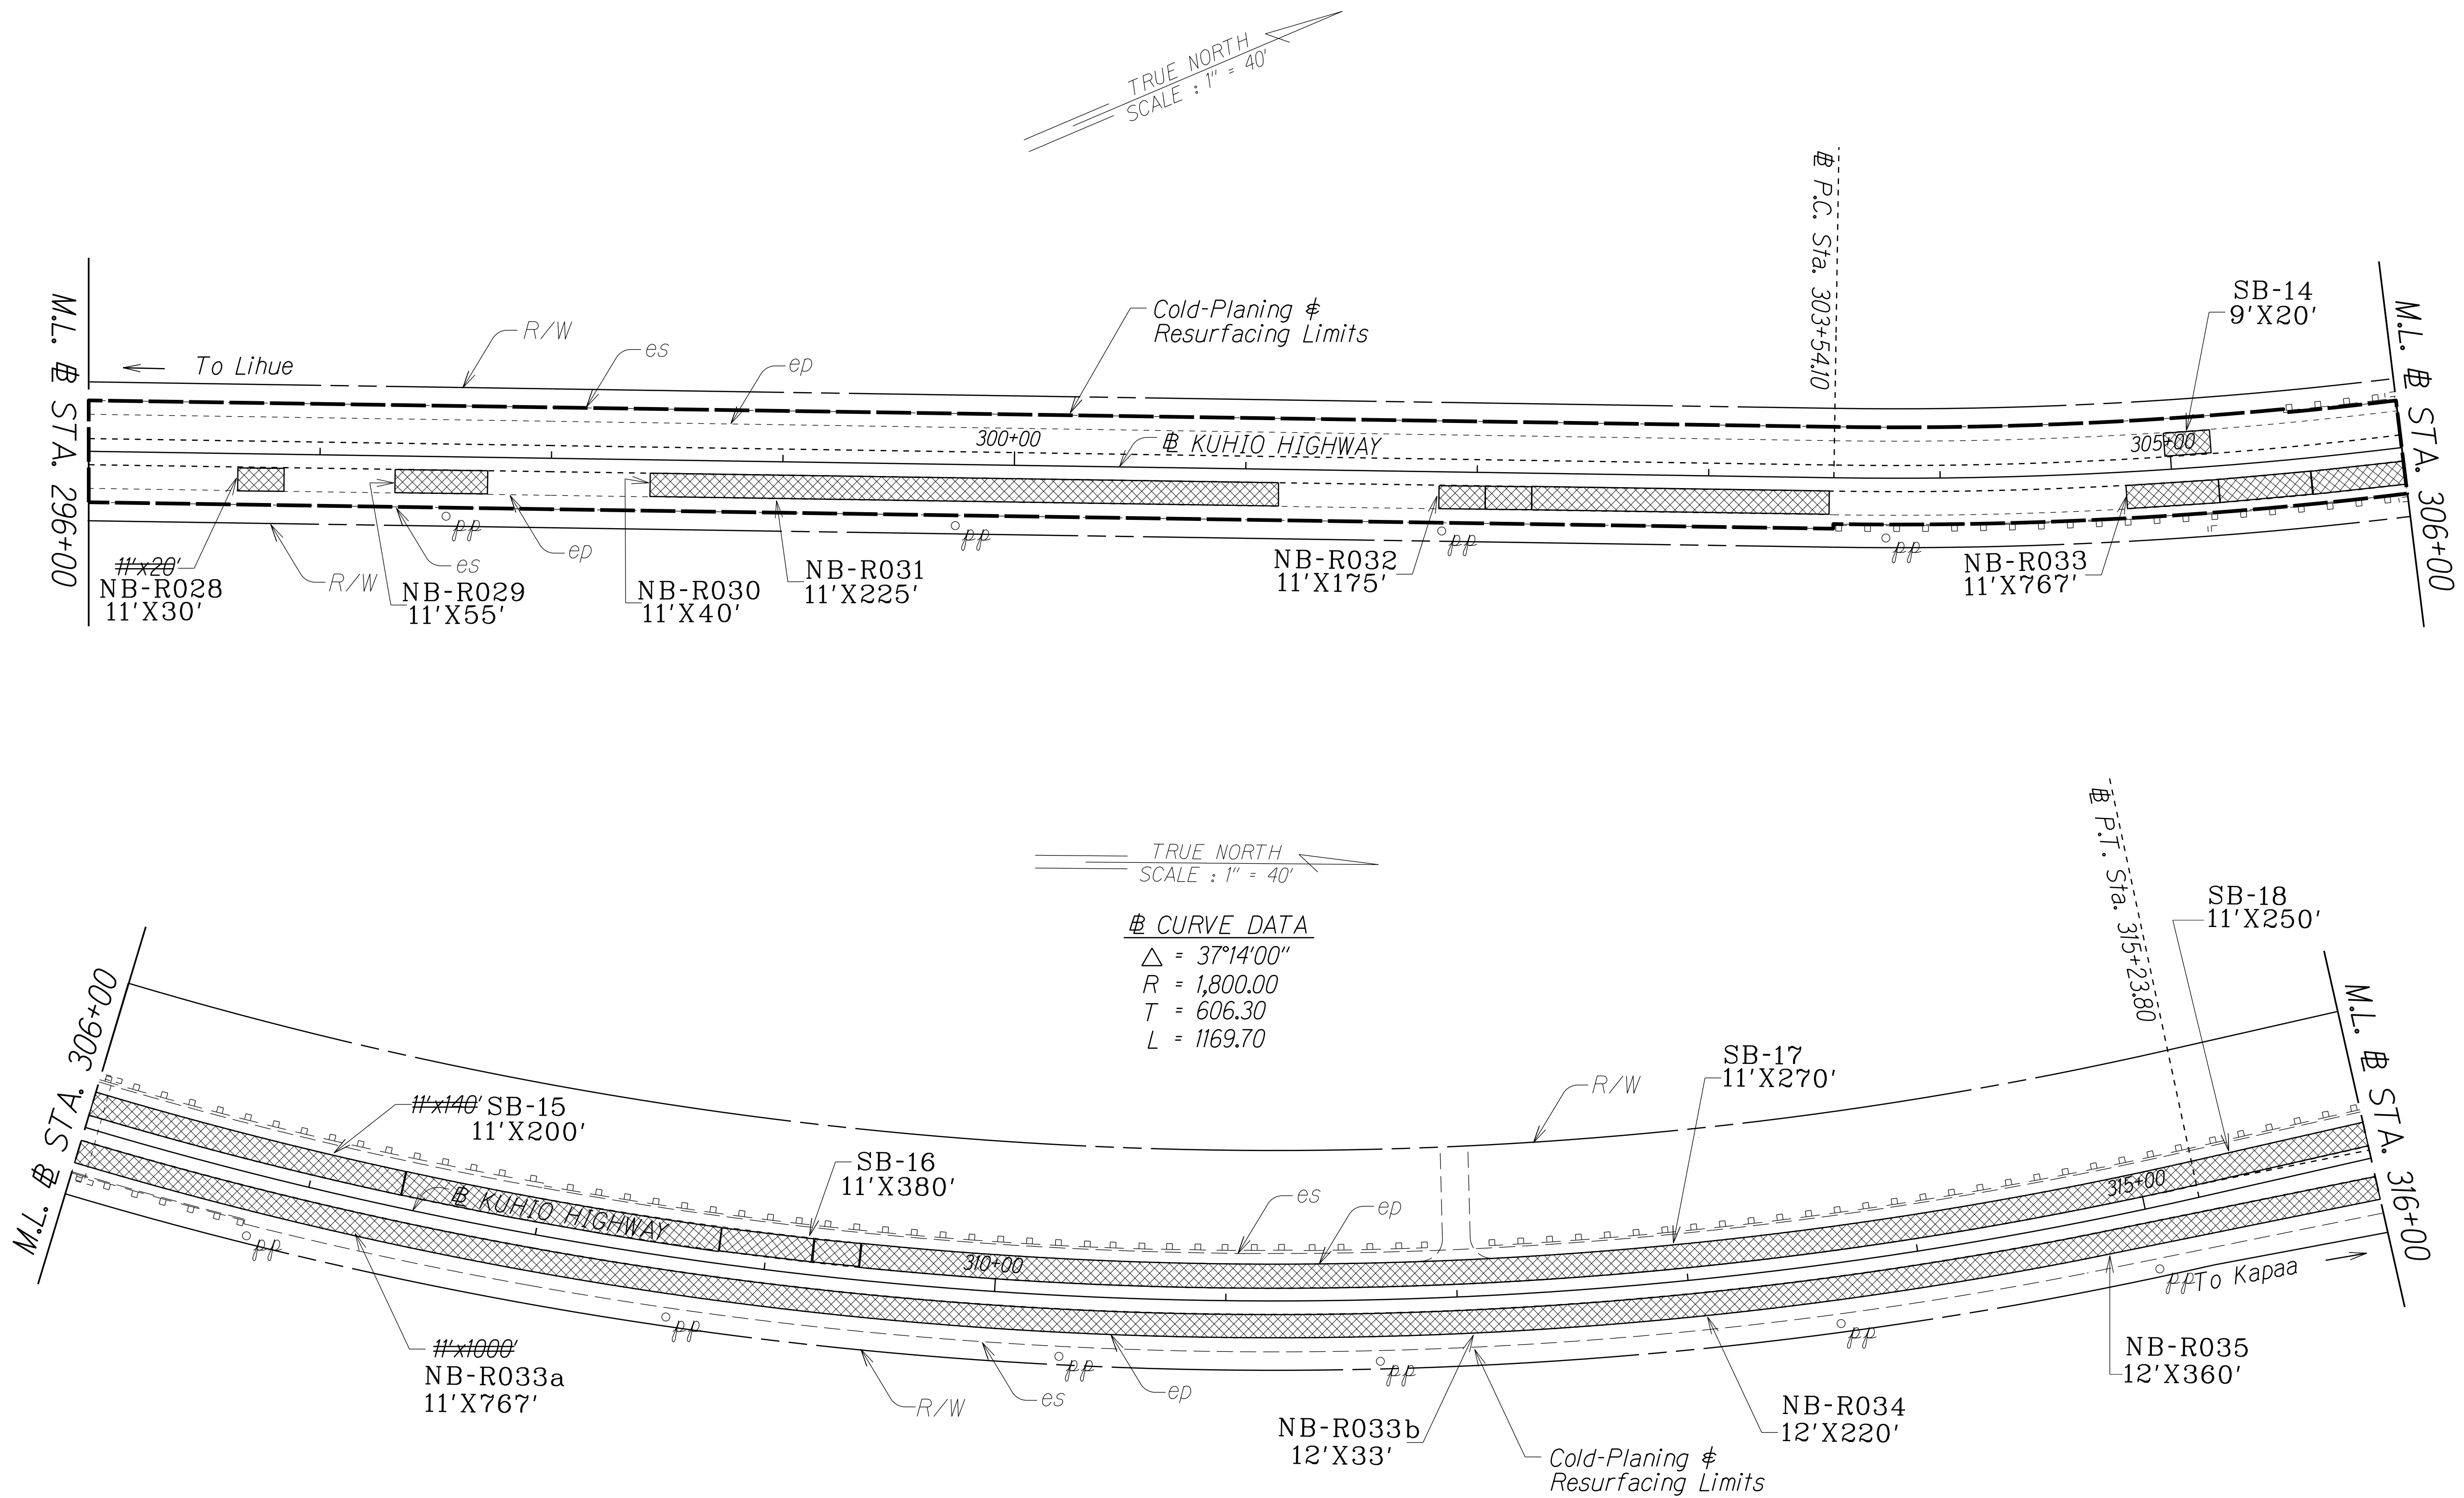

FED. ROAD DIST. NO.	STATE	FED-AID PROJ. NO.	FISCAL YEAR	SHEET NO.	TOTAL SHEETS
HAWAII	HAW.	NH-056-1(058)	2017	14	30

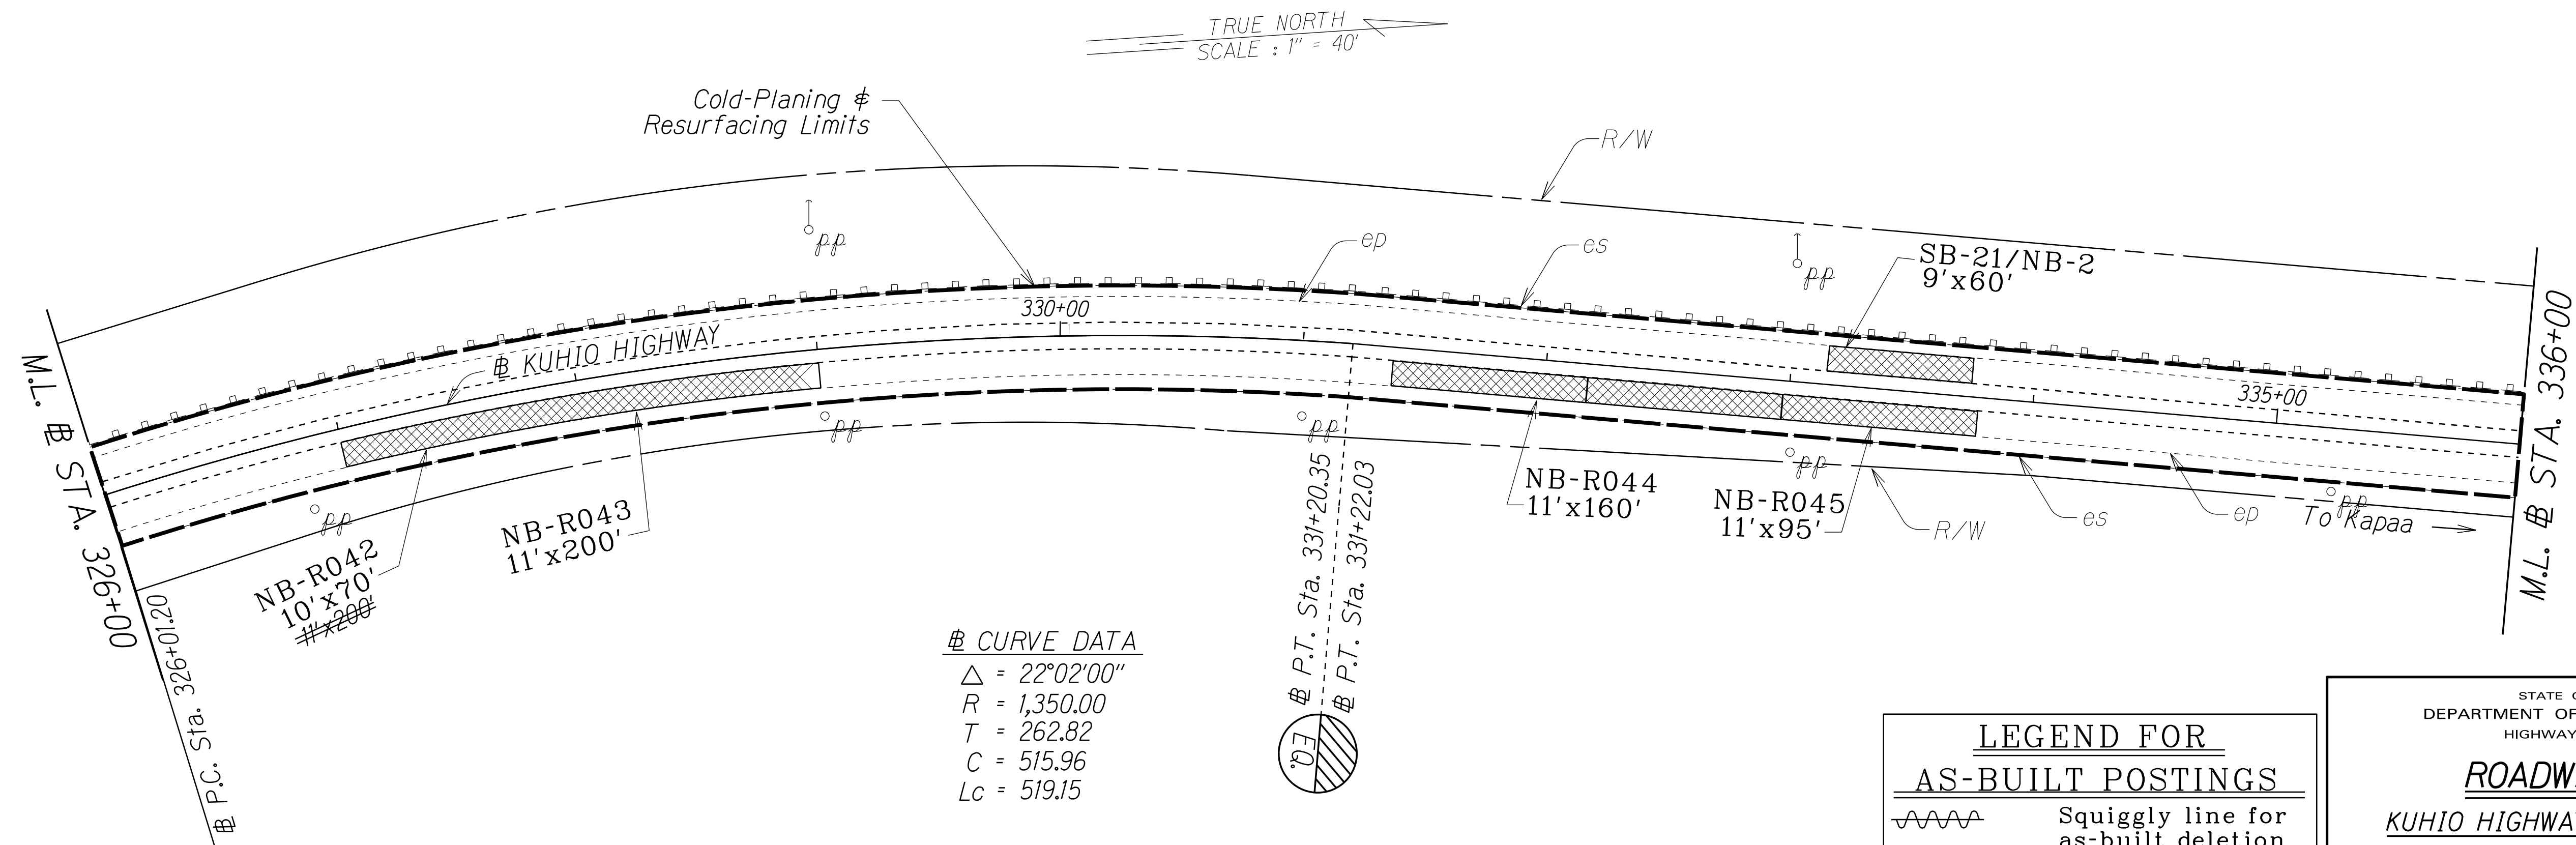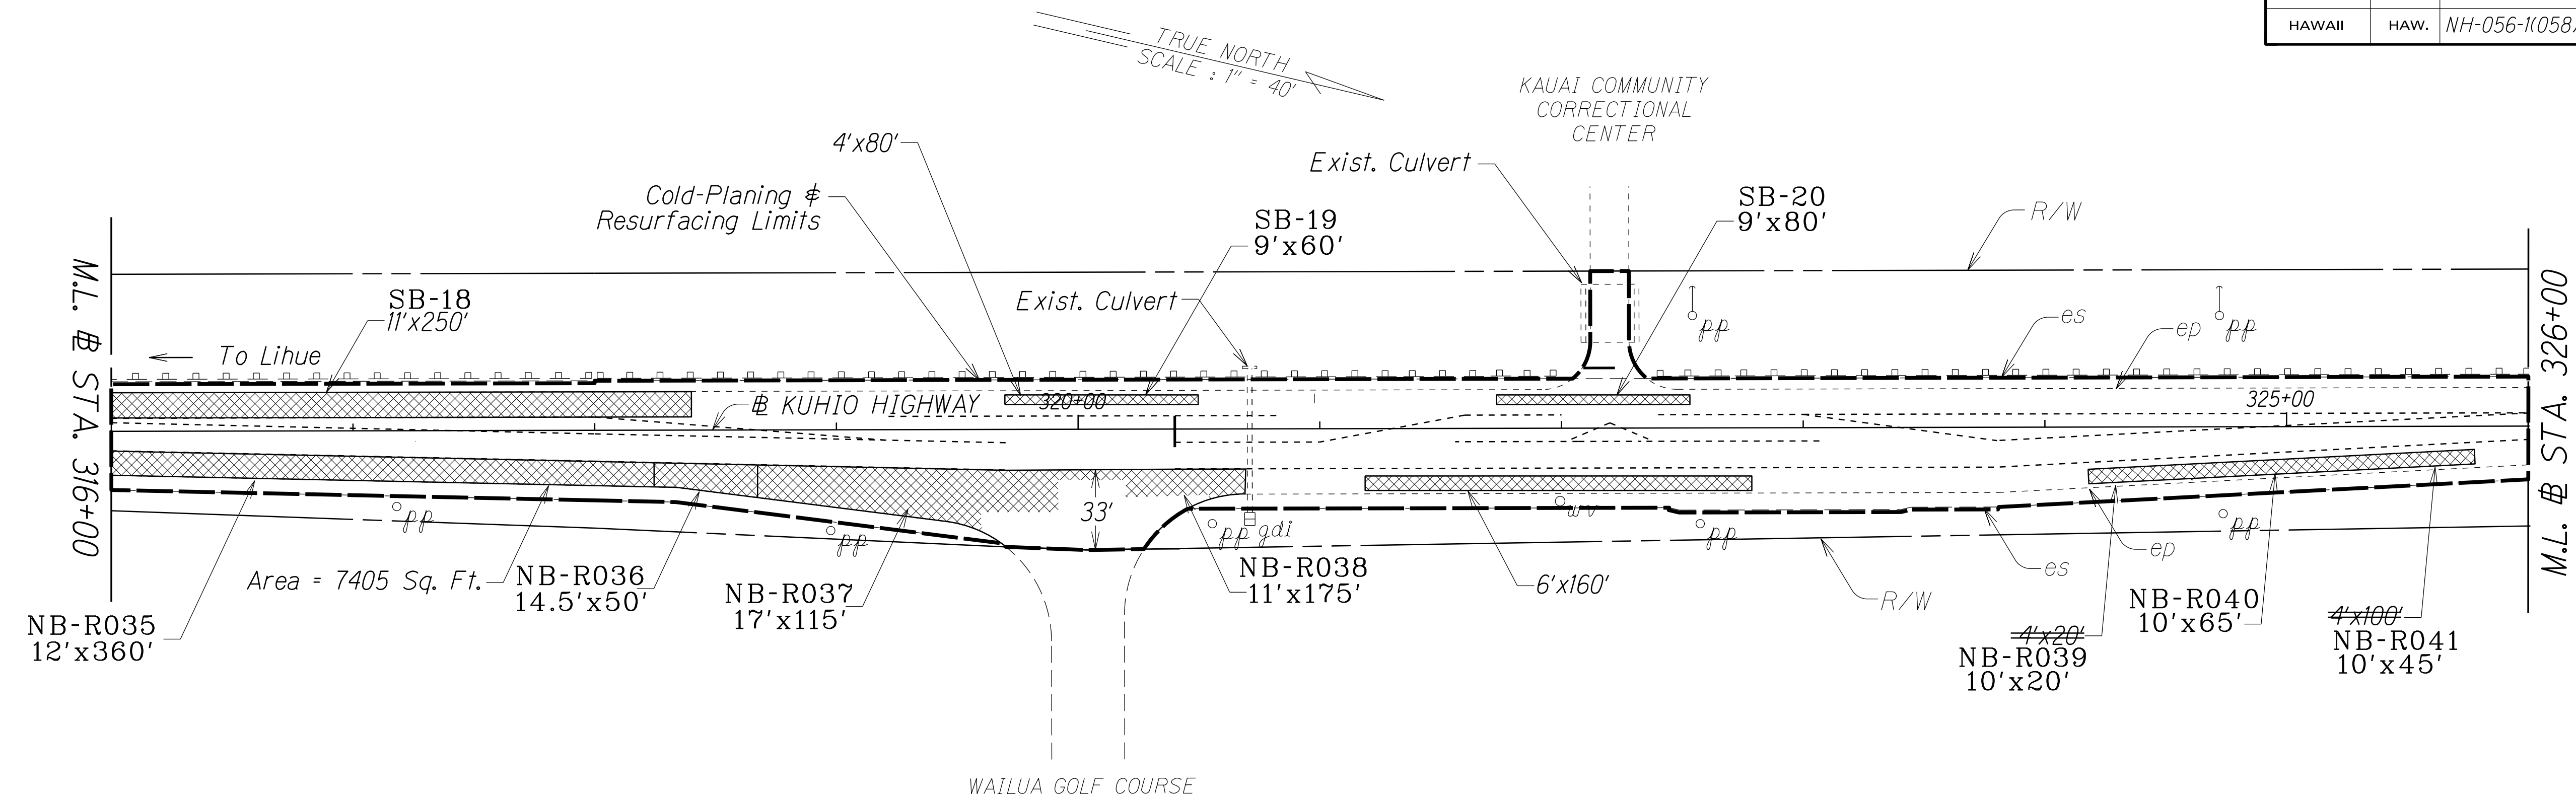

ORIGINAL PLAN	SURVEY PLOTTED BY	DATE
NOTE BOOK	DRAWN BY	10/1/16
DESIGNED BY	CHECKED BY	
NO.		

LEGEND FOR AS-BUILT POSTINGS	
	Squiggly line for as-built deletion
	Double line for as-built deletion
Roadway	Text for as-built posting

STATE OF HAWAII
DEPARTMENT OF TRANSPORTATION
HIGHWAYS DIVISION



ROADWAY PLAN
KUHIO HIGHWAY RESURFACING
Kapule Highway to North Leho Drive
Federal-Aid Project No. NH-056-1(058)

Scale: 1" = 40' Date: Oct. 2016

SHEET No. 5 OF 8 SHEETS

"AS-BUILT"

FED. ROAD DIST. NO.	STATE	FED-AID PROJ. NO.	FISCAL YEAR	SHEET NO.	TOTAL SHEETS
HAWAII	HAW.	NH-056-1(058)	2017	15	30

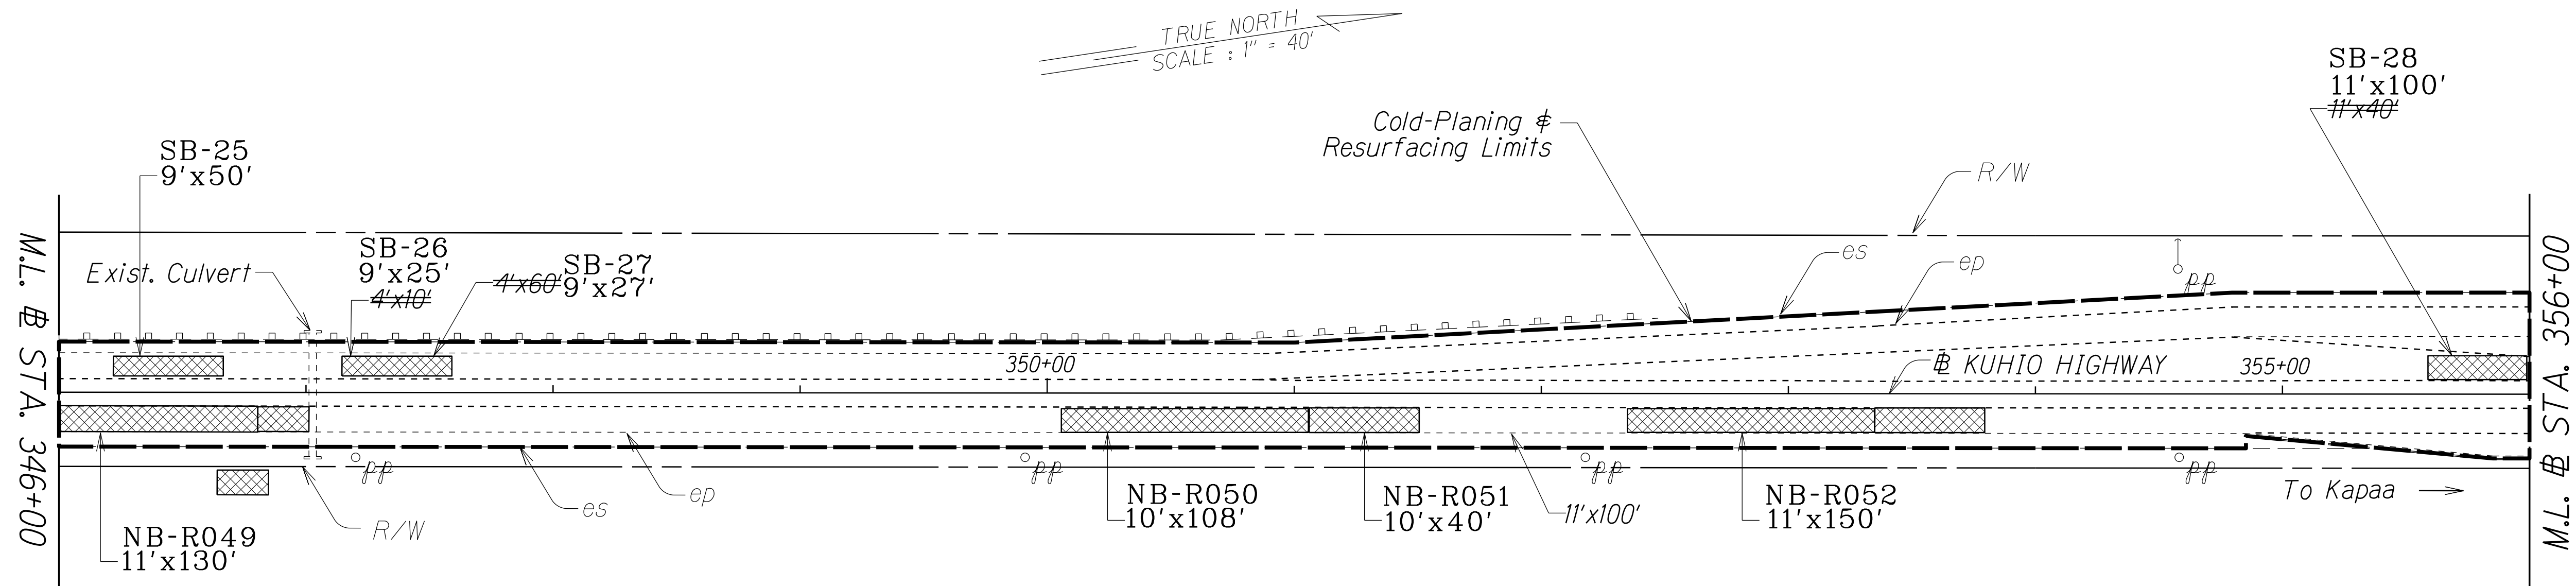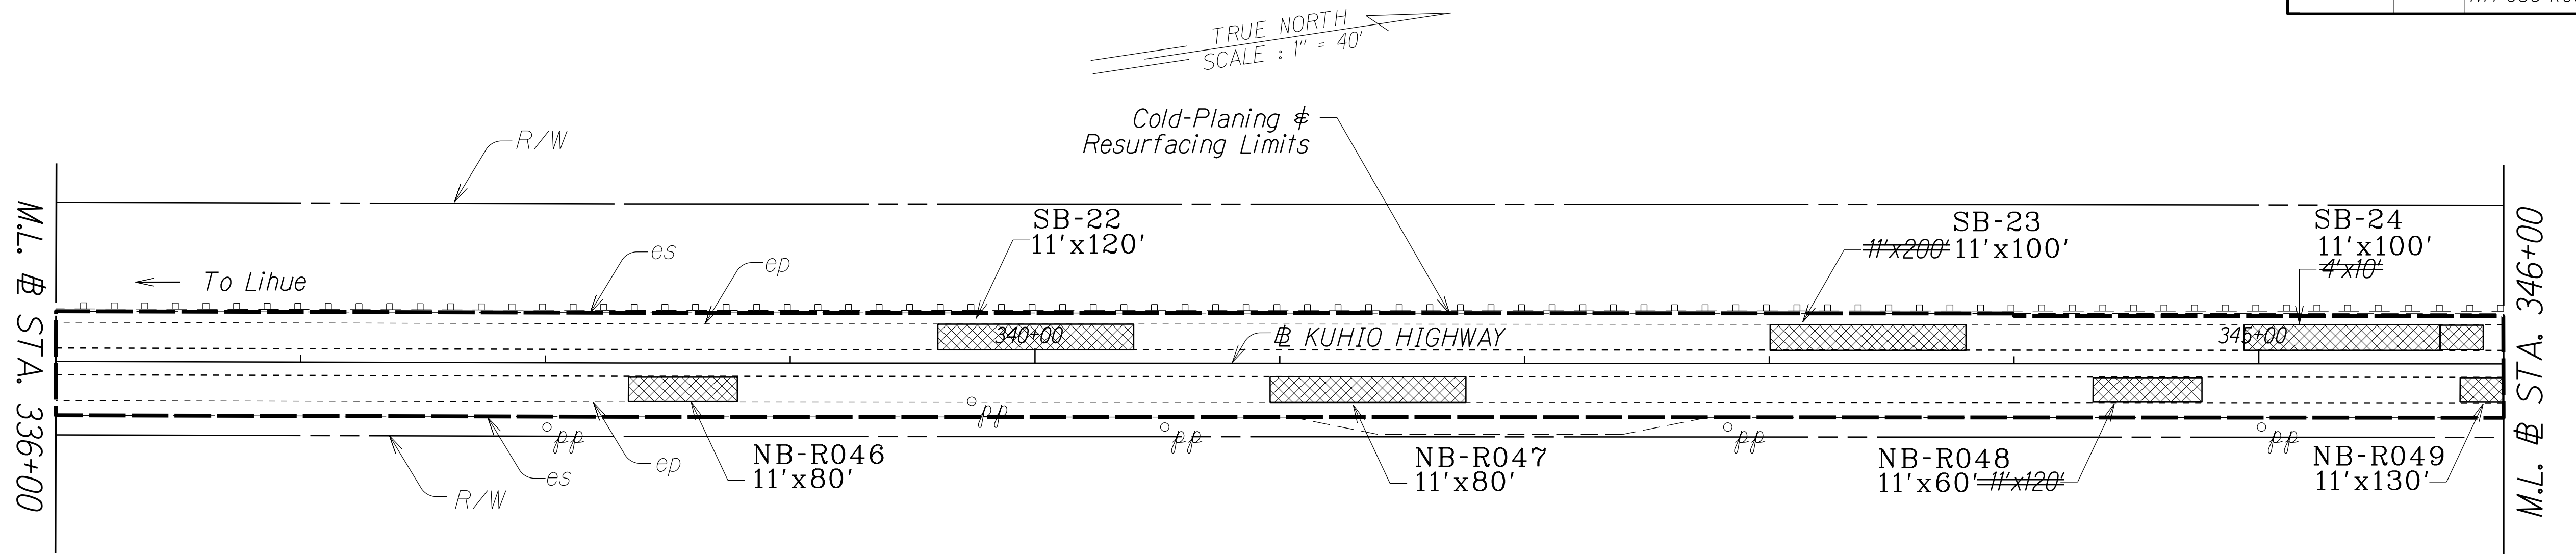

ORIGINAL PLAN	SURVEY PLOTTED BY	DATE
NOTE BOOK	DRAWN BY	
DESIGNED BY	TRACED BY	
CHECKED BY	DESIGNED BY	
	CHECKED BY	

LEGEND FOR AS-BUILT POSTINGS	
	Squiggly line for as-built deletion
	Double line for as-built deletion
Roadway	Text for as-built posting

STATE OF HAWAII
DEPARTMENT OF TRANSPORTATION
HIGHWAYS DIVISION


ROADWAY PLAN

*KUHIO HIGHWAY RESURFACING
Kapule Highway to North Leho Drive
Federal-Aid Project No. NH-056-1(058)*

Scale: 1" = 40' Date: Oct. 2016

SHEET No. 6 OF 8 SHEETS

FED. ROAD DIST. NO.	STATE	FED-AID PROJ. NO.	FISCAL YEAR	SHEET NO.	TOTAL SHEETS
HAWAII	HAW.	NH-056-1(058)	2017	16	30

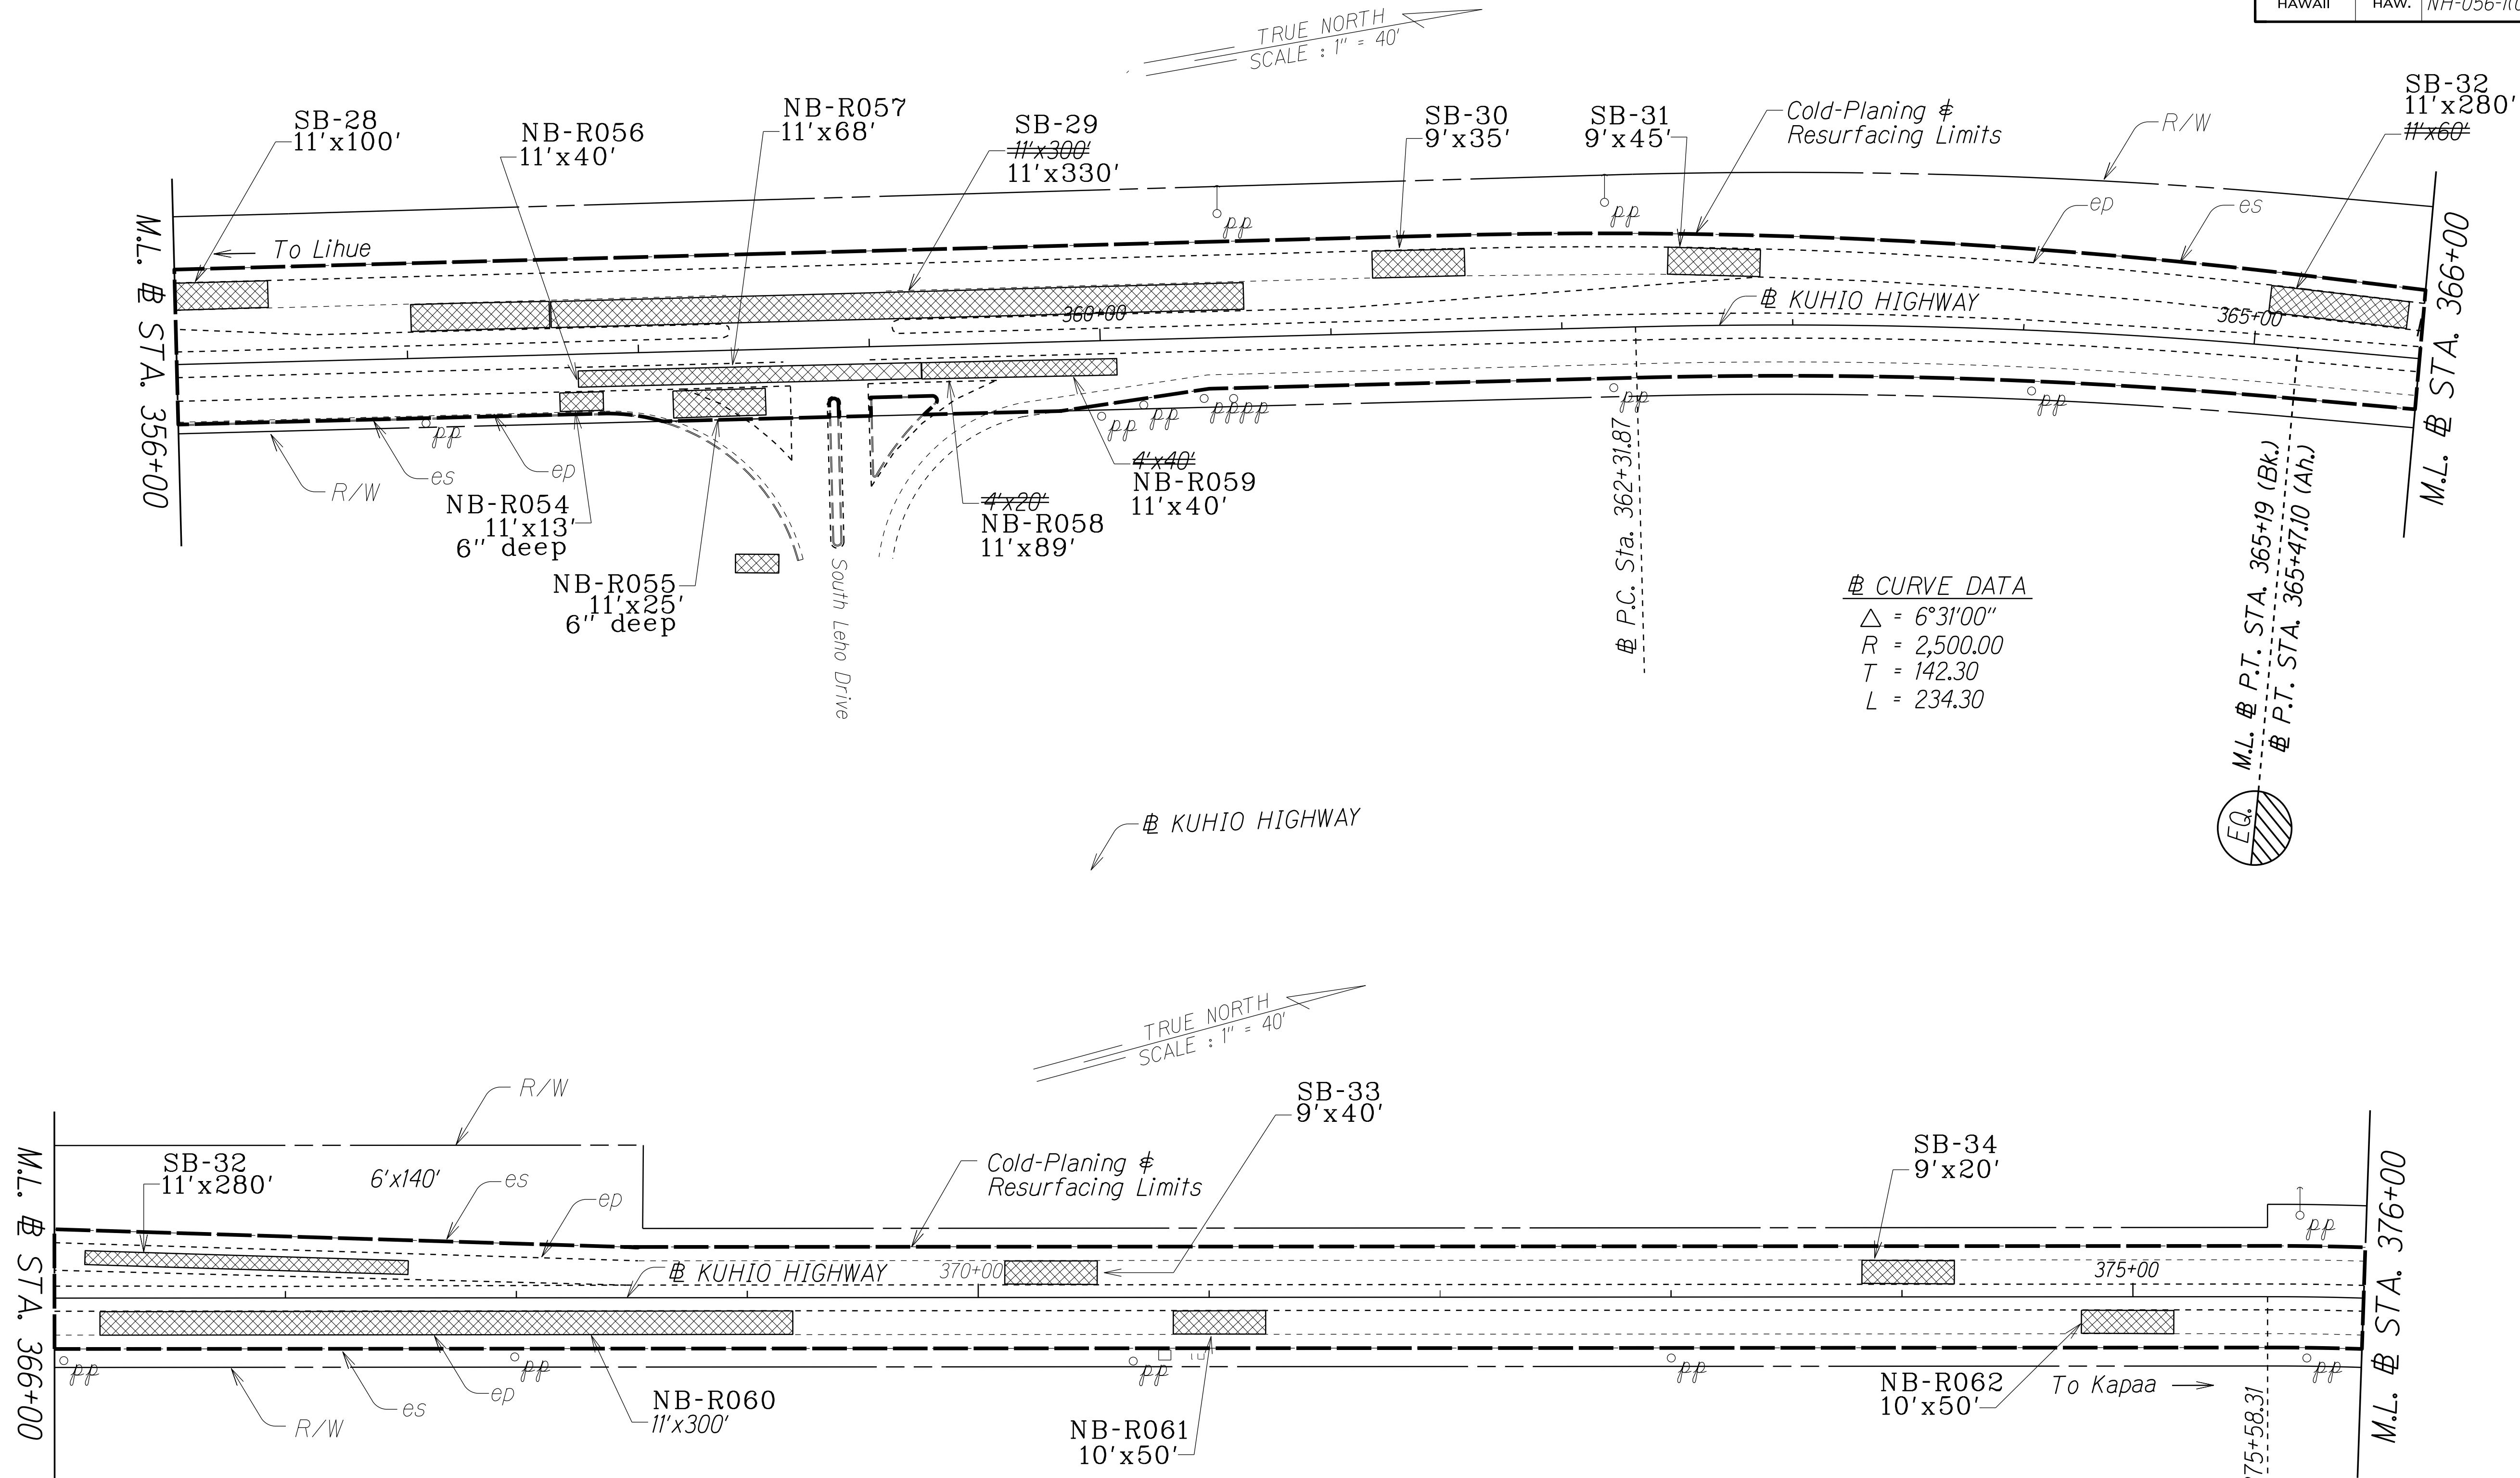

ORIGINAL PLAN	SURVEY PLOTTED BY	DATE
NOTE BOOK	DRAWN BY	
DESIGNED BY	TRACED BY	
CHECKED BY	DESIGNED BY	
	CHECKED BY	

LEGEND FOR AS-BUILT POSTINGS	
	Squiggly line for as-built deletion
	Double line for as-built deletion
Roadway	Text for as-built posting

STATE OF HAWAII
DEPARTMENT OF TRANSPORTATION
HIGHWAYS DIVISION



ROADWAY PLAN

KUHIO HIGHWAY RESURFACING
Kapule Highway to North Leho Drive
Federal-Aid Project No. NH-056-1(058)

Scale: 1" = 40' Date: Oct. 2016

SHEET No. 7 OF 8 SHEETS

FED. ROAD DIST. NO.	STATE	FED-AID PROJ. NO.	FISCAL YEAR	SHEET NO.	TOTAL SHEETS
HAWAII	HAW.	NH-056-1(058)	2017	17	30

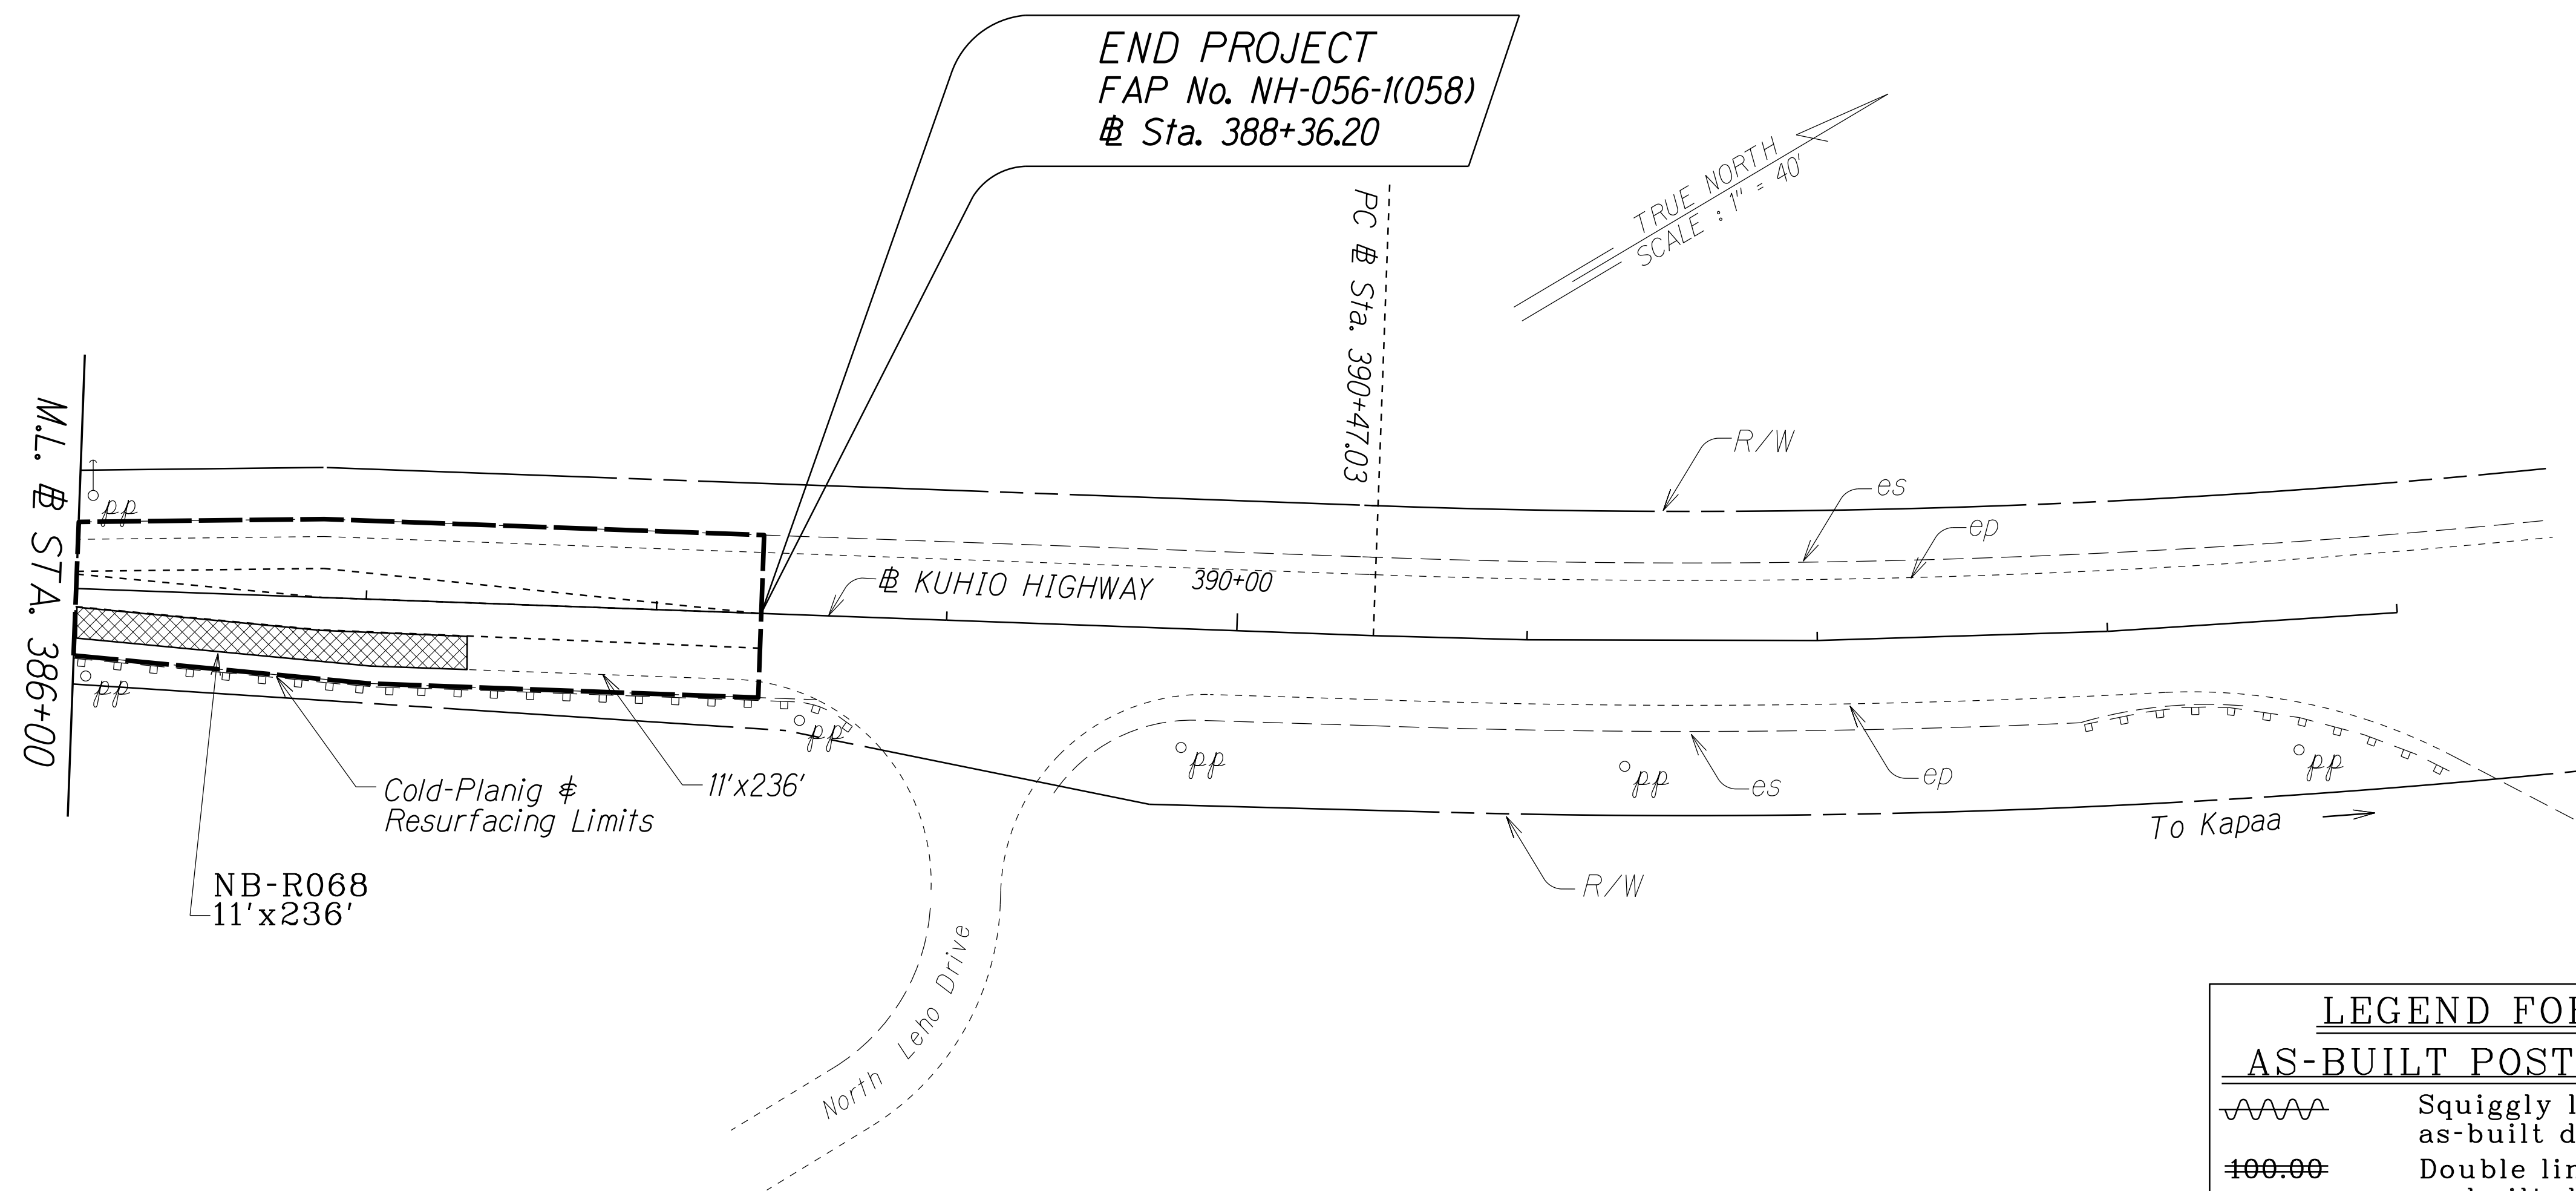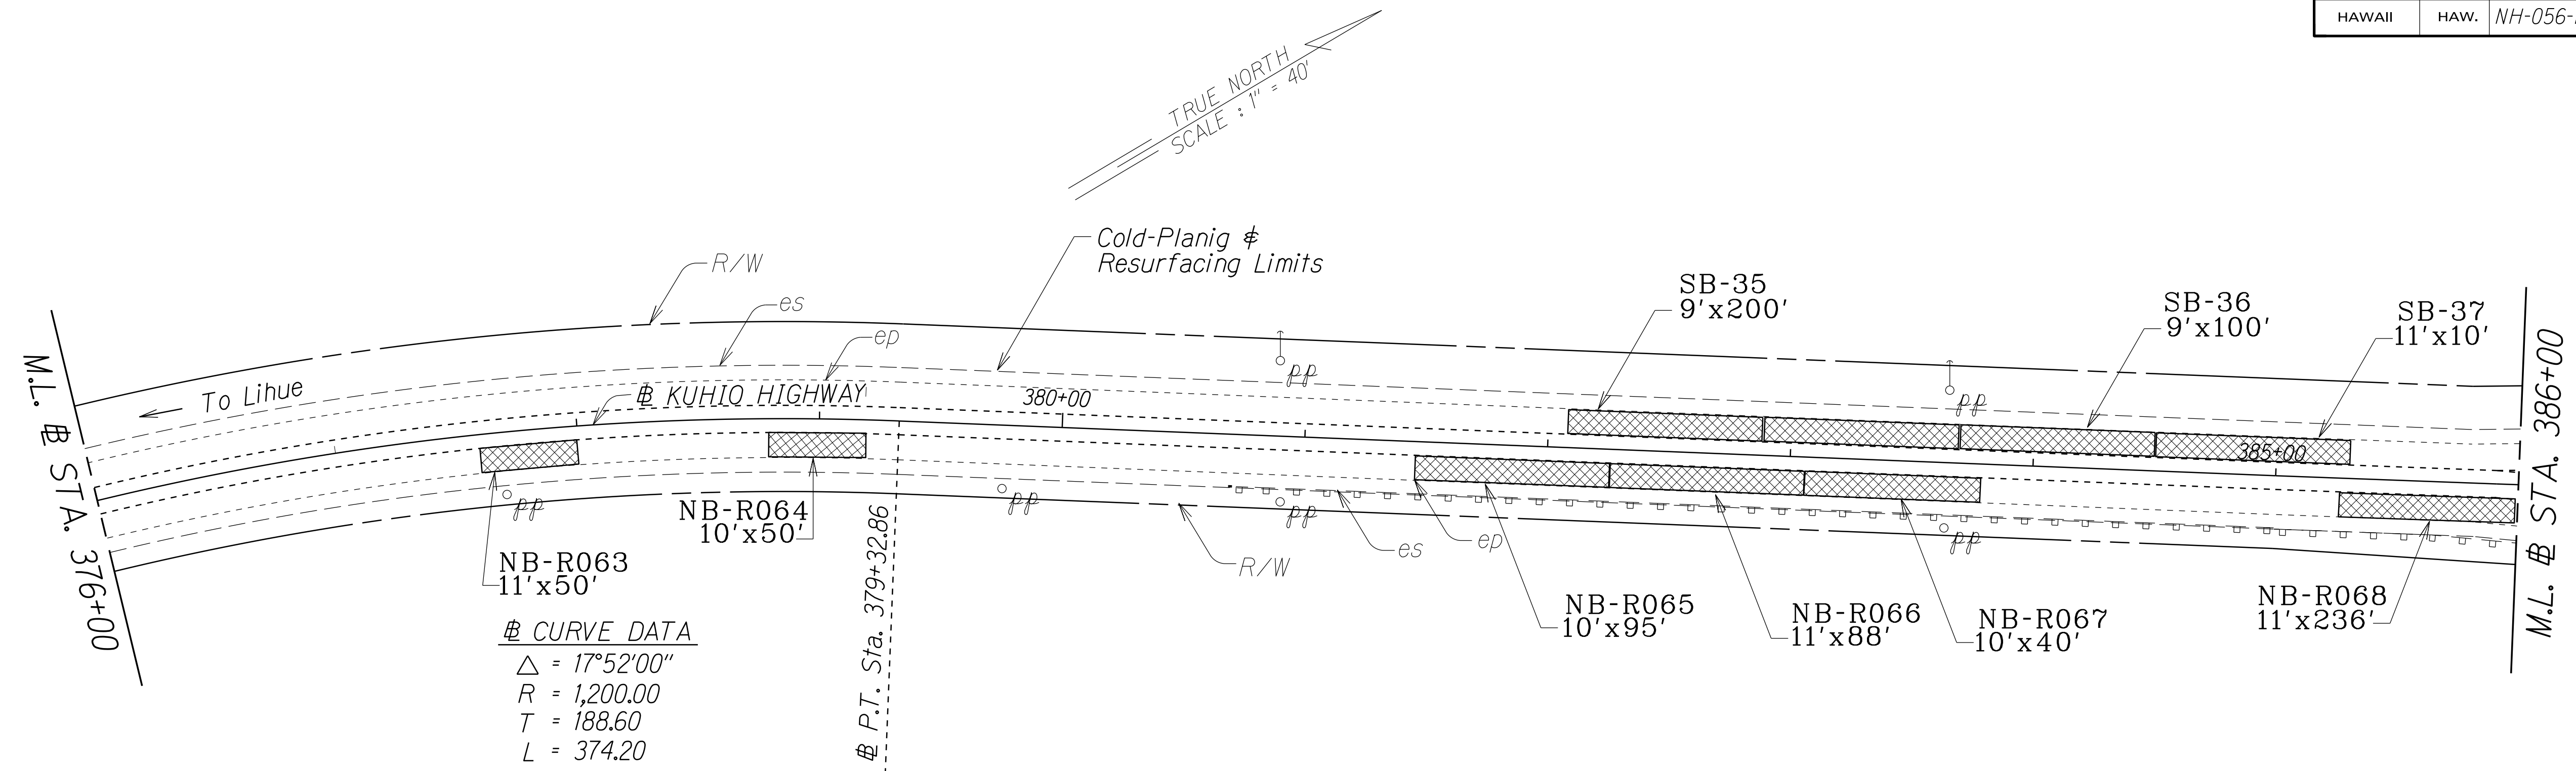

DATE	_____
SURVEY PLOTTED BY	_____
DRAWN BY	_____
DESIGNED BY	_____
CHECKED BY	_____
ORIGINAL PLAN	_____
NOTE BOOK	_____
FILE NAME	_____
NO.	_____

LEGEND FOR AS-BUILT POSTINGS	
	Squiggly line for as-built deletion
	Double line for as-built deletion
Roadway	Text for as-built posting

STATE OF HAWAII
DEPARTMENT OF TRANSPORTATION
HIGHWAYS DIVISION

ROADWAY PLAN

*KUHIO HIGHWAY RESURFACING
Kapule Highway to North Leho Drive
Federal-Aid Project No. NH-056-1(058)*

Scale: 1" = 40' Date: Oct. 2016

SHEET No. 8 OF 8 SHEETS

"AS-BUILT"