
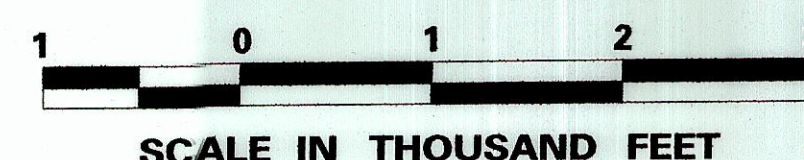
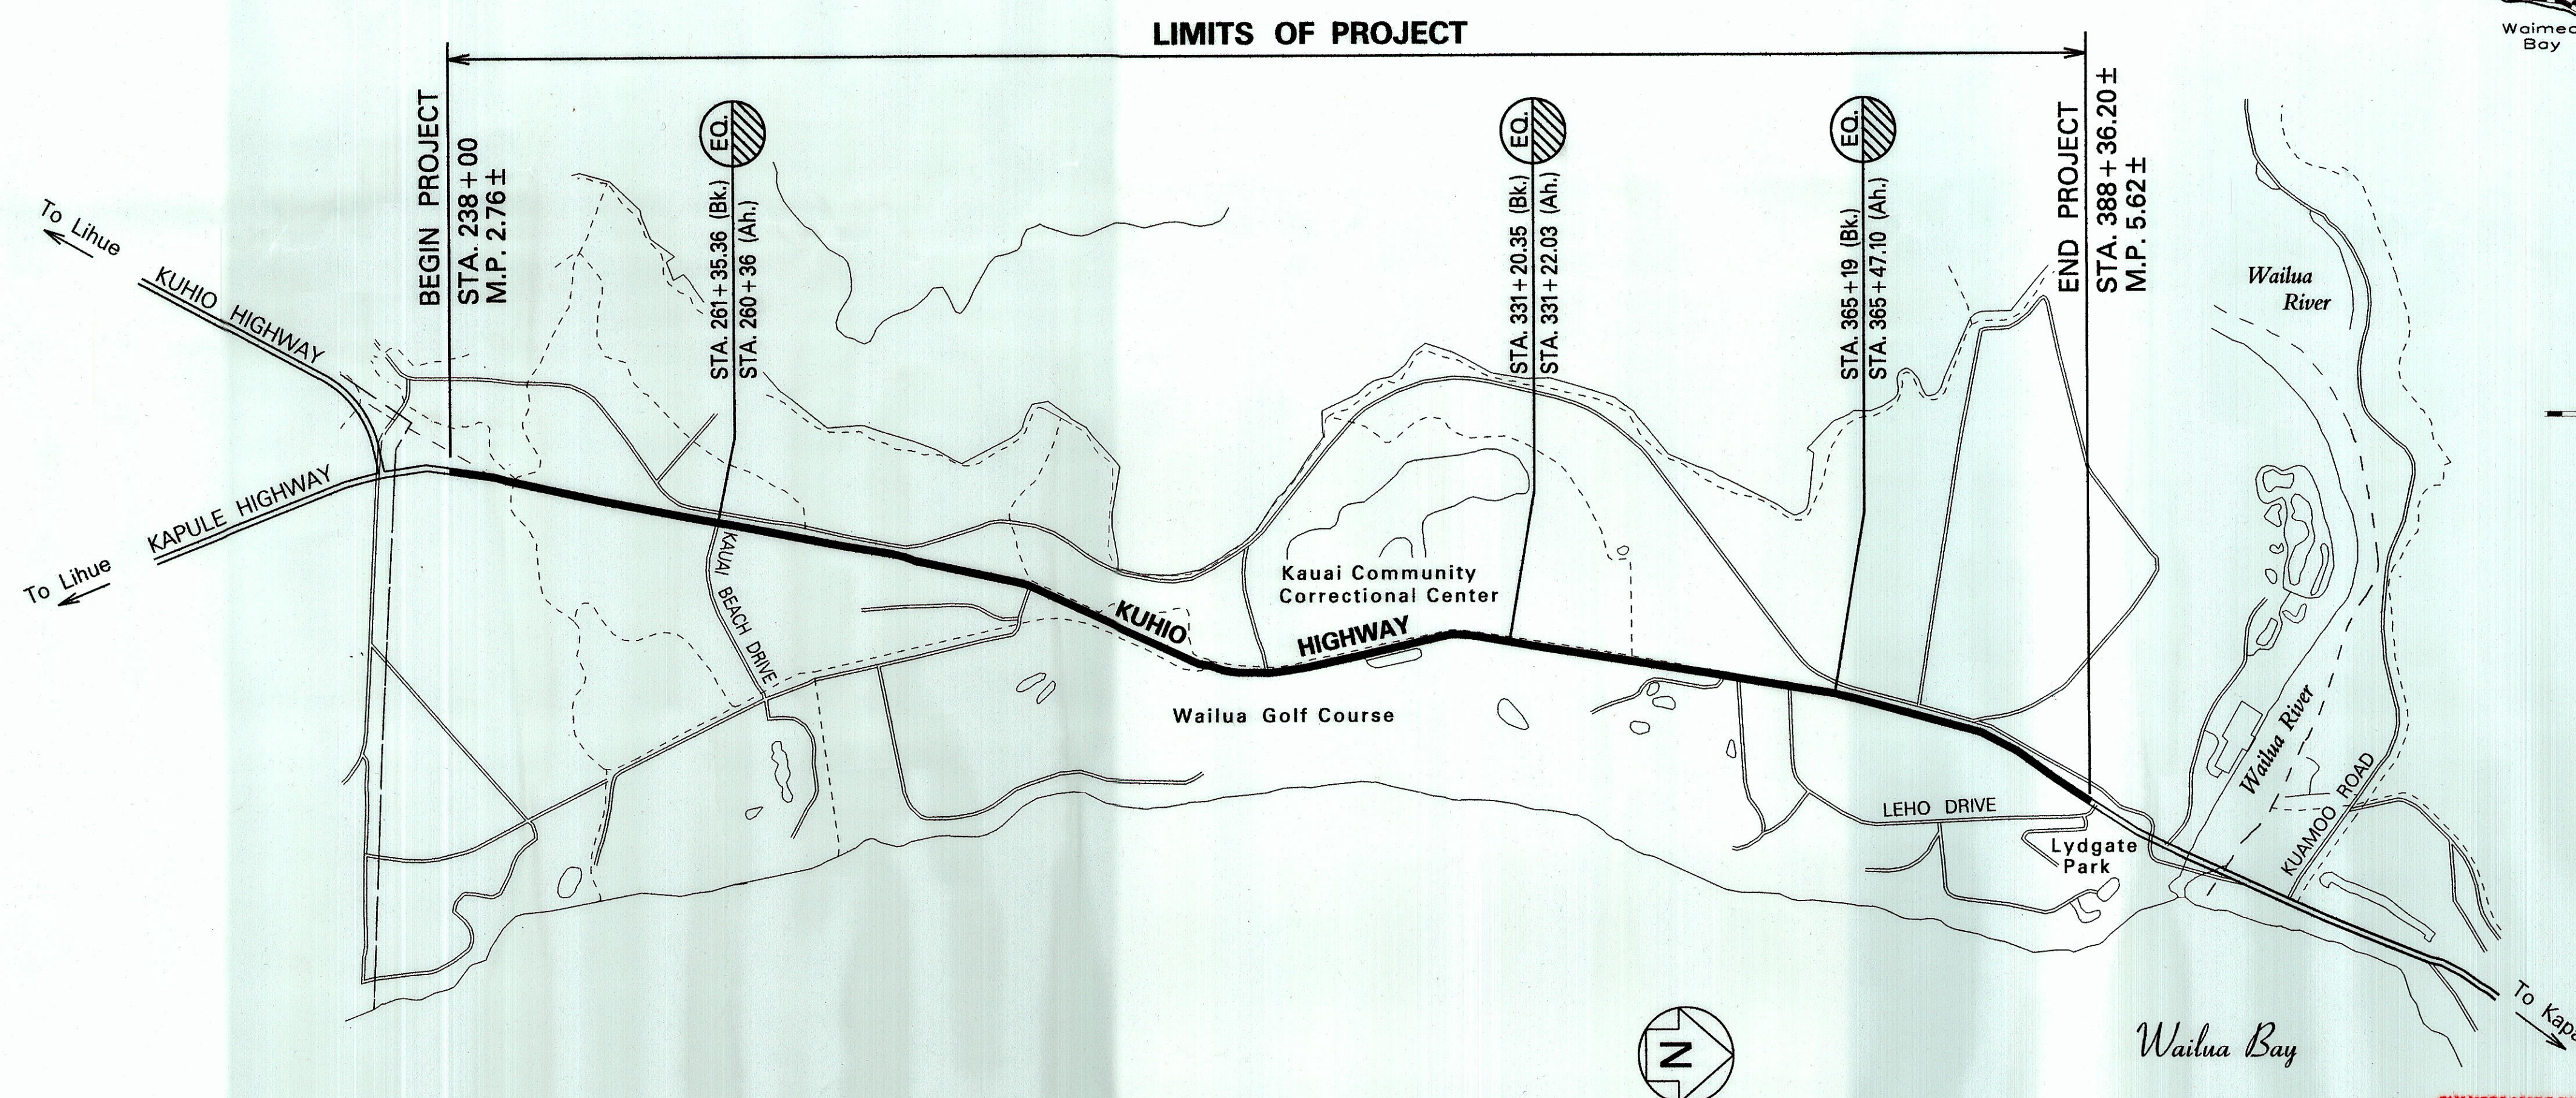



INDEX TO DRAWINGS	
SHEET NO.	DESCRIPTION
1	TITLE SHEET
2	STANDARD PLANS SUMMARY
3	GENERAL NOTES & LEGEND
4 - 6	WATER POLLUTION AND EROSION CONTROL NOTES
7 - 9	TYPICAL SECTION
10 - 17	ROADWAY PLAN
18	PAVEMENT MARKING, NOTES, LEGEND, AND SIGN DETAILS
19	CENTERLINE MILLED RUMBLE STRIP DETAIL
20 - 27	PAVEMENT MARKING AND TRAFFIC SIGNING PLAN
28	SUPPLEMENTAL PLATE DETAIL
29	DESTINATION SIGN DETAIL
30	LOW SPEED UNDIVIDED HIGHWAY WORK ZONE SIGNING PLAN, NOTES & DETAILS

STATE OF HAWAII
DEPARTMENT OF TRANSPORTATION
HIGHWAYS DIVISION
HONOLULU, HAWAII
"AS-BUILT" PLANS FOR
**KUHIO HIGHWAY RESURFACING
KAPULE HIGHWAY TO NORTH LEHO DRIVE
FEDERAL-AID PROJECT NO. NH-056-1(058)**
DISTRICT OF LIHUE
ISLAND OF KAUAI

FED. ROAD DIST. NO.	STATE	FED-AID PROJ. NO.	FISCAL YEAR	SHEET NO.	TOTAL SHEETS
HAWAII	HAW.	NH-056-1(058)	2017	1	30

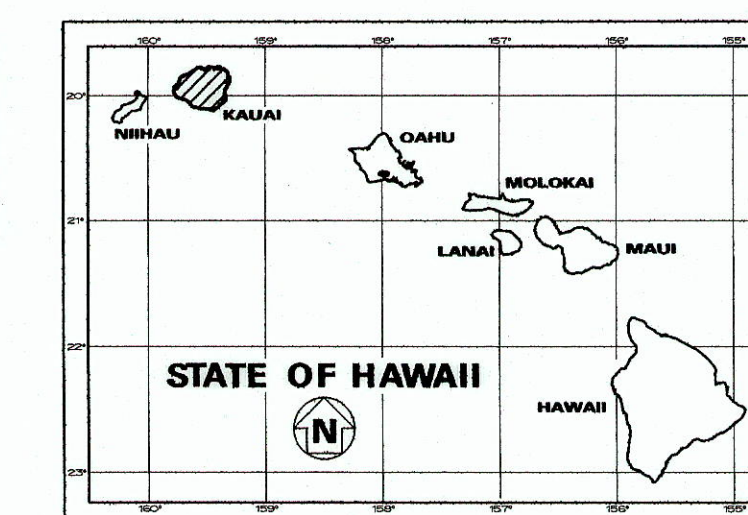

LAYOUT PLAN
GROSS LENGTH OF PROJECT.....2.76 MILE
NET LENGTH OF PROJECT.....2.76 MILE

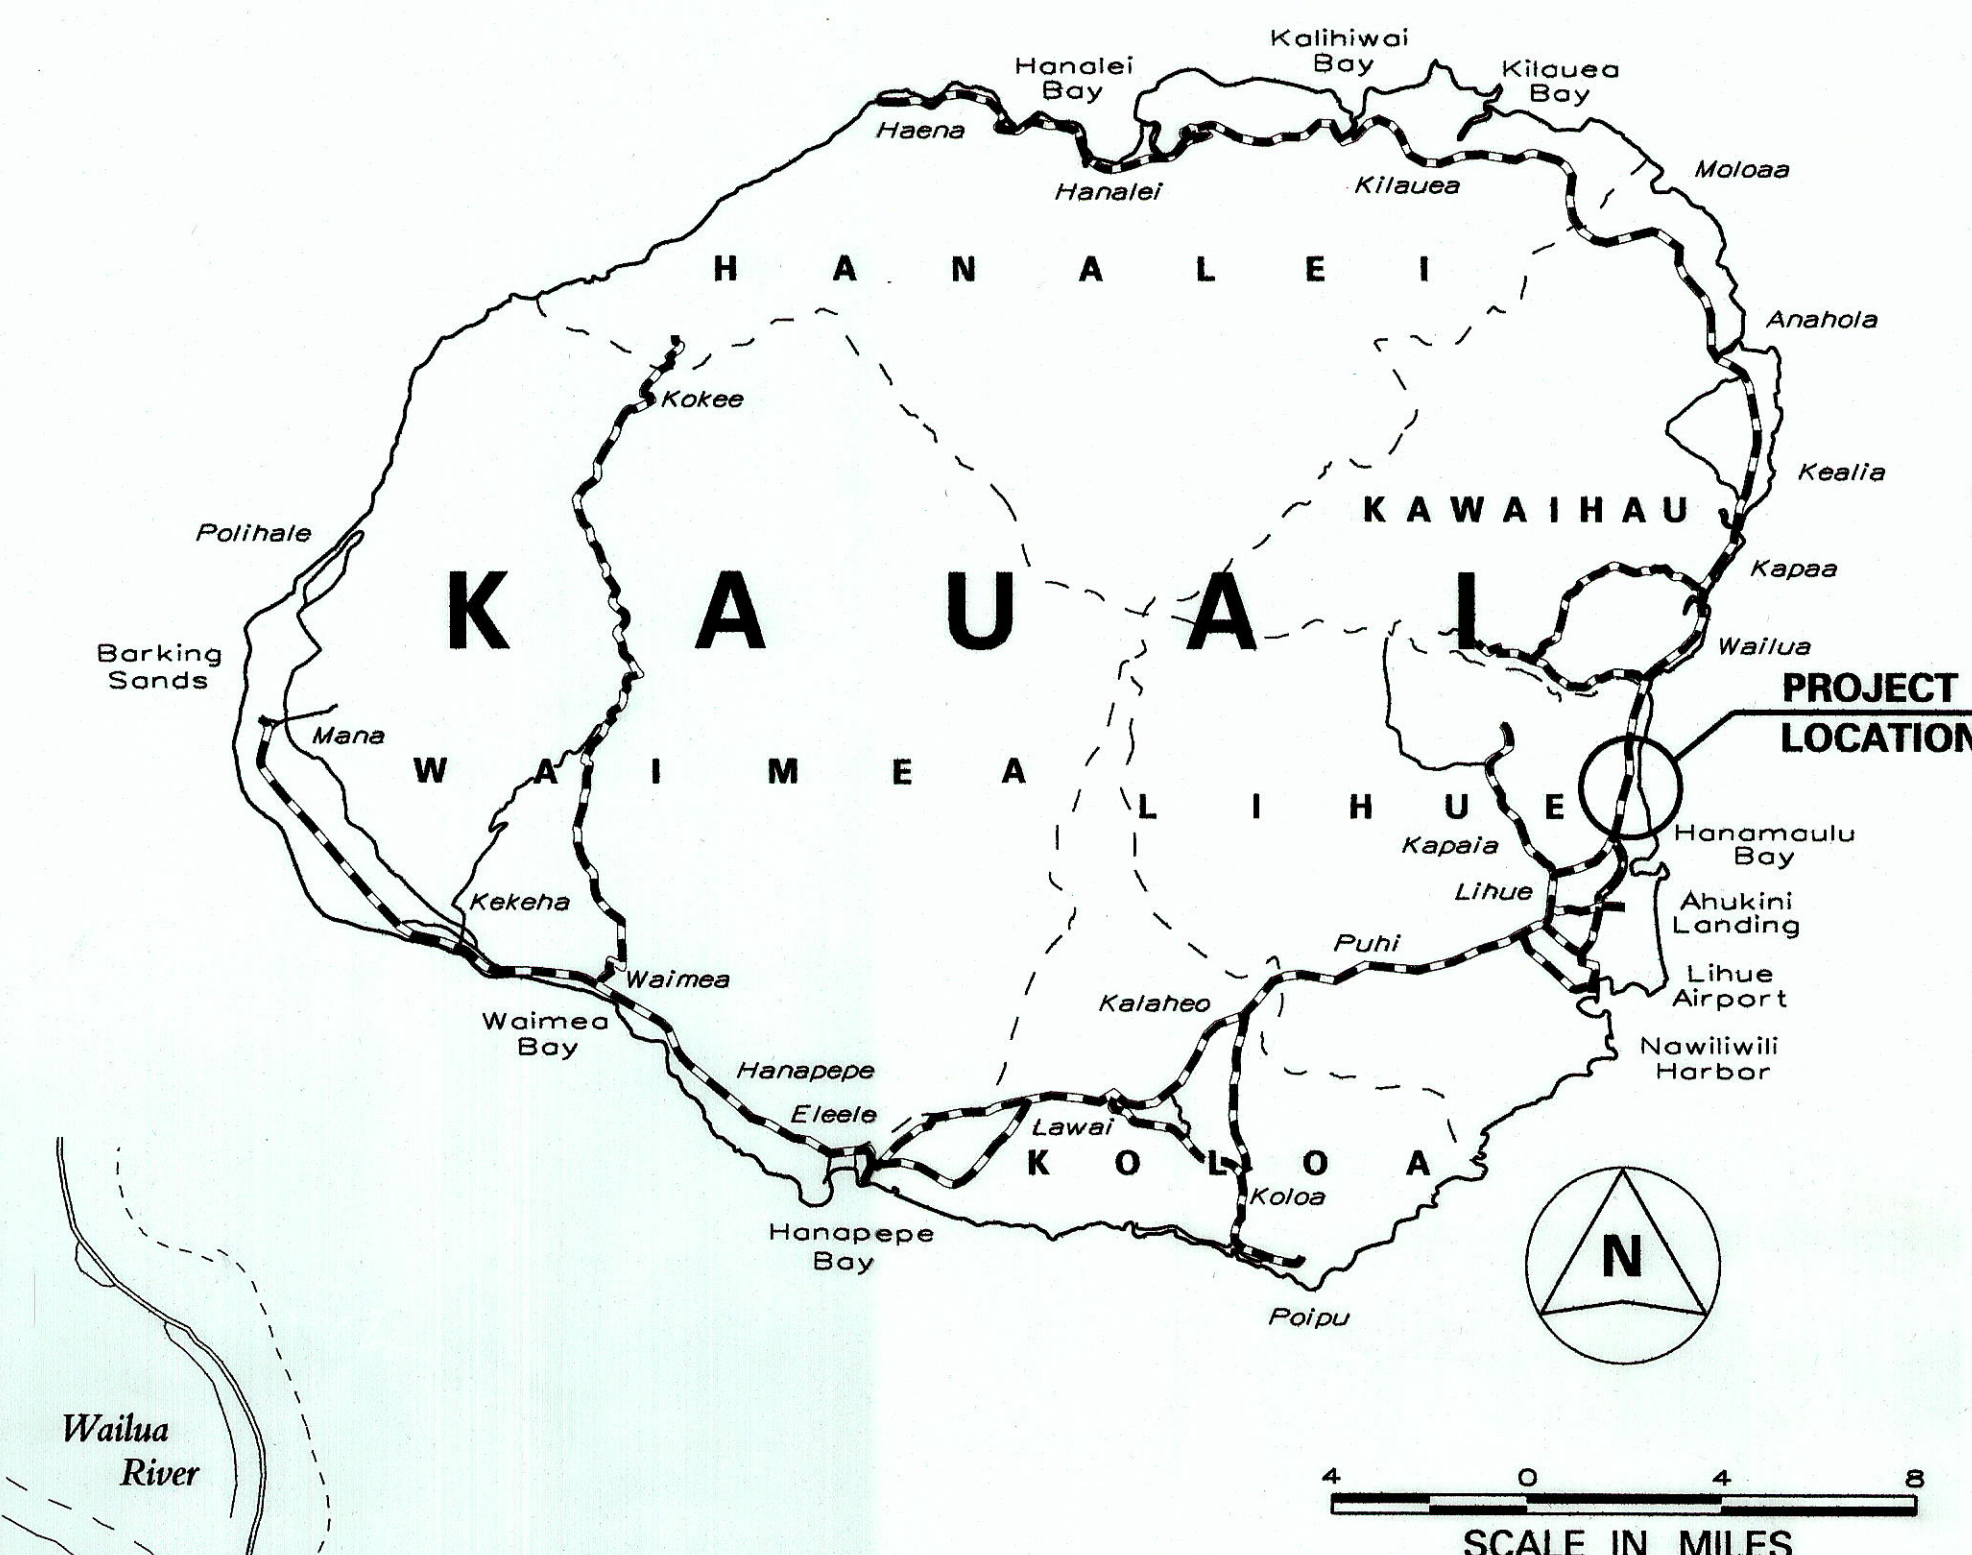

--- FEDERAL AID PROJECTS PREVIOUSLY CONSTRUCTED OR UNDER CONSTRUCTION

MILE POST 2.76 TO MILE POST 5.62

DESIGN DESIGNATION

ADT (2013).....34,400
ADT (2030).....40,200
DHV3,220
D60/40
T2.0 %
V40 M.P.H.

CHANGES MADE DURING CONSTRUCTION HAVE BEEN INCORPORATED ON THESE PLANS EXCEPT CHANGES IN THE ORIGINAL THEORETICAL QUANTITIES. FOR ACTUAL QUANTITIES, REFER TO PROJECT LEDGER AND/OR COMPUTATION BOOK.
RESIDENT ENGINEER
DATE 4/20/21

DEPARTMENT OF TRANSPORTATION
STATE OF HAWAII
APPROVED:
DIR. OF TRANSPORTATION
DATE 7/19/17

DESIGNED BY HWY-K
MANAGED BY HWY-KE
PHONE 241-3000
DATE AUG. 2017